



REVISIONS
 Per Bldg. Dept. - 9/10/01
 CONSULTANT

CITY OF LAS VEGAS, NEVADA
 FIRE STATION #44

Enlarged Wall Sections


RECORD DRAWING
 DEPARTMENT OF PUBLIC WORKS

OWNER: CITY OF LAS VEGAS
 DEPARTMENT OF PUBLIC WORKS
 ARCHITECTURAL SERVICES

400 EAST STEWART AVENUE
 LAS VEGAS, NEVADA 89101
 PHONE: (702) 229-6535
 FAX: (702) 382-3232
 TDD: (702) 386-9108

DRAWN: EPB
 FILE: 144-AB-1
 DATE: 10/23/01
 SCALE: 1/2" = 1'-0"
 BID NO: 02.15341.02
 CLDWG NO: 630.97
 42 OF 706

A9.1

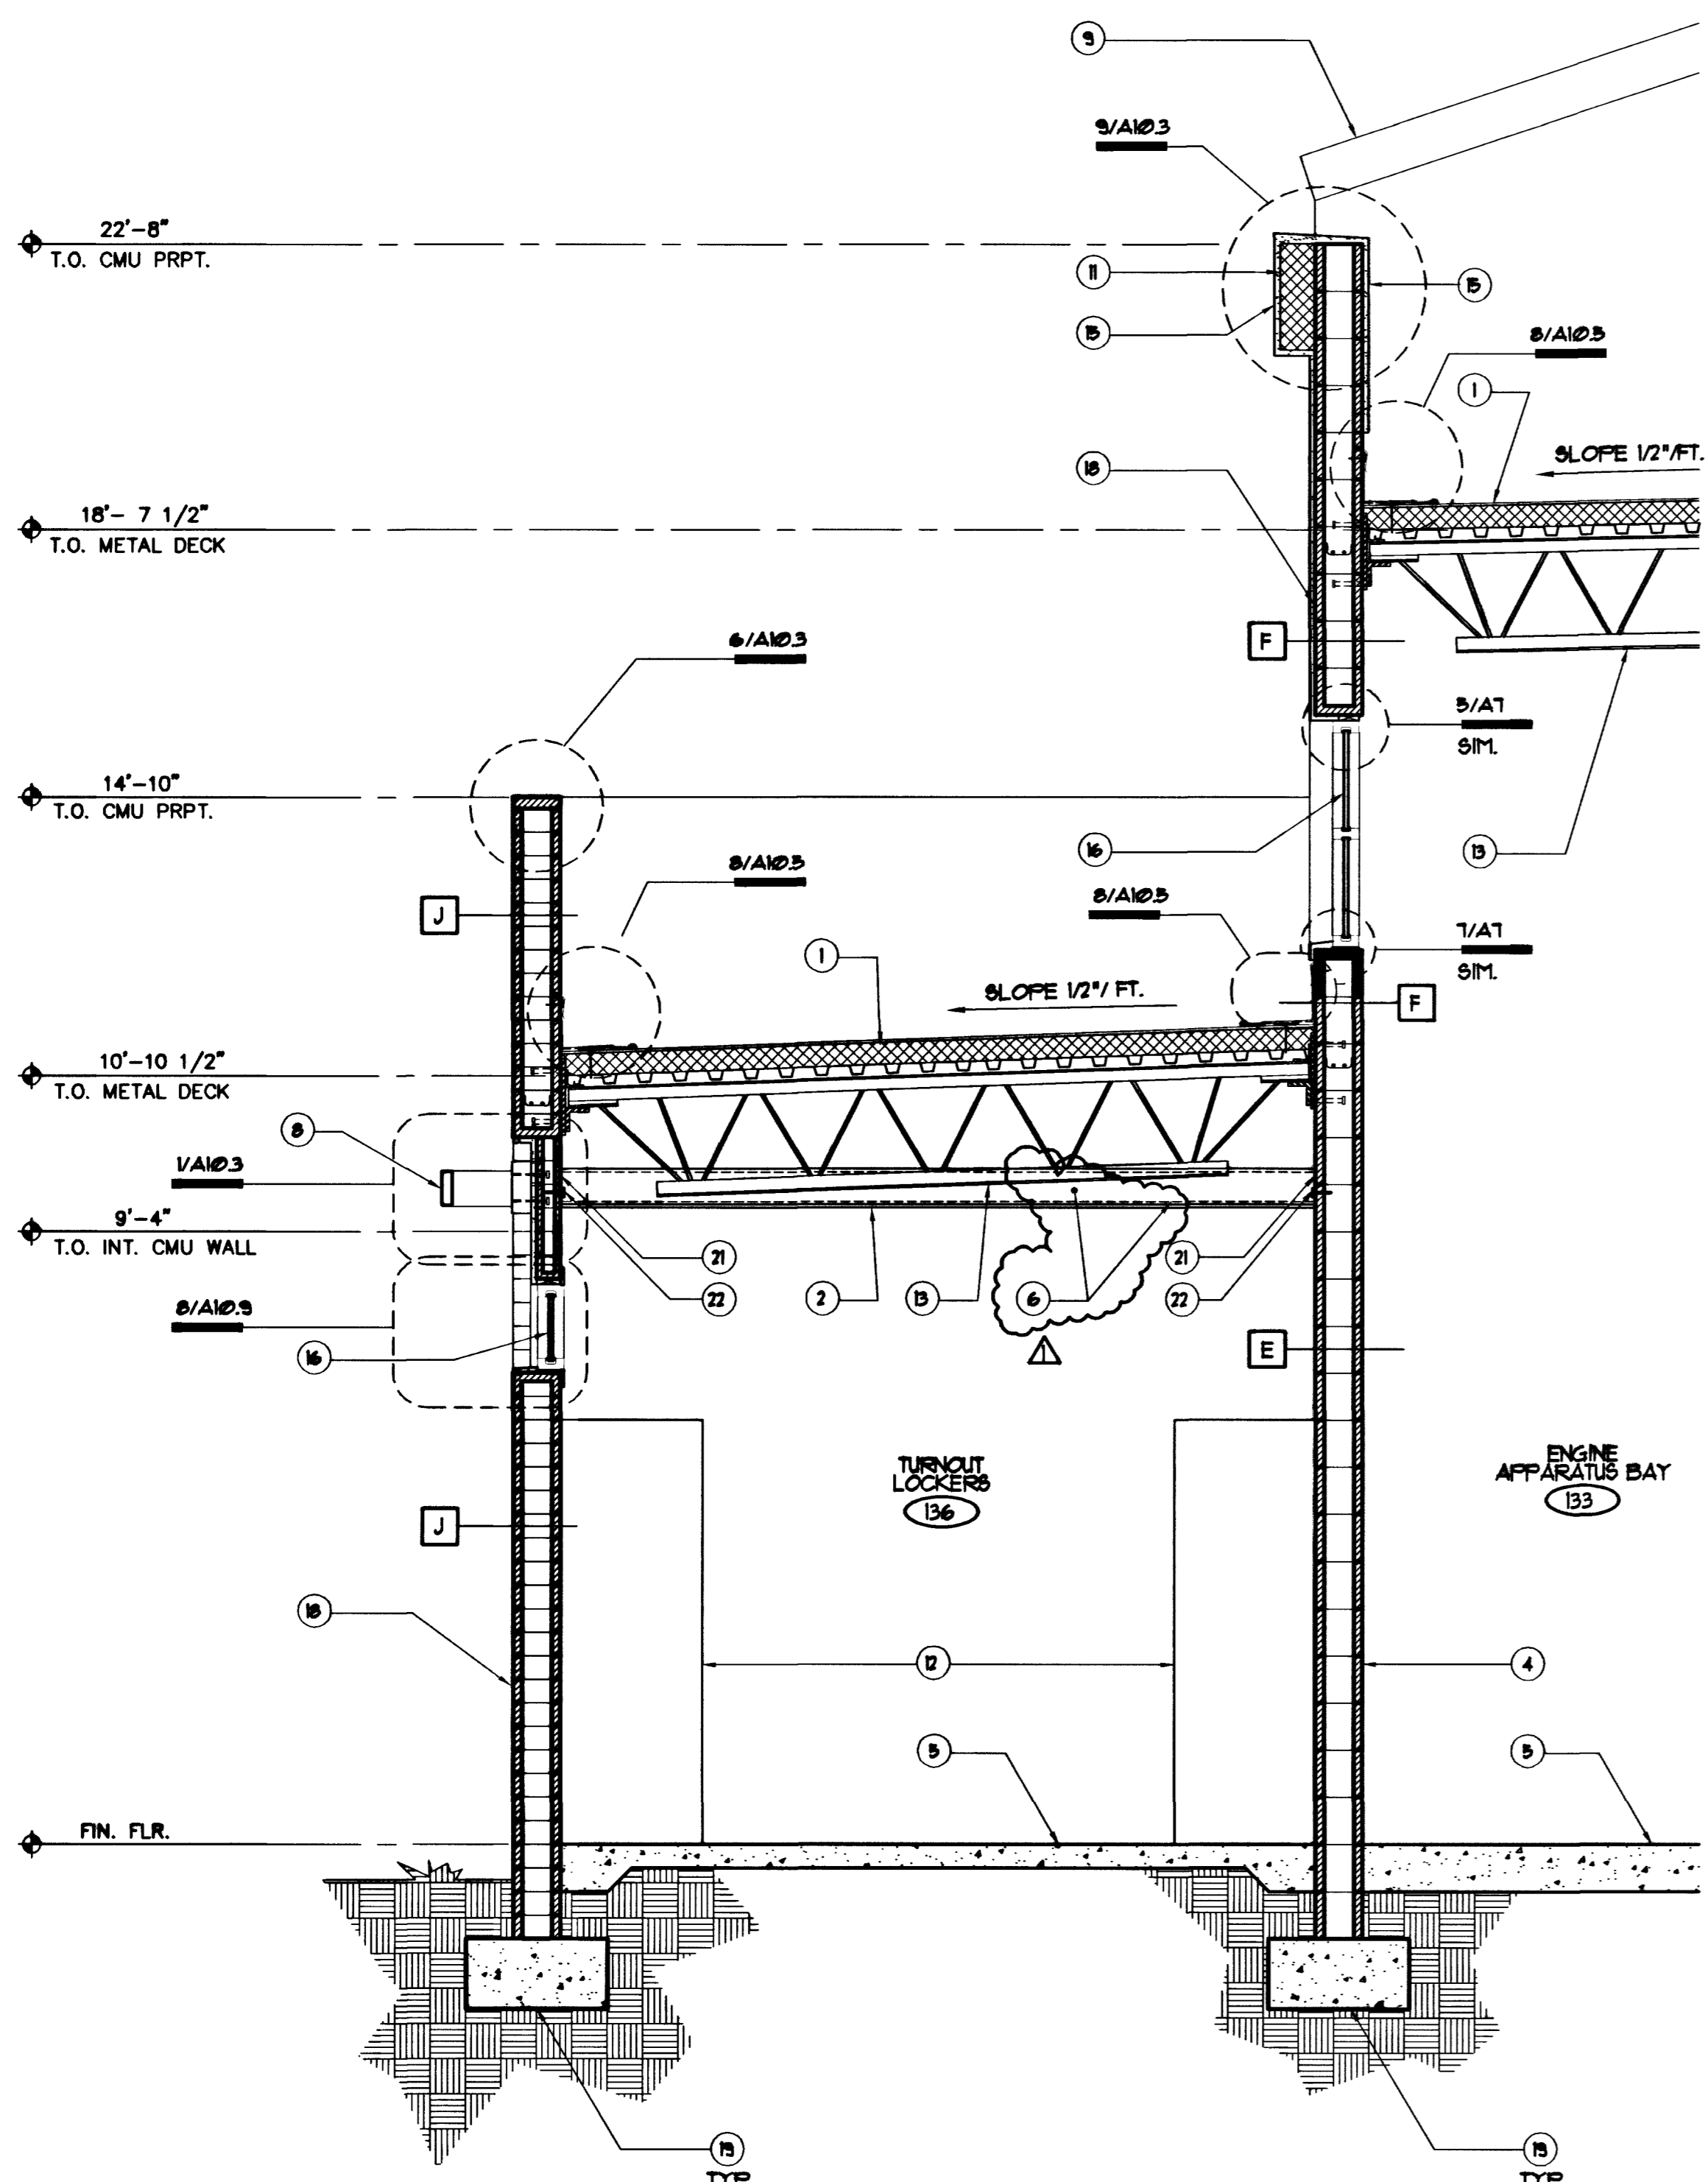


1 Wall Section
 Scale: 1/2"=1'-0"

Keynotes

- 1 SINGLE PLY ROOFING SYSTEM O/ R-30 RIGID INSULATION O/ MTL. DECK.
- 2 5/8" TYPE "X" GYP. BD. CEILING (SUSPENDED), PAINT # SEE SIM. DTL. 6/A103.
- 3 CEILING SOFFIT ABOVE UPPER CABINTRY. FRAME W/ 3-5/8" 2@ GA. MTL. STUDS @ 16" O.C. W/ 5/8" TYPE "X" GYP. BOARD. PAINT PER FINISH SCHEDULE.
- 4 INTERIOR WALL ASSEMBLY. SEE CALLOUTS AT WALLS # 5HT. G2.
- 5 REINFORCED CONCRETE SLAB. IN ADDITION, SEE STRUCTL. CALC'S.
- 6 USE 2@2@3C CEILING JOISTS @ 24" O.C. SEE STRUCTL. CALC'S.
- 7 PAINTED TUBE STEEL CROSSBARS # ROSETTE POPOUT. SEE DETAIL 1/A102.
- 8 WINDOW CANOPY. SEE DETAILS ON SHEET A102 # A103 INDICATED FOR DIFFERING WINDOW CANOPY CONDITIONS.
- 9 LINE OF GABLE END PARAPET BEYOND, SEE ELEVATIONS.
- 10 GYP. BD. CORNER BEAD, TYP.


57264

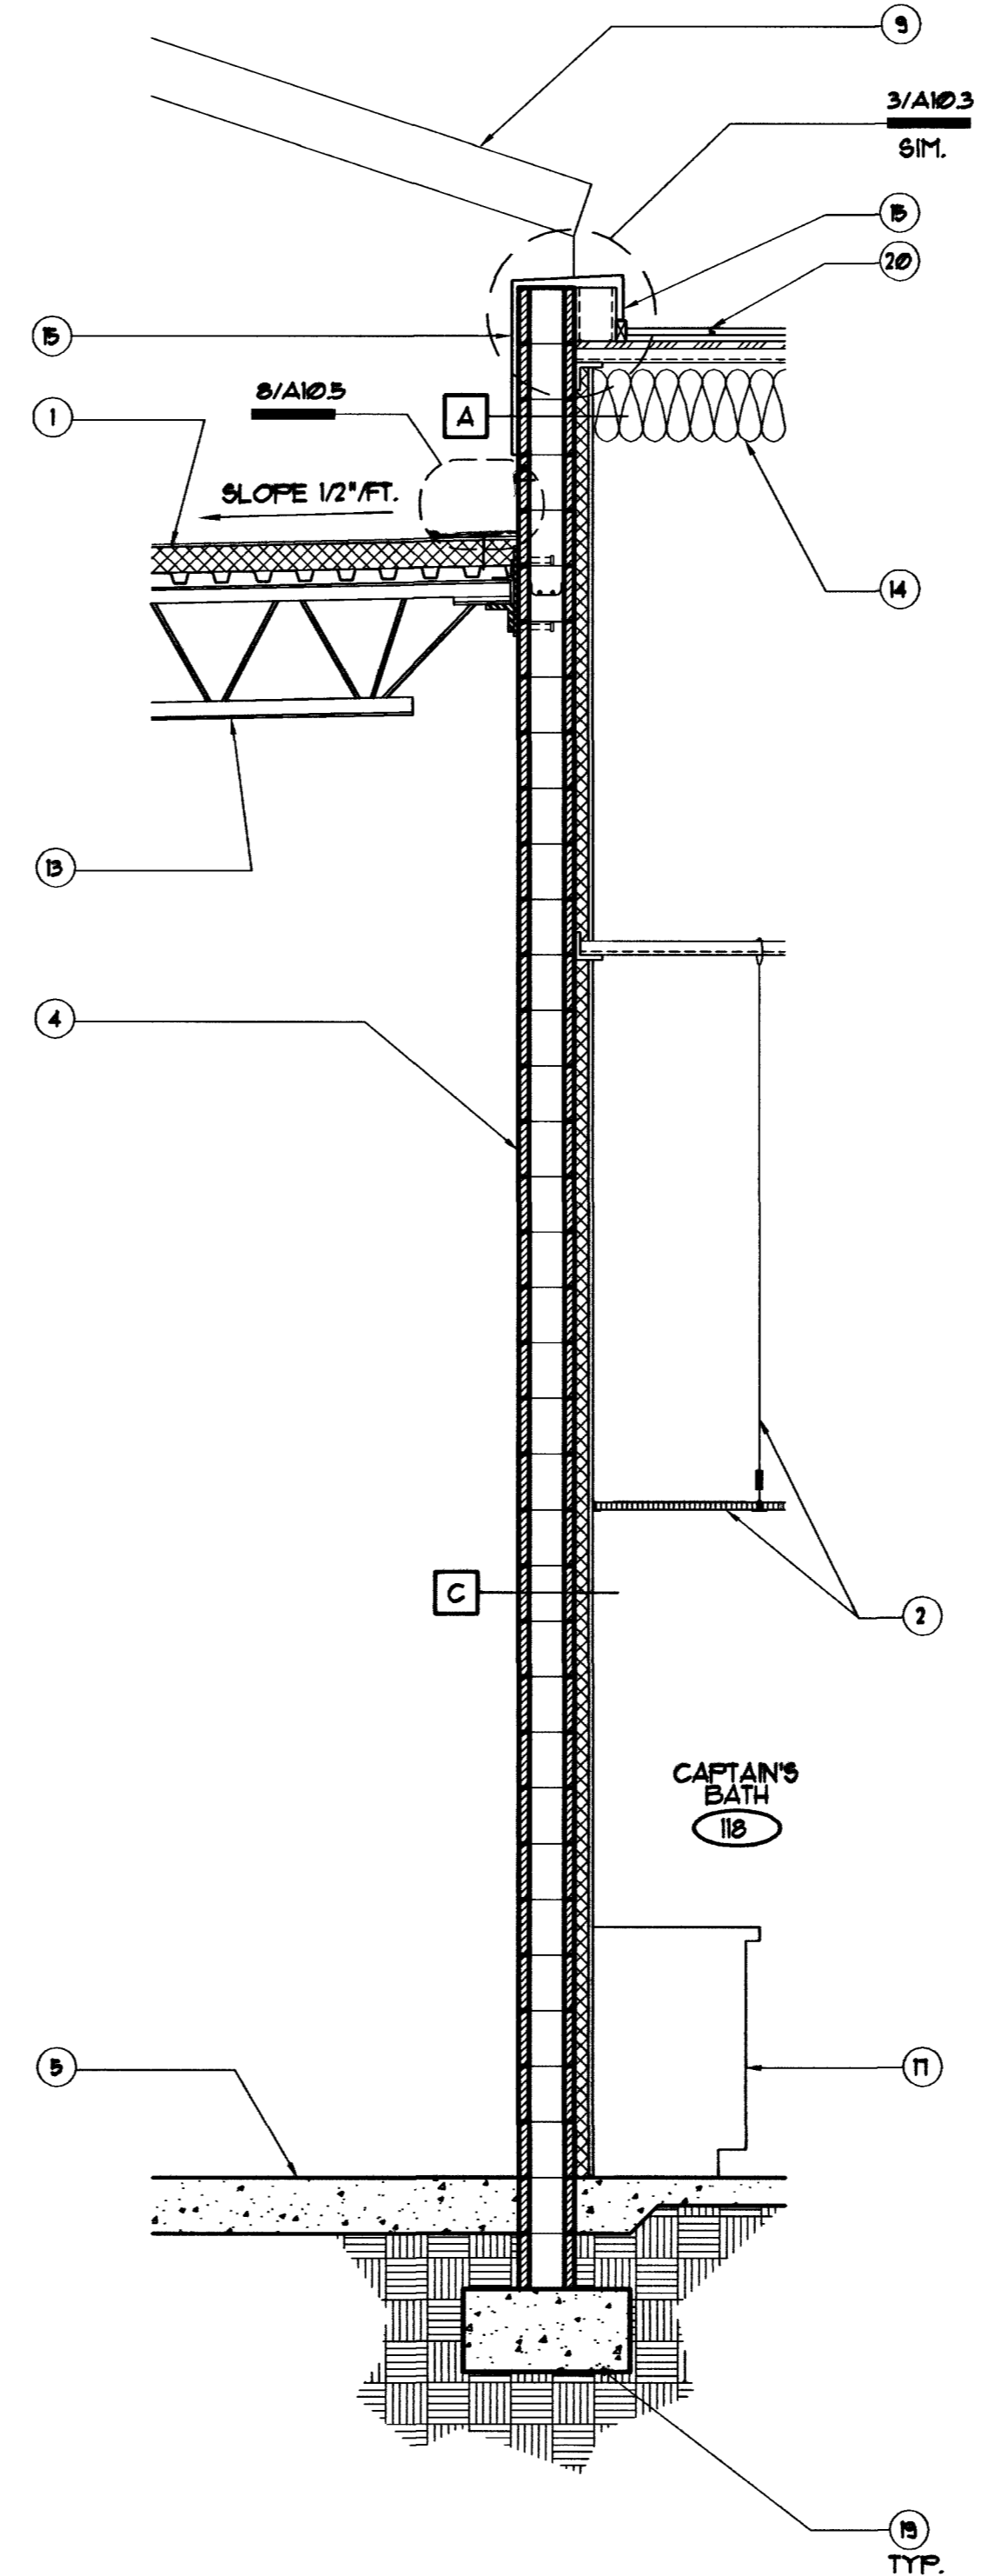

2 Wall Section
 Scale: 1/2"=1'-0"

Keynotes

- 11 PARAPET TRIM BANDING (POPOUT) - PAINT PER FINISH SCHEDULE. SEE DETAIL 9/A103.
- 12 METAL TURNOUT LOCKERS, SEE SPECIFICATIONS FOR TYPE AND SIZE.
- 13 PREFAB. ROOF TRUSS OR JOIST, SEE STRUCTURAL DIAGS.
- 14 R-30 BATT. ROOF INSULATION.
- 15 LIGHT SAND STUCCO FINISH - SEE EXTERIOR FINISH LEGEND # SPECIFICATIONS.
- 16 EXTERIOR WINDOW. SEE WINDOW SCHEDULE, SHEET A6.
- 17 CASEWORK, SEE INTERIOR ELEVATIONS, SPECIFICATIONS # DETAILS, 5HT. A104.
- 18 EXTERIOR WALL ASSEMBLY, SEE CALLOUTS AT ALL WALLS # 5HT. G2.
- 19 WALL FOOTING, SEE STRUCTURAL DIAGS.
- 20 CONCRETE TILE ROOFING O/ 30# FELT O/ WOOD SHEATHING O/ METAL DECKING. SEE ROOF PLAN.
- 21 CONTINUOUS LEDGER TRACK W/ #6 TOP # BOTTOM # EACH CEILING JOIST. (SEE STRUCTURAL CALCULATIONS).
- 22 USE 1 1/2" DIA. "SIMPSON" WEDGE ALL WEDGE ANCHORS # 4'-0" O.C. MAX. W/ 4" MINIMUM EMBEDS. (SEE STRUCTURAL CALCULATIONS).

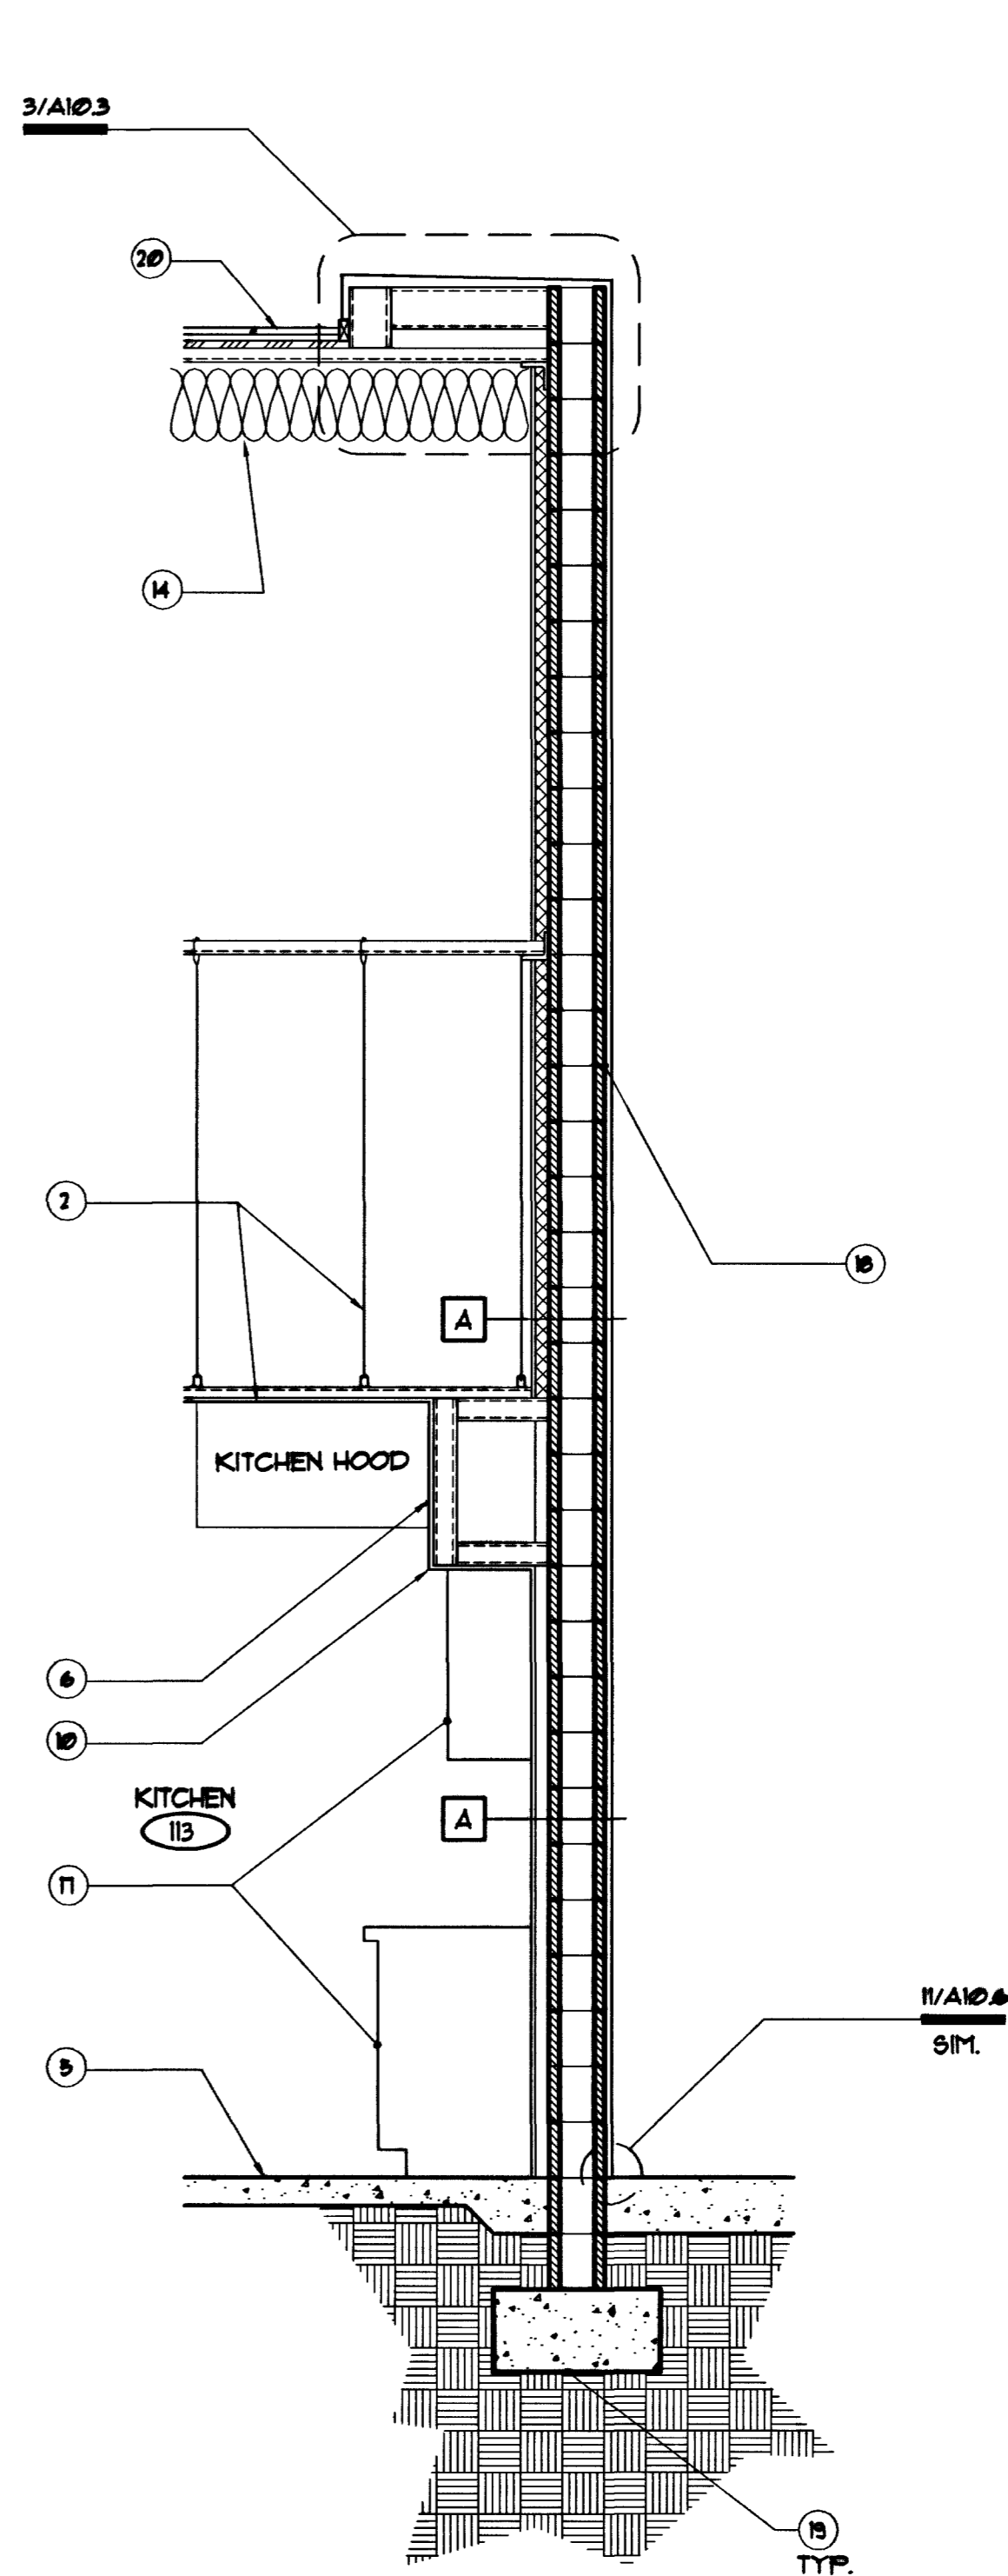

3 Wall Section
 Scale: 1/2"=1'-0"

General Notes:

- 1 REFER TO SHEETS A11, A12 AND G2 FOR INFORMATION ON ALL WALL TYPES.