
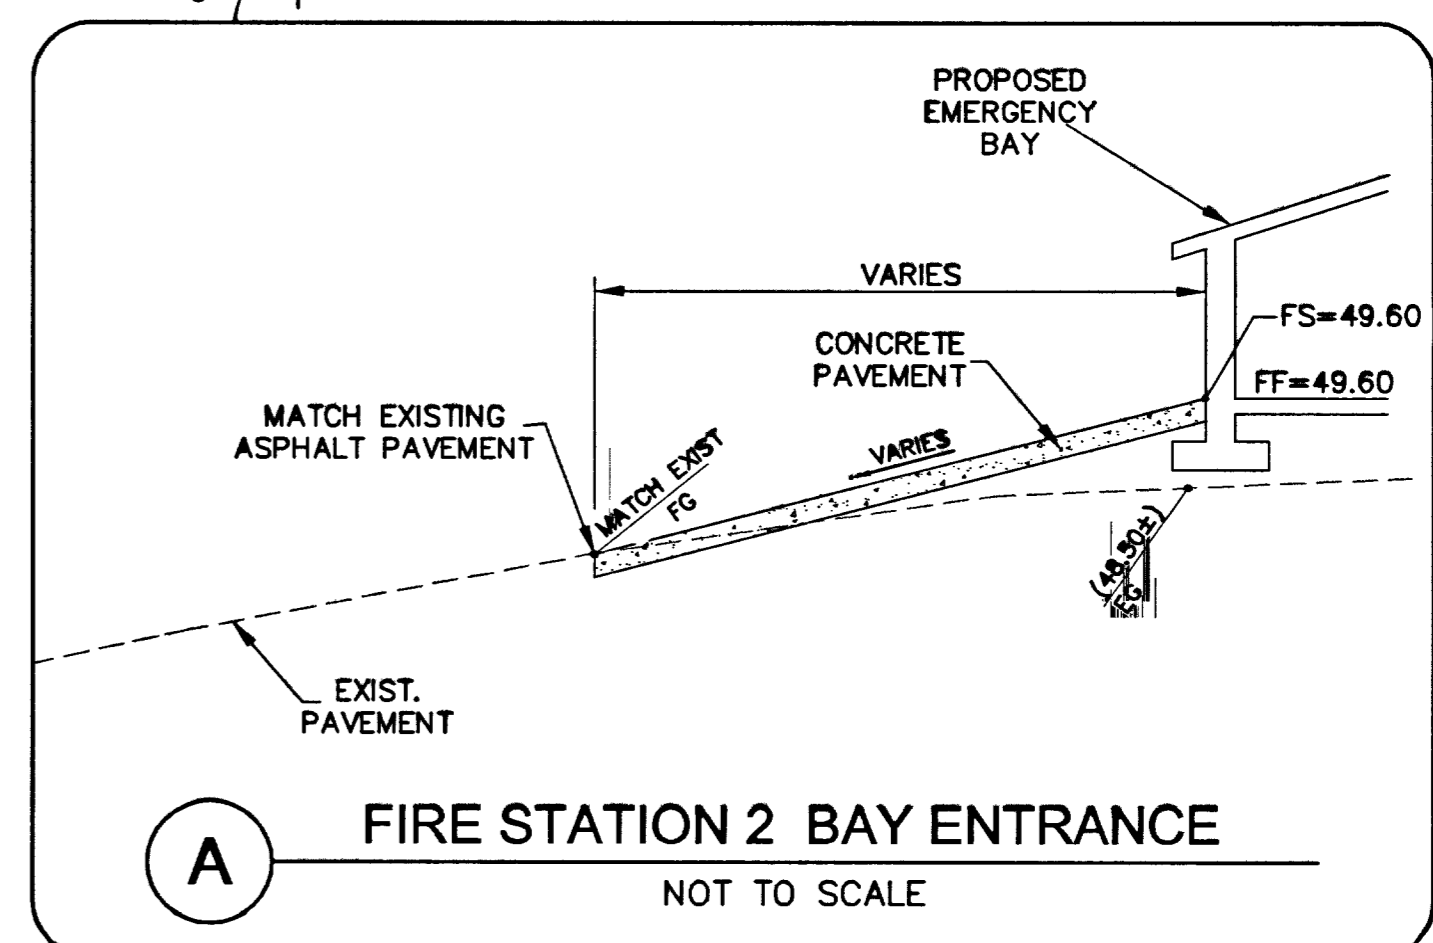
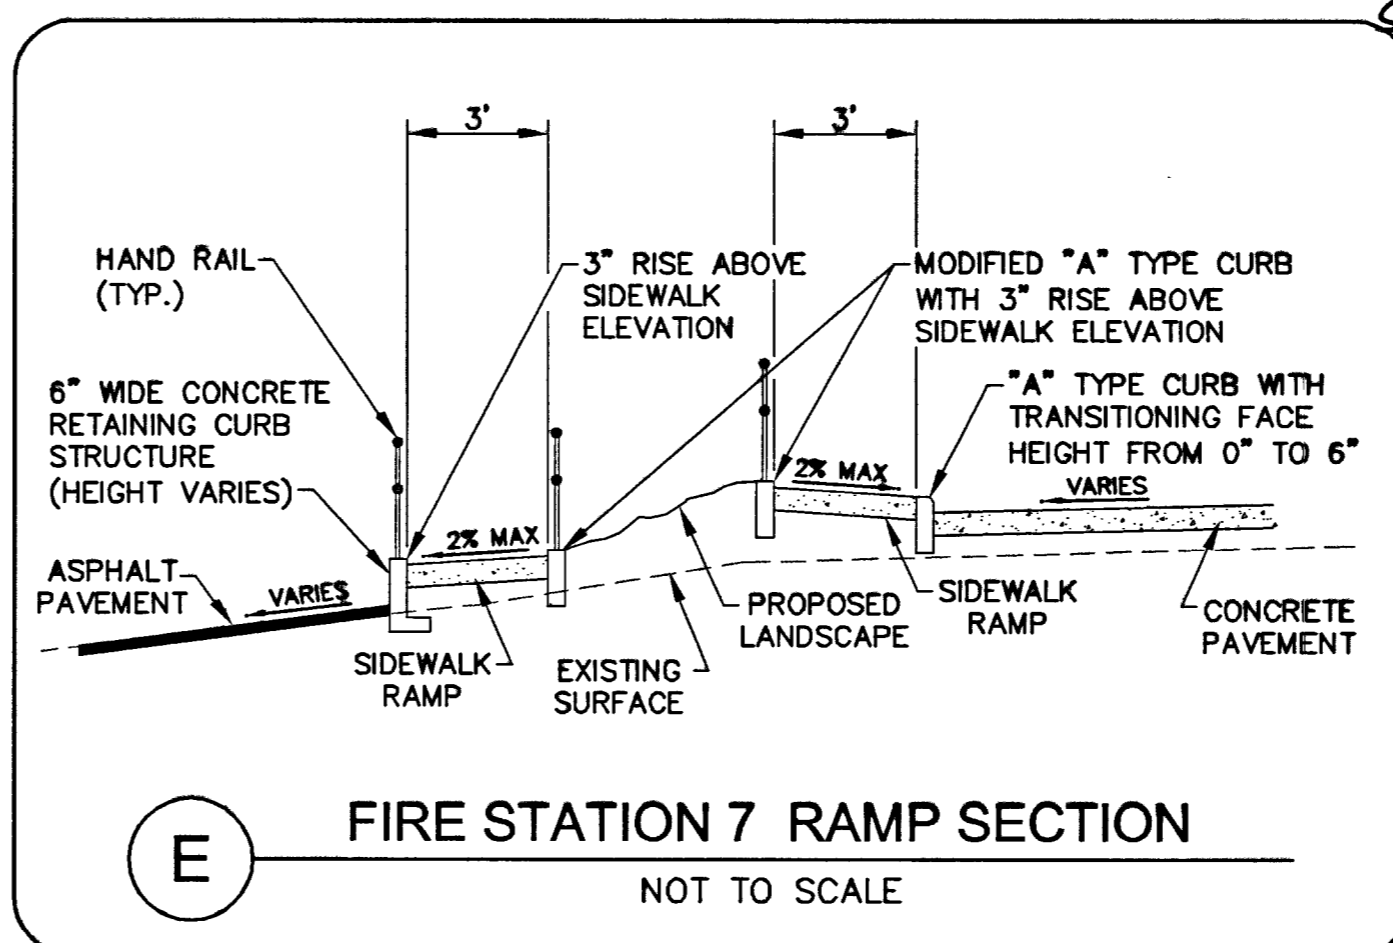
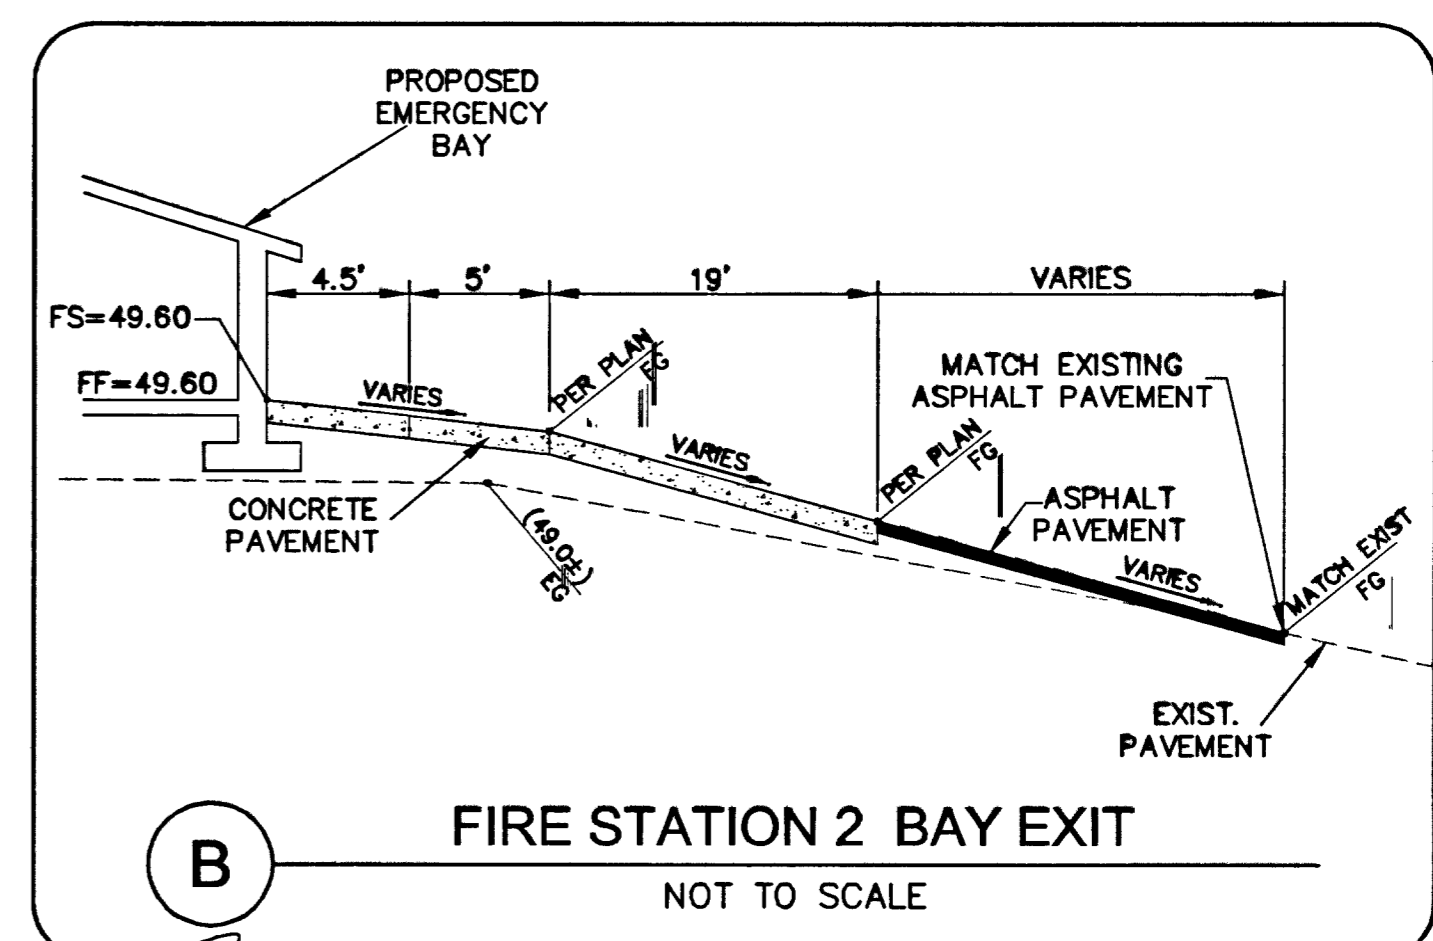
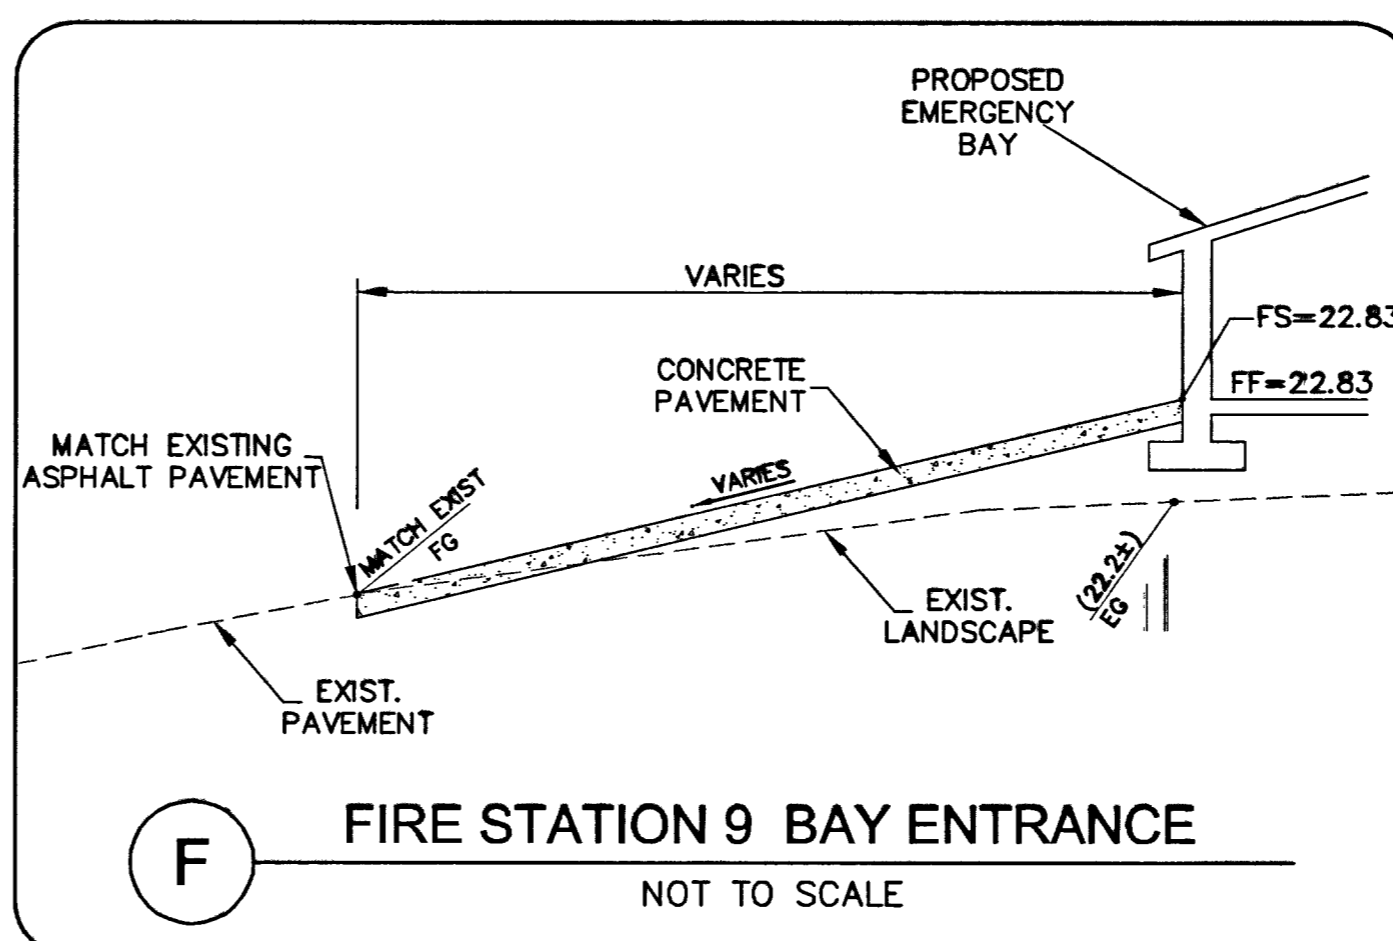
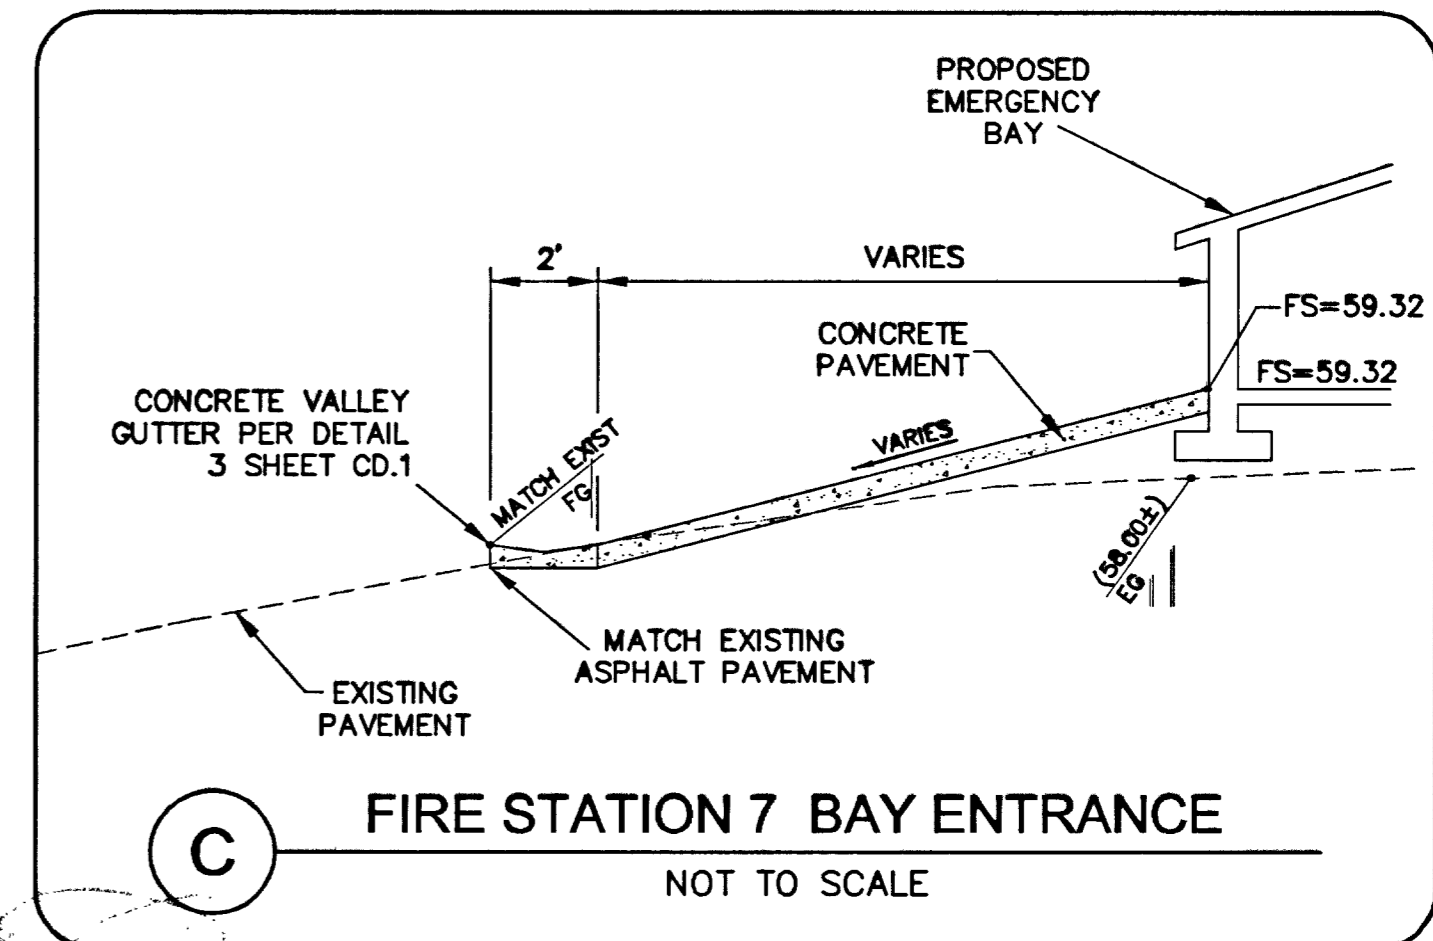
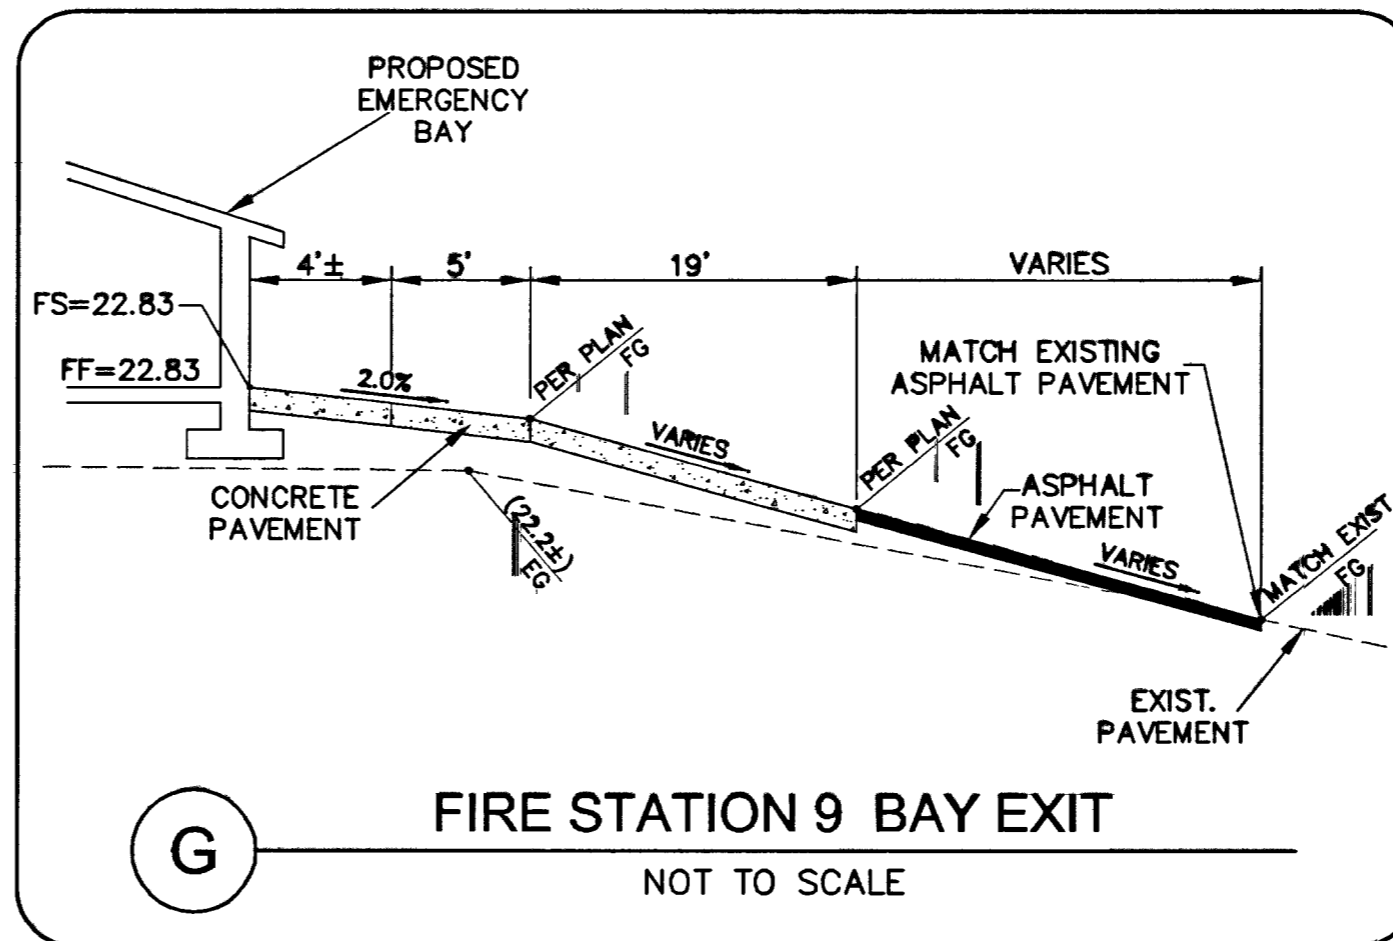


**RECORD DRAWINGS**  
 AS-BUILT INFORMATION WAS PROVIDED BY THE CONTRACTOR. AZTEC ASSUMES NO LIABILITY FOR ACCURACY OF ITS CONTENTS.

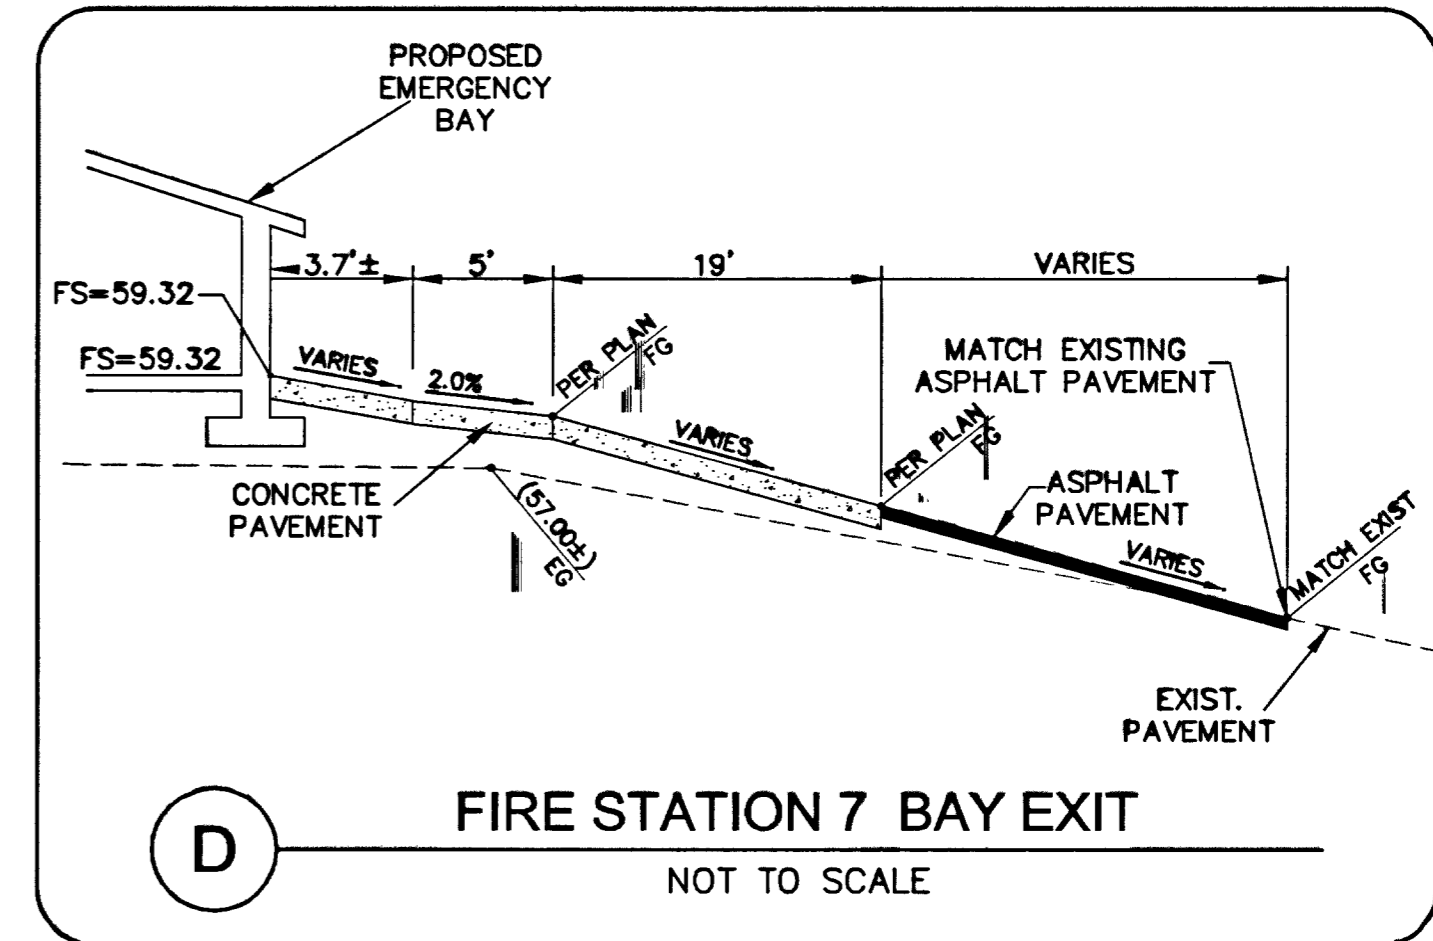

AS-BUILT DRAWINGS 05-02-03  
 DATE: 05-02-03  
 DESIGN: ABM/LG/RAS  
 SCALE: AS SHOWN  
 CAD FILE: #0 CD.2  
 PROJ NO: AZ01035  
 CITY OF LAS VEGAS FIRE STATION NO. 2, 7 & 9  
 SHEET CD.2  
 16 of 17 Sheets  
 CLV PROJECT NO. 630.99  
 AZTEC ENGINEERING  
 3320 N. Buffalo Dr., Ste. 106 Las Vegas, NV 89129  
 Tel (702) 396-3428 Fax (702) 396-3758  
 Email: aztec@azteceng.com  
 PROFESSIONAL ENGINEER - STATE OF NEVADA  
 ALLEN E. PAVELKA  
 No. 9029  
 STAMP DATE: 06/07/03  
 SITES IMPROVEMENTS  
 TYPICAL SECTIONS