
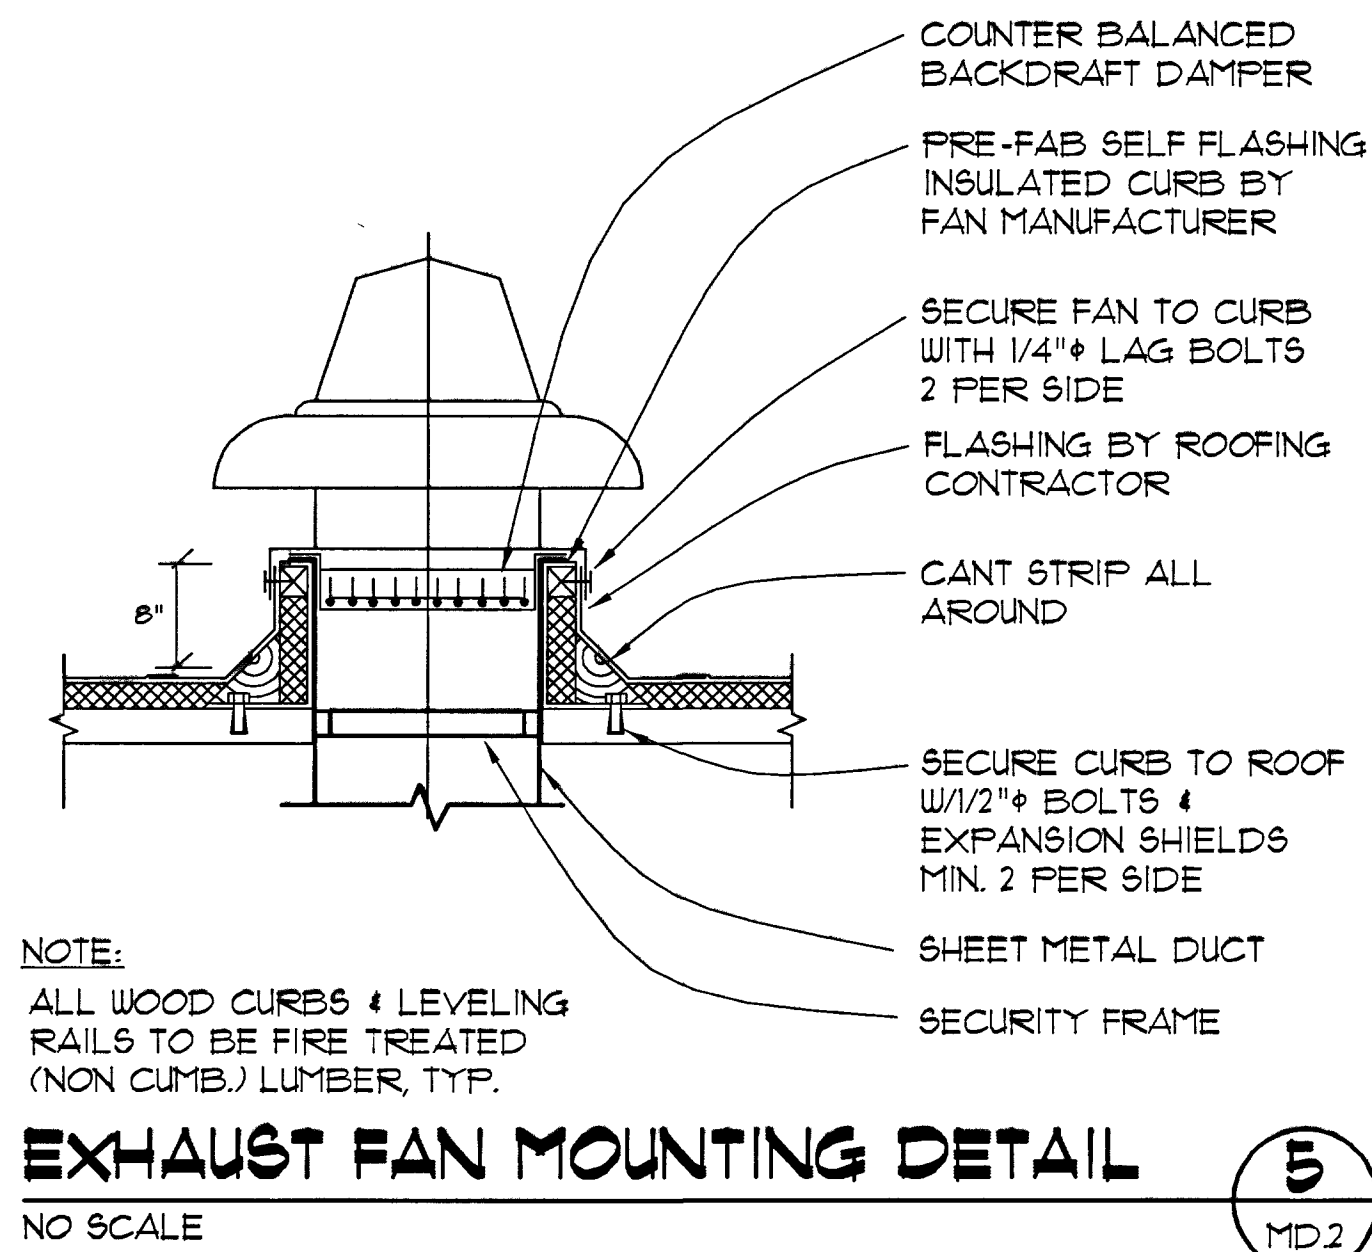
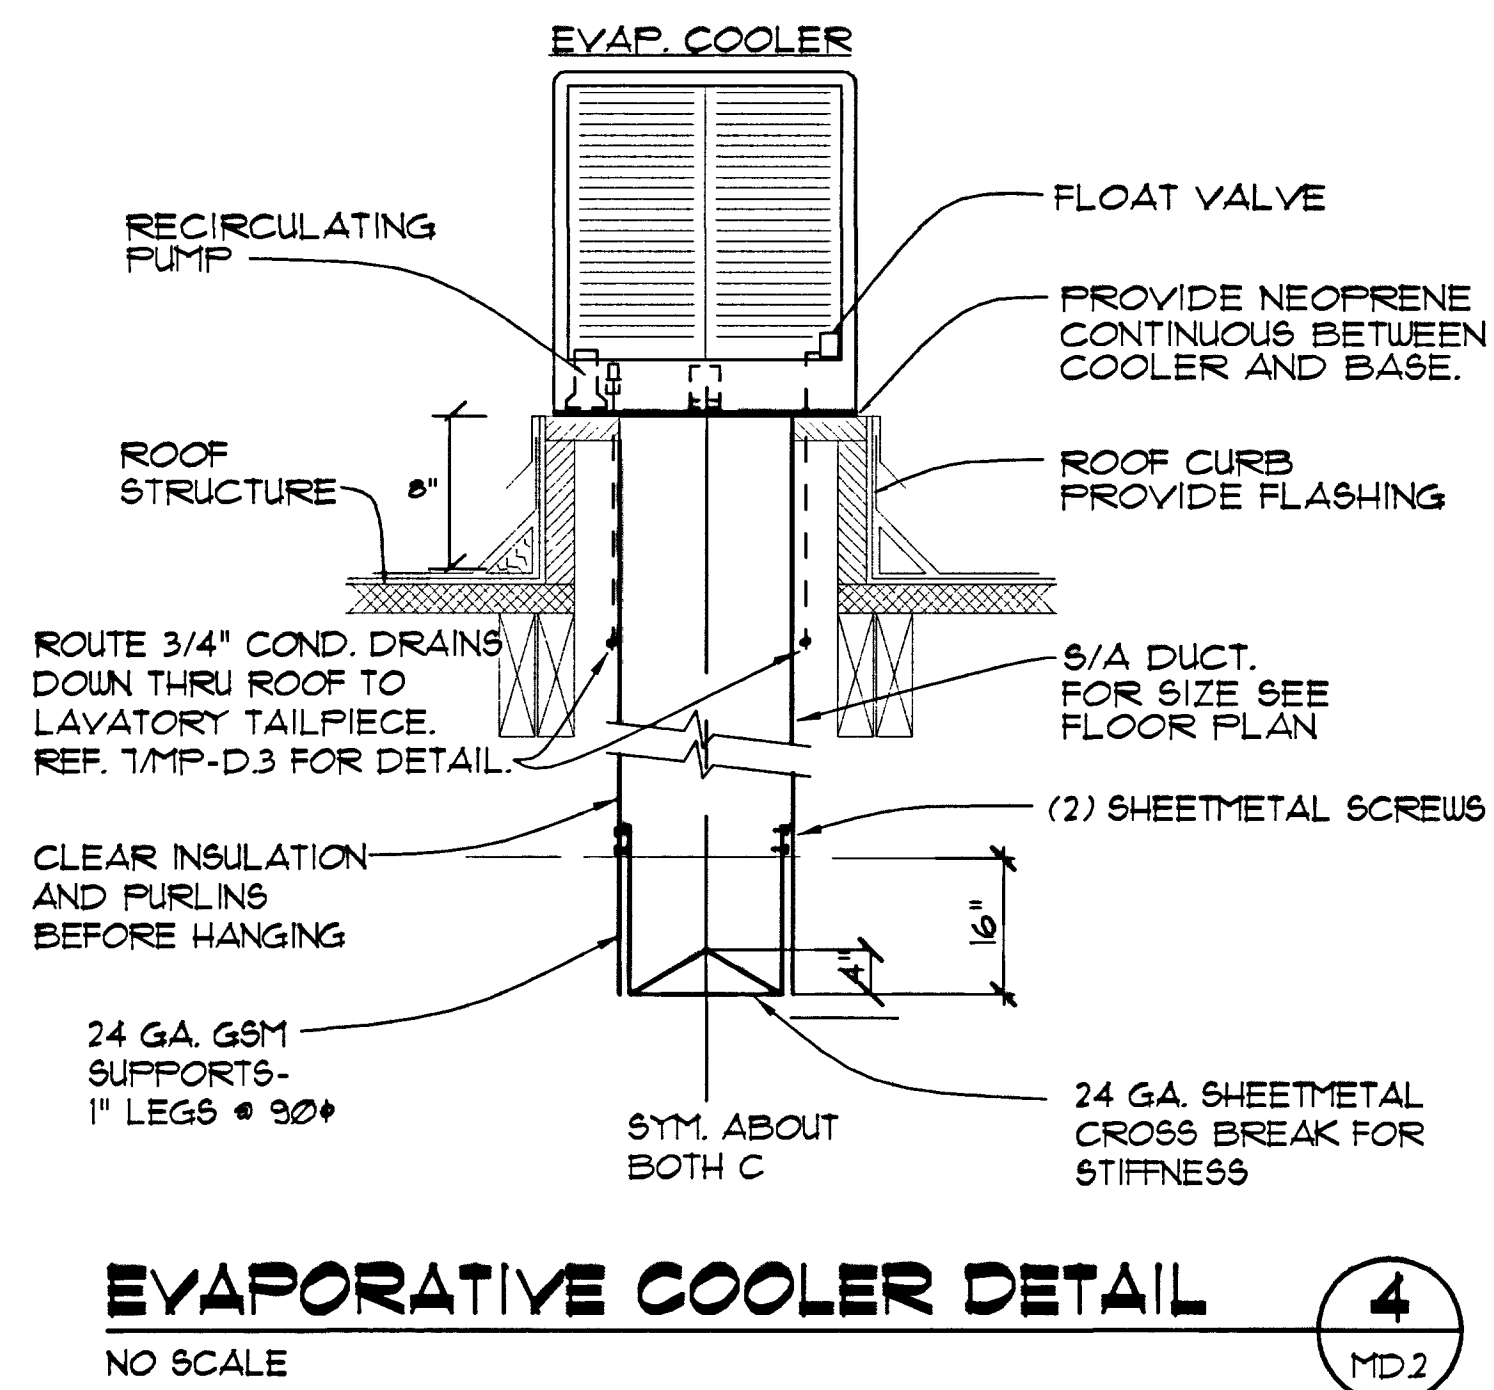
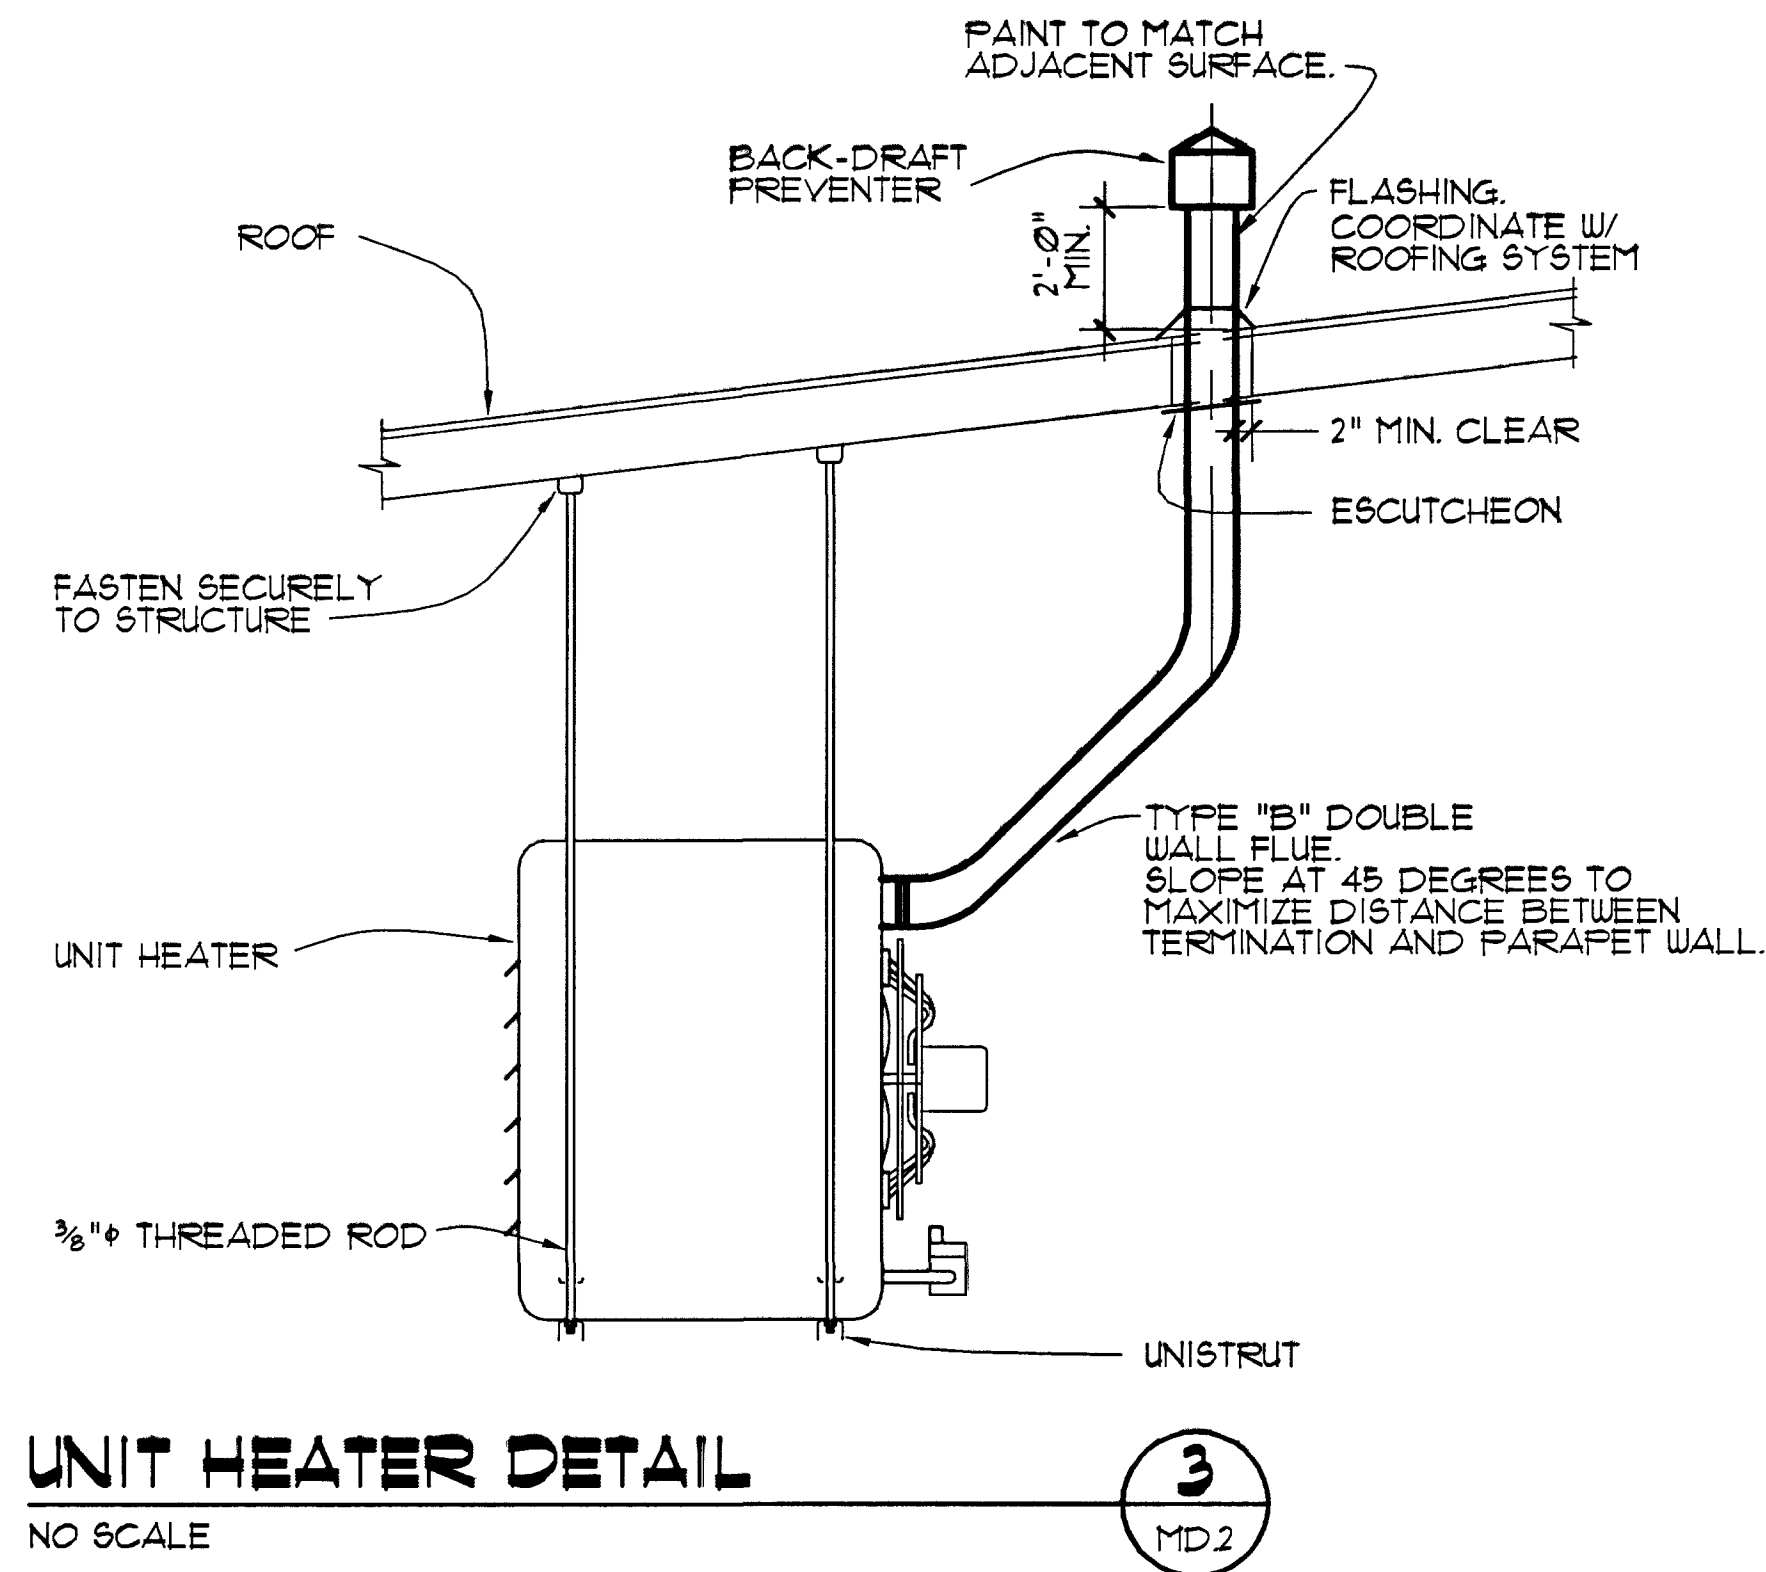
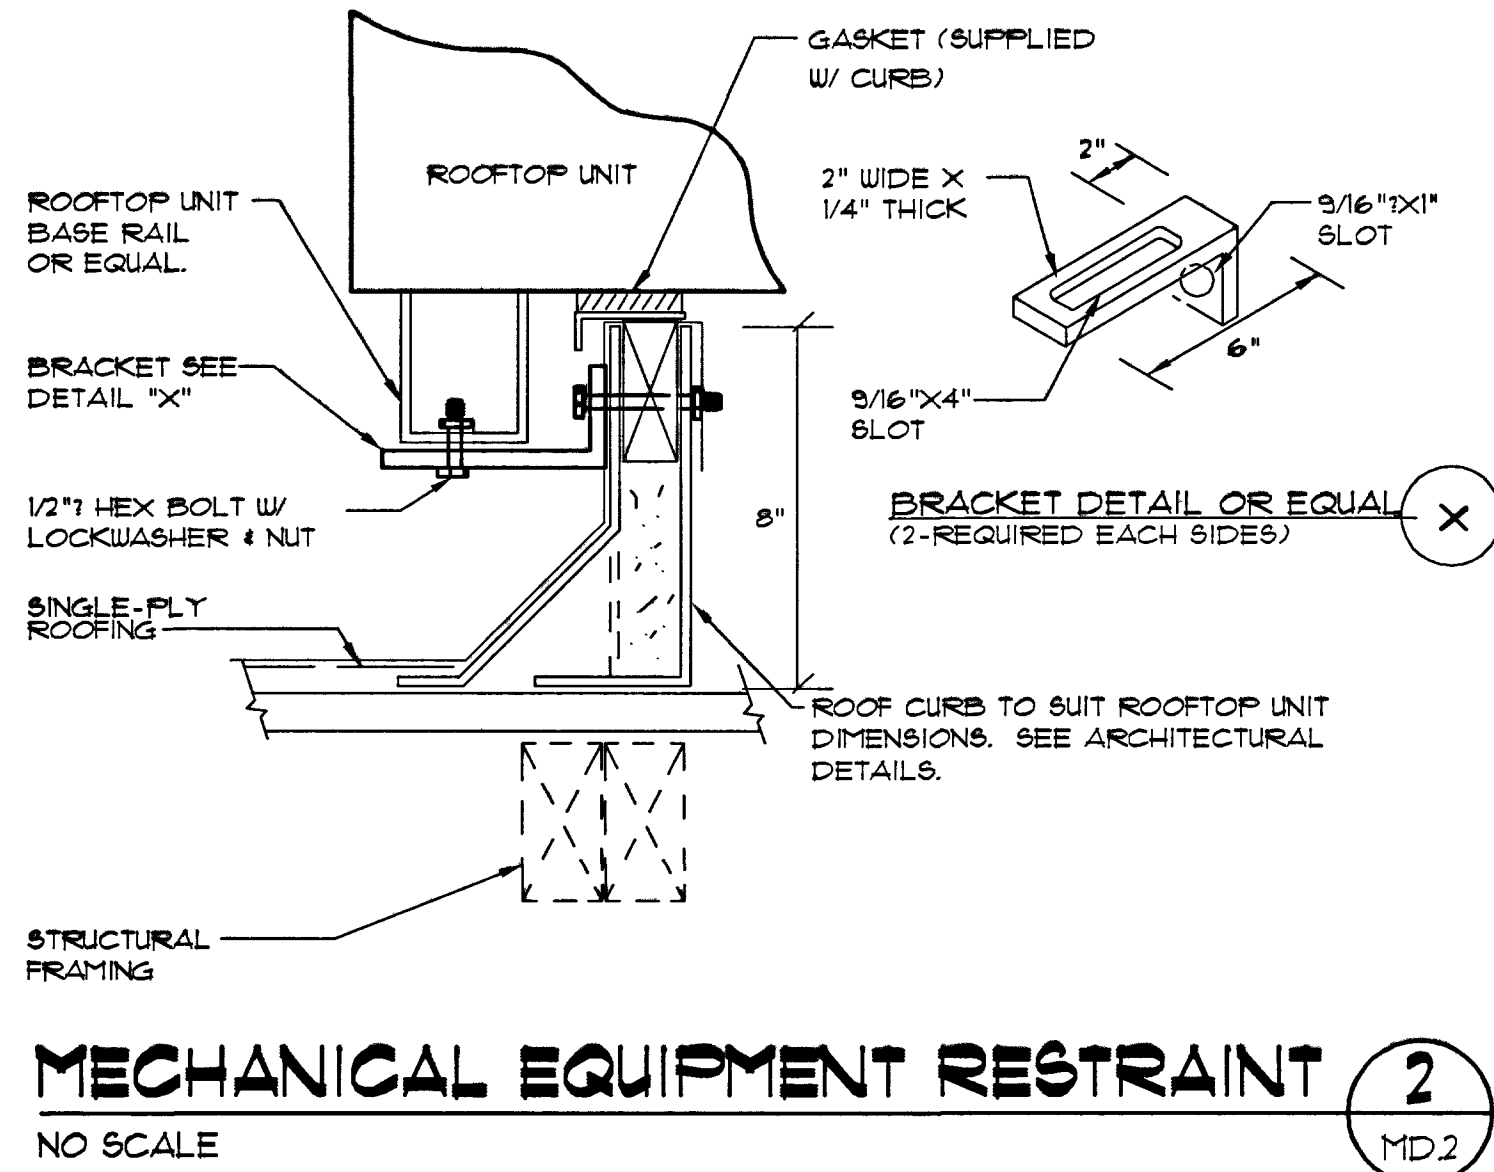


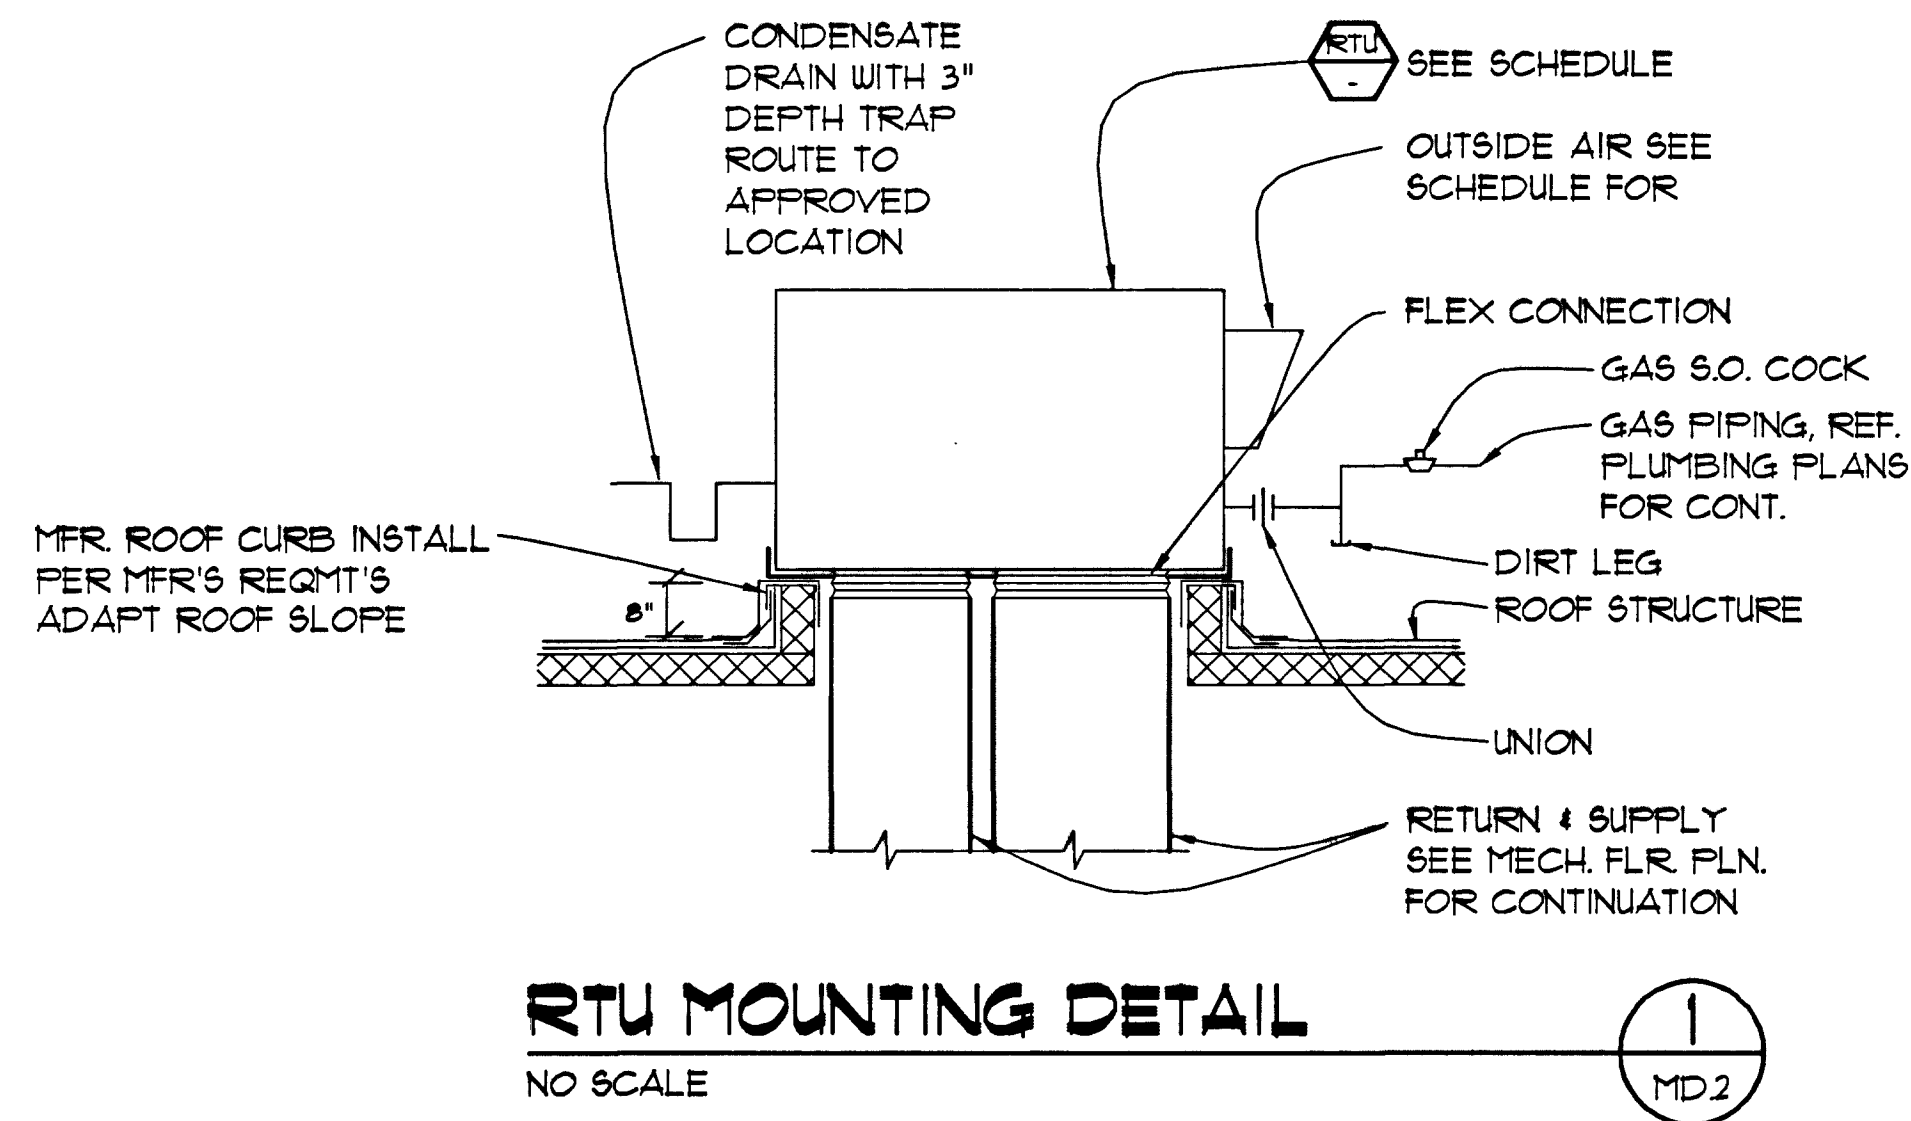

RECORD DRAWINGS
AS BUILT INFORMATION WAS PROVIDED BY THE CONTRACTOR. WESTAR ARCHITECTURAL ASSUMES NO LIABILITY FOR ACCURACY OF ITS CONTENTS.

WESTAR
ARCHITECTURAL GROUP, INC.
LAS VEGAS • PHOENIX
ARCHITECTURE • PLANNING • PROJECT MANAGEMENT
3900 MEADOWS LANE SUITE 220 LAS VEGAS, NEVADA 89107
TELEPHONE: (702) 878-0000 FAX: (702) 878-8430

A FACILITY IMPROVEMENT FOR:
FIRE STATION 2, 7, & 9
LAS VEGAS, NEVADA

PROJECT NUMBER	DATE	REVISION DESCRIPTION	DATE
01833			
DRAWN BY			
S.J.F.			
CHECKED BY			
KSD			
ISSUE DATE			
09-13-01			
SCALE			
NONE			
SHEET NUMBER			
630.99			
MD.2			