

This document, including the ideas and design it contains, is an instrument of professional services rendered by the Architect / Engineer. This document may not be used or copied in whole, or in part, for any purpose other than this specific project without the expressed written consent of Westar Architectural Group, Inc.

ABF CONSULTING ENGINEERS

ABF

Las Vegas, Nevada 89103
Tel:(702)248-0338
Sparks, Nevada 89431
Tel:(775)574-2222
Phoenix, Arizona 85014
Tel:(602)274-1801

THE ENGINEER ACCEPTS NO LIABILITY FOR ANY RESPONSIBILITY FOR THESE DOCUMENTS, UNLESS THE ENGINEER HAS BEEN ADVISED IN WRITING TO THE CONTRARY.

SEAL

FINAL


REGISTERED PROFESSIONAL ENGINEER STATE OF NEVADA

ROBERT E. ASH

Exp. Date: 31.2020

ELECTRICAL

REGISTERED NO. 1317

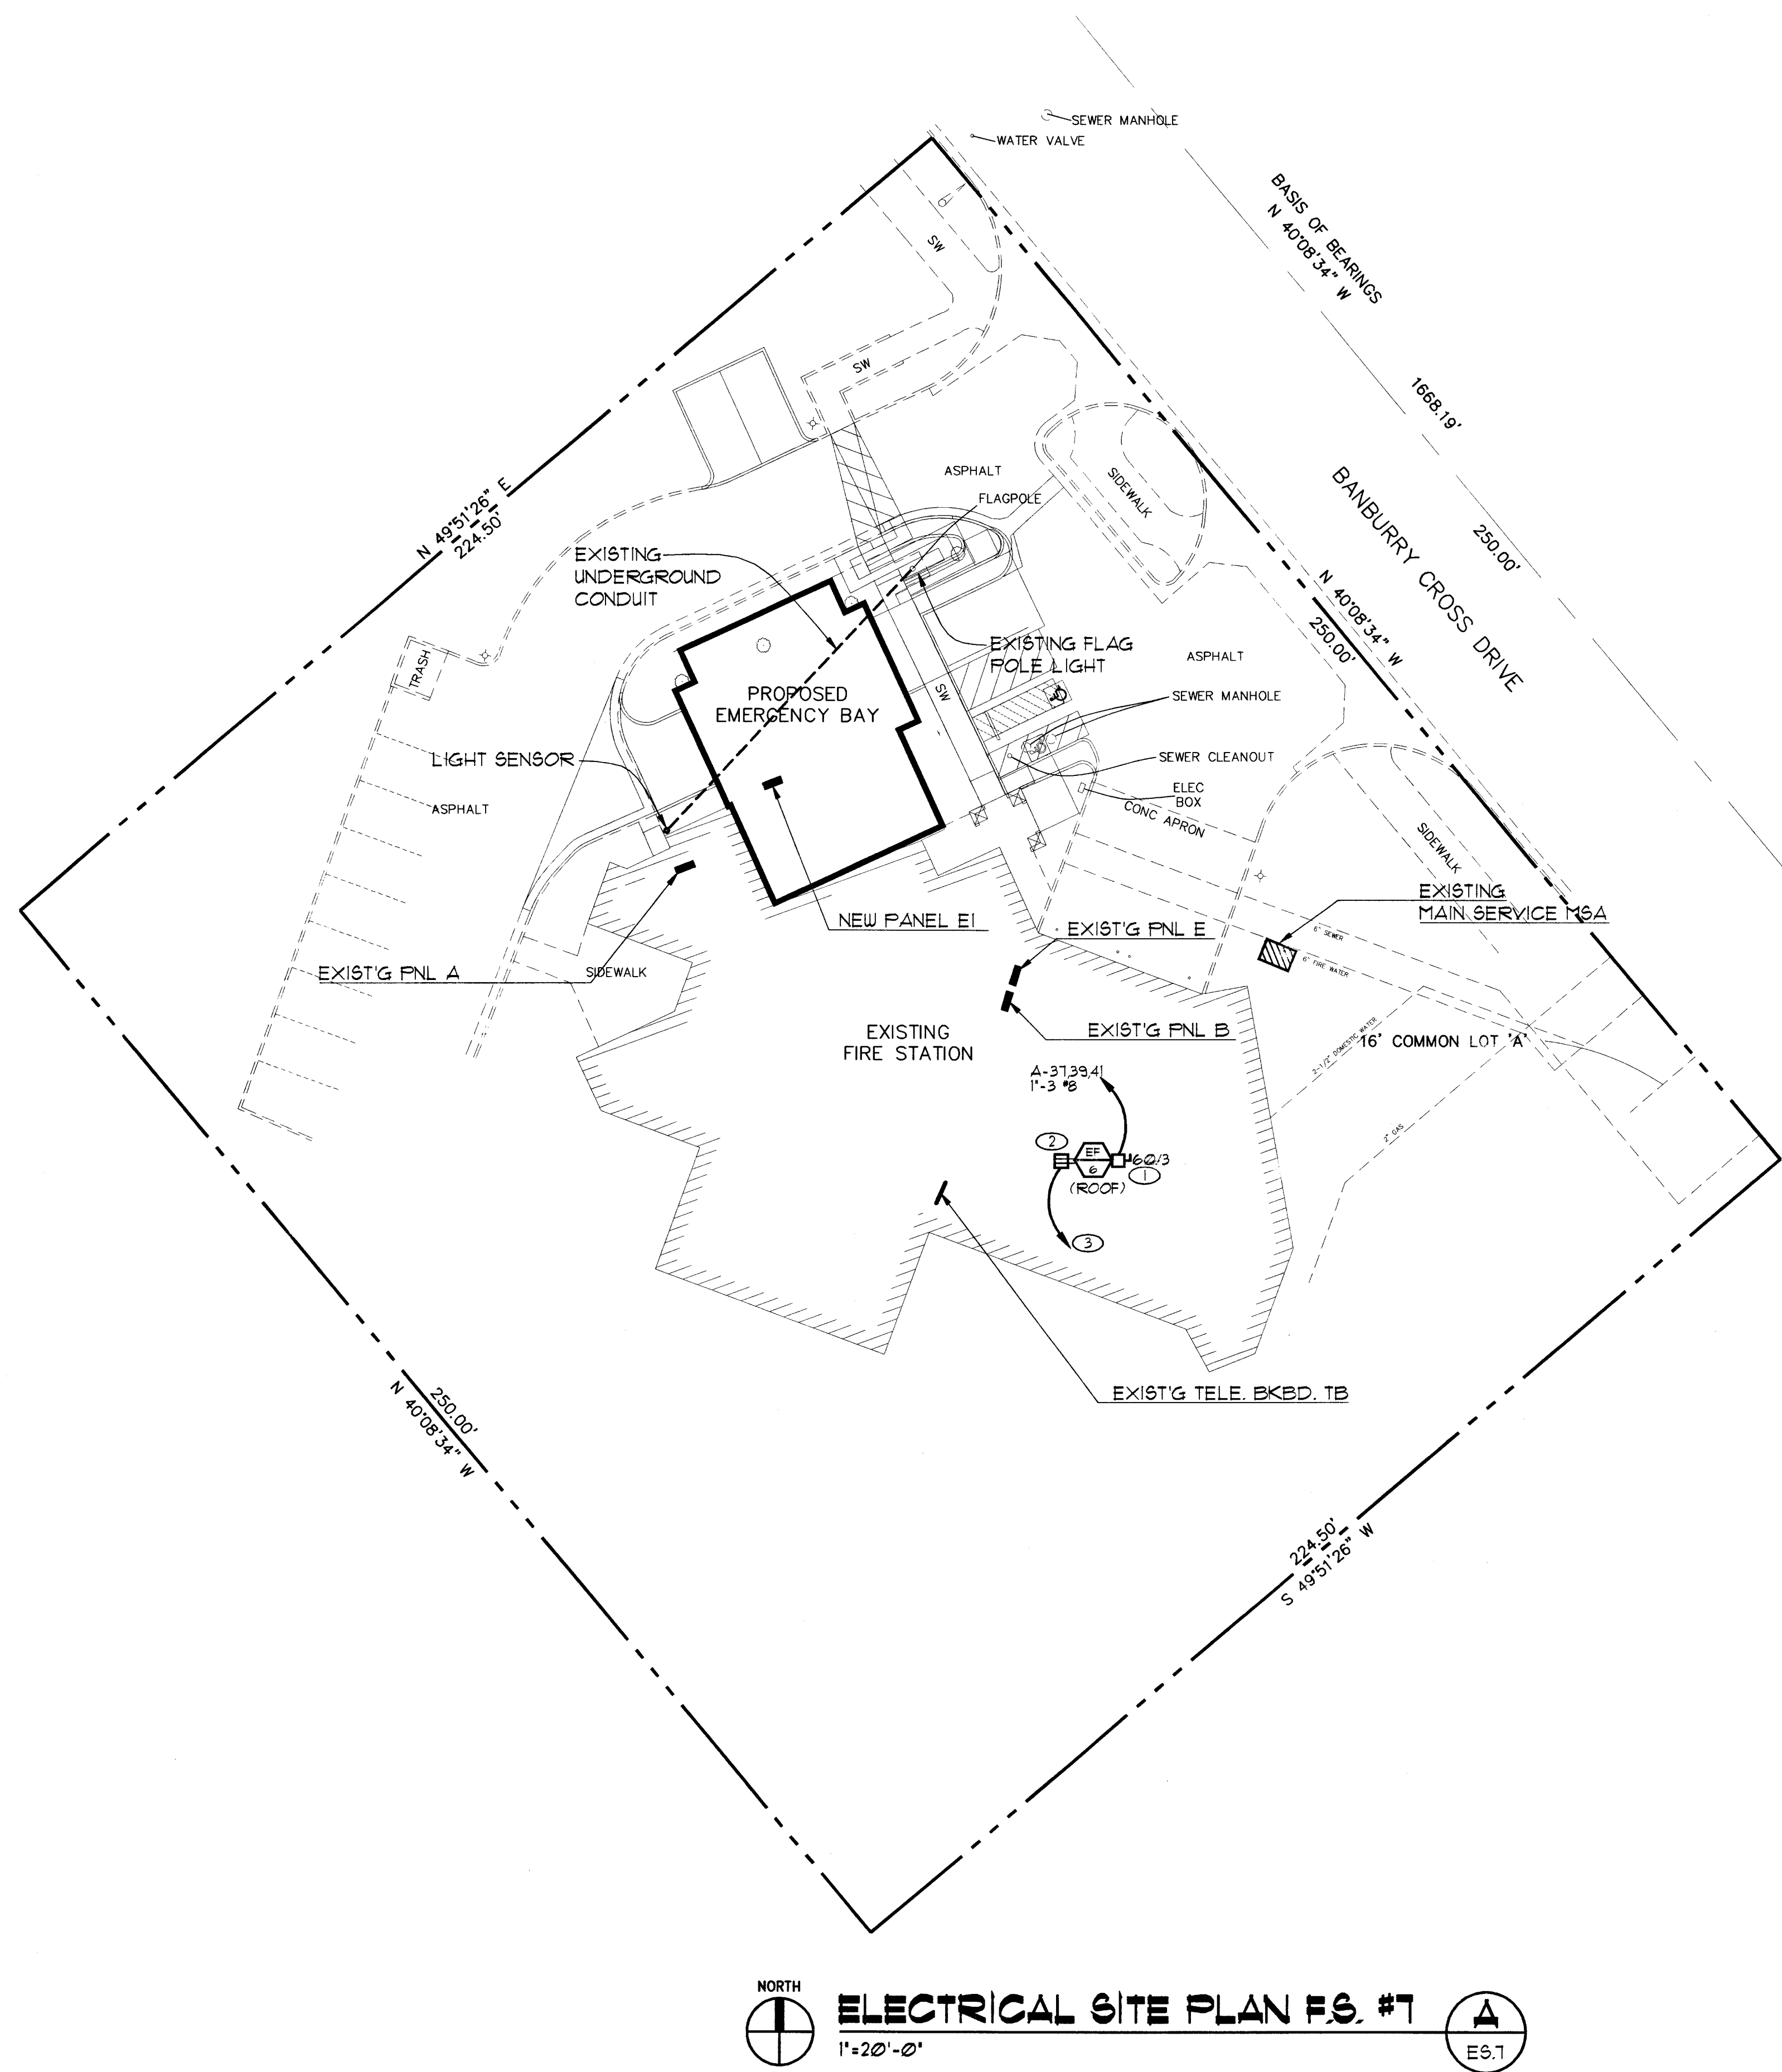

- ### NOTES
1. PROVIDE WP COMBINATION FUSED DISCONNECT SWITCH WITH FUSES SIZED PER HVAC EQUIPMENT MANUFACTURER'S RECOMMENDATION. SIZE 1" STARTER ON-OFF SWITCH, 120V CONTROL XFMR, AMBIENT COMP OVERLOADS, AUXILIARY CONTACTS AND OVERLOADS. VERIFY WITH MECHANICAL PRIOR TO INSTALLATION.
 2. PROVIDE WP GFI DUPLEX MAINTENANCE RECEPTACLE ON ROOF.
 3. CIRCUIT DOWN TO NEAREST 120V. RECEPTACLE CIRCUIT WITH SPARE AMPACITY.

WESTAR

ARCHITECTURAL GROUP, / NEVADA INC.

LAS VEGAS * PHOENIX

ARCHITECTURE * PLANNING * PROJECT MANAGEMENT

3900 MEADOWS LANE SUITE 220 LAS VEGAS, NEVADA 89107

TELEPHONE: (702) 878-0000 FAX: (702) 878-8430

A FACILITY IMPROVEMENT FOR:

FIRE STATION 2, 7, & 9

LAS VEGAS, NEVADA

PROJECT NUMBER		01633									
DRAWN BY		GGG		CHECKED BY							
N.B.		GGG									
DATE		08-18-01									
SCALE		1"=20'-0"									
				NUMBER				REVISION DESCRIPTION			

AS BUILT 8/23/04

ES.7