


This document, including the ideas and designs it contains, is an instrument of professional services rendered by the Architect / Engineer. This document may not be used or copied in whole, or in part, for any purpose other than this specific project without the expressed written consent of Westar Architectural Group, Inc.






ABF CONSULTING ENGINEERS
Las Vegas, Nevada 89103
Tel: (702) 246-0338
Sparks, Nevada 89431
Tel: (775) 674-2222
Phoenix, Arizona 85014
Tel: (602) 274-1801
THE ENGINEER ACCEPTS NO LIABILITY FOR THESE DOCUMENTS WITHOUT THE DESIGN, CALCULATIONS, AND/OR CONSTRUCTION OF ANY TYPE.

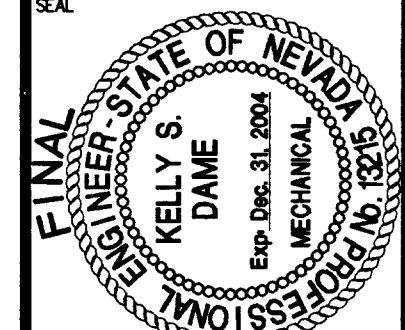

WESTAR
ARCHITECTURAL GROUP, / NEVADA INC.
LAS VEGAS * PHOENIX
ARCHITECTURE * PLANNING * PROJECT MANAGEMENT
3900 MEADOWS LANE SUITE 220 LAS VEGAS, NEVADA 89107
TELEPHONE: (702) 878-0000 FAX: (702) 878-8430

A FACILITY IMPROVEMENT FOR:
FIRE STATION 27, & 9
LAS VEGAS, NEVADA

PROJECT NUMBER	01633	DATE	REVISION DESCRIPTION	NUMBER
DRAWN BY	S.J.F.	DESIGNED BY	KSD	
DATE	09-10-01	SCALE	NONE	
SHEET NUMBER	MD.2			

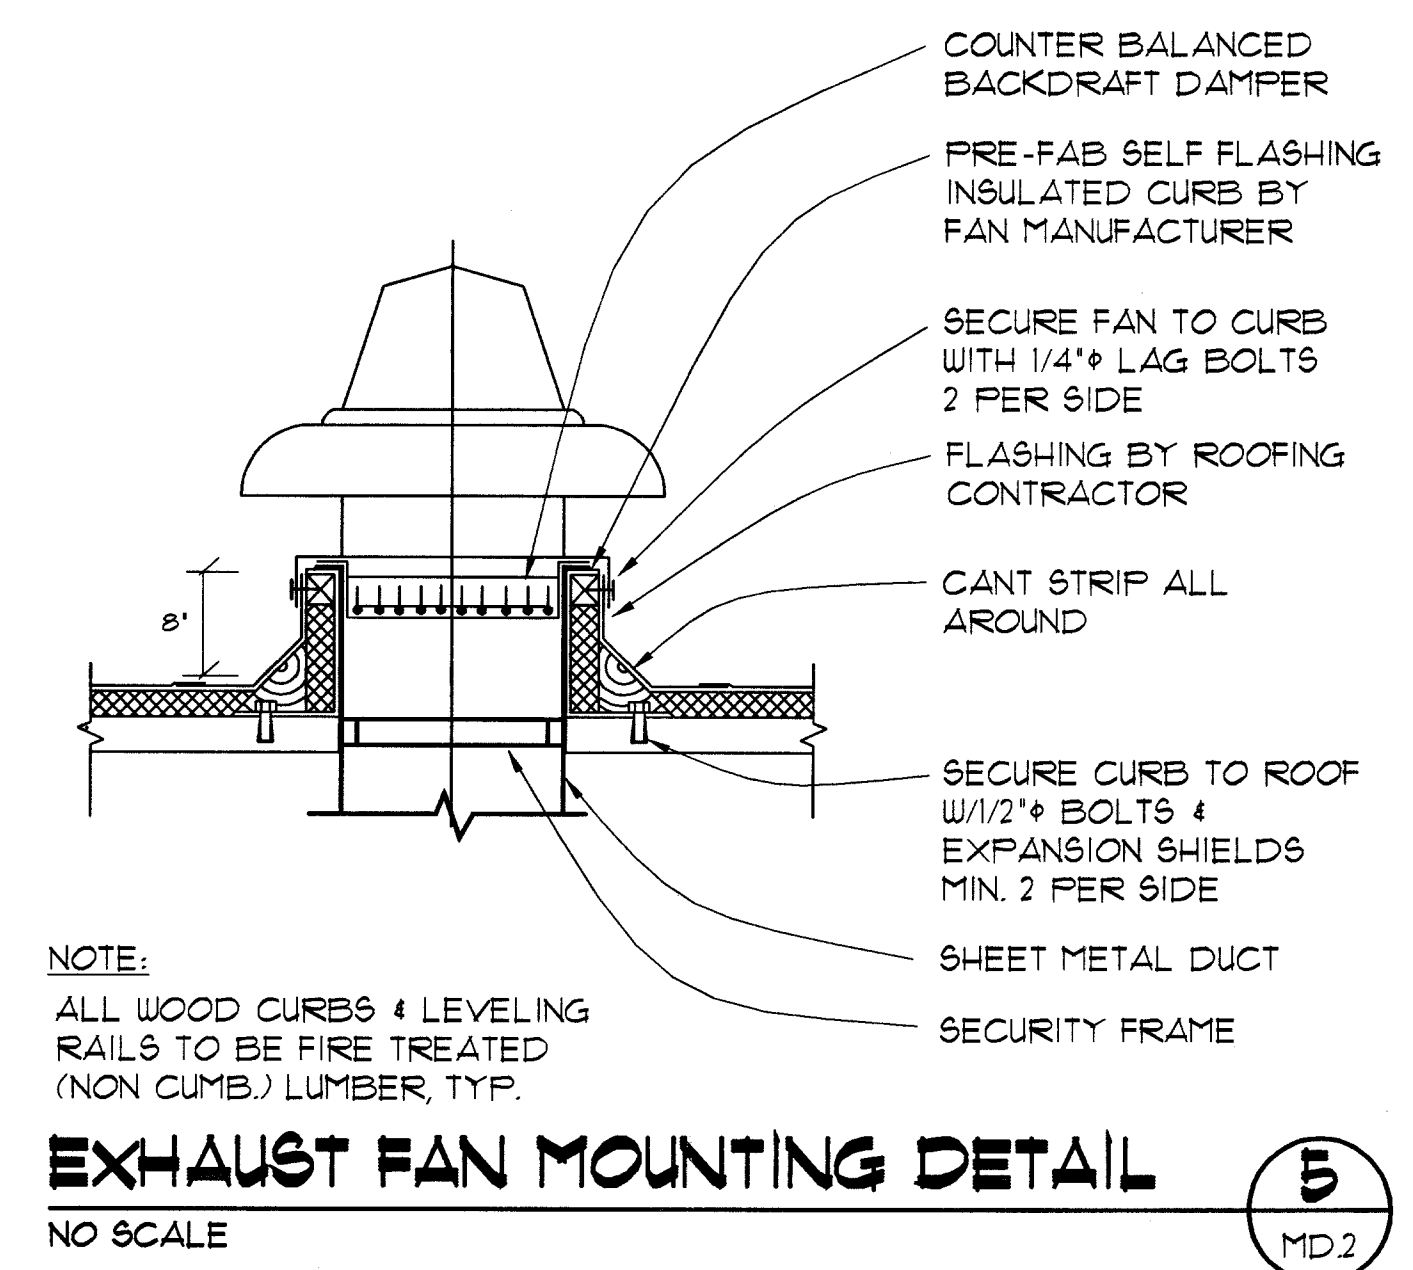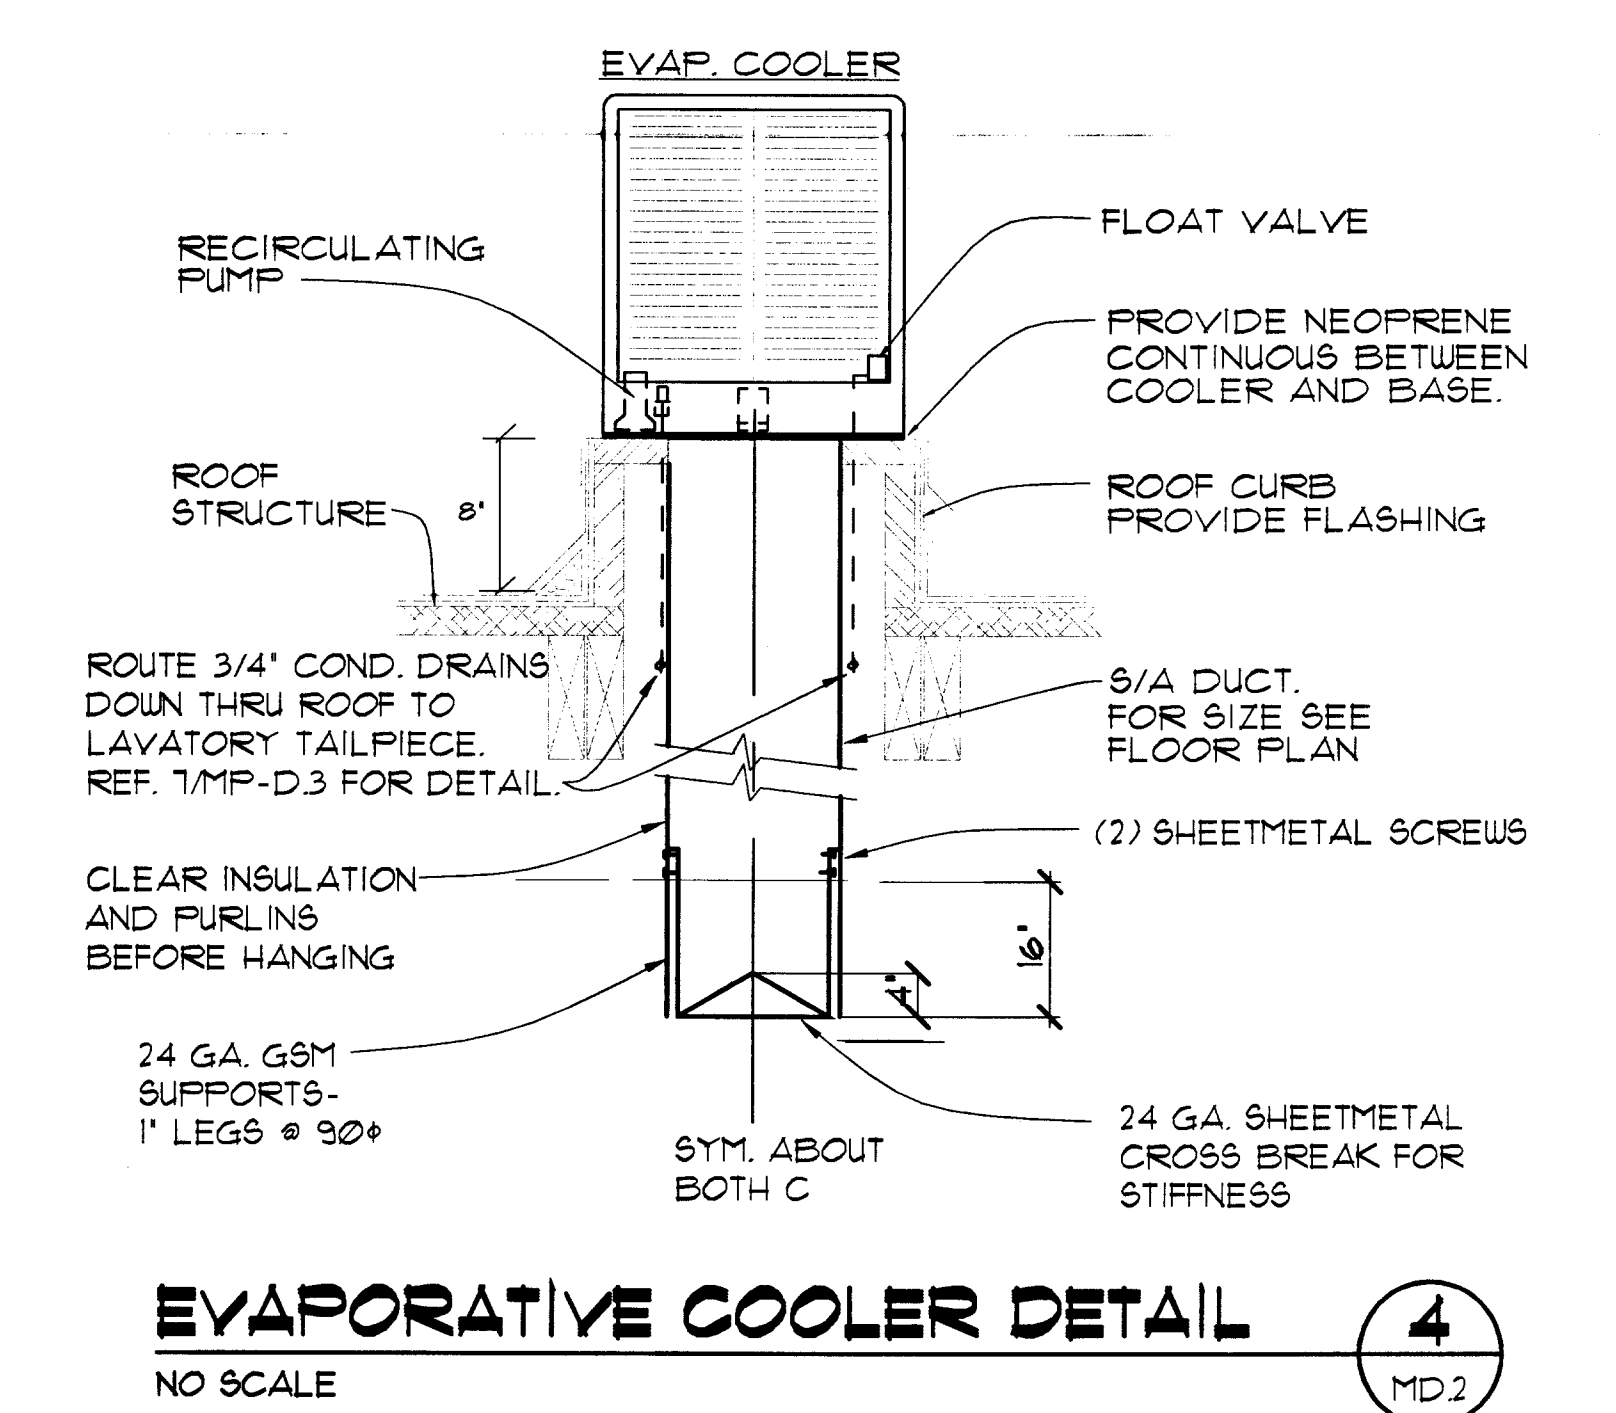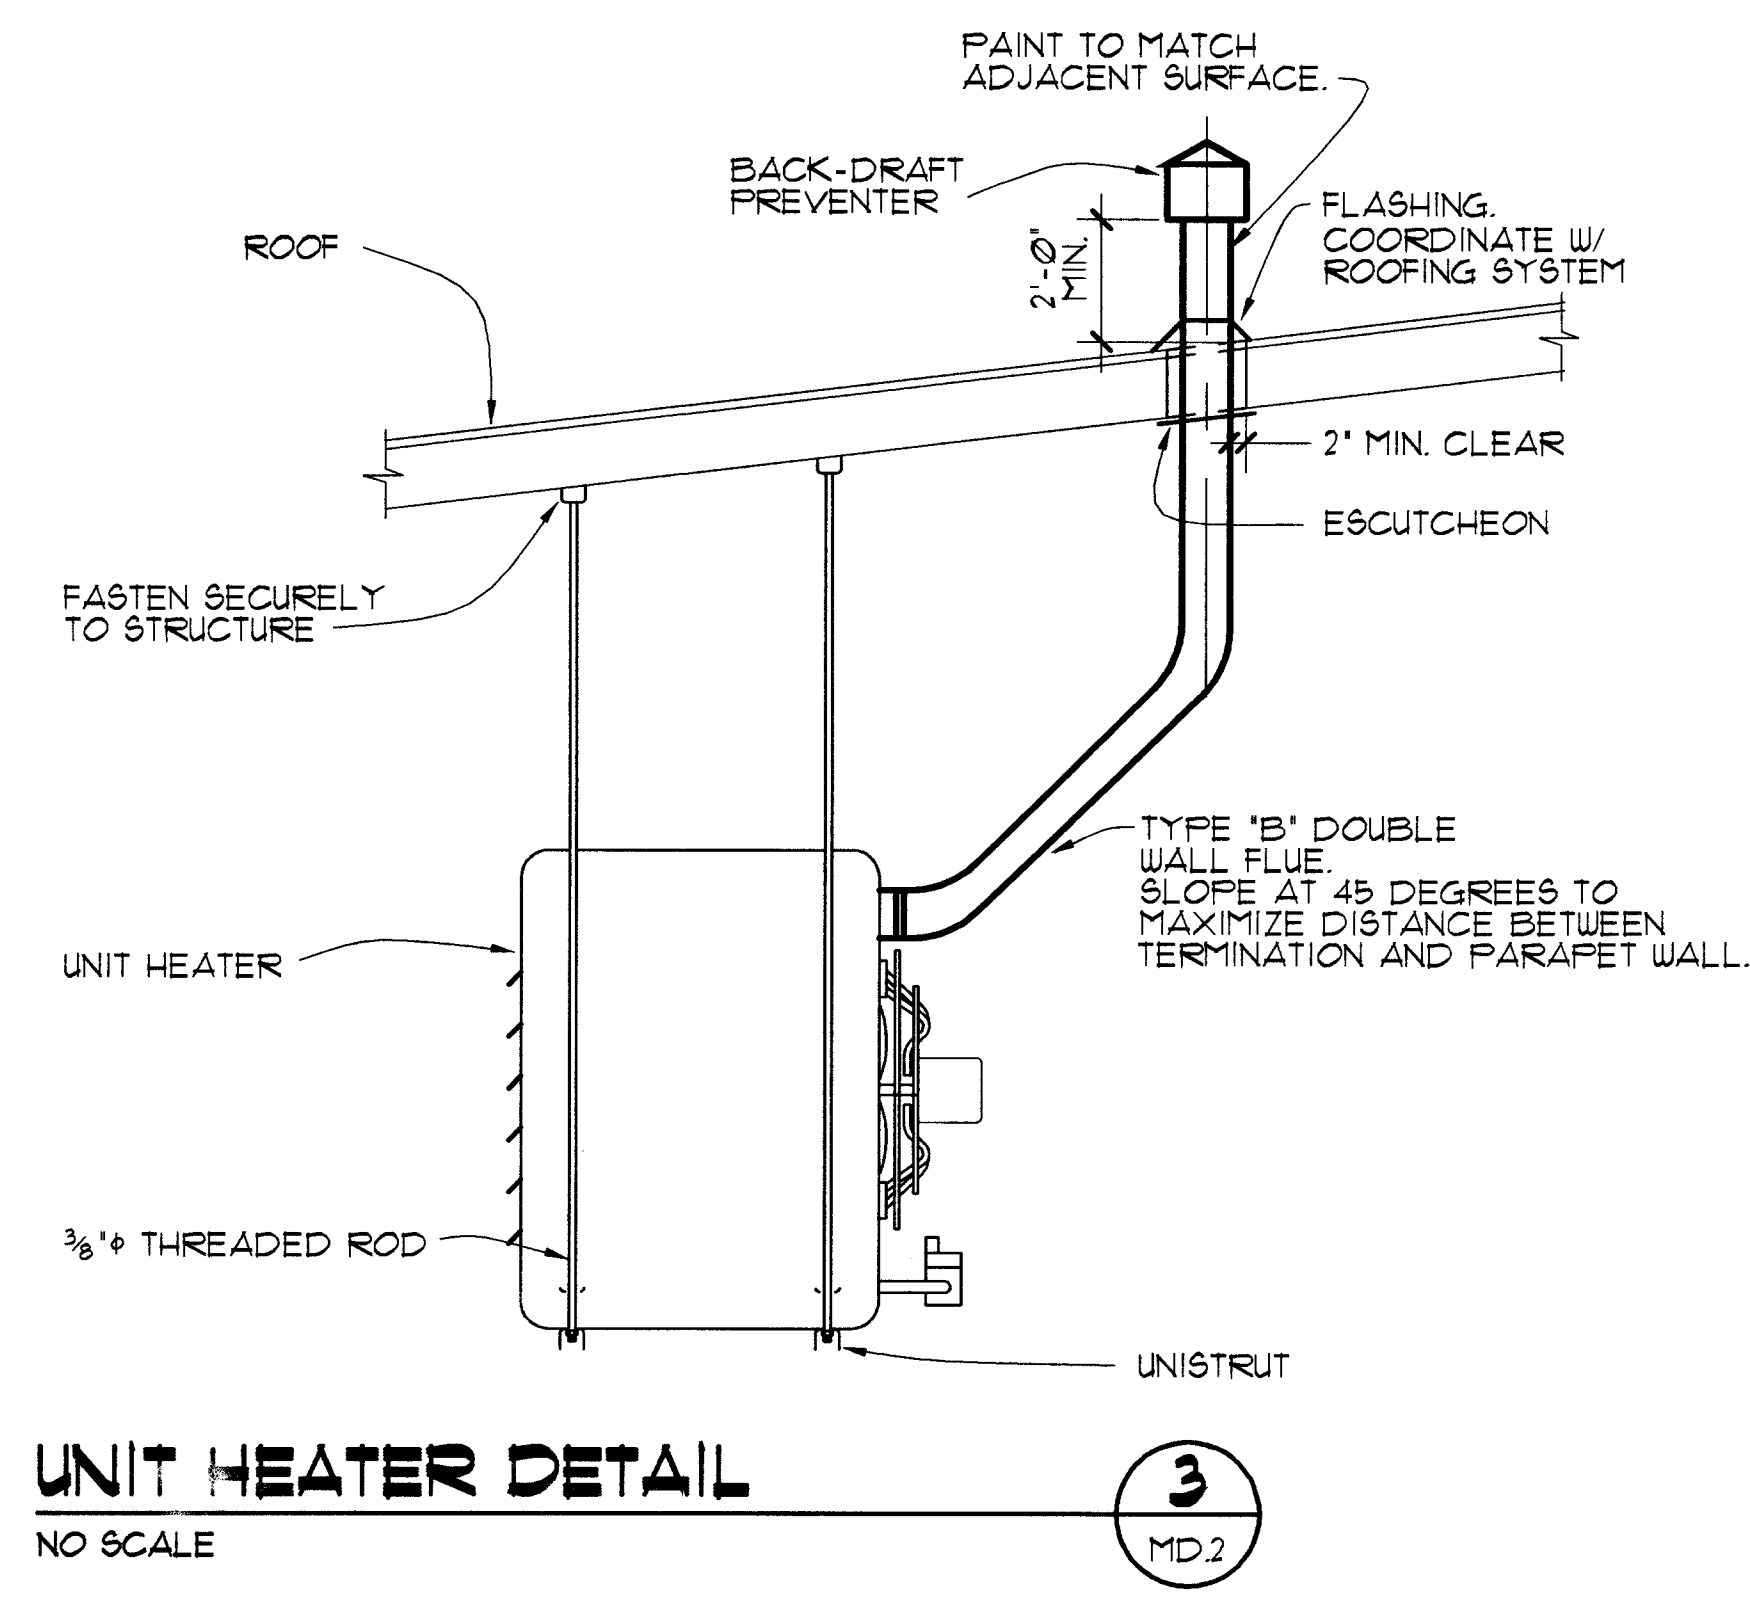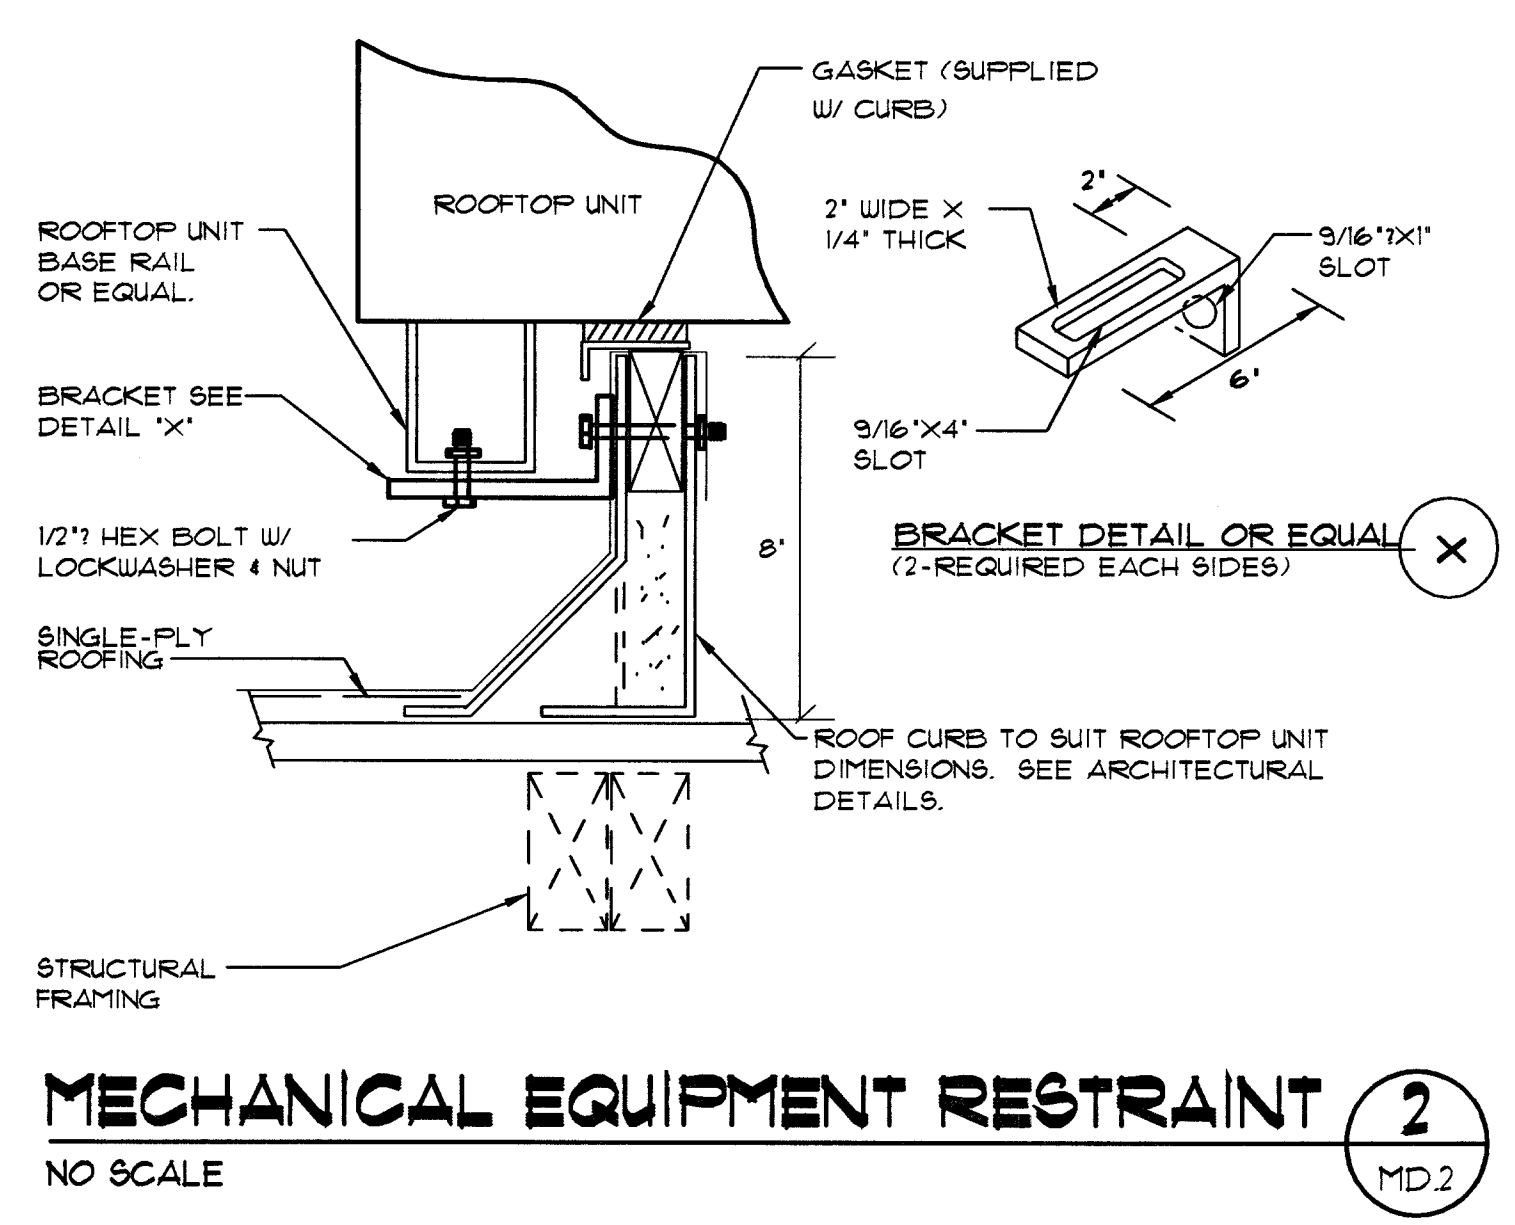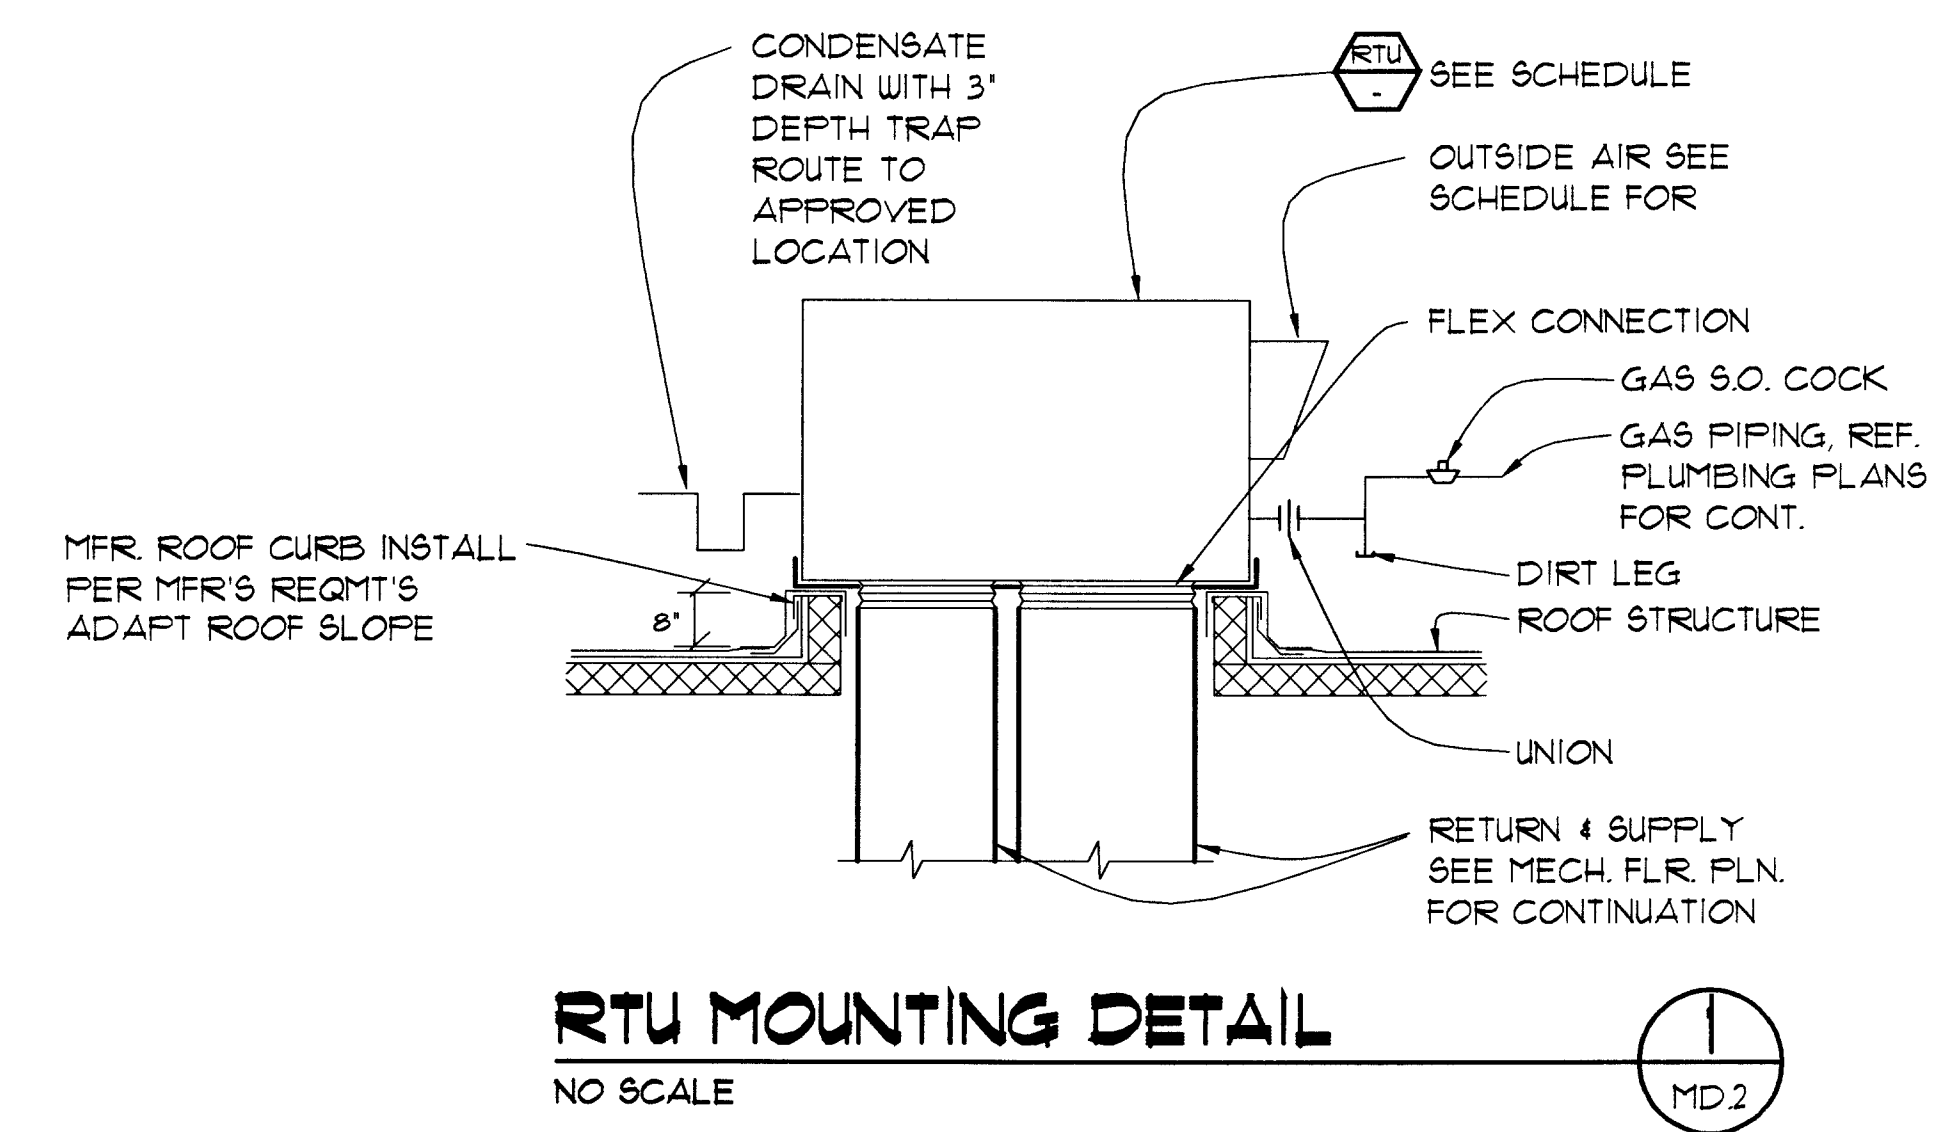

AS BUILT 8/23/04