

Mayor:

OSCAR B. GOODMAN

Councilmen:

GARY REESE
(MAYOR PRO-TEM)
MICHAEL J. McDONALD
LARRY BROWN
LYNETTE B. McDONALD
LAWRENCE WEEKLY
MICHAEL MACK

City Manager:

VIRGINIA VALENTINE

Director of Public Works:


RICHARD D. GOECKE

City Engineer:

CHARLES KAJKOWSKI, JR., P.E.

Funded by :

CITY OF LAS VEGAS

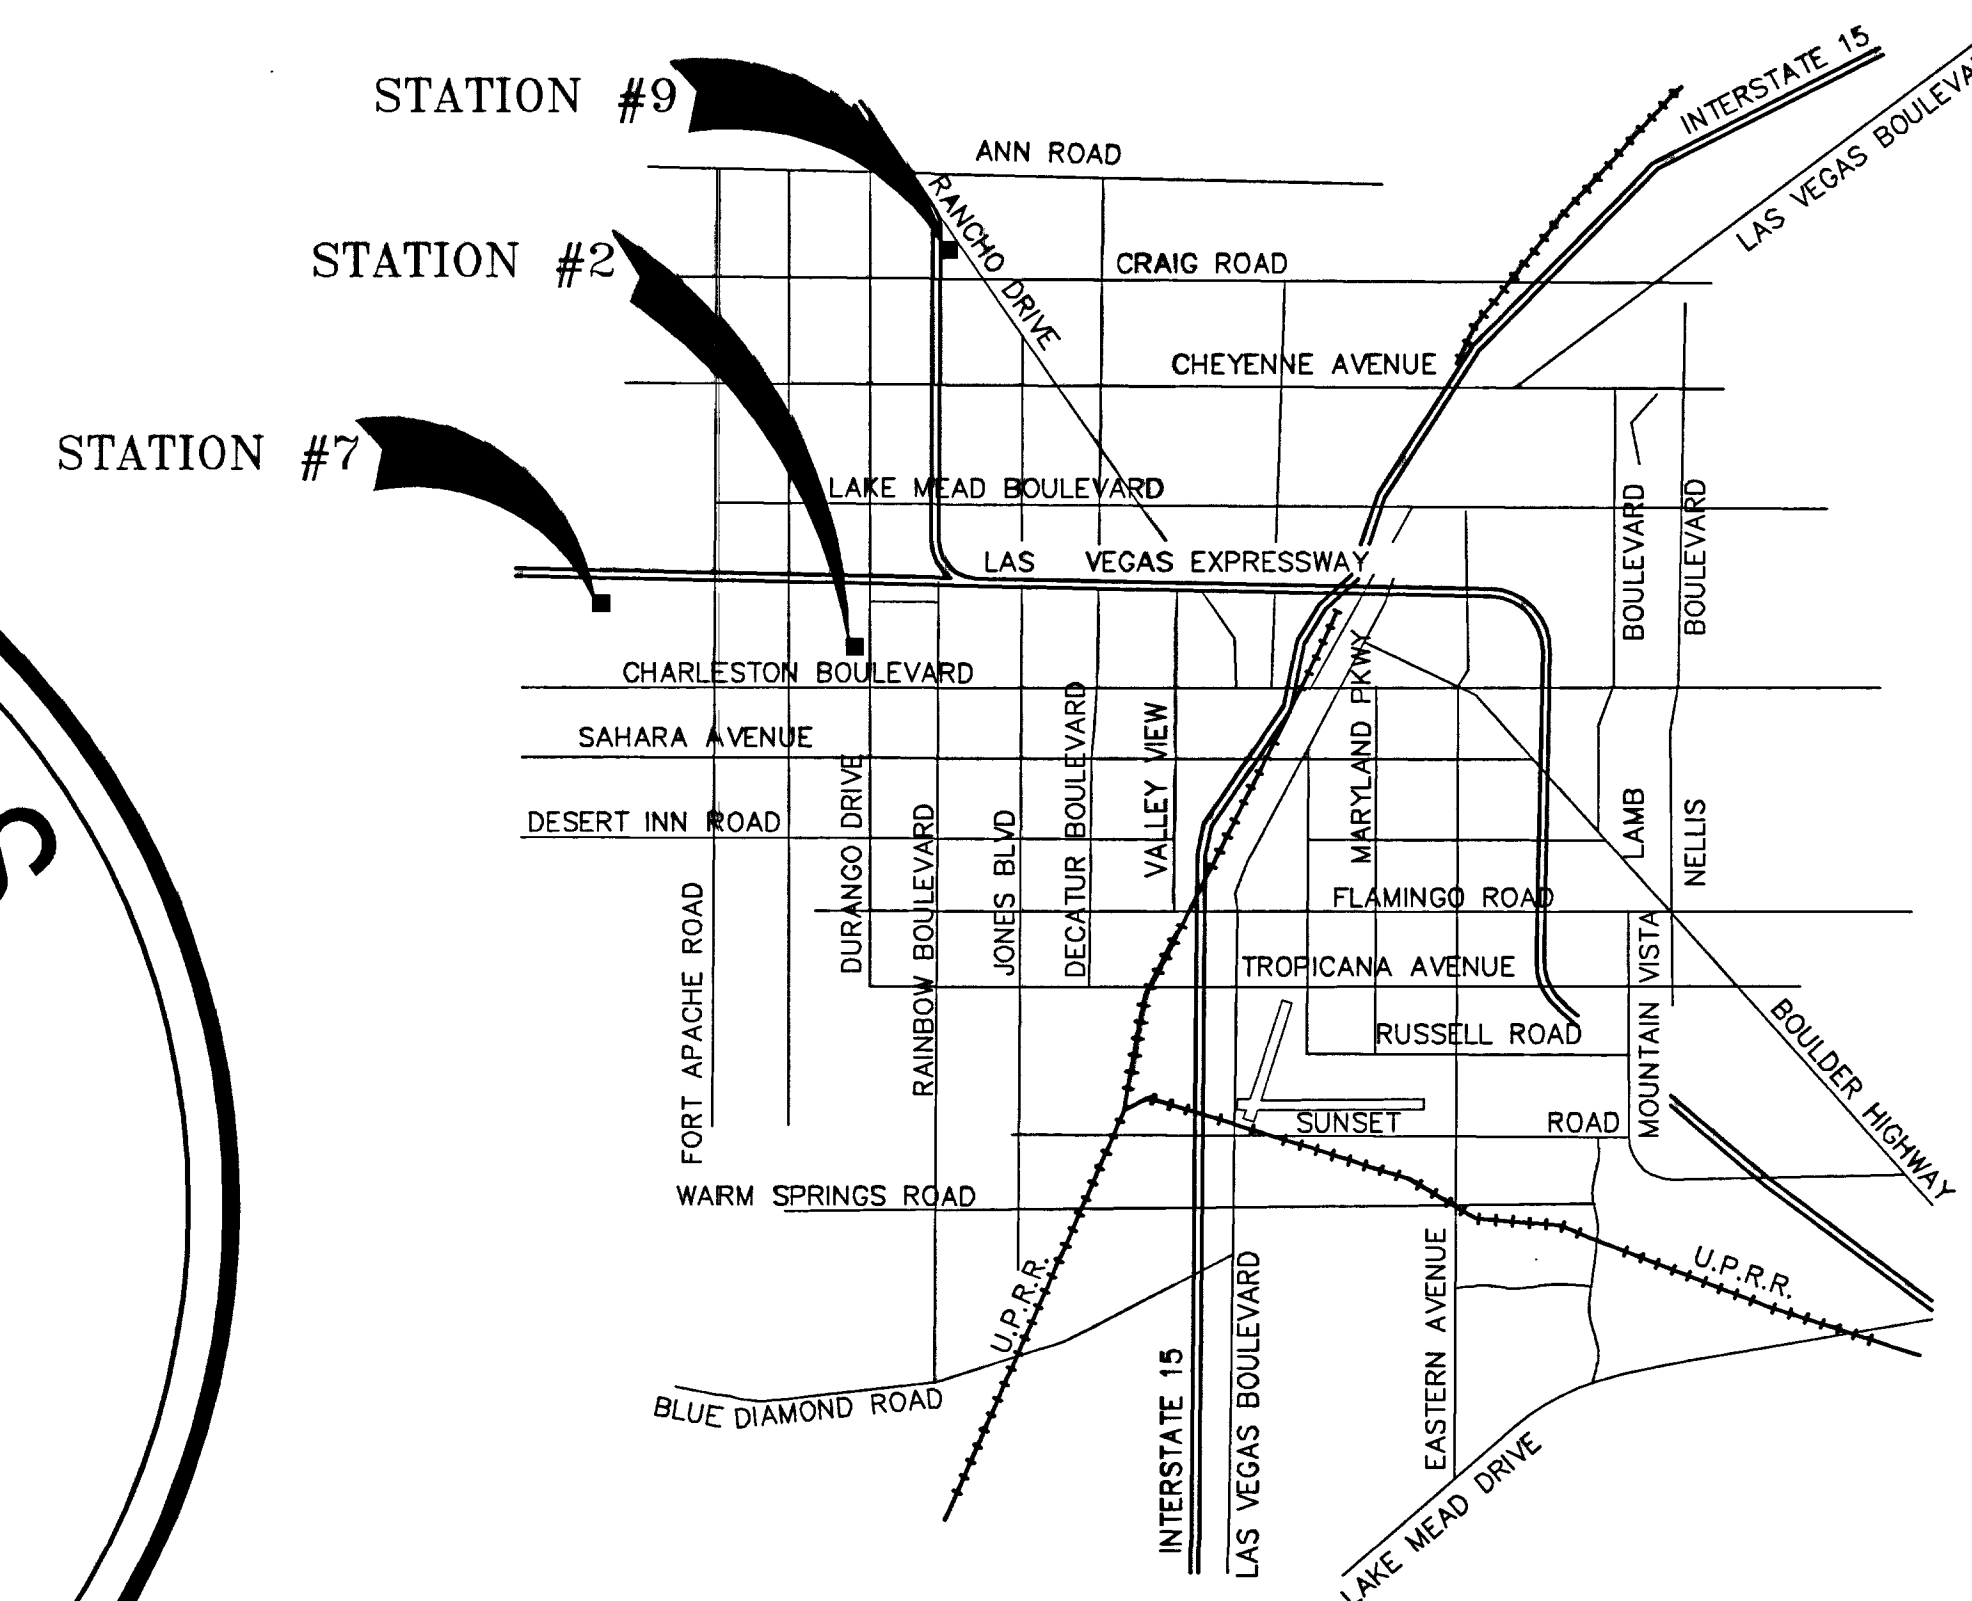

VICINITY MAP

SCALE: N.T.S.



A FACILITY IMPROVEMENT FOR FIRE STATION 2,7,&9 CONSTRUCTION DOCUMENTS


BID NO. 01.15301.25

PLANS LIBRARY NO. 630.99

RECORD DRAWINGS

AS BUILT INFORMATION WAS PROVIDED
BY THE CONTRACTOR. WESTAR
ARCHITECTURAL ASSUMES NO LIABILITY
FOR ACCURACY OF ITS CONTENTS.

WESTAR
ARCHITECTURAL GROUP, INC. / NEVADA INC.
LAS VEGAS • PHOENIX
ARCHITECTURE • PLANNING • PROJECT MANAGEMENT
3900 MEADOWS LANE SUITE 220 LAS VEGAS, NEVADA 89107
TELEPHONE: (702) 878-0000 FAX: (702) 878-0430

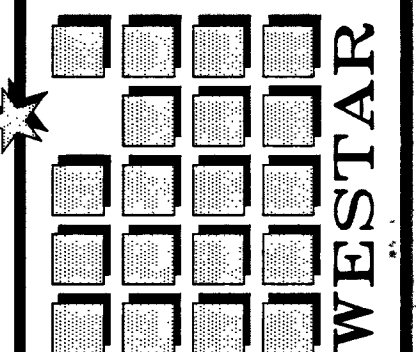

A FACILITY IMPROVEMENT FOR:
FIRE STATION 2,7, & 9
LAS VEGAS, NEVADA

PROJECT NUMBER	DATE	REVISION DESCRIPTION	DATE
0633	03/17/03	1. AS BUILT'S CORRECTIONS	
0633	03/17/03	2. AS BUILT'S CORRECTIONS	
0633	03/17/03	3. AS BUILT'S CORRECTIONS	
0633	03/17/03	4. AS BUILT'S CORRECTIONS	
0633	03/17/03	5. AS BUILT'S CORRECTIONS	
0633	03/17/03	6. AS BUILT'S CORRECTIONS	
0633	03/17/03	7. AS BUILT'S CORRECTIONS	

630.99
GO.11