




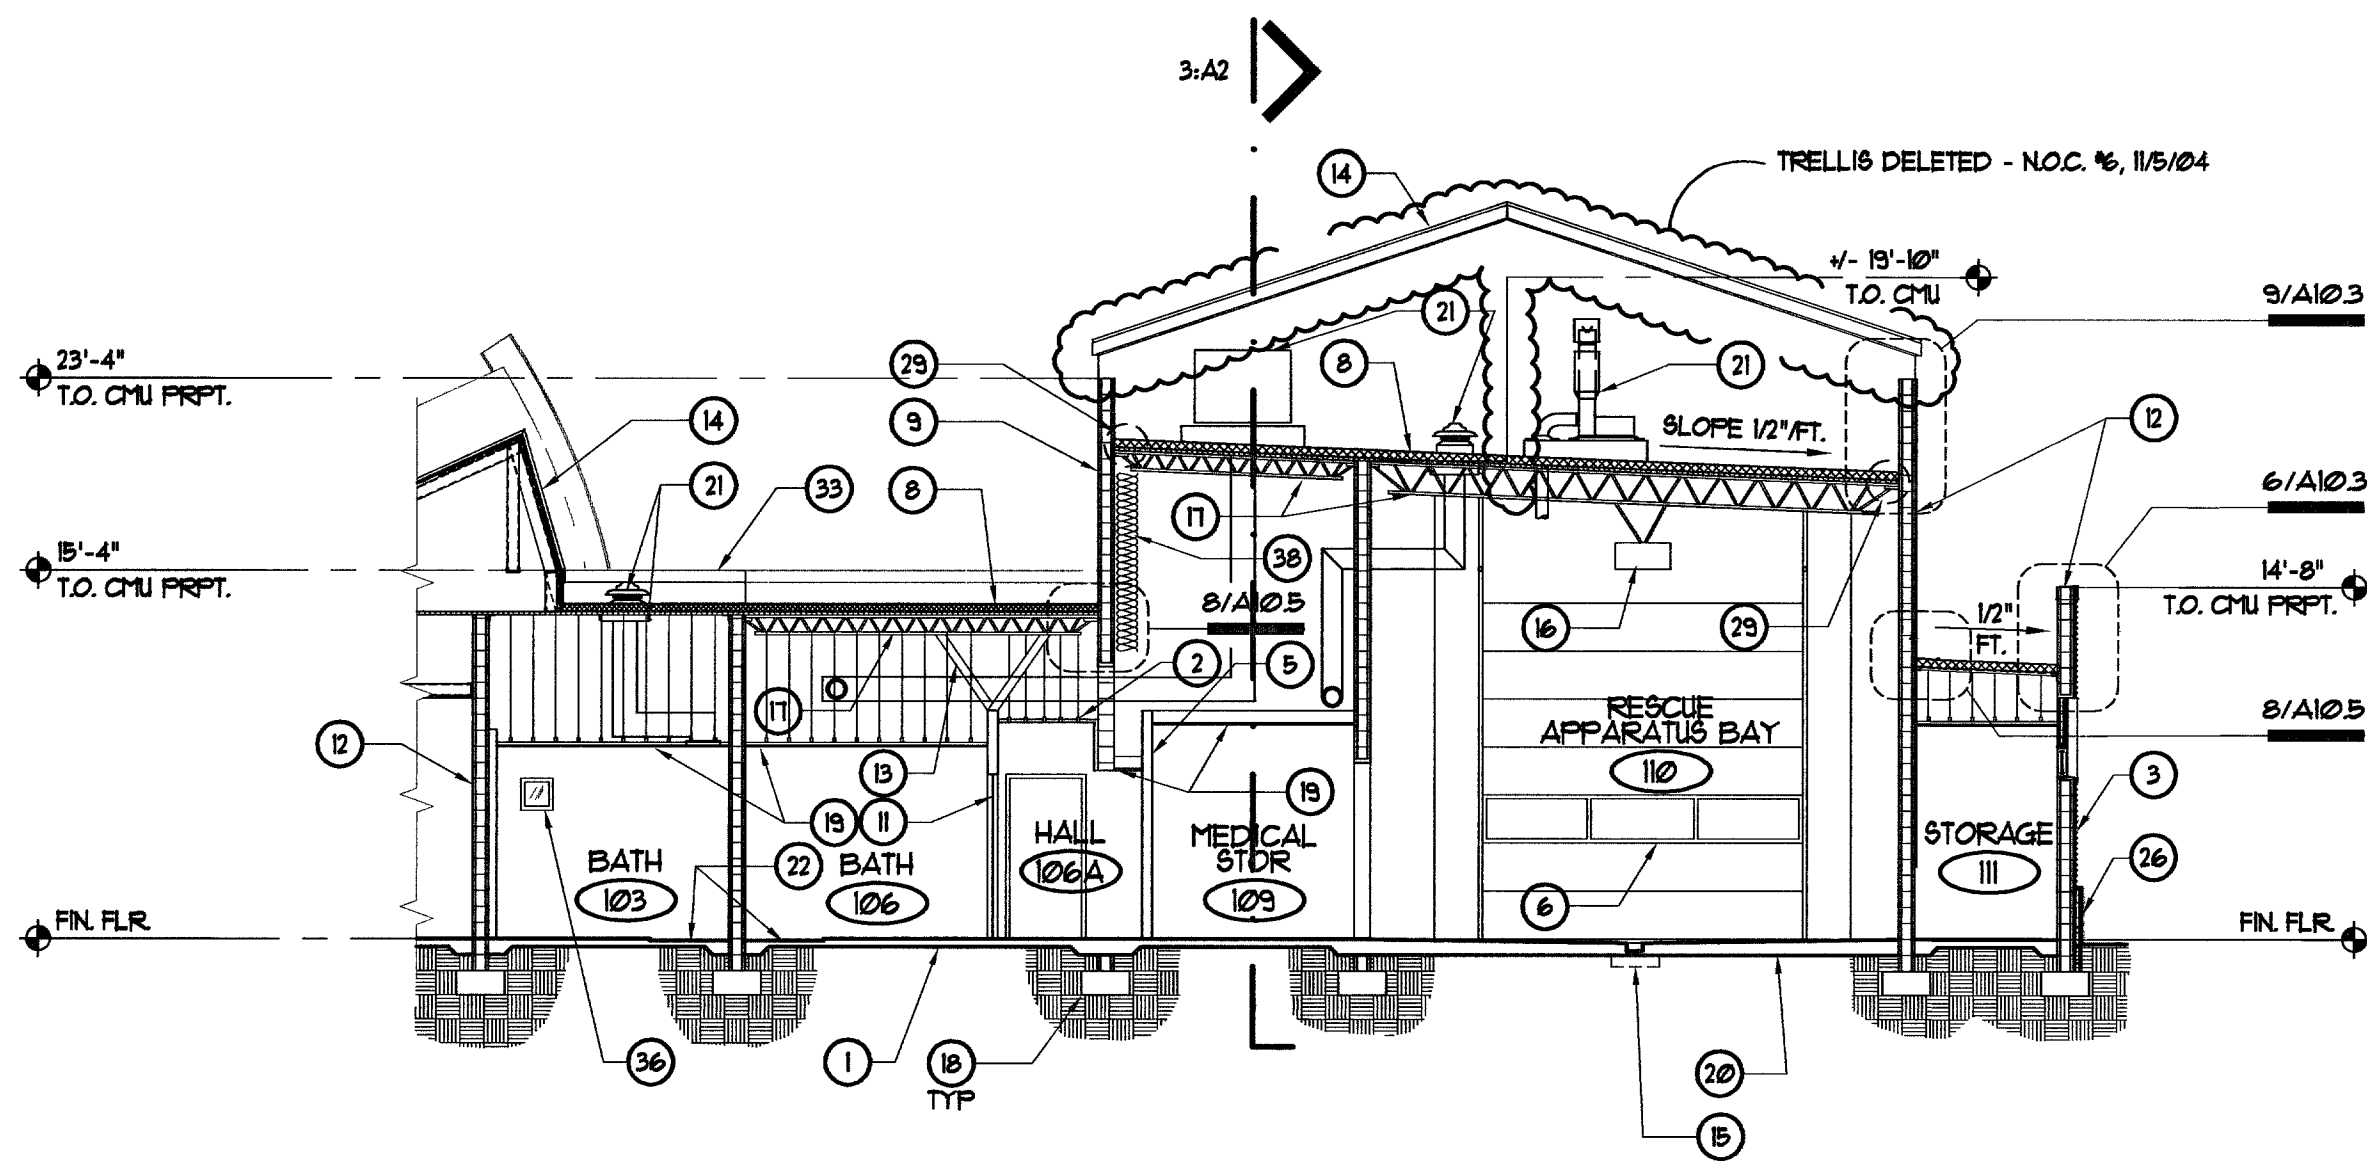


1 Building Section
Scale: 1/8"=1'-0"

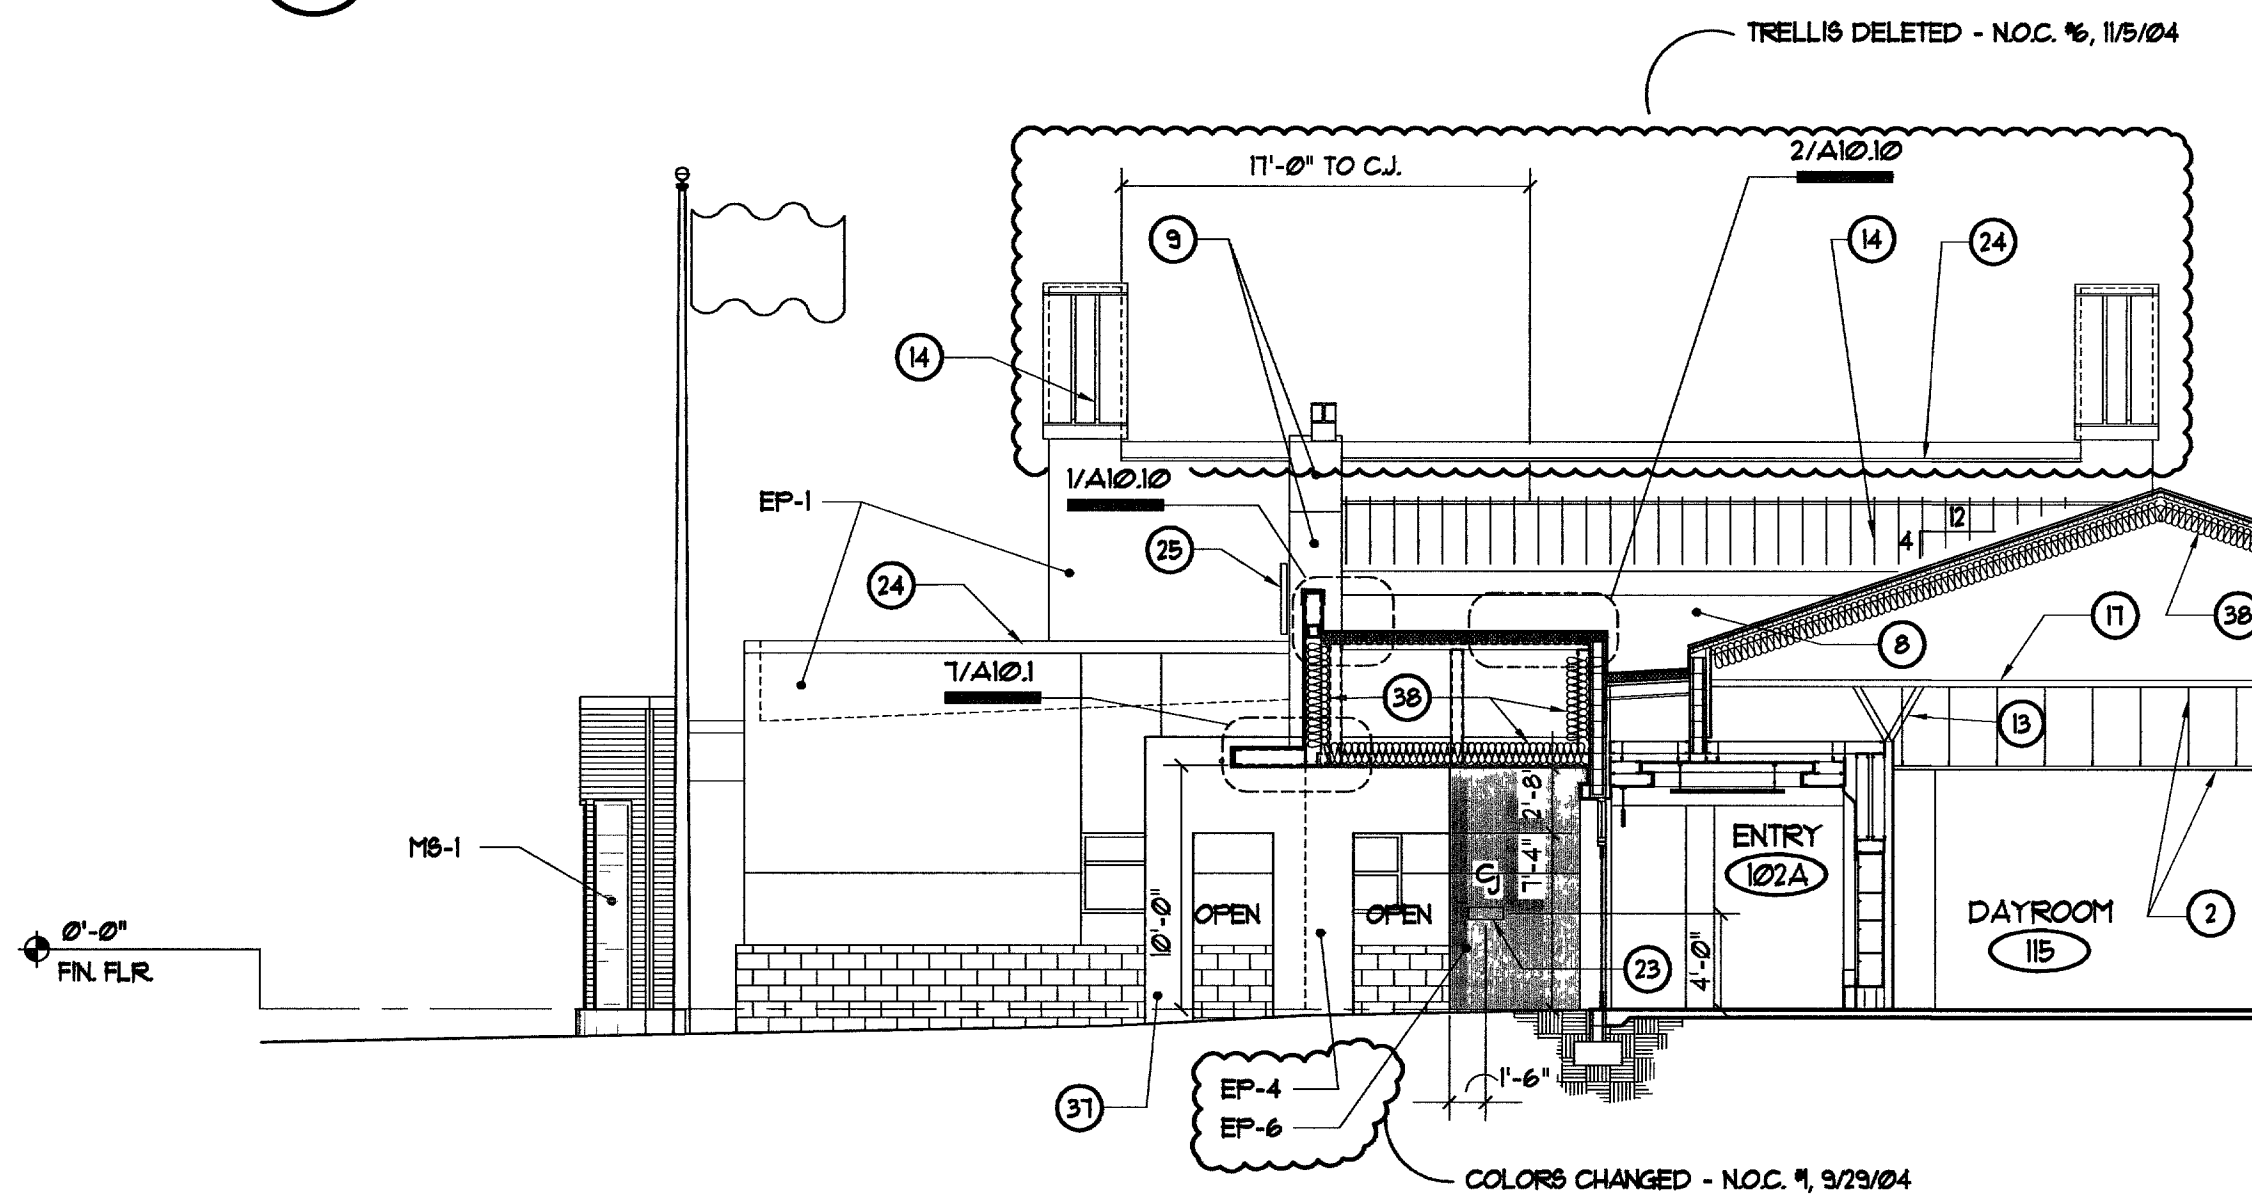


2 Building Section / Partial North Elevation
Scale: 1/8"=1'-0"

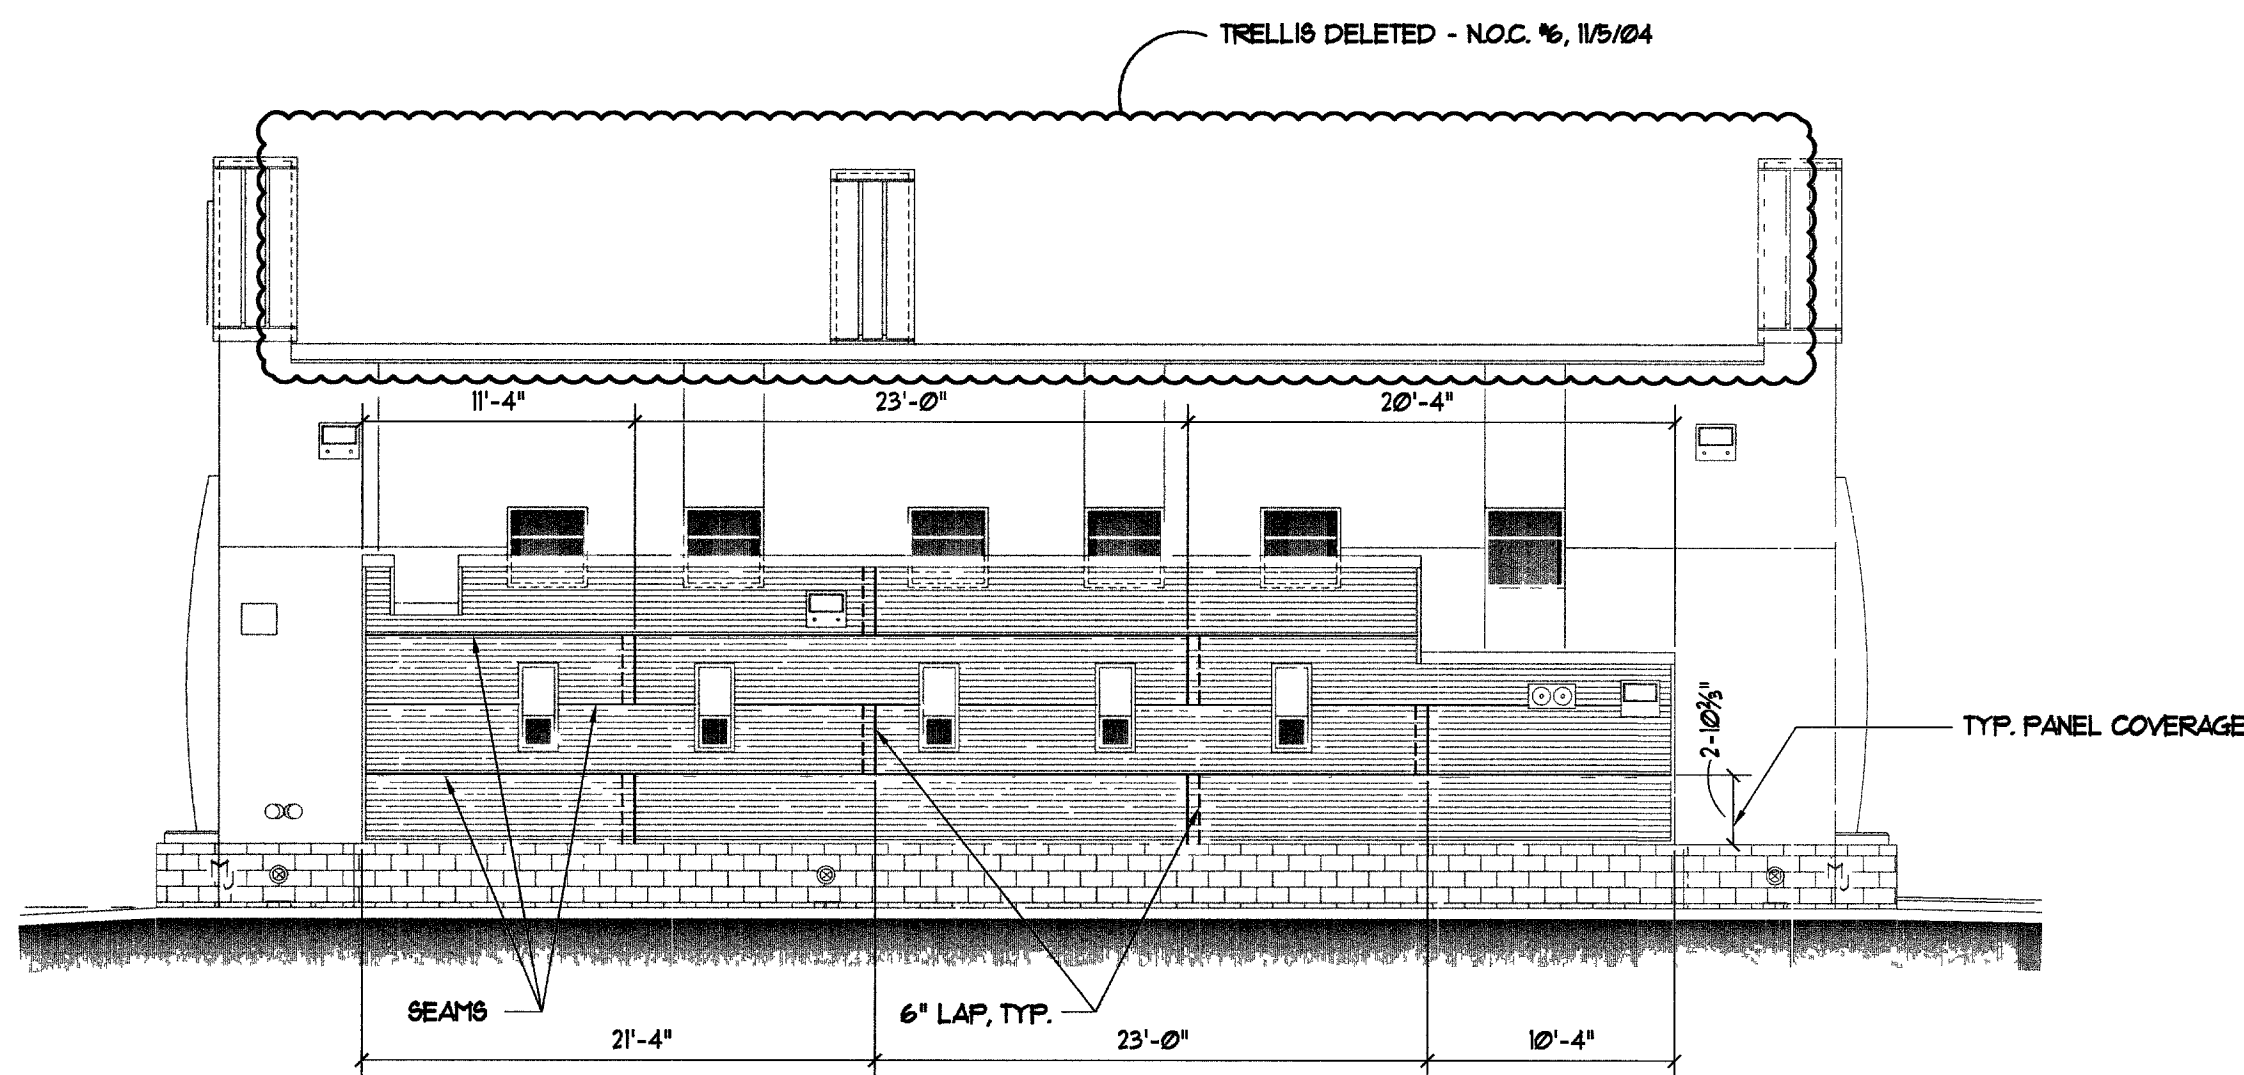


1 Metal Siding - Seam/Lap Locations
Scale: 1/8"=1'-0"

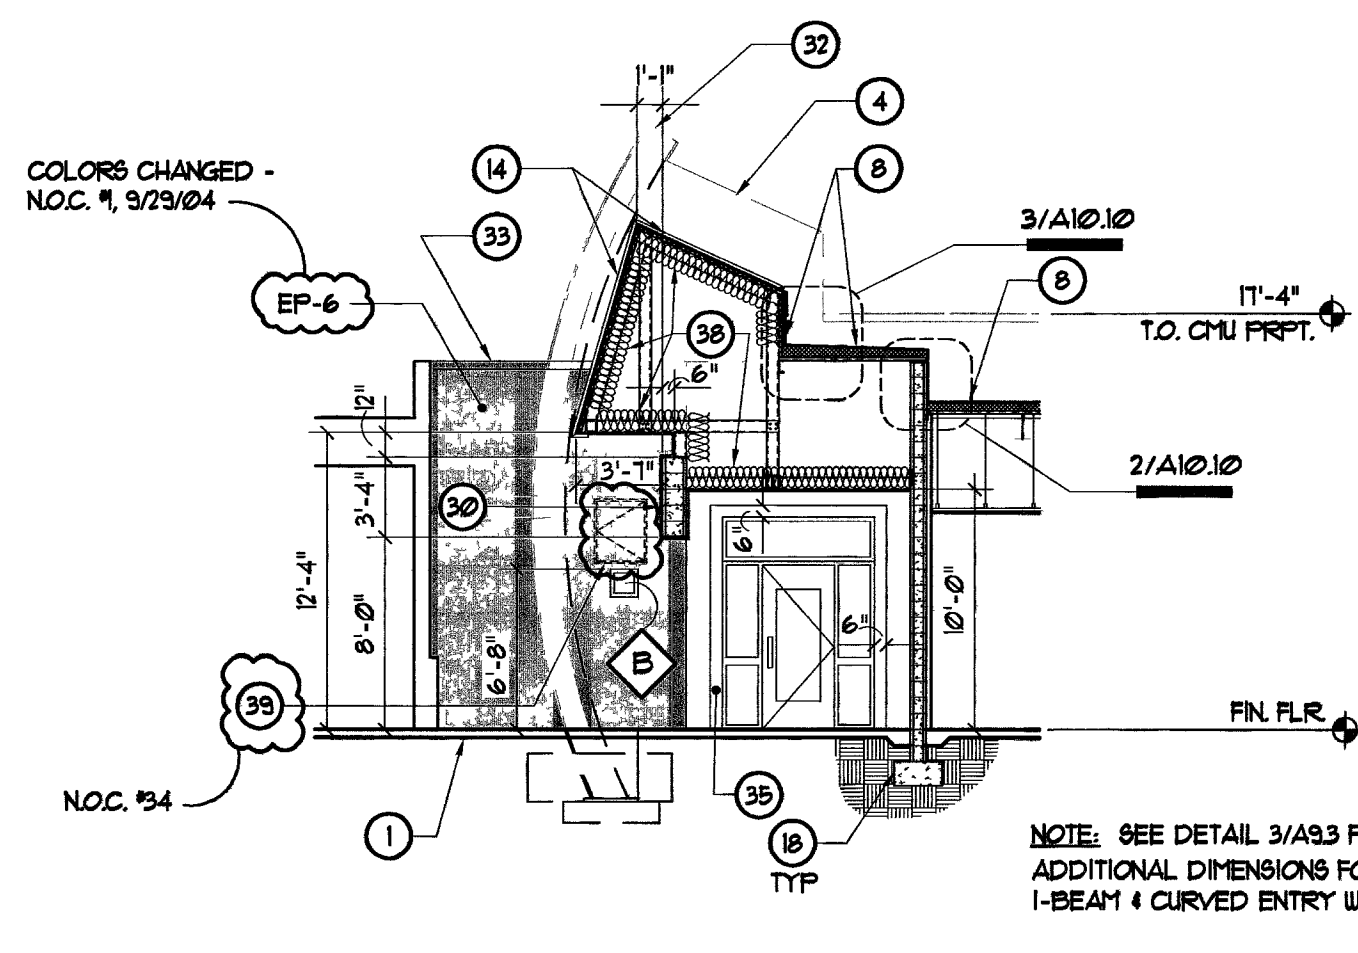

3 Building Section @ Entry
Scale: 1/8"=1'-0"

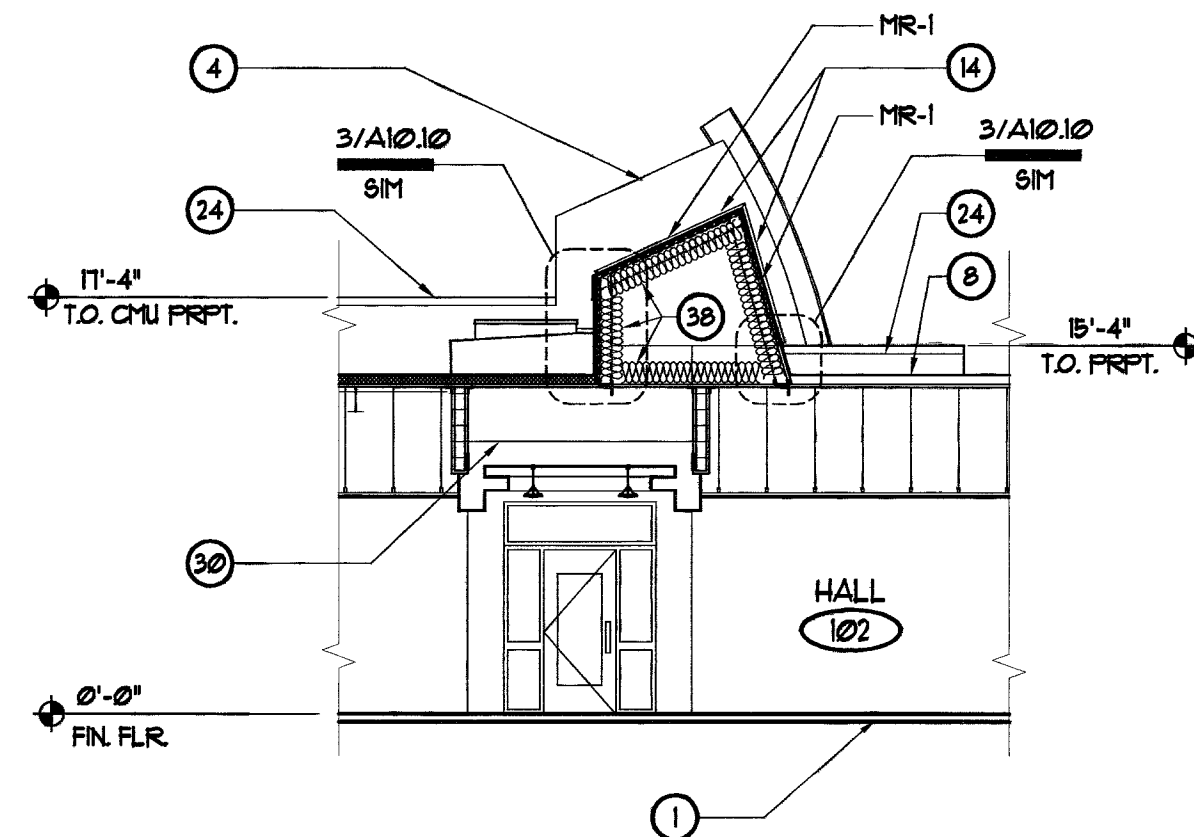

9 Partial Building Section
Scale: 1/8"=1'-0"

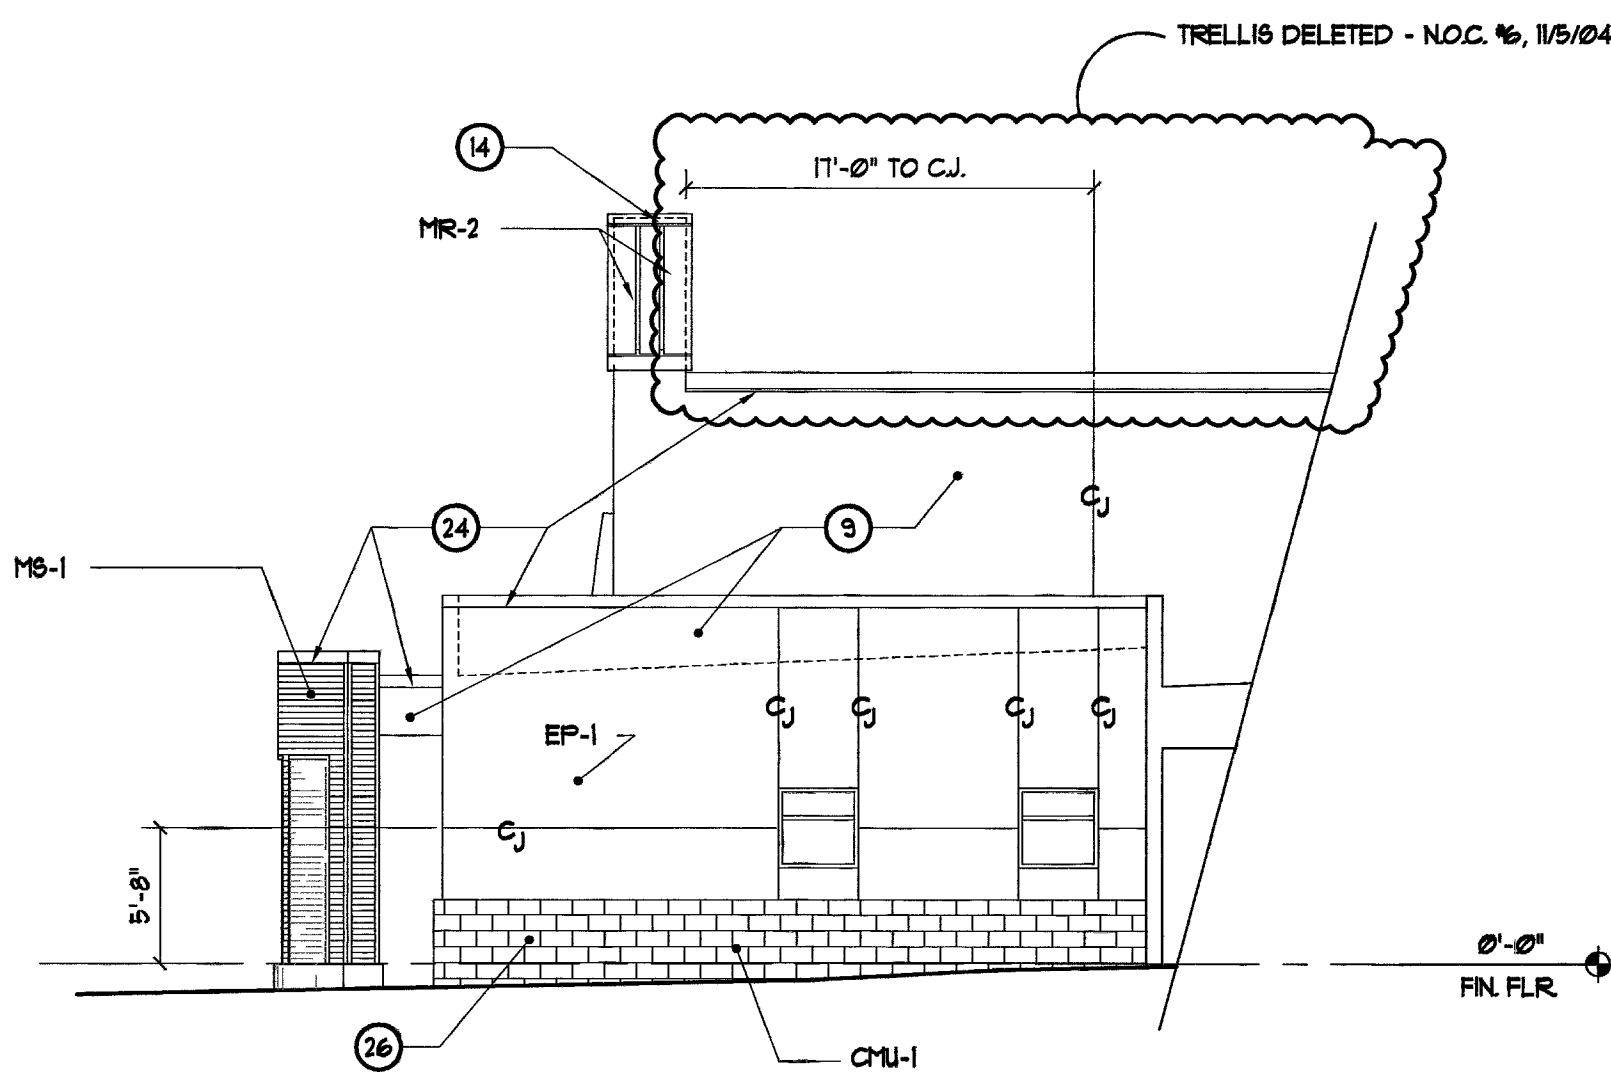

8 Partial North Elevation
Scale: 1/8"=1'-0"

RECORD DRAWING

Keynotes

- 1 REINFORCED CONCRETE SLAB, SEE STRUCTURAL DWGS. & CIVIL DWGS. AS REQUIRED.
- 2 ACOUSTICAL TILE CEILING & SUSPENSION WIRES, SEE REF. CLG. PLAN & SPEC'S.
- 3 METAL SIDING O/ FURRING CHANNELS
- 4 LINE OF PARAPET & ENTRY WALL ALONG GRIDLINE 10, SHOWN FOR REFERENCE.
- 5 INTERIOR WALL ASSEMBLY - SEE SHEETS A11 & G2.
- 6 SECTIONAL GARAGE DOOR & TRACK W/ WINDOW "LITES" AS SHOWN - SEE DOOR SCHEDULE, SHEET A6.
- 7 NOT USED.
- 8 SINGLE PLY ROOFING SYSTEM O/ R-30 RIGID INSUL. O/ METAL DECKING, SEE SHT. A3.
- 9 LIGHT SAND STUCCO FINISH - SEE EXTERIOR FINISH LEGEND & SPECIFICATIONS.
- 10 LINE OF PARAPET WALL BEYOND, SEE ROOF PLAN.
- 11 INTERIOR DOOR, SEE DOOR SCHEDULE, SHEET A6.
- 12 EXTERIOR WALL ASSEMBLY, SEE WALL TYPES, SHEET G2 AND SHEET A11.
- 13 DIAGONAL BRACING FOR INTERIOR WALLS, SEE STRUCTURAL DRAWINGS AND DTL. 1/A103.
- 14 STANDING SEAM METAL ROOF O/ 30" FELT O/ PLYWOOD O/ MTL. DECK, SEE STRUCT'L.
- 15 LINE OF CONCRETE SLAB DEPRESSION FOR TRENCH DRAIN, SEE STRUCTURAL DRAWINGS.
- 16 OVERHEAD DOOR OPERATOR, SEE SPEC'S & ELECT. DWGS. & REFLECTED CLG. PLAN.
- 17 PREFAB. ROOF TRUSSES, SEE STRUCT'L DWGS.
- 18 WALL FOOTING - SEE STRUCTURAL DRAWINGS.
- 19 5/8" TYPE "X" SUSPENDED GYP. BD. CEILING, PAINTED.
- 20 8" THICK CONCRETE SLAB & APPARATUS BAYS, PER STRUCTURAL DRAWINGS.
- 21 MECHANICAL EQUIPMENT & BRACING - SEE STRUCTURAL/MECHANICAL DWGS.
- 22 DEPRESSIONED SLAB FOR SHOWER - SEE STRUCTURAL - COORDINATE SIZE AND DEPTH W/ SHOWER PAN MANUFACTURER.
- 23 MAILBOX - OWNER FURNISHED, CONTRACTOR INSTALLED.
- 24 METAL COPING TO MATCH MR-2 - SEE SECTIONS AND DETAILS.
- 25 GALVANIZED STEEL PAN NUMERAL "8" & NEON BACK-LIGHTING, SEE DETAIL 10/A102.
- 26 EXPOSED MASONRY WAISTCOT - SEE WALL LEGEND.
- 27 EXTERIOR LIGHT FIXTURE - COORDINATE W/ ELECTRICAL DWGS.
- 28 METAL SIDING O/ FRAMING PER STRUCTURAL DRAWINGS.
- 29 PROVIDE AIR-TIGHT SEAL AT ENTIRE PERIMETER OF ROOF & AT ROOF PENETRATIONS. SEE DETAIL 3/A103.
- 30 CMU BOND BEAM, SEE STRUCTURAL DWGS.
- 31 NOT USED.
- 32 CURVED I-BEAM, SEE STRUCTURAL DRAWINGS, DET 2/A33 & DETAILS, PAINT PER FINISH SCHEDULE.
- 33 MTL. COPING TO MATCH MR-1 AT WALLS PAINTED W/ EP-3 ONLY.
- 34 MECHANICAL INTAKE & EXHAUST WALL VENTS, SEE MECHANICAL DWGS.
- 35 (6" W X 2" D) EPS FOAM POPOUT W/ STUCCO FINISH, PAINTED EP-3.
- 36 EXTERIOR WINDOW, SEE WINDOW SCHEDULE, SHEETS A6 & A6.1.
- 37 8"X12"X16" CMU WALL W/ STUCCO FINISH, PAINTED EP-2.
- 38 R-30 ROOF BATT INSULATION, SEE SPECIFICATIONS. (NOTE: R-30 BATT INSUL. SHALL BE CONTINUOUS FOR ENTIRE LENGTH OF ROOF OVERBUILD OVER ENTRY, WHERE OCCURS).
- 39 24"X30" ACCESS DOOR INSTALLED AT BACK SIDE OF CURVED ENTRY WALL. DOOR PAINTED "BAND MOTIF" #42, SEE N.O.C. #34.

General Notes:

1. ALL EXTERIOR METAL TO BE GALVANIZED & PAINTED PER EXTERIOR FINISH SCHEDULE ON SHEET A4.1.
2. SEE FINISH SCHEDULE FOR COLORS OF ALL FINISHES KEYNOTED ON ELEVATIONS.
3. SEE STRUCTURAL DWGS. FOR REINFORCING OF ALL MASONRY WALL PENETRATIONS WHERE DUCTWORK PENETRATES MASONRY WALLS.
4. ■■■ DENOTES TO BE PAINTED EP-3.



REVISIONS	DATE	BY	APP'D

CONSULTANT	DATE	BY	APP'D

OWNER	DATE	BY	APP'D

ARCHITECT	DATE	BY	APP'D

DESIGNER	DATE	BY	APP'D

DATE	BY	APP'D

DATE	BY	APP'D

DATE	BY	APP'D

DATE	BY	APP'D

A2.1