




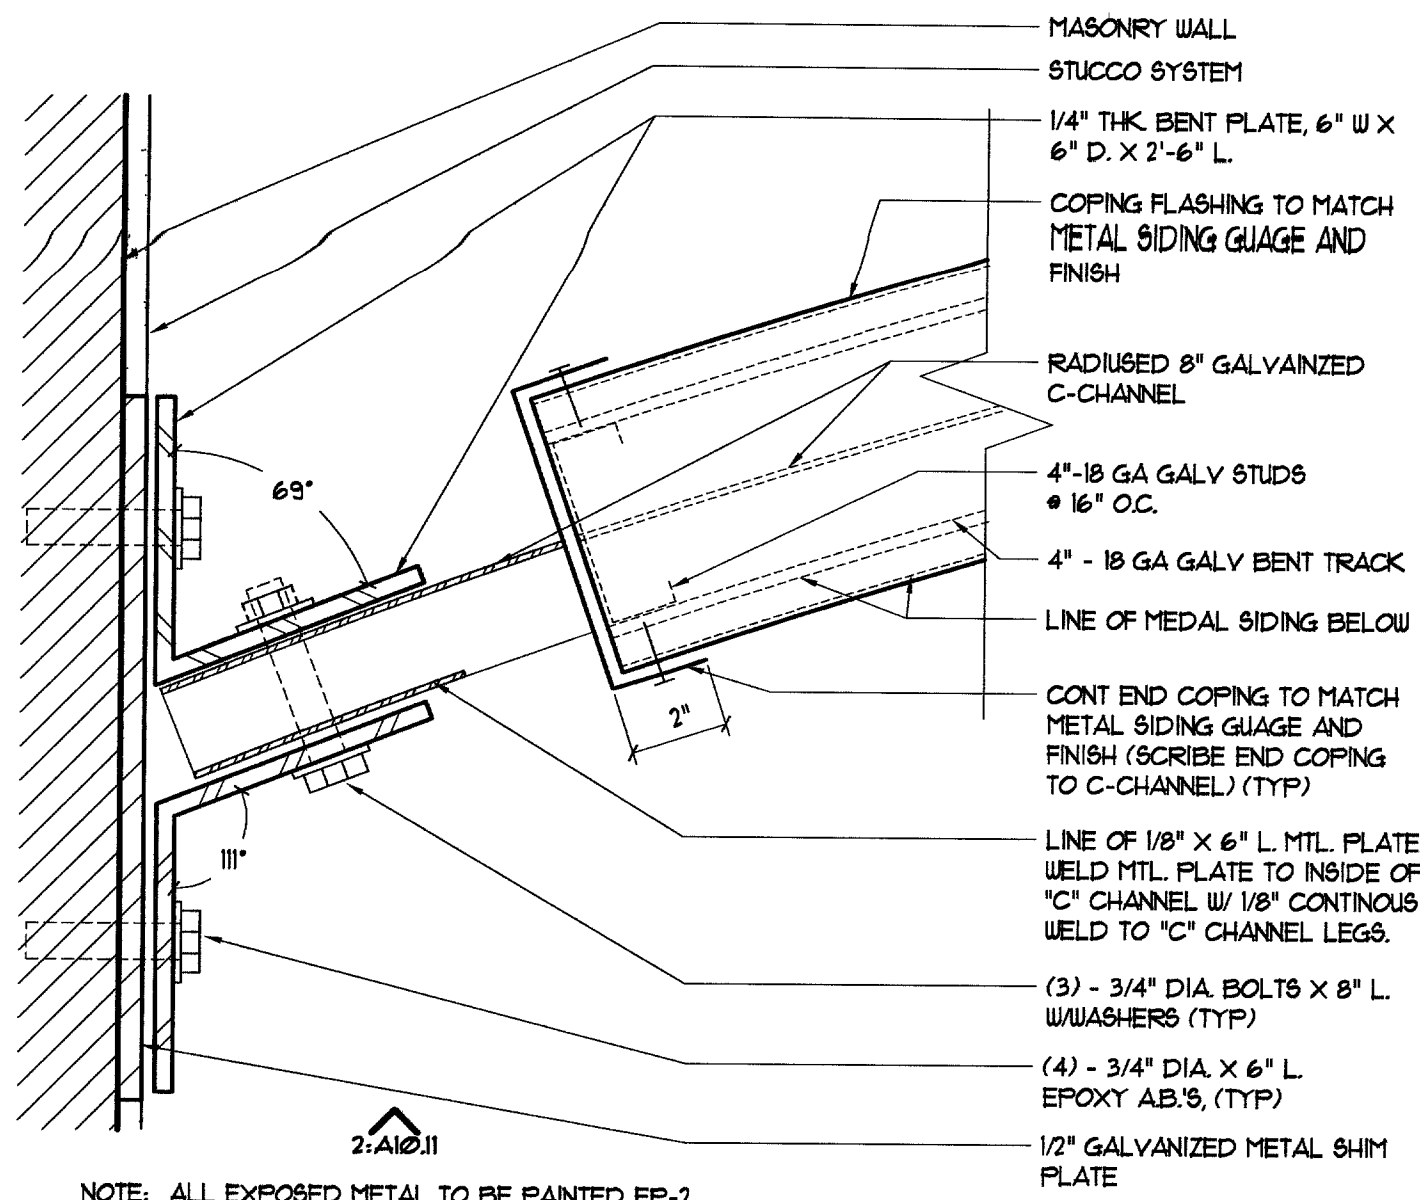


1 Canopy Connection Detail
Scale: 3" = 1'-0"

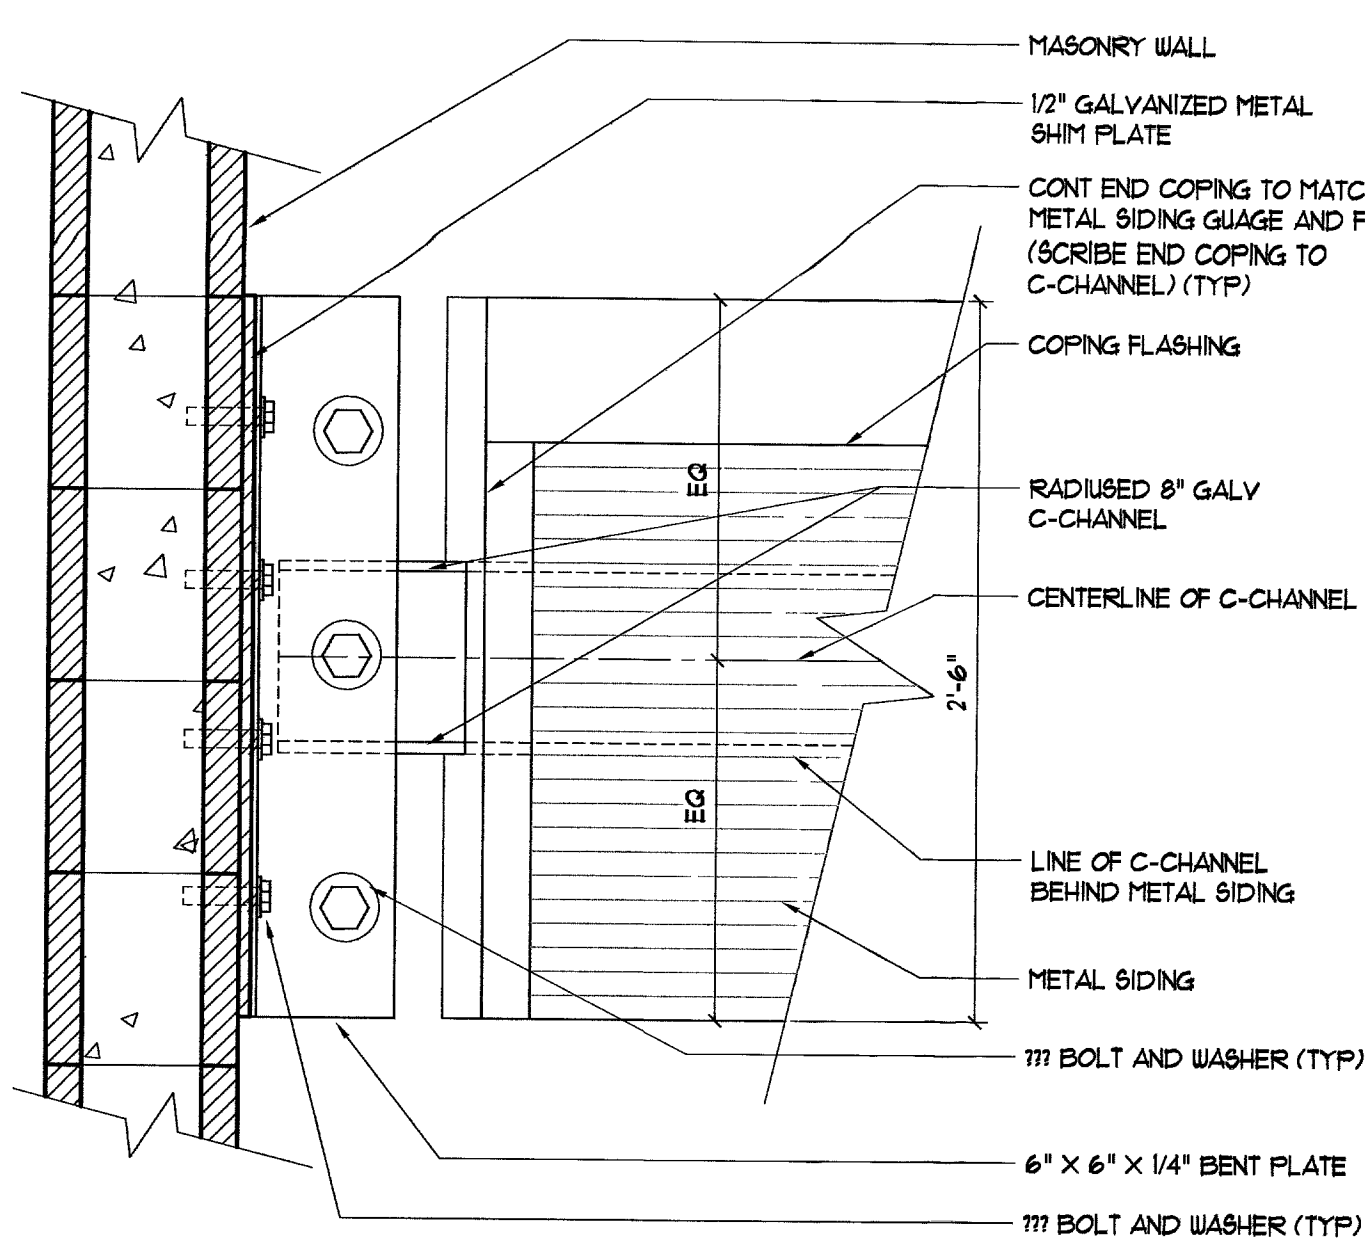


2 Canopy Connection Detail
Scale: 1-1/2" = 1'-0"

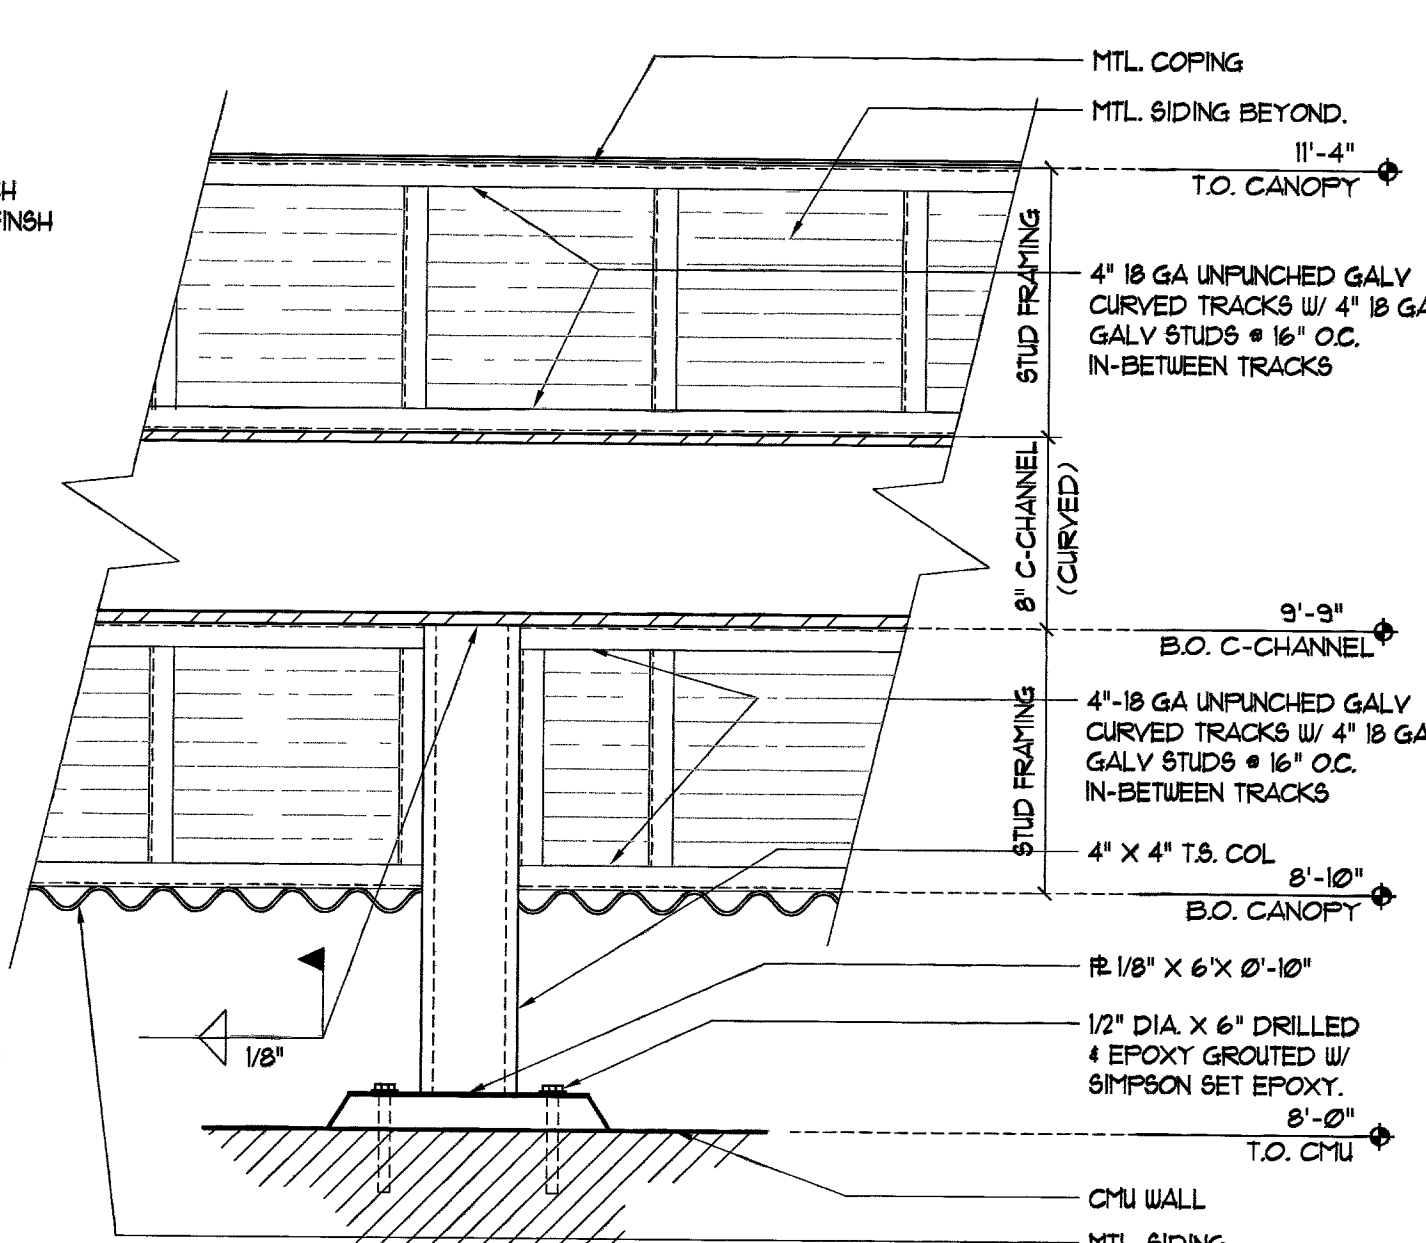


3 Canopy Connection Detail
Scale: 1-1/2" = 1'-0"

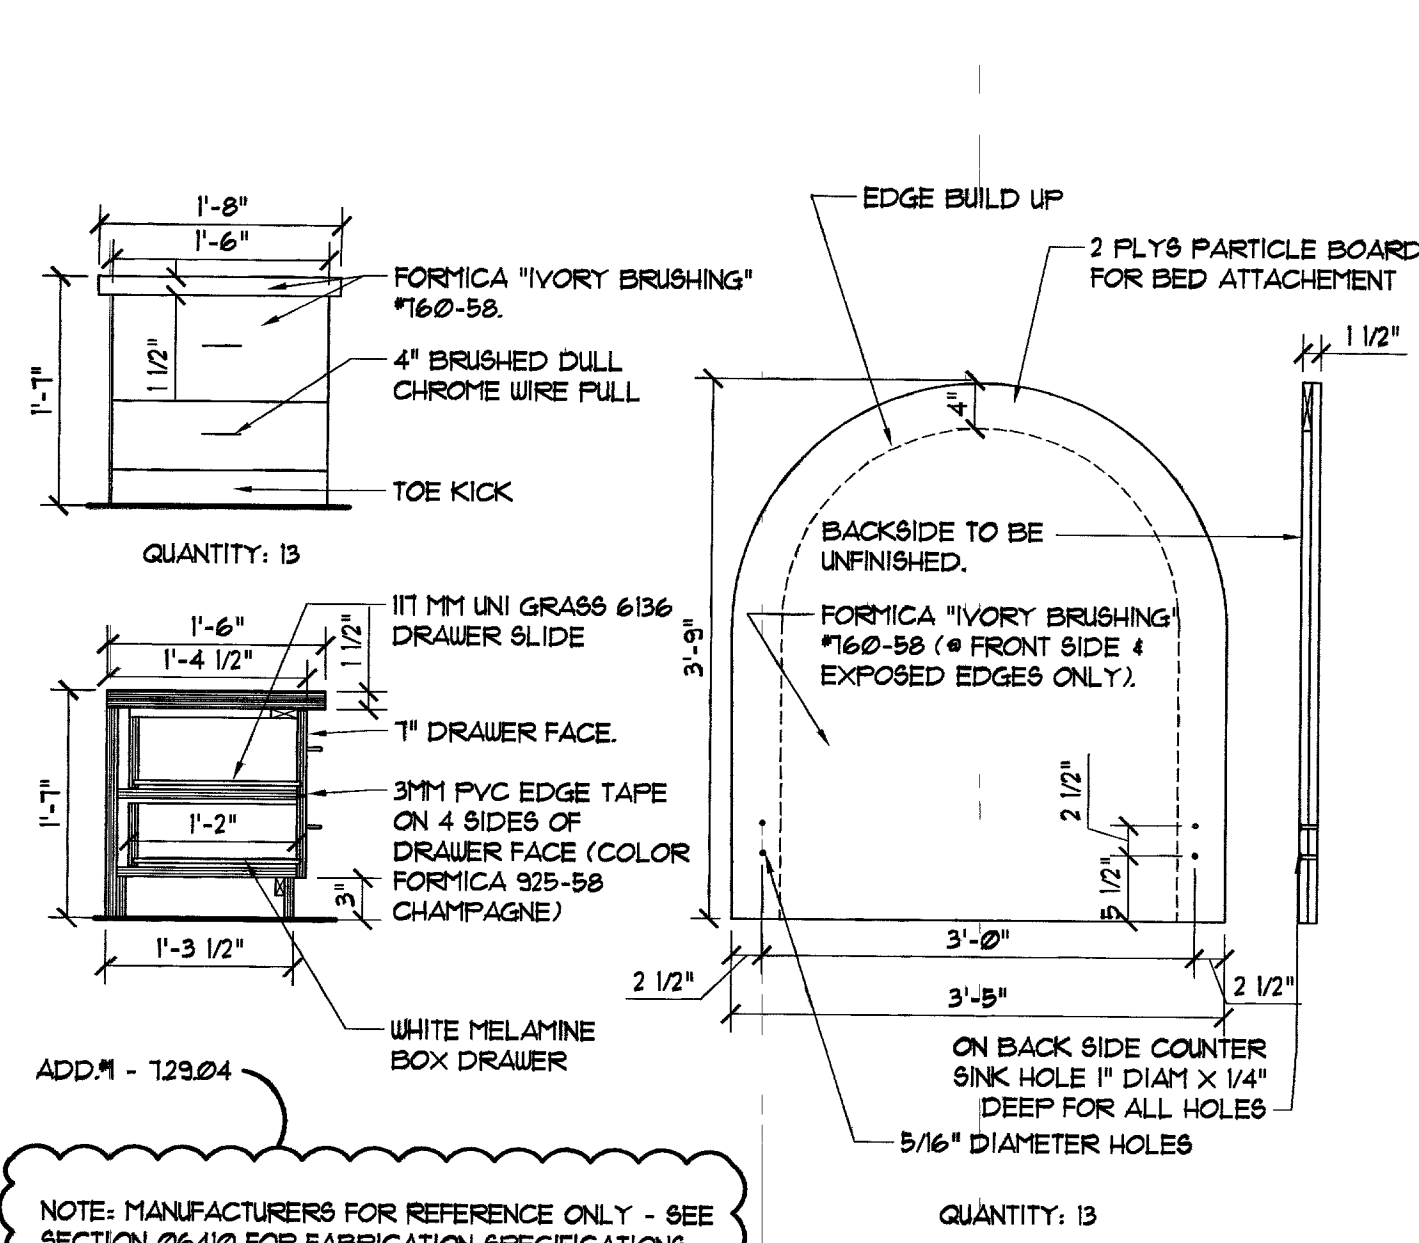

4 Nightstand/Headboard Details
Scale: 3/4" = 1'-0"

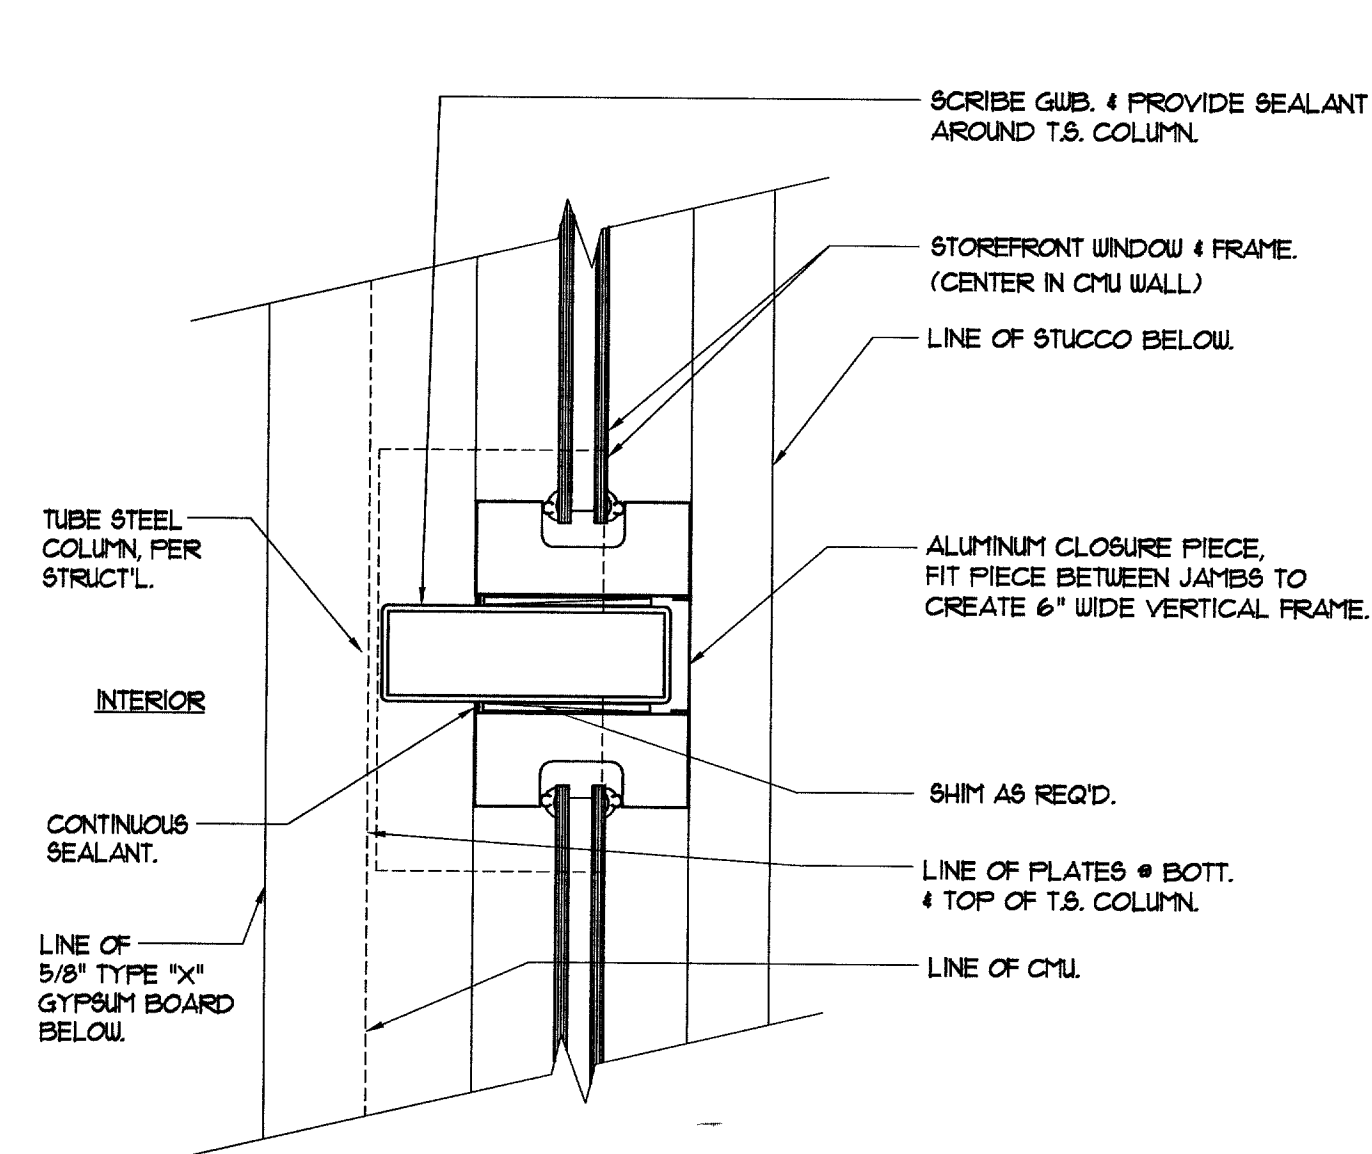


5 Vertical Mullion Detail @ T.S. Col.
Scale: 3" = 1'-0"

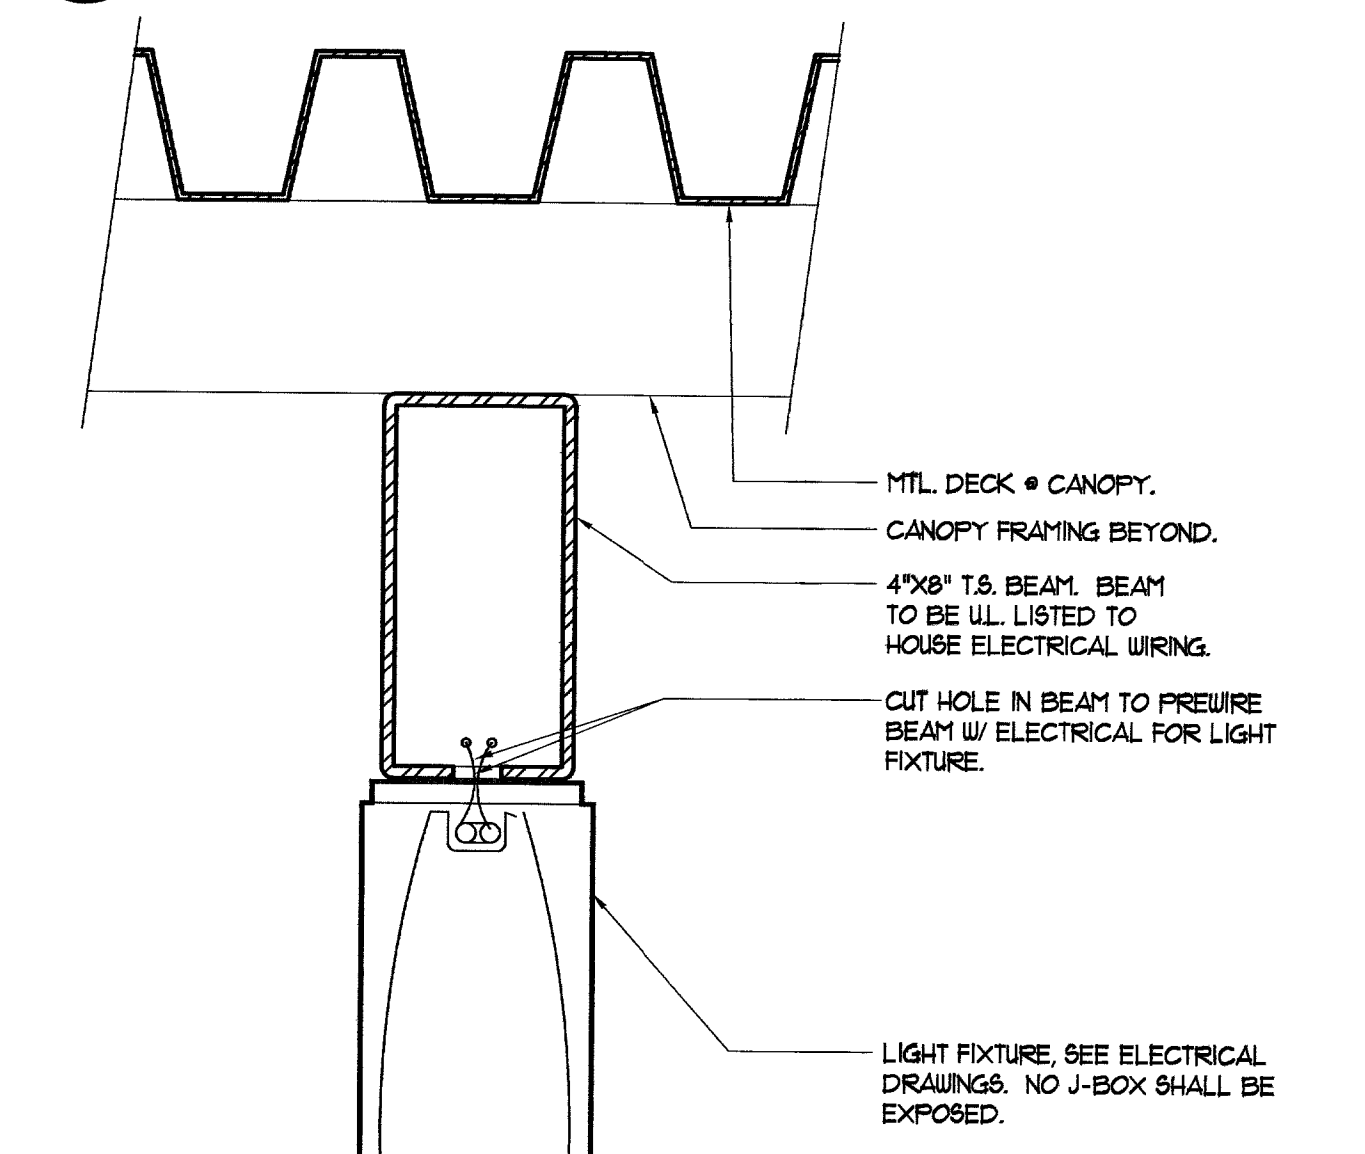

6 Lighting Detail @ T.S. Beam
Scale: 3" = 1'-0"

RECORD DRAWING

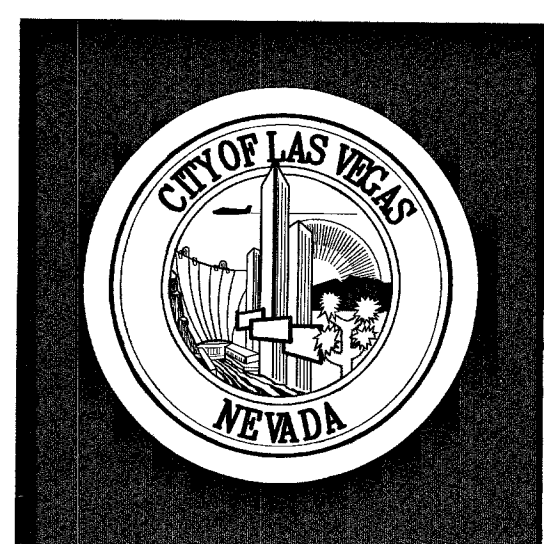

REVISIONS 1. PER OWNER - 6/21/04	
CONSULTANT	
CITY OF LAS VEGAS, NEVADA FIRE STATION #8	
Details	
STAMP	
OWNER: CITY OF LAS VEGAS DEPARTMENT OF PUBLIC WORKS ARCHITECTURAL SERVICES ARCHITECT OF RECORD SAMUEL D. TOLMAN, AIA, NCARB 400 EAST STEWART AVENUE LAS VEGAS, NEVADA 89101 PHONE: (702) 229-6535 FAX: (702) 382-3232 TDD: (702) 386-9108	
DRAWN FILE DATE SCALE RCD NO CLY DWG NO SHT NO	EP6 708-A10.11 4/1/04 As Noted 0415341.04 630-101 067
A10.11	

DRAWINGS AS INSTRUMENTS OF SERVICE ARE THE PROPERTY OF THE DESIGN PROFESSIONAL, WHOSE STAMP OF CERTIFICATION APPEARS ON THE DRAWINGS AND SPECIFICATIONS. ANY USE OR REPRODUCTION IN WHOLE OR IN PART WITHOUT WRITTEN CONSENT IS STRICTLY PROHIBITED. COPIES OF THE DRAWINGS AND SPECIFICATIONS FURNISHED BY THE CLIENT MAY BE UTILIZED ONLY FOR OCCUPANCY OF THE PROJECT FOR WHICH THEY WERE PREPARED AND NOT FOR THE CONSTRUCTION OF ANY OTHER PROJECT. N.A.C. 633.790