

- C-1 COVER SHEET
- C-2 GENERAL NOTES & QUANTITIES
- C-3 SURVEY CONTROL PLAN
- C-4 SITE PLAN – ONSITE SIGNAGE AND STRIPING
- C-5 HORIZONTAL CONTROL PLAN
- C-6 MASTER UTILITY PLAN
- C-7 GRADING PLAN
- C-8 PLAN & PROFILE – HARRIS AVENUE
- C-9 TRAFFIC SIGNAGE, STRIPING, & STREETLIGHTING –
MOJAVE ROAD
- C-10 EMERGENCY SIGNAL FLASHER
- C-11 CONSTRUCTION DETAILS I
- C-12 CONSTRUCTION DETAILS II
- C-13 CONSTRUCTION DETAILS III
- C-14 CONSTRUCTION DETAILS IV
- C-15 CONSTRUCTION DETAILS V
- C-16 CONSTRUCTION DETAILS VI
- C-17 CONSTRUCTION DETAILS VII
- C-18 CONSTRUCTION DETAILS VIII
- C-19 CONSTRUCTION DETAILS IX
- C-20 CONSTRUCTION DETAILS X
- C-21 CONSTRUCTION DETAILS XI
- C-22 JOINTING PLAN
- C-23 REMOVAL PLAN
- C-ES.1 ELECTRICAL SITE PLAN

Councilmen:
GARY REESE
 (Mayor Pro-Tem)
LARRY BROWN
LYNETTE B. McDONALD
LAWRENCE WEEKLY
MICHAEL MACK
JANET MONCRIEF

City Engineer:
CHARLES KAJKOWSKI, JR., P.E.

APN. A PORTION OF 139-25-303-014


CITY OF LAS VEGAS
STATE OF NEVADA



Funded By:
CITY OF LAS VEGAS

DEPARTMENT OF PUBLIC WORKS
400 EAST STEWART
LAS VEGAS, NV 89101
(702) 229-6276

BID NO.: 04.15341.04

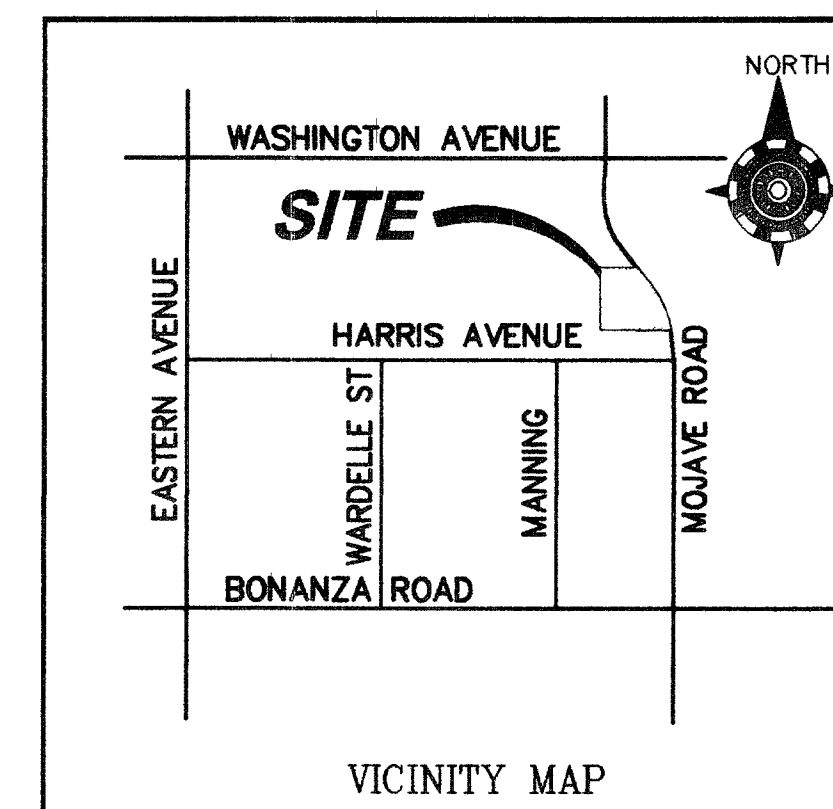

APN. A PORTION OF 139-25-303-014

APPROVALS

 7/16/2004
CITY ENGINEER
CHARLES KAJKOWSKI, JR., P.E. #4784
DATE

APPROVAL OF THESE PLANS IS LIMITED TO THOSE IMPROVEMENTS CONSTRUCTED IN THE DEDICATED RIGHT-OF-WAY AND/OR DEDICATED EASEMENTS. THIS APPROVAL DOES NOT AUTHORIZE THE CONSTRUCTION OF ANY IMPROVEMENTS THAT DEViate FROM ADOPTED STANDARDS AND/OR SPECIFICATIONS, EXCEPT THOSE SPECIFICALLY LISTED UNDER DEVIATIONS FROM STANDARD. THE ENGINEER SHALL RESOLVE ANY DEVIATION OTHER THAN THOSE LISTED IN DEVIATIONS FROM STANDARDS IN FAVOR OF THE UNIFORM STANDARD DRAWINGS AND SPECIFICATIONS CLARK COUNTY AREA NEVADA.

[Signature]
CITY OF LAS VEGAS FIRE MARSHAL

M. Margo Wheeler (6.14.04)
M. MARGO WHEELER, AICP, CURRENT PLANNING MANAGER DATE

THIS PLAN MEETS THE APPLICABLE STANDARDS OF THE
PLANNING AND DEVELOPMENT DEPARTMENT.


6/16/04
 LAS VEGAS VALLEY WATER DISTRICT (SHEETS: 1, 2, 6, 21) DATE
 PROJ. 29289

NEVADA POWER COMPANY DATE

Tom Stiles 6-2-0
SPRINT TELEPHONE COMPANY DATE

"THE AFFIXED SPRINT NEVADA APPROVAL DOES NOT ASSUME OR GUARANTEE LIABILITY FOR KNOWN OR UNKNOWN CONFLICTS WITH EXISTING OR PROPOSED IMPROVEMENTS. RESOLUTION OF ANY CONFLICT WILL BE ACCOMPLISHED PURSUANT TO LOCAL ORDINANCES, NEVADA REVISED STATUTES AND/OR PUBLIC UTILITY COMMISSION RULES AND REGULATIONS"

EDGARDO ESTANISLAO 6/7/00
SOUTHWEST GAS CORPORATION DATE

Yania L. Tapia 6/3/04
COX COMMUNICATIONS, LAS VEGAS, INC. DATE

[illegible]

RECORD DRAWINGS