




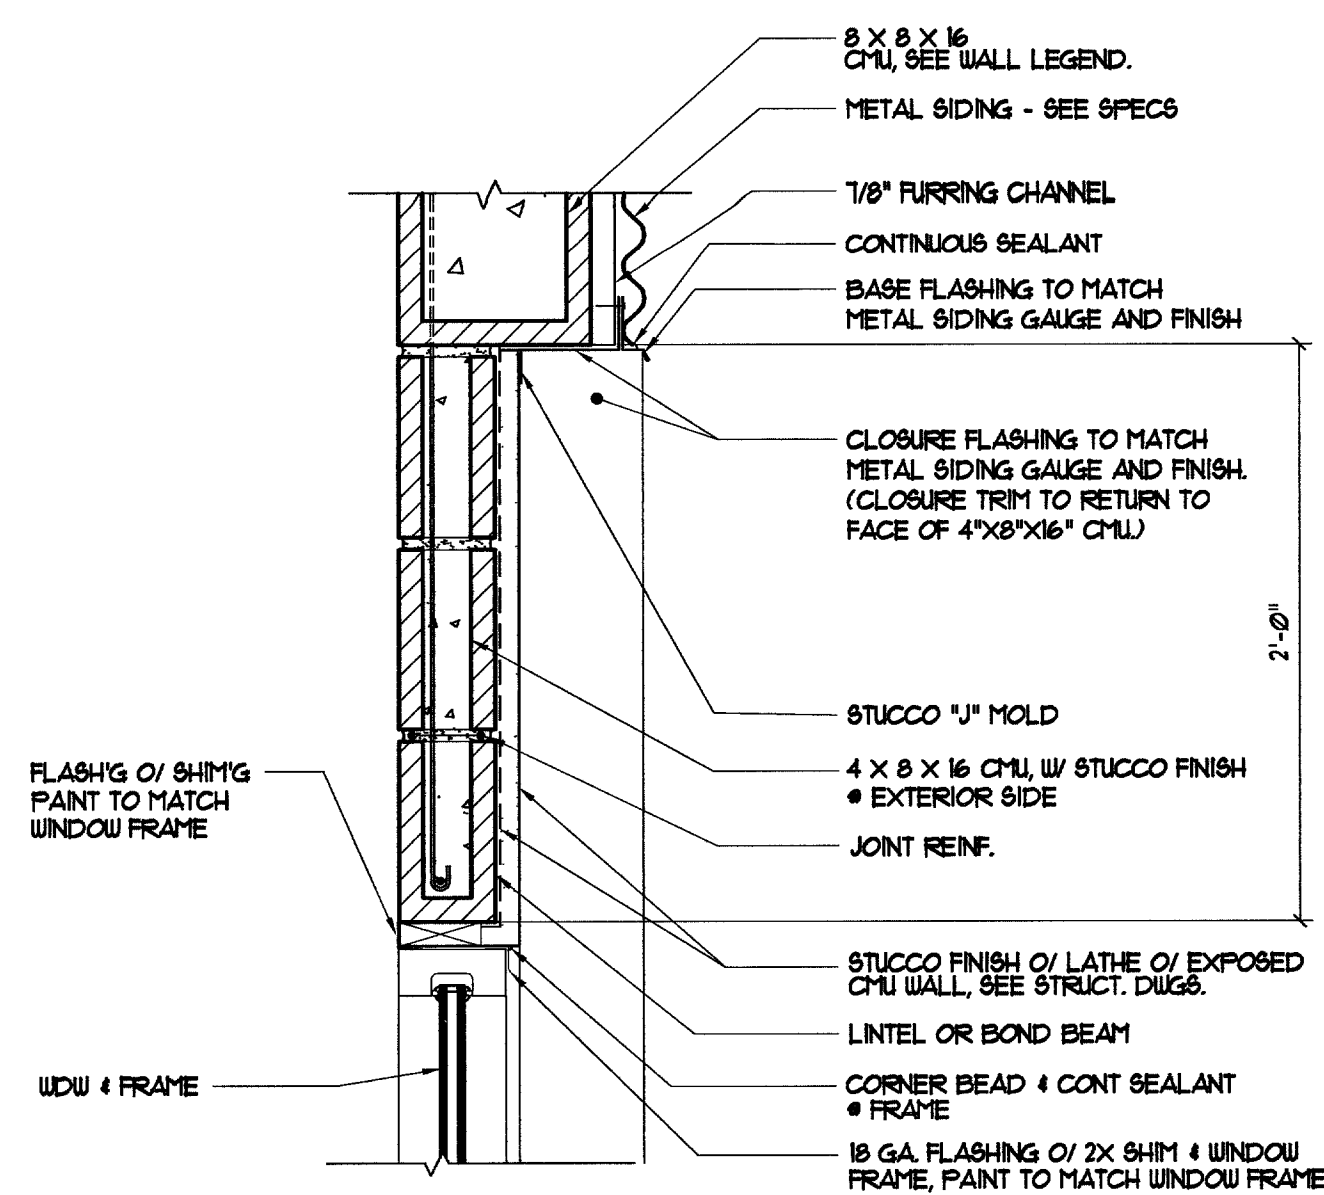


1 Siding Flashing Detail
Scale: 1 1/2" = 1'-0"
A10-3-1

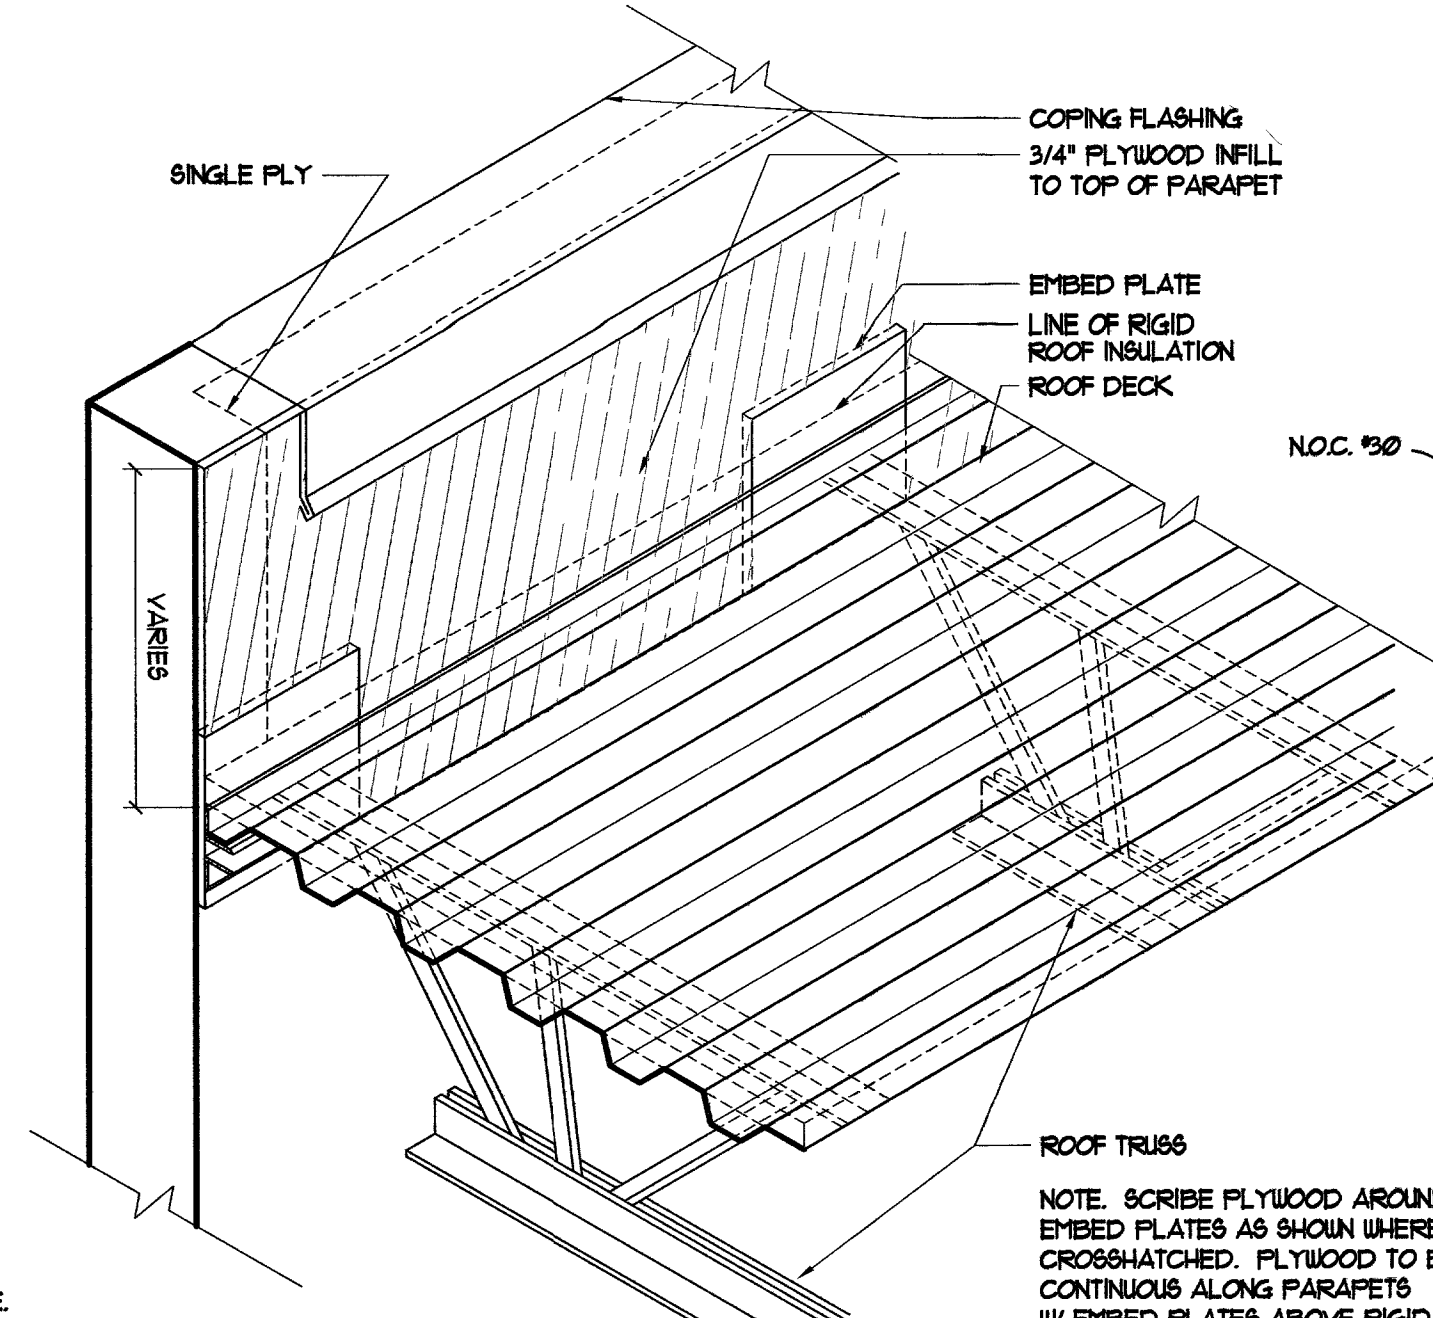


2 Plywood Infill Isometric
Scale: Isometric
A10-3-2

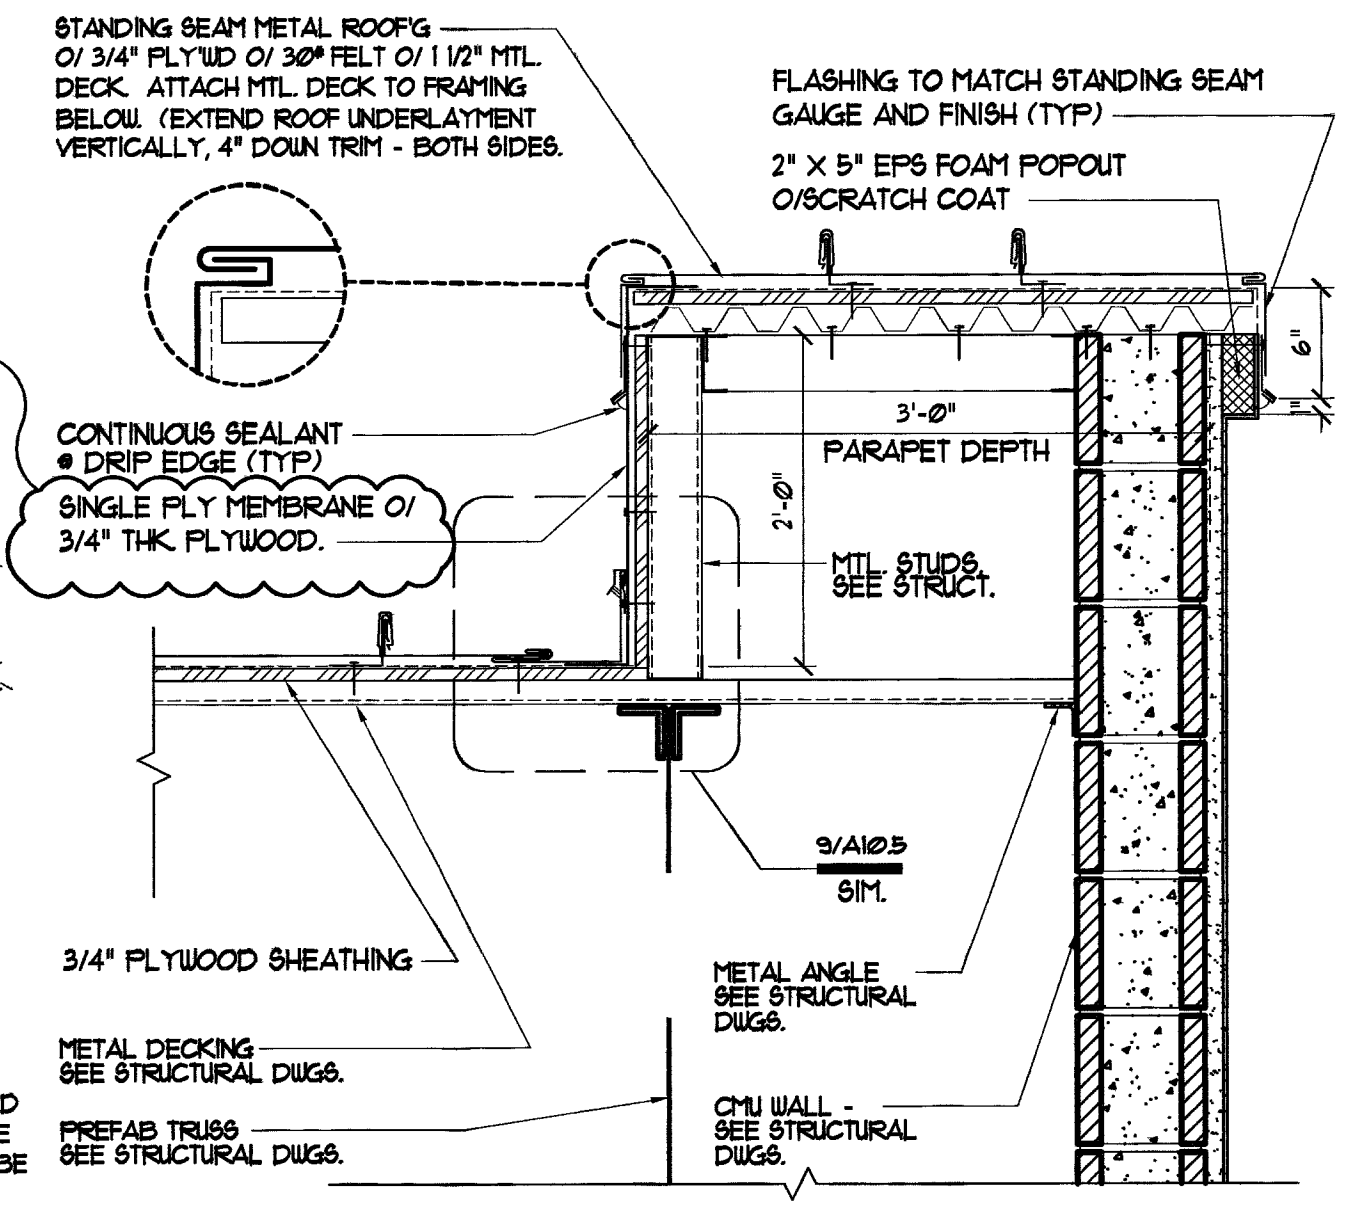


3 Gable End Parapet Detail
Scale: 1" = 1'-0"
A10-3-3

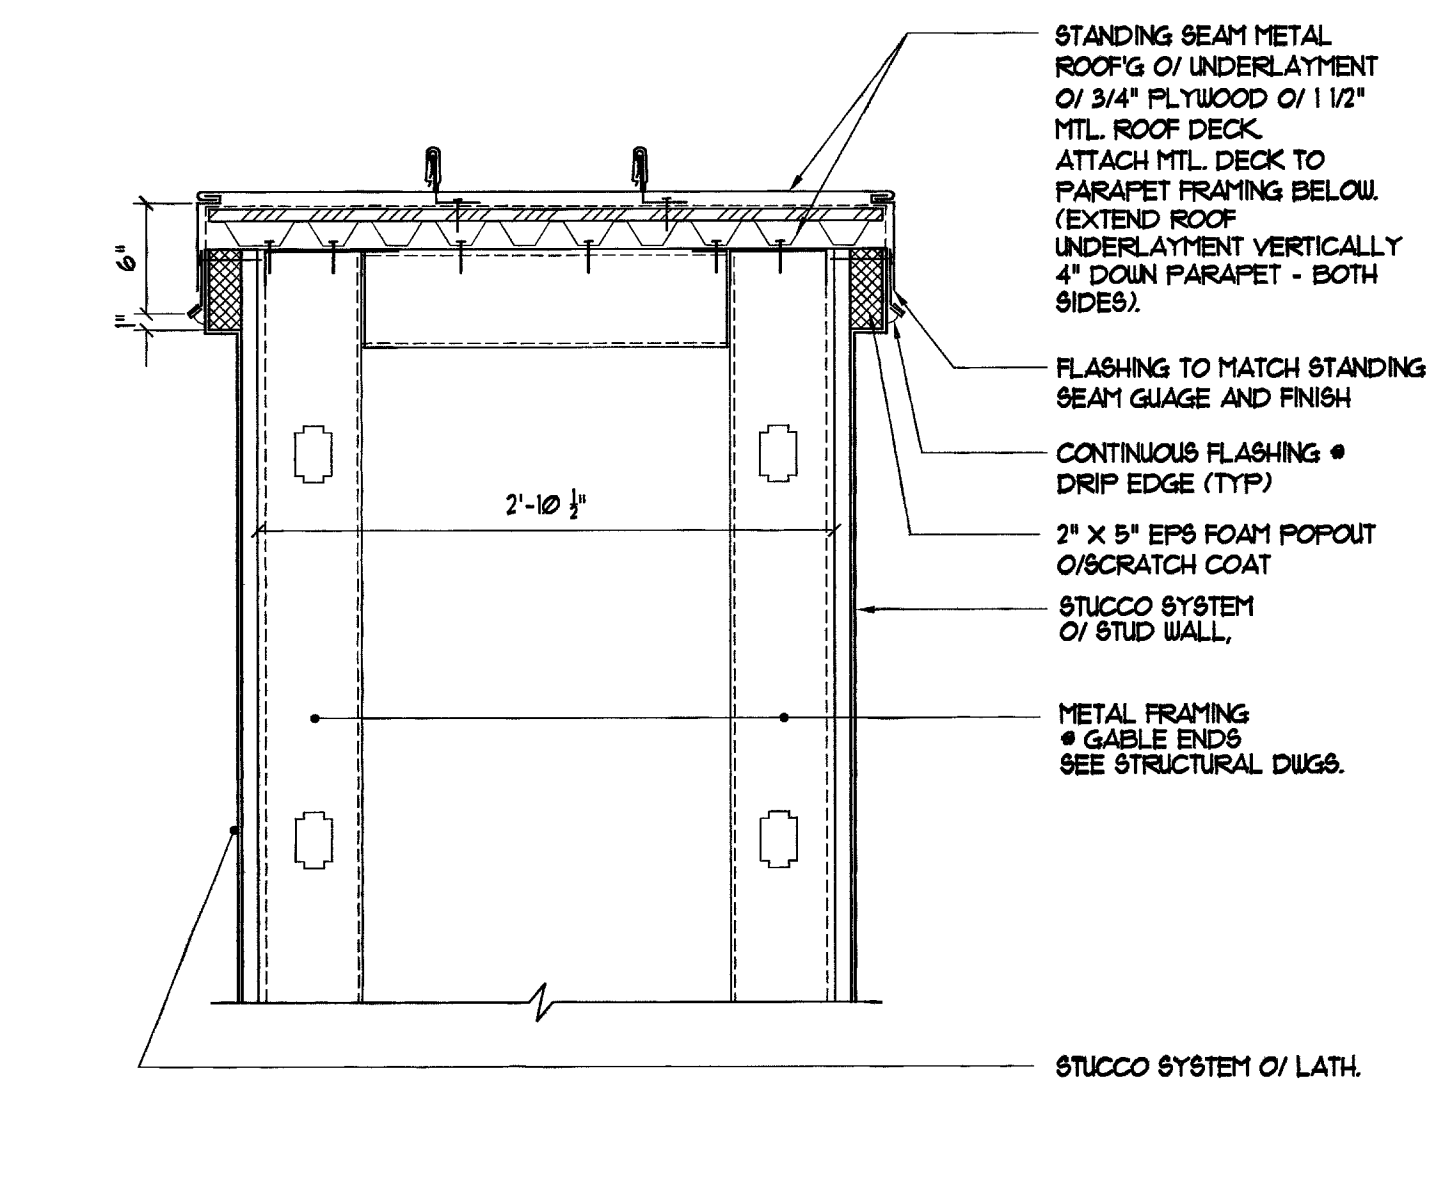


4 Parapet Detail @ Gable Ends
Scale: 1" = 1'-0"
A10-3-4

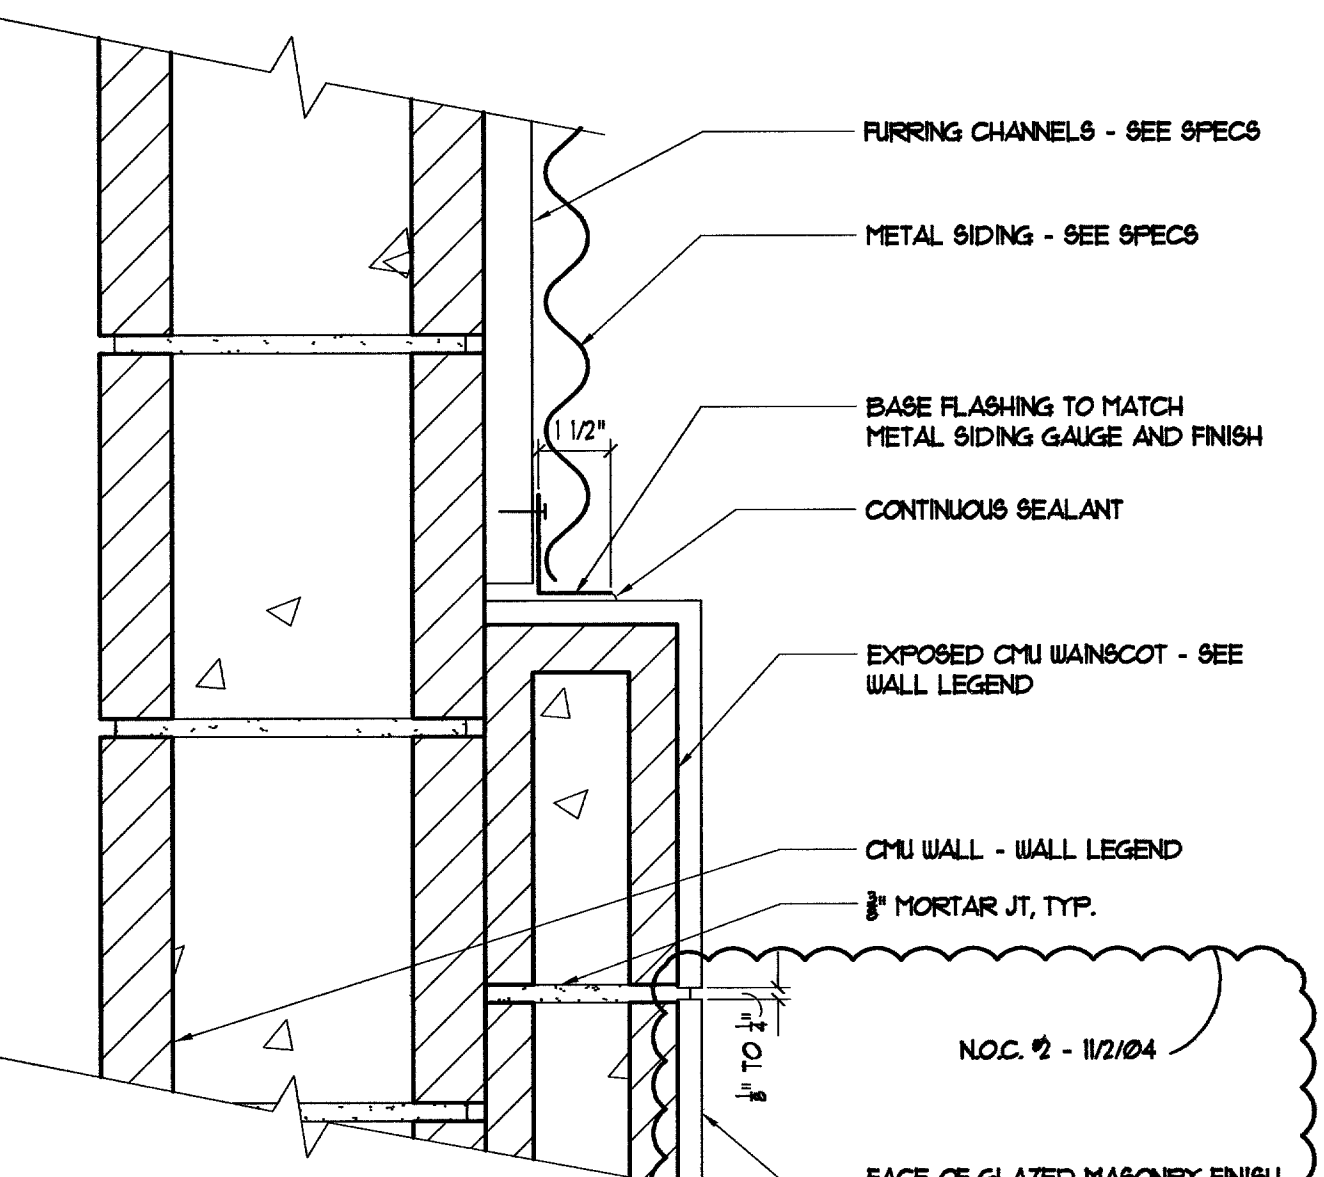


5 Base Flashing @ Exposed CMU
Scale: 3" = 1'-0"
A10-3-5

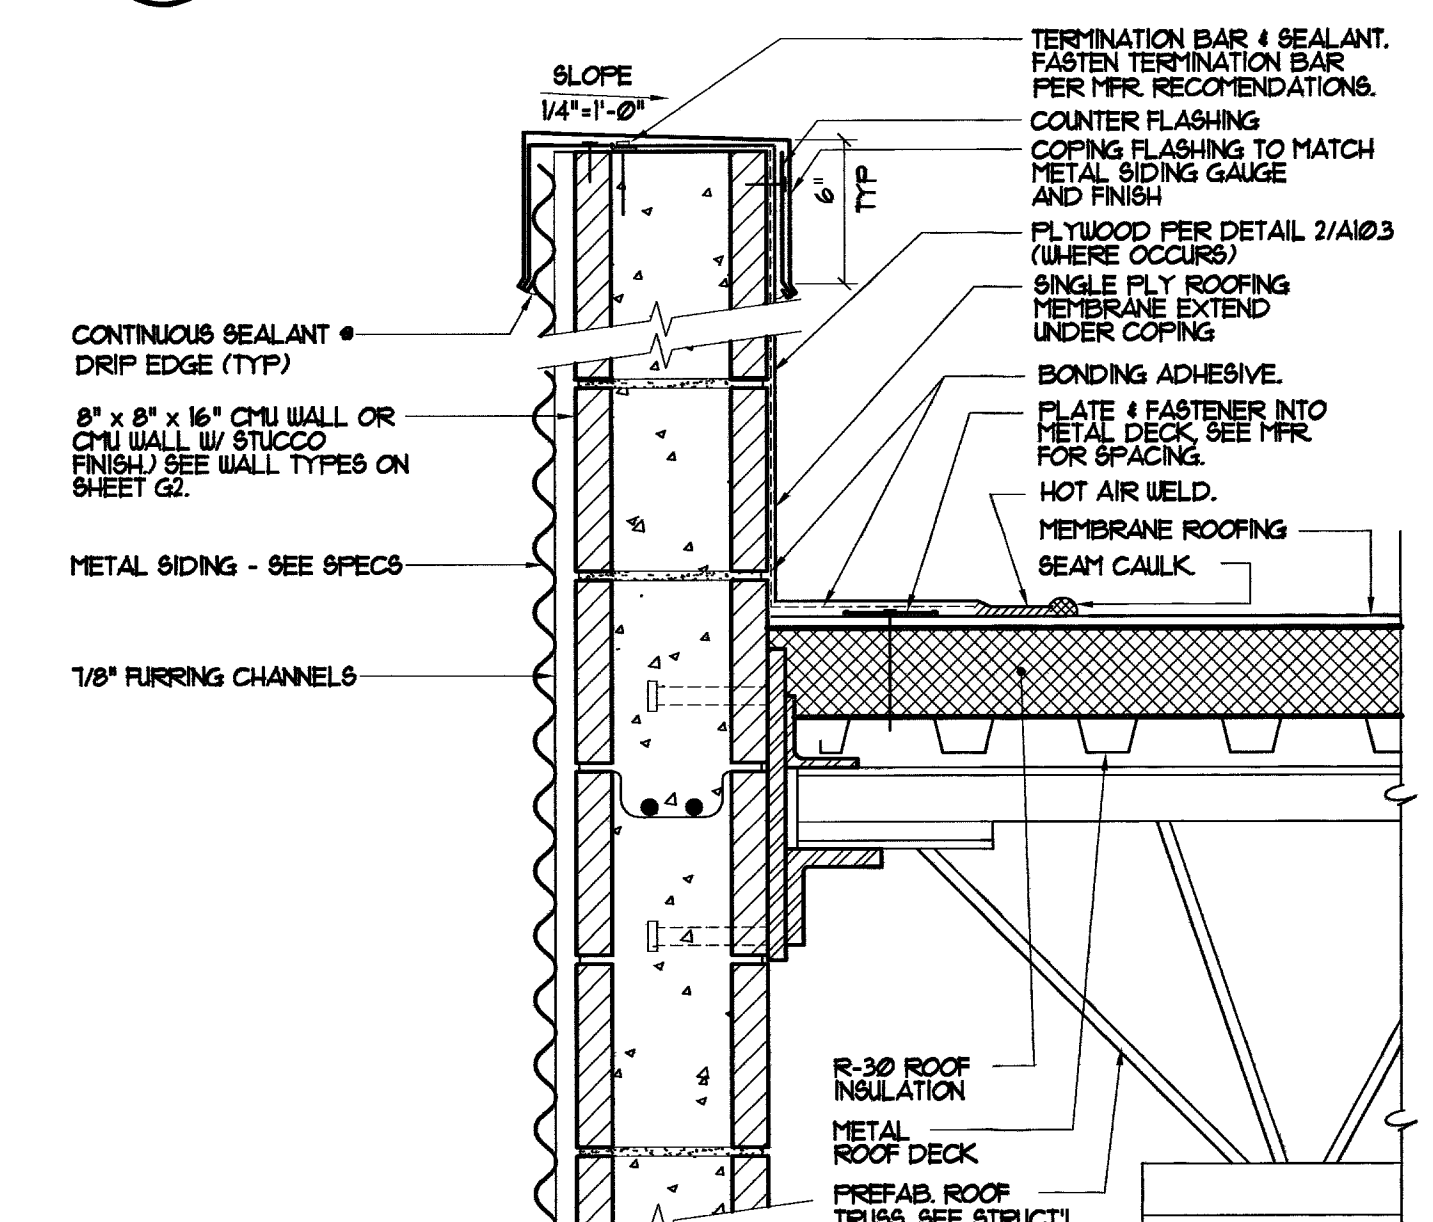


6 Parapet Dtl. @ CMU Wall
Scale: 1 1/2" = 1'-0"
A10-3-6

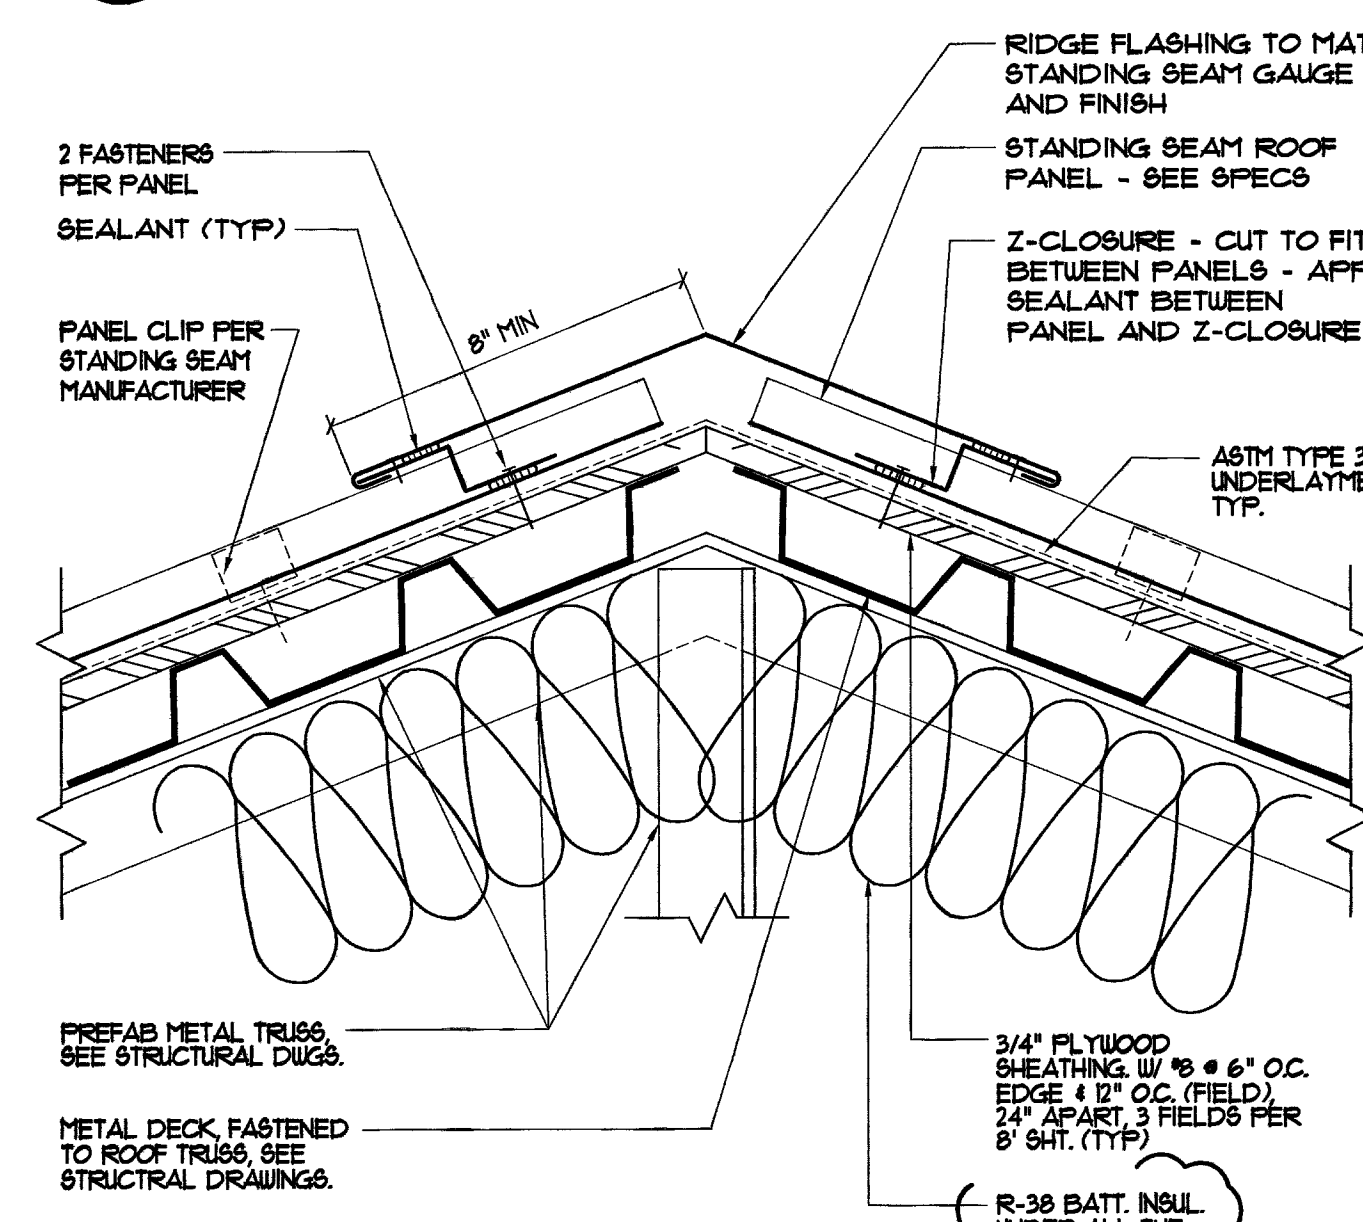


7 Ridge Trim Detail
Scale: 3" = 1'-0"
A10-3-7

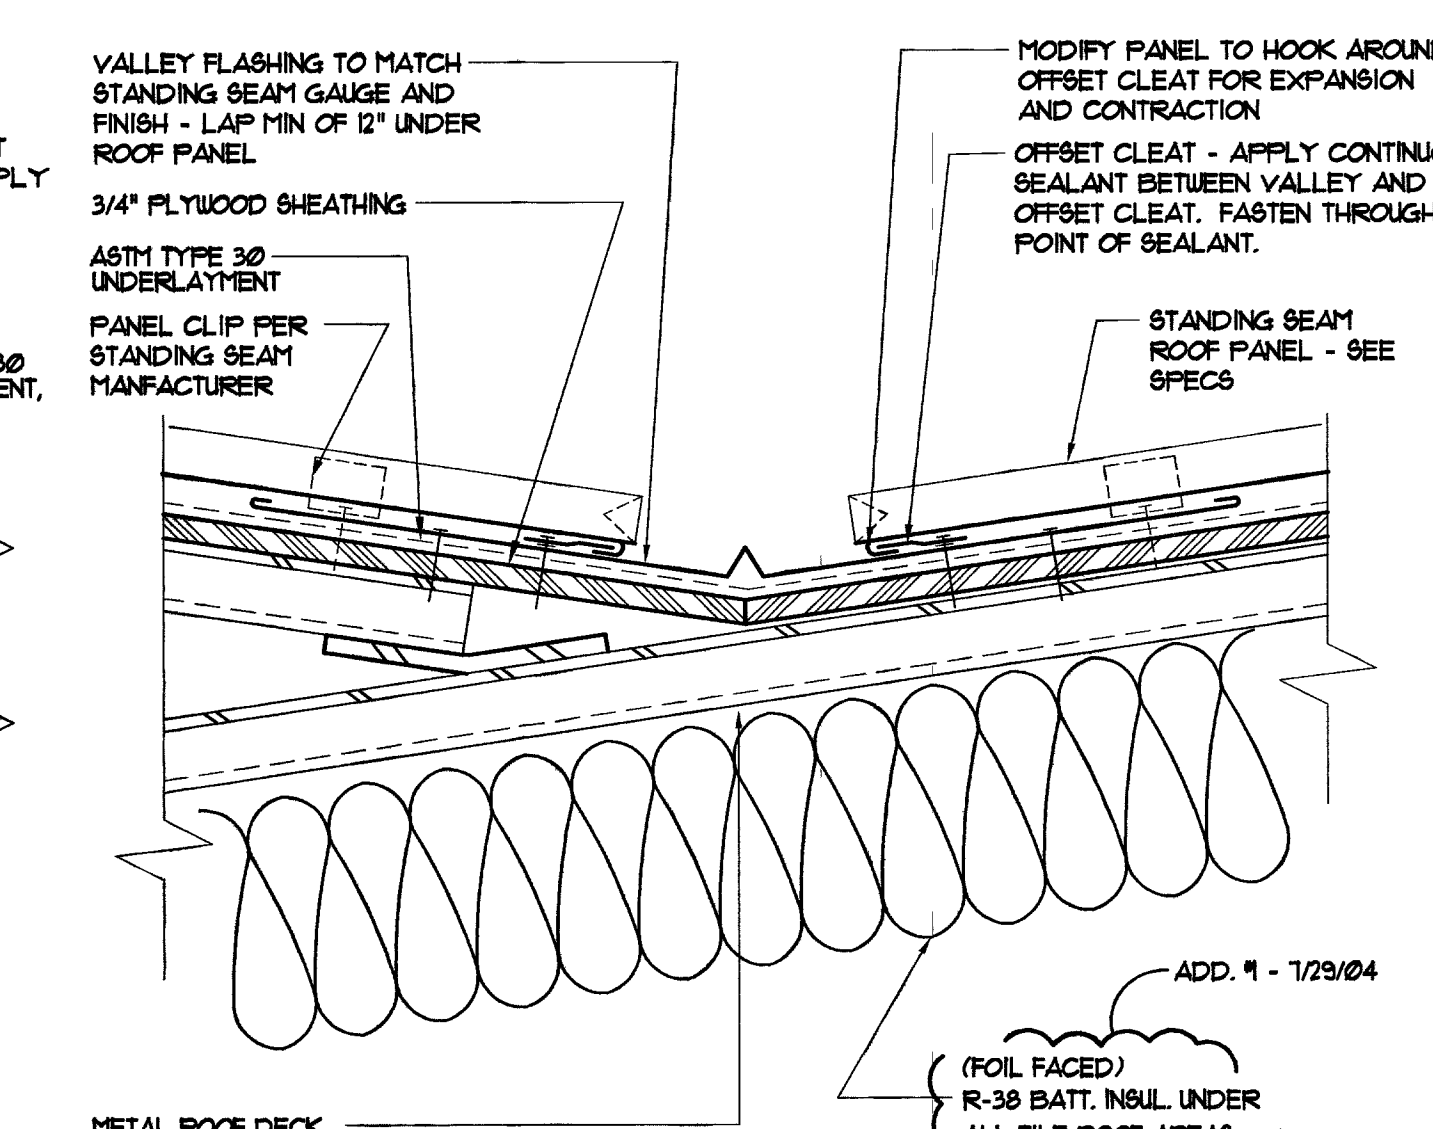


8 Closed Valley Flashing Detail
Scale: 3" = 1'-0"
A10-3-8

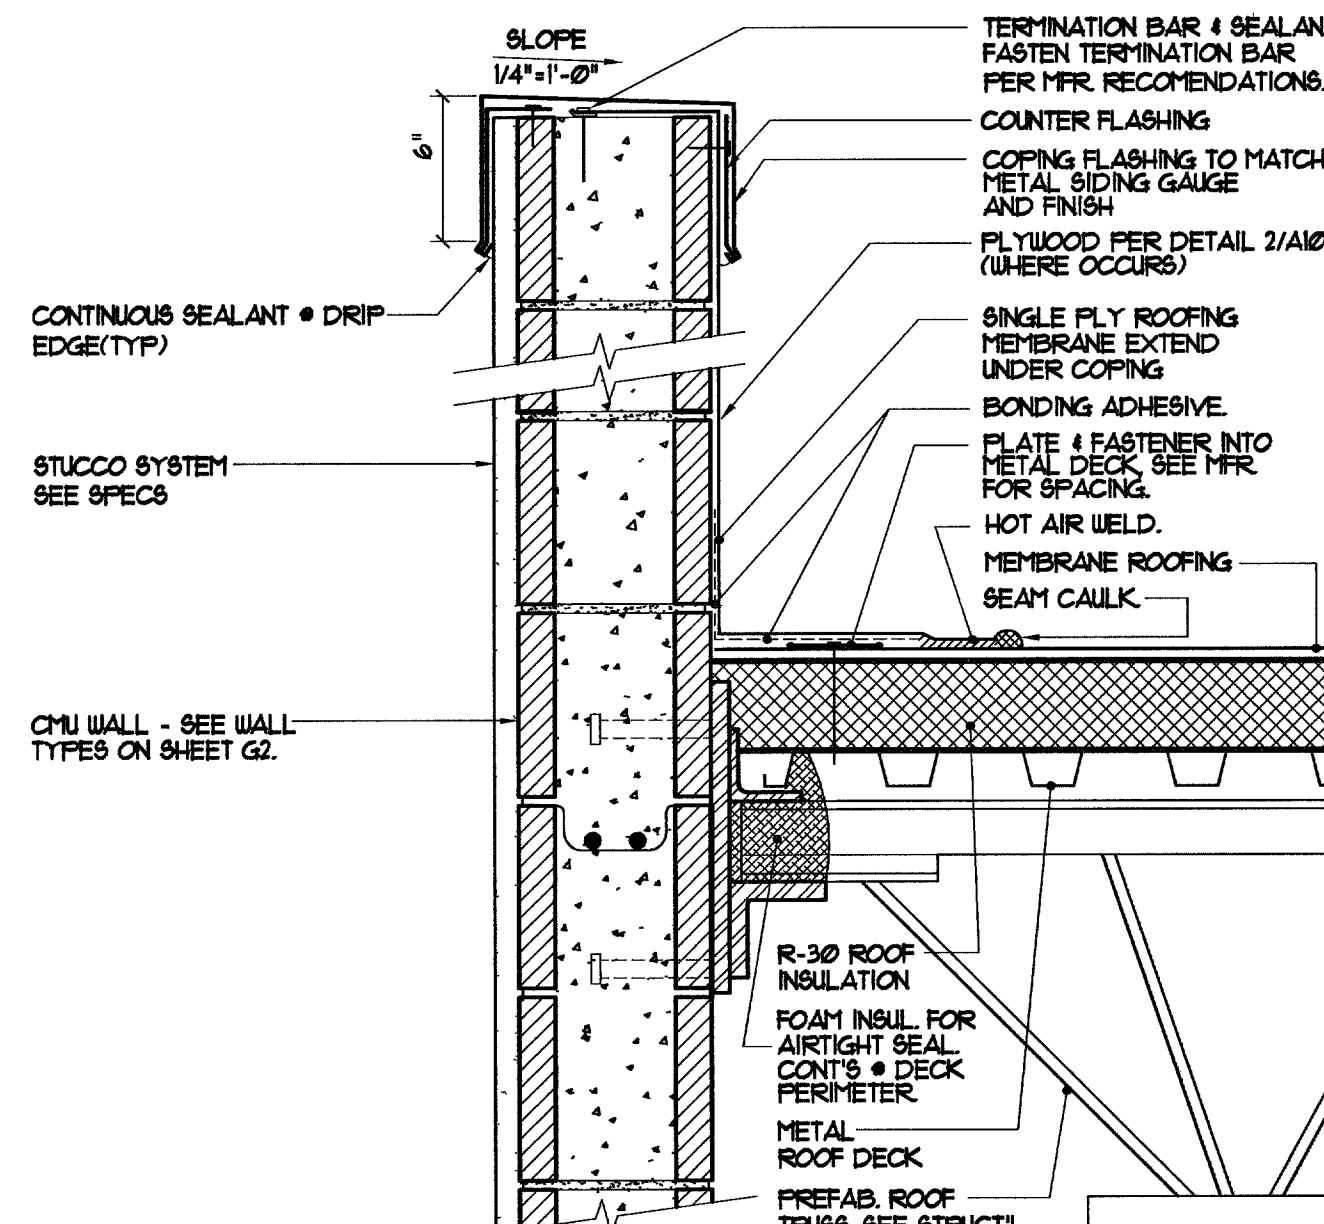


9 Parapet Detail
Scale: 1 1/2" = 1'-0"
A10-3-9

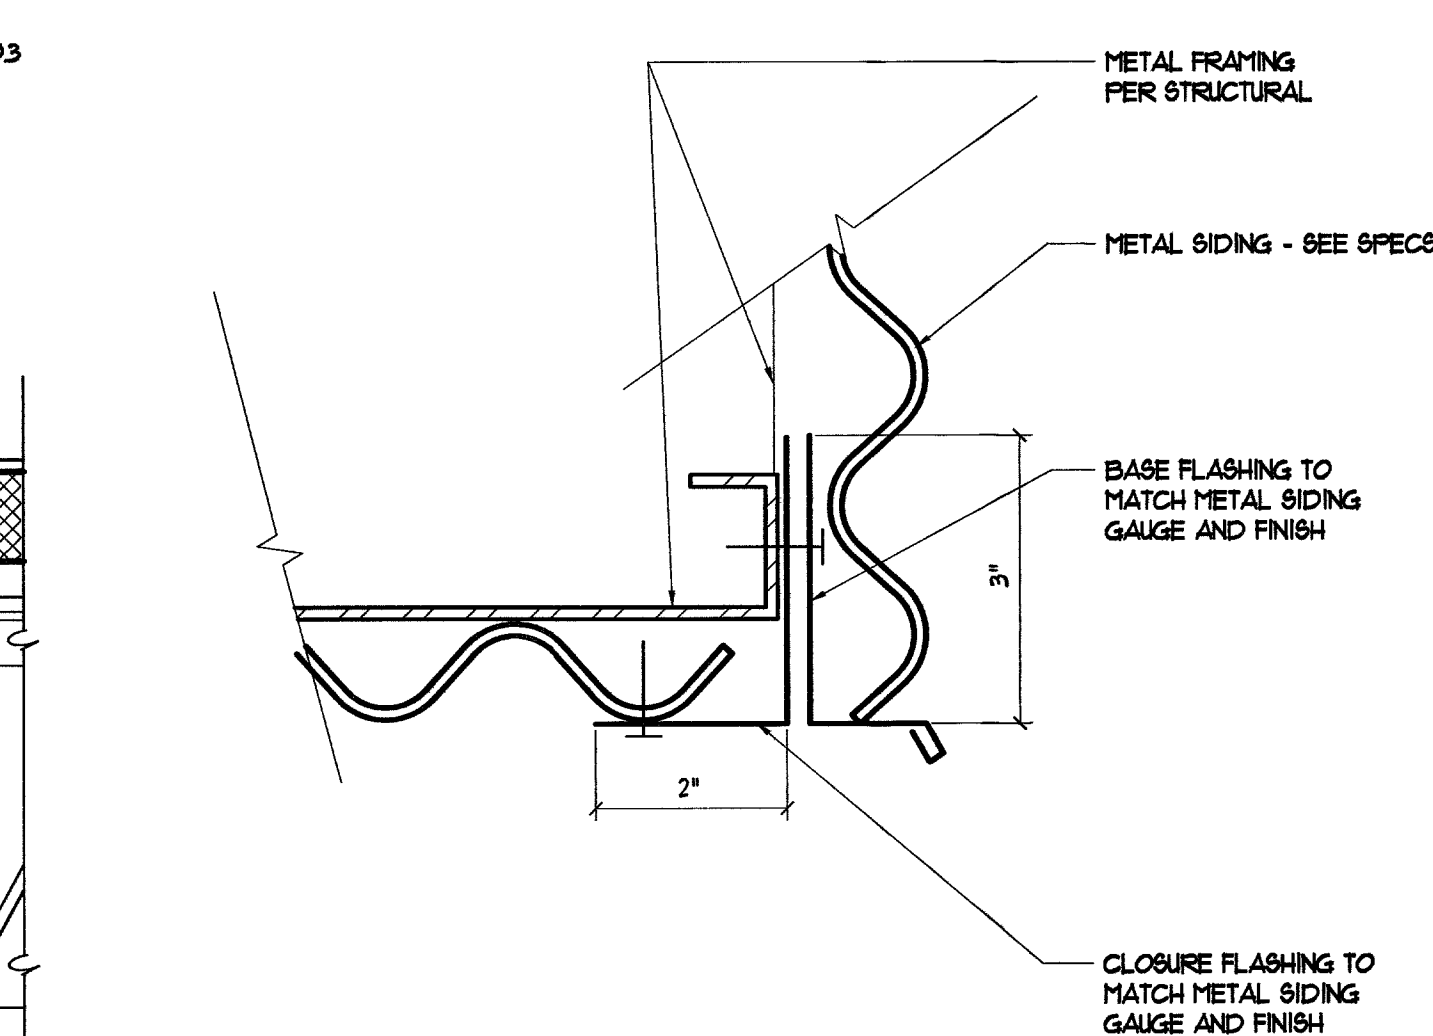

10 Trellis Base Flashing
Scale: 6" = 1'-0"
A10-3-10

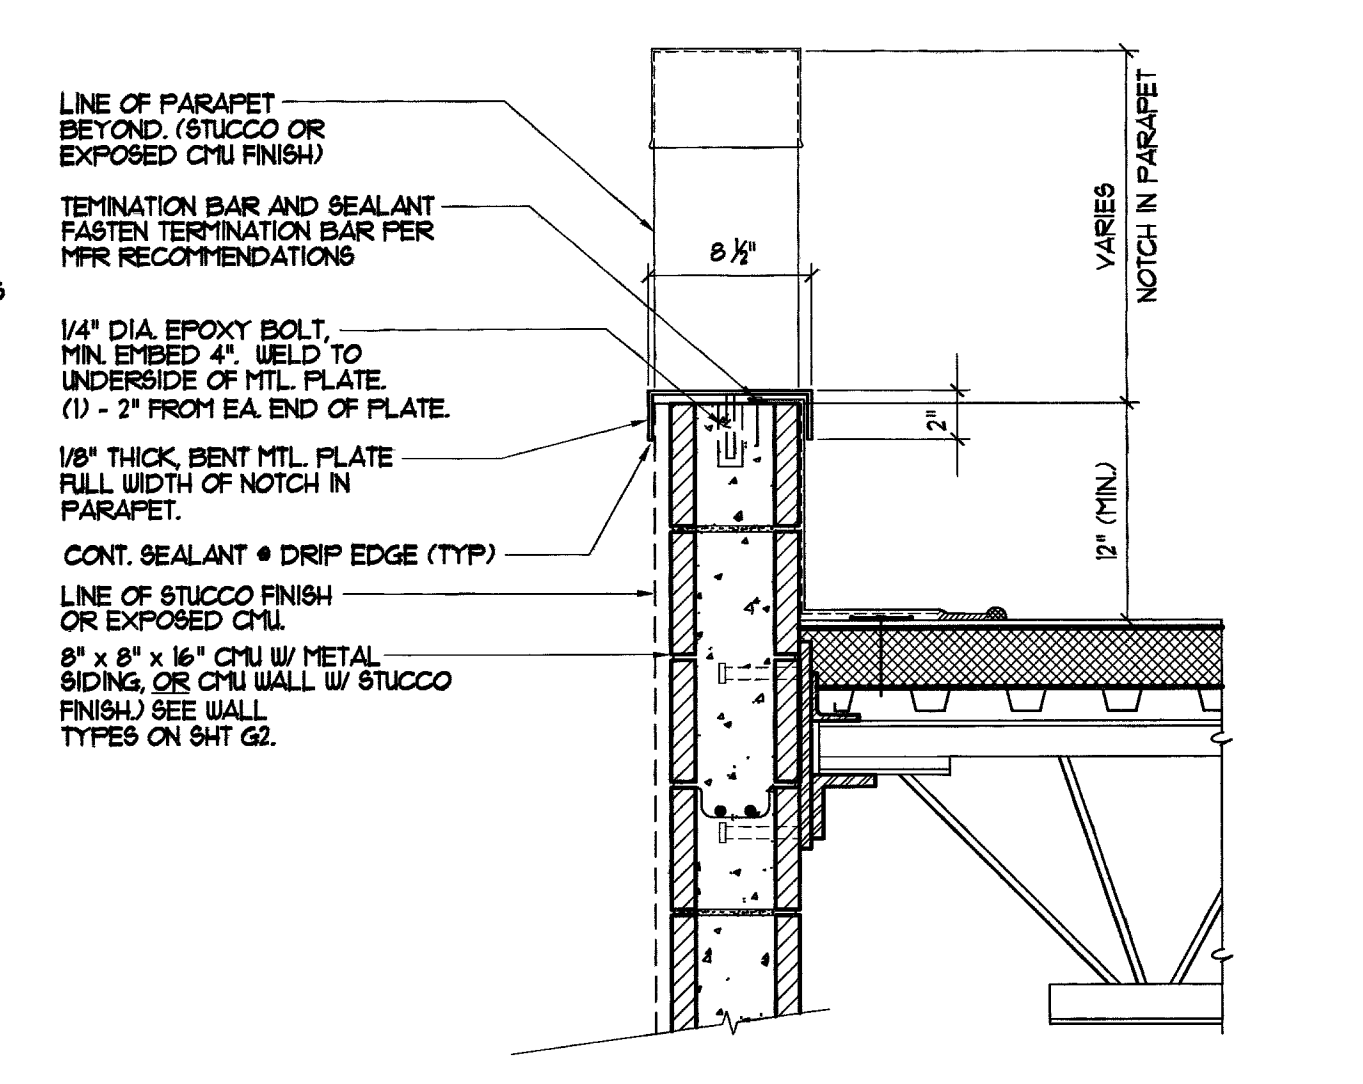

11 Roof Ladder Detail
Scale: 1" = 1'-0"
A10-3-11

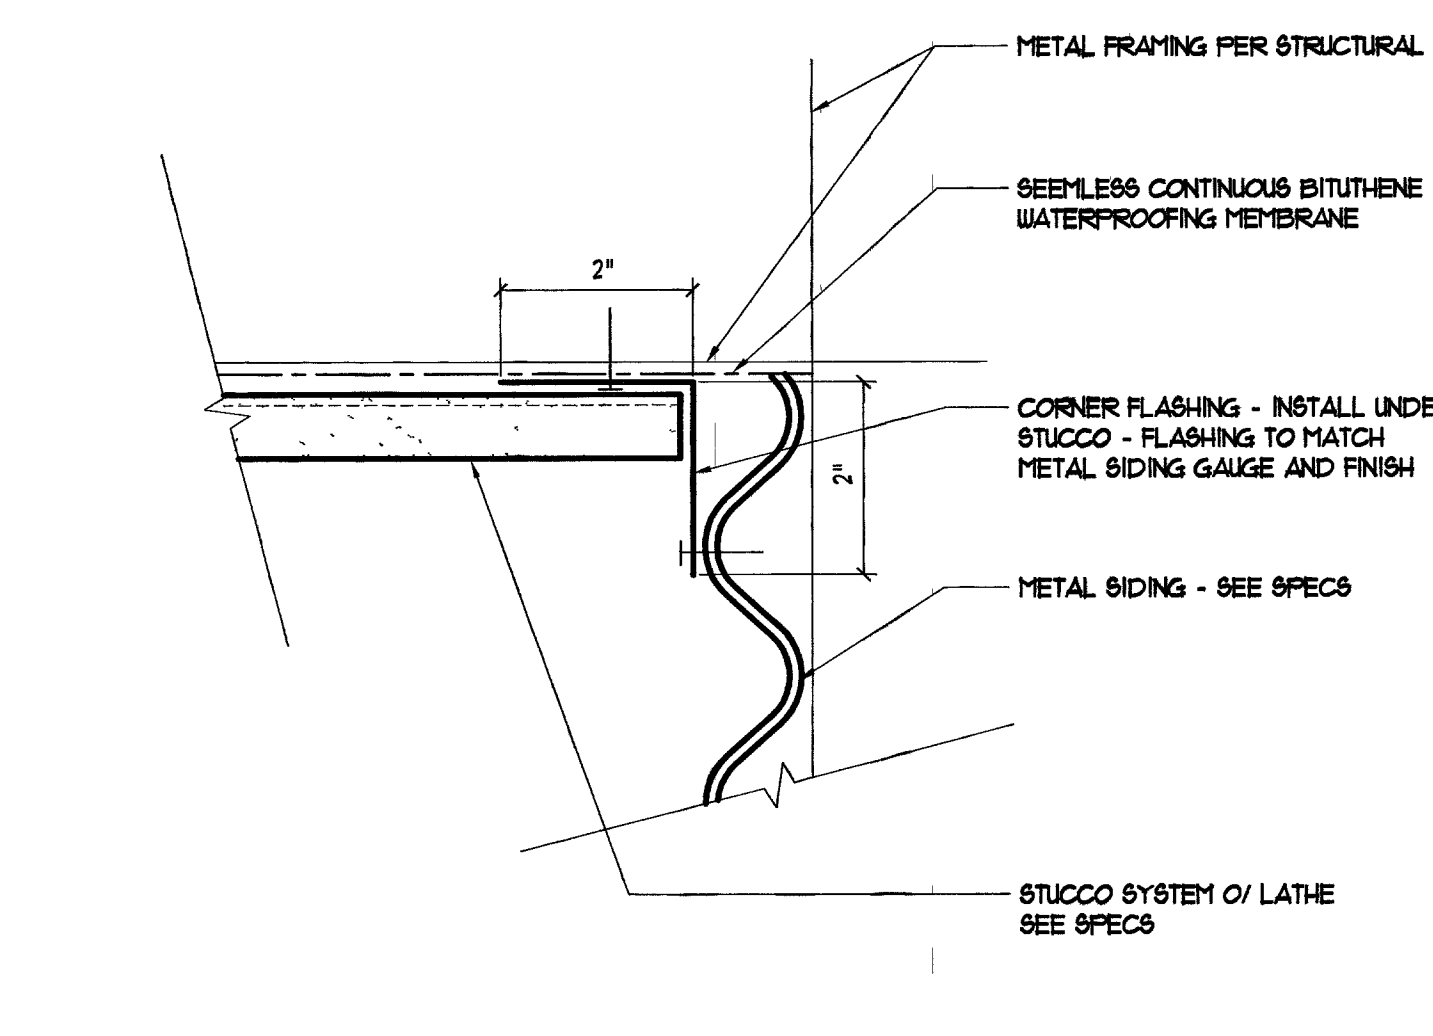

12 Trellis Corner Flashing
Scale: 6" = 1'-0"
A10-3-12

RECORD DRAWING

CITY OF LAS VEGAS, NEVADA
FIRE STATION #8
Details

REVISIONS	
NO.	DESCRIPTION

DEPARTMENT OF PUBLIC WORKS

OWNER: CITY OF LAS VEGAS
DEPARTMENT OF PUBLIC WORKS
ARCHITECTURAL SERVICES

ARCHITECT OF RECORD
SAMUEL D. TOLMAN, AIA, NCARB

400 EAST STEWART AVENUE
LAS VEGAS, NEVADA 89101
PHONE: (702) 229-6335
FAX: (702) 382-3232
TDD: (702) 386-9108

DRAWN	EPS	FILE	DATE	SCALE

BID NO: 03.1534104
CLV DWG NO: 630-101

056
SHEET NO

A10.3