




ROOF SCUPPER DET. ①
SCALE - 1" = 1'-0"

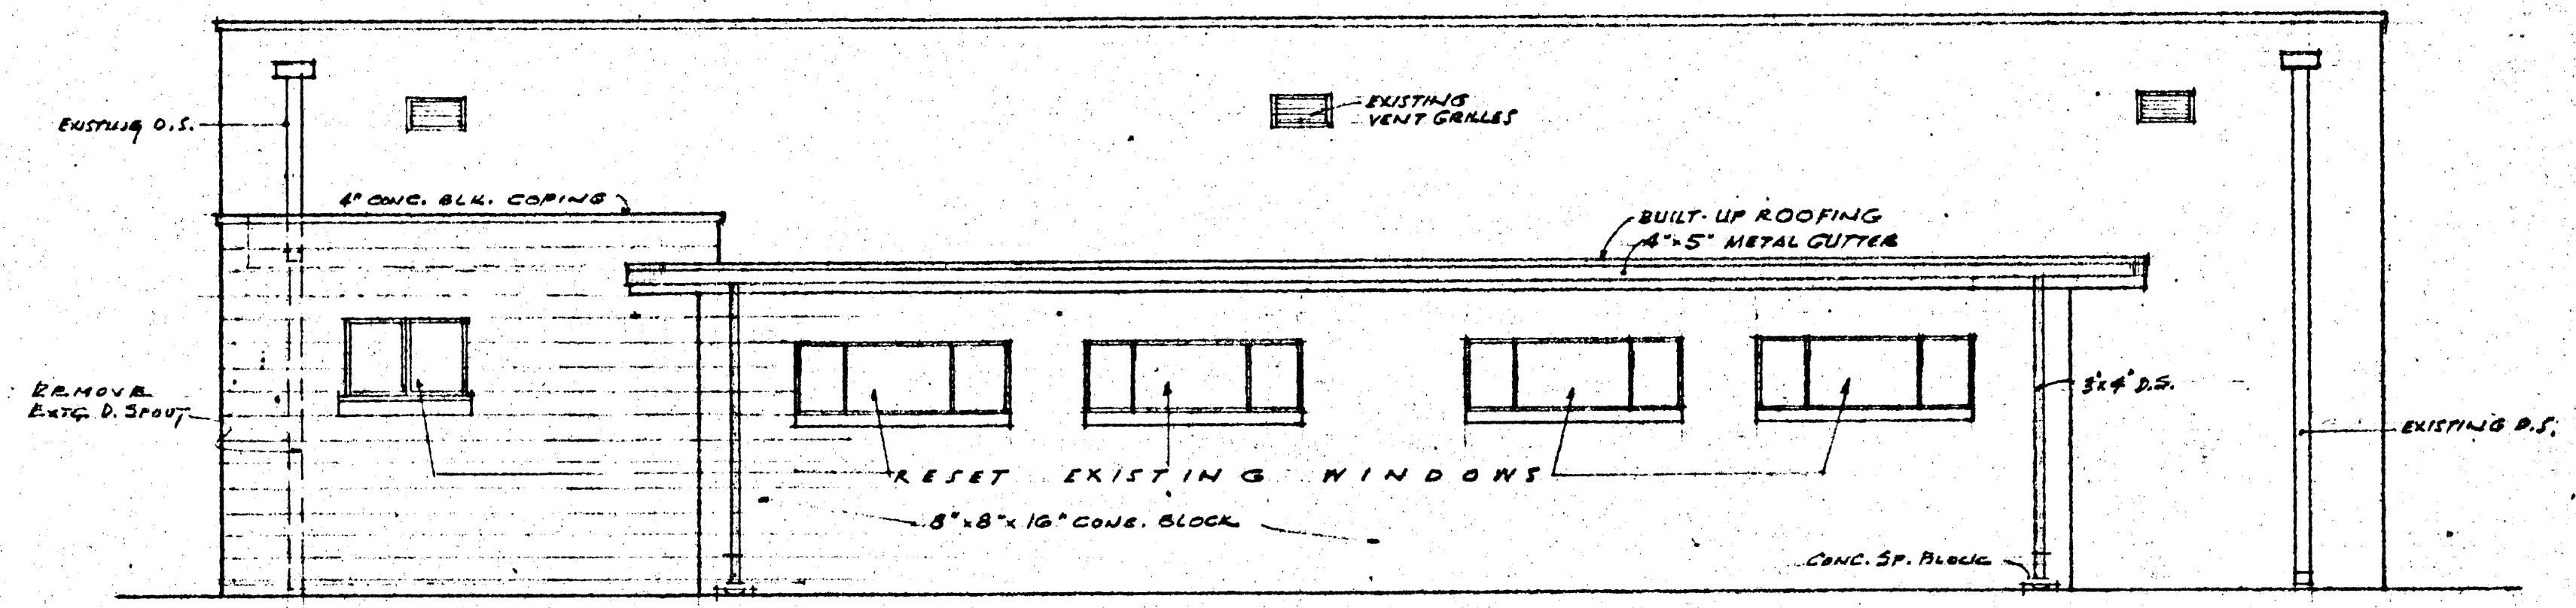

EAST ELEVATION
SCALE 1/4" = 1'-0"

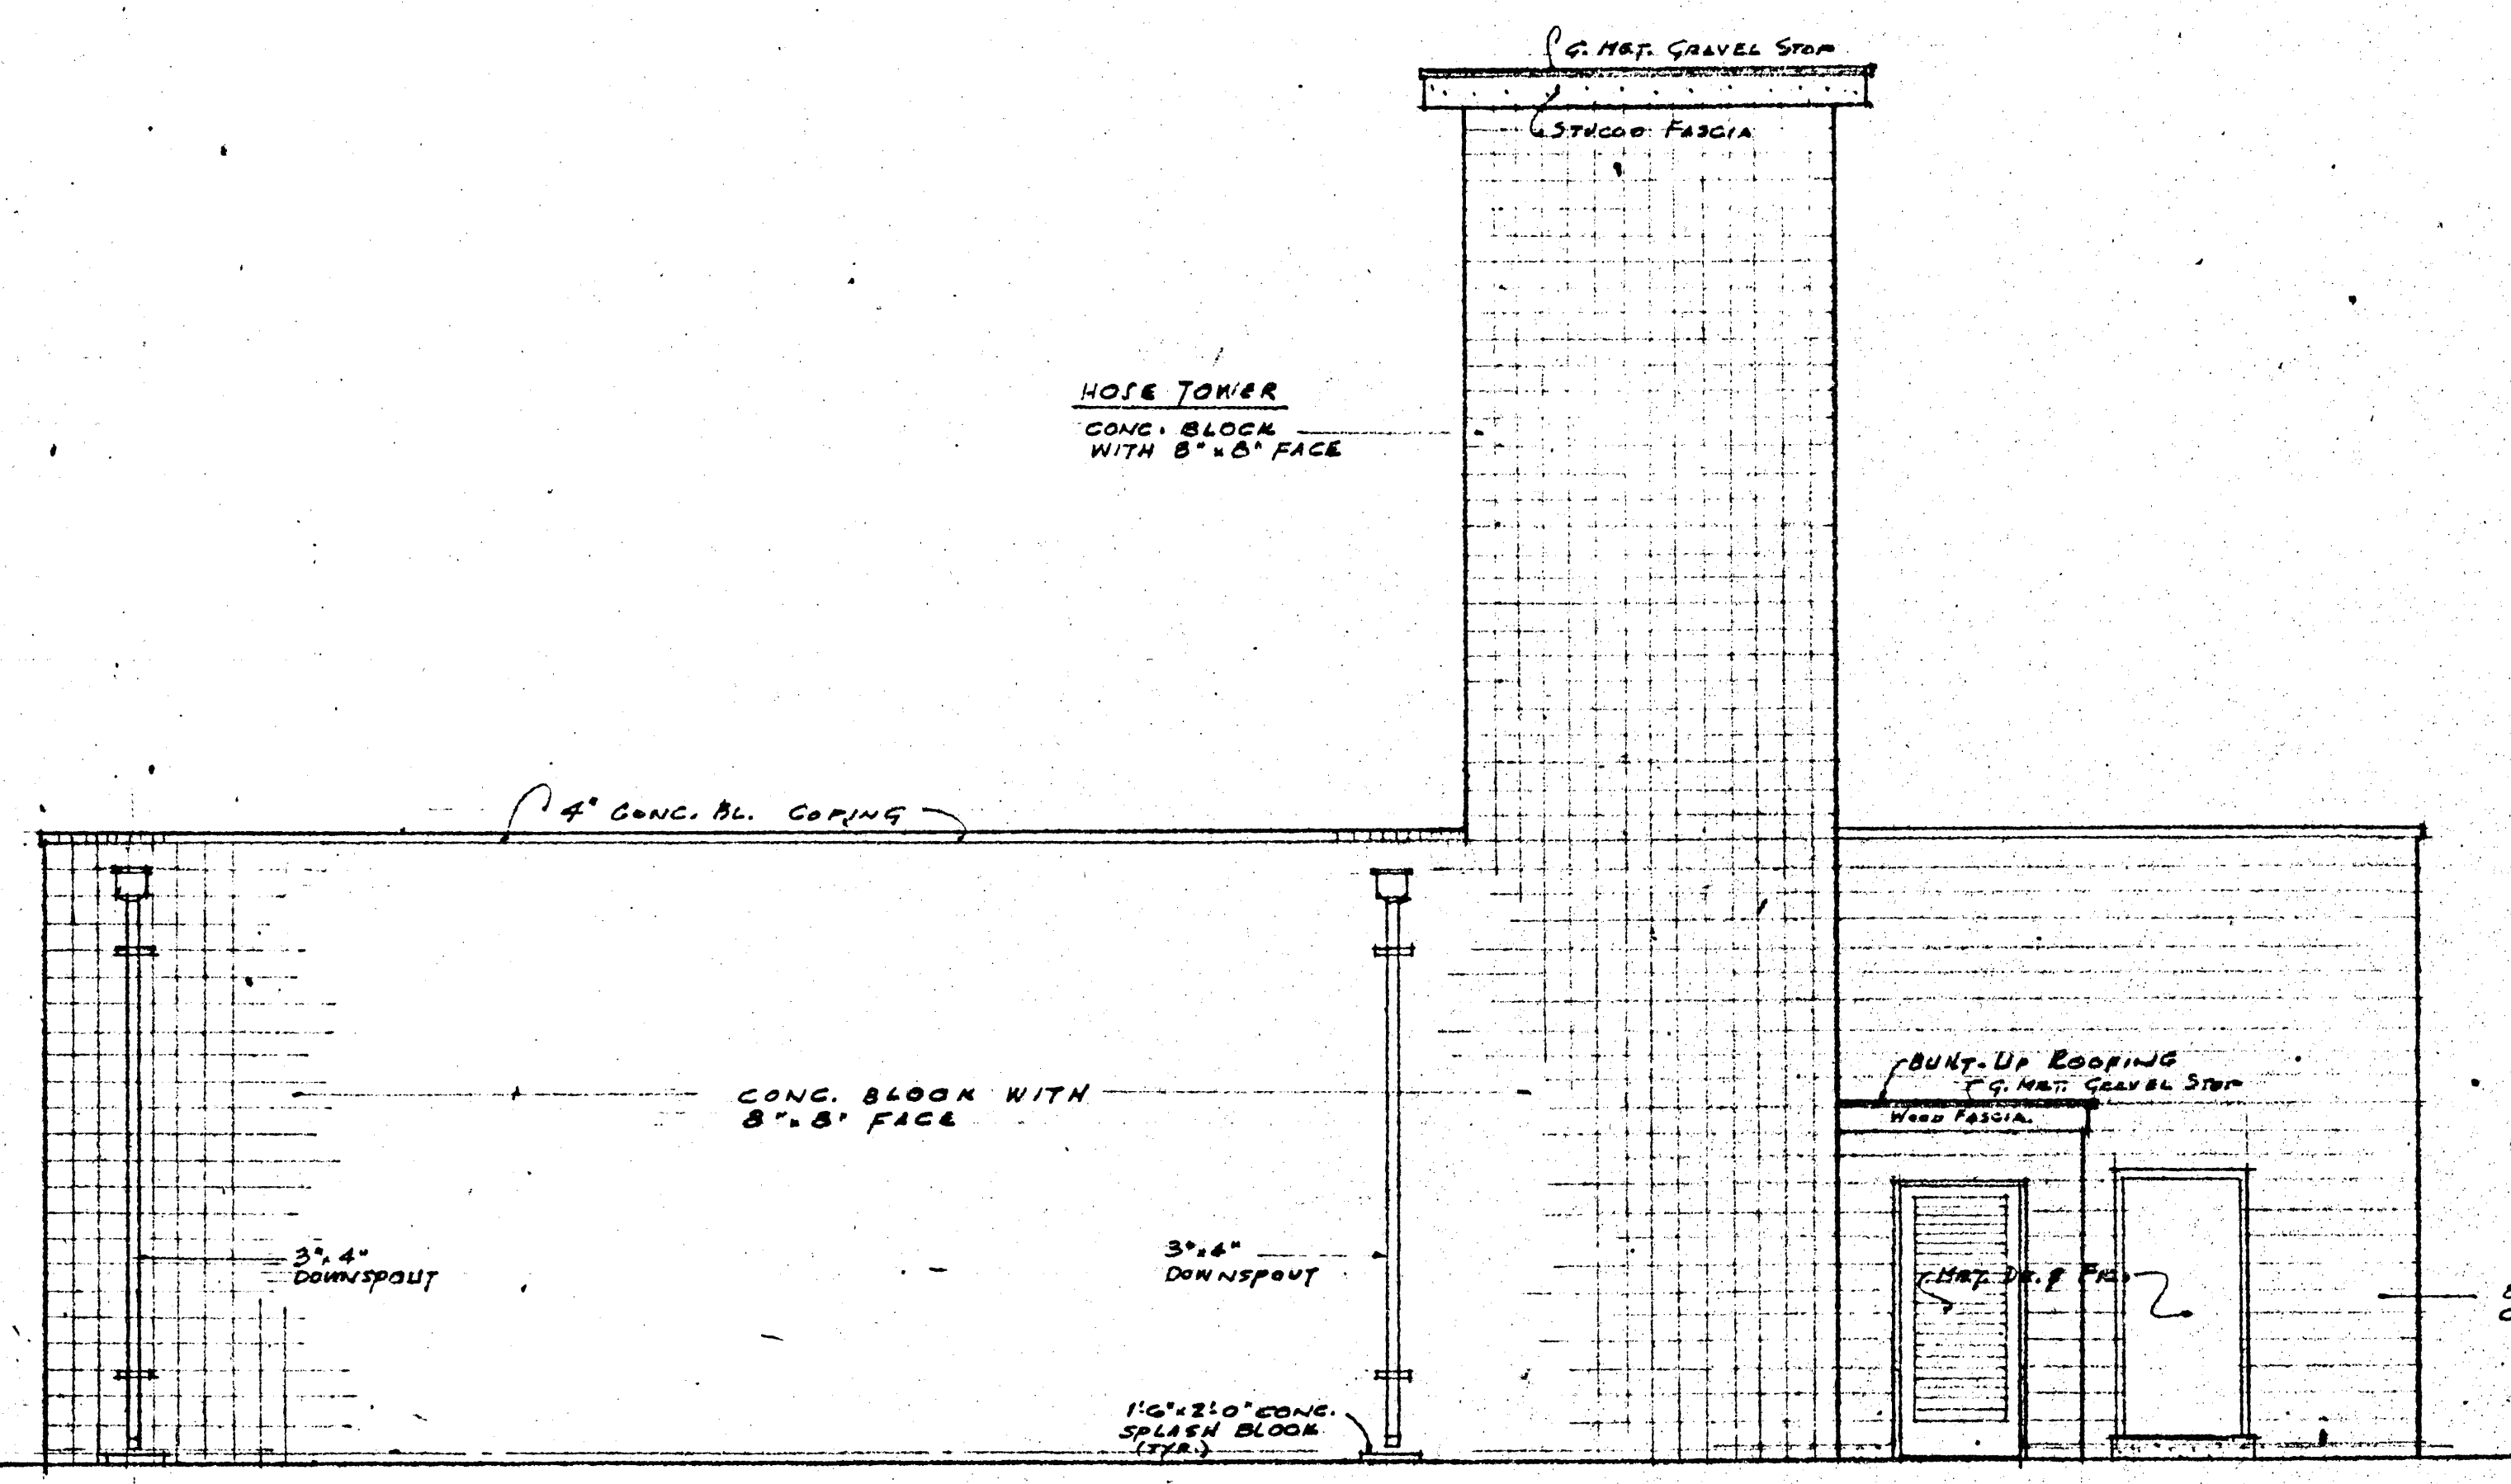

WEST ELEVATION
SCALE 1/4" = 1'-0"

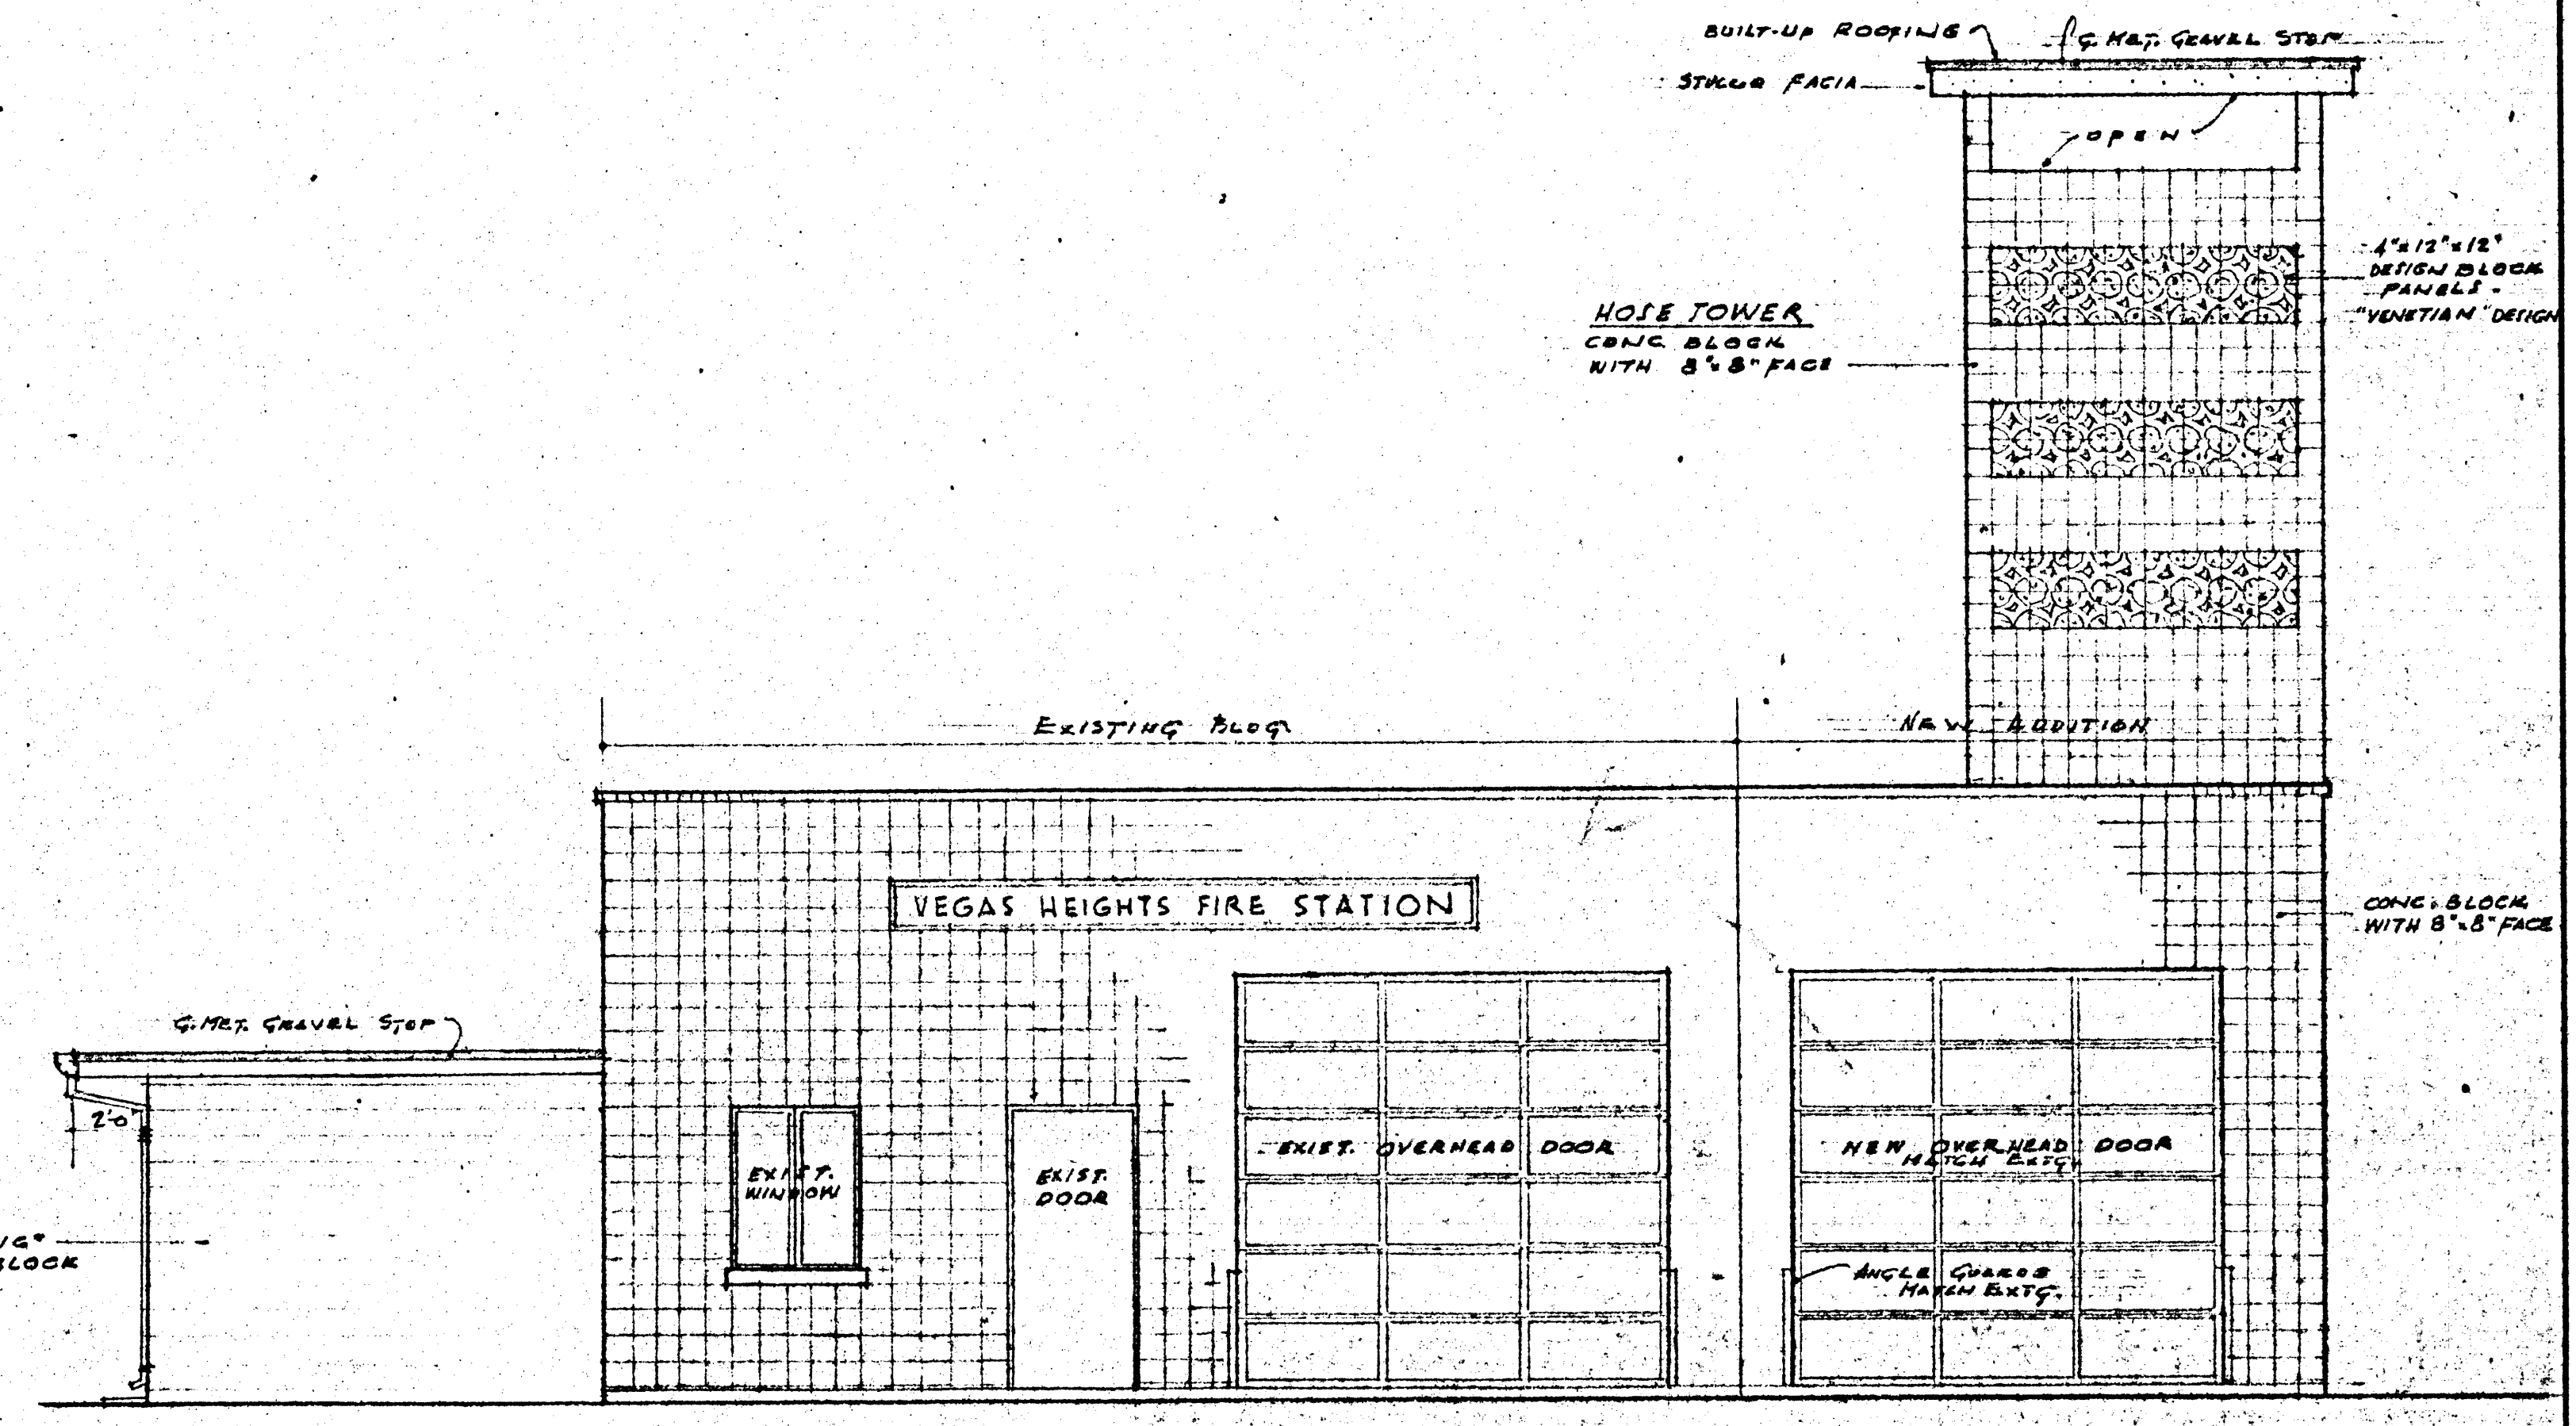

NORTH ELEVATION
SCALE 1/4" = 1'-0"

IRA C. MARSHAK EDWARD LEEDS
ARCHITECTS A.I.A.
820 S. SIXTH STREET LAS VEGAS, NEV.

VEGAS HEIGHTS FIRE STATION ADDITION
1201 WEST MILLER STREET
LAS VEGAS, NEVADA

SHEET TITLE
EXTERIOR ELEVATIONS

| | | | |
|------------------|-----------------|-----------|----------------------|
| DRAWN BY E.L. | DATE 1-28-65 | REVISIONS | SHEET NO. 5 OF 12 |
|------------------|-----------------|-----------|----------------------|

AS BUILT

DIRECTOR OF PUBLIC WORKS
CITY OF LAS VEGAS