

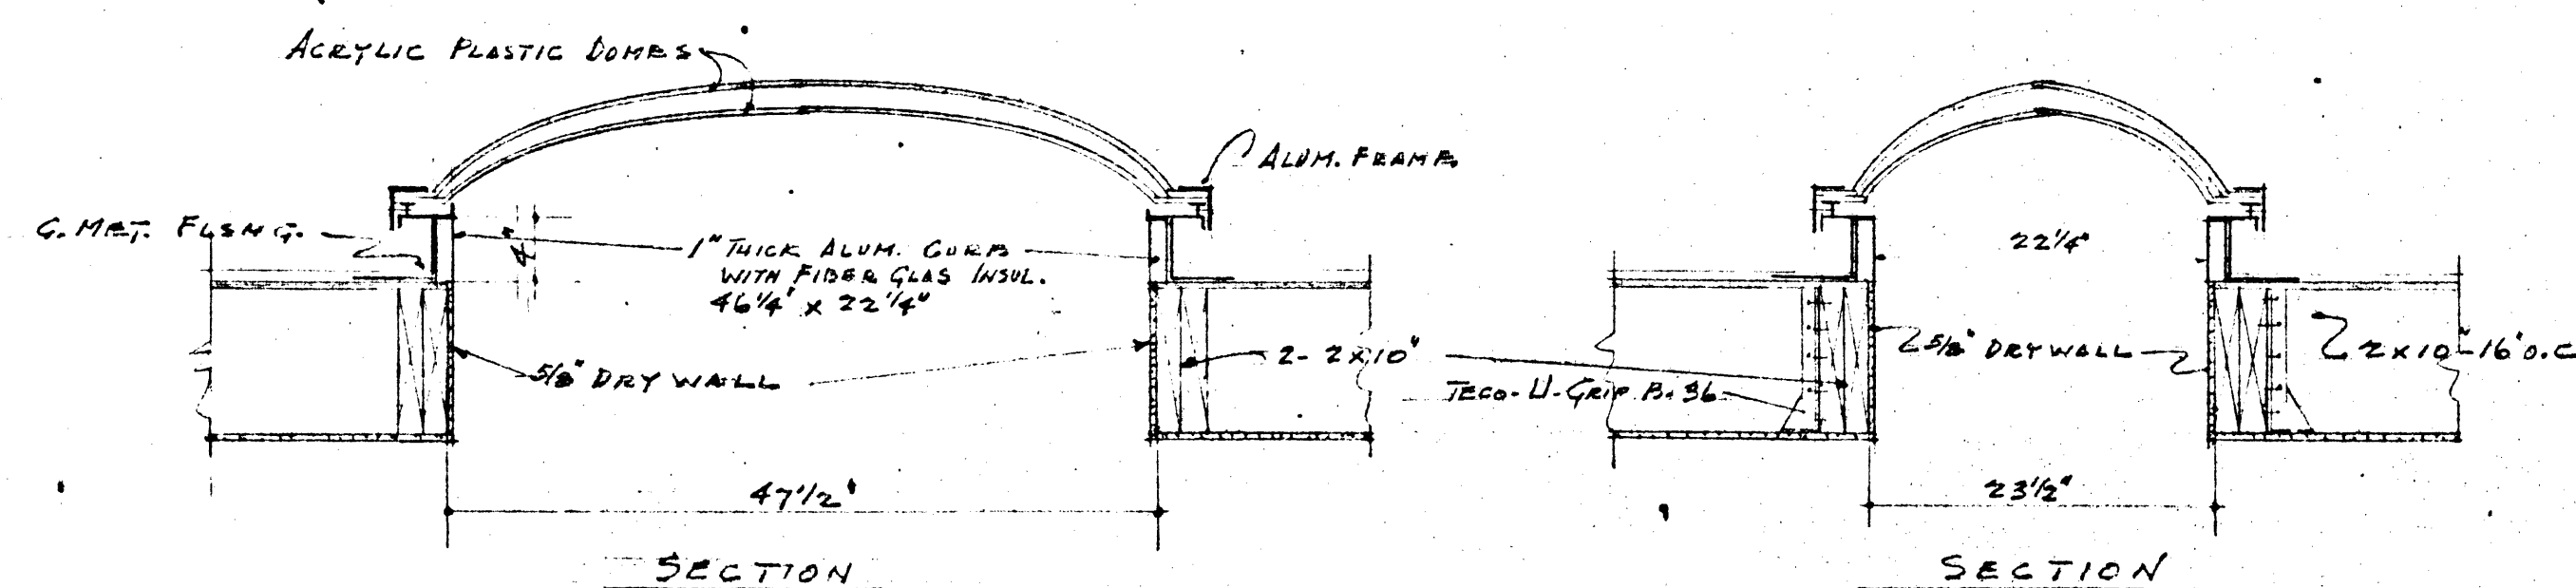


SKYDOME DETAILS (1)
SCALE - 1" = 1'-0"

SKYDOMES TO BE TWIN DOME UNIT DD41-2852 ACRYLIC SKYLIGHT,
AS MFGD. BY AMERICAN CYANAMID CO. COMPLETE WITH ALUM. FRAME,
INSULATED ALUM. CURB & ACRYLIC PLASTIC DOMES, CLEAR WHITE W-10.

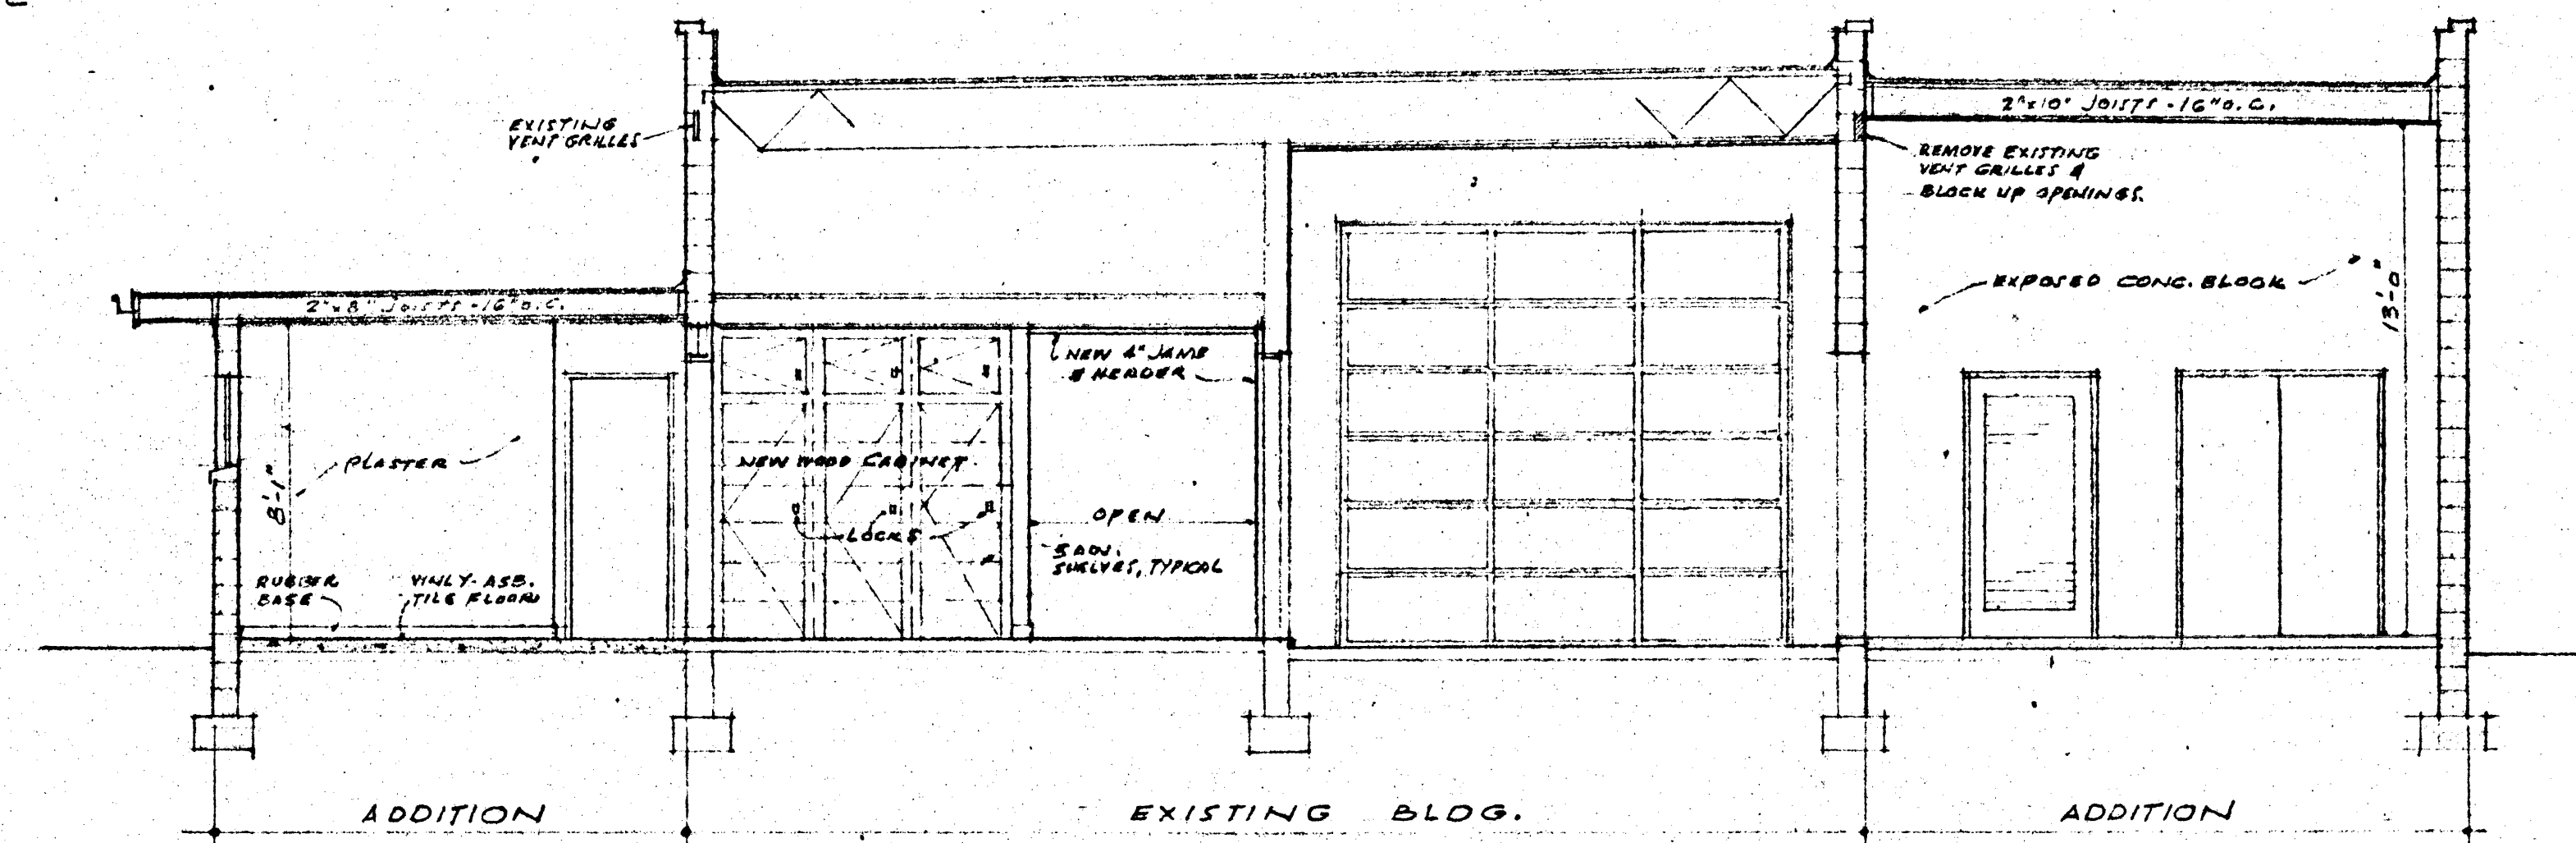

TYP. CROSS SECTION SCALE $\frac{1}{4}" = 1'-0"$
(FOR DETAILS SEE SECTION "A-A" SHT. A-7)

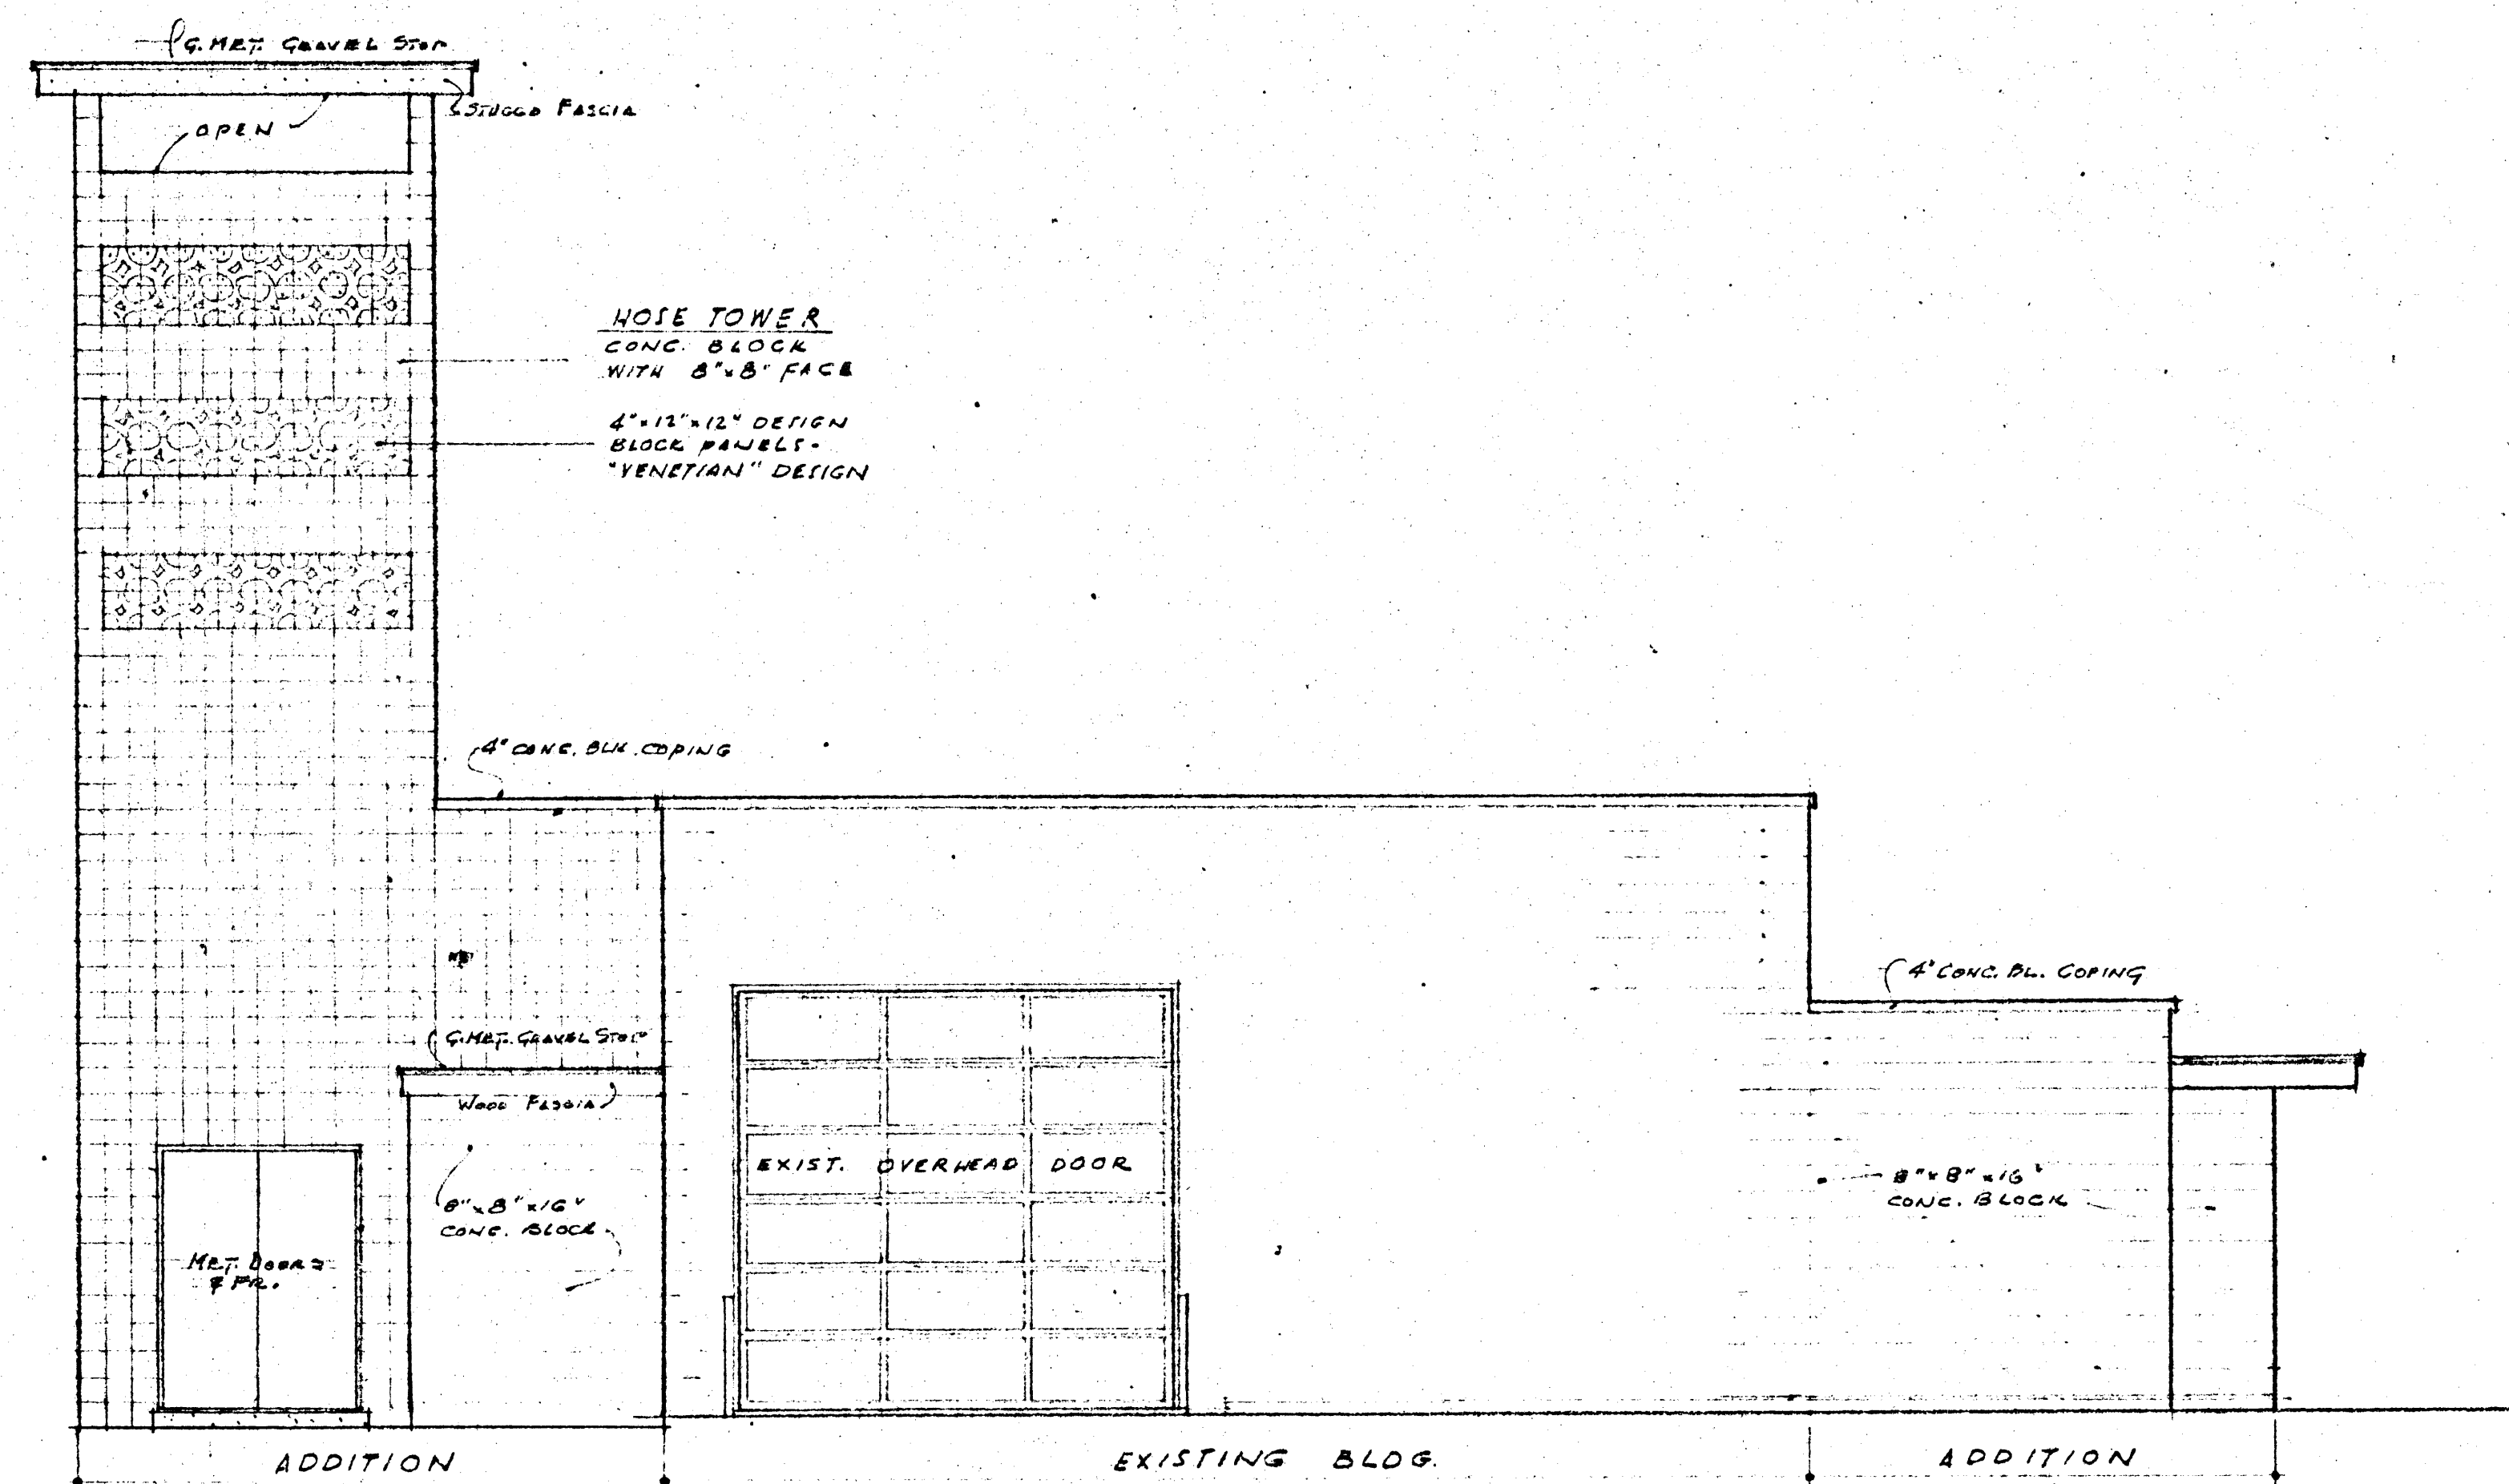

SOUTH ELEVATION SCALE 1/4"=1'-0"

AS BUILT

IRA C. MARSHAK EDWARD LEEDS
ARCHITECTS A.I.A.
820 S. SIXTH STREET LAS VEGAS, NEV.

EDWARD LEEDS

VEGAS HEIGHTS FIRE STATION ADDITION
1201 WEST MILLER STREET
LAS VEGAS NEVADA

SHEET TITLE	
EXTERIOR ELEVATION - TYPICAL CROSS SECTION	

DRAWN	E. L.
DATE	1-28-6

A441198	REVISIONS		SHEET NO.	
			A-6	6
				OF
				12