

**INTERIOR ELEVATION**

5  
A2.2

**INTERIOR ELEVATION**

4  
A2.2

**INTERIOR ELEVATION**


3  
A2.2

**INTERIOR ELEVATION**

2  
A2.2


**INTERIOR ELEVATION**

1  
A2.2

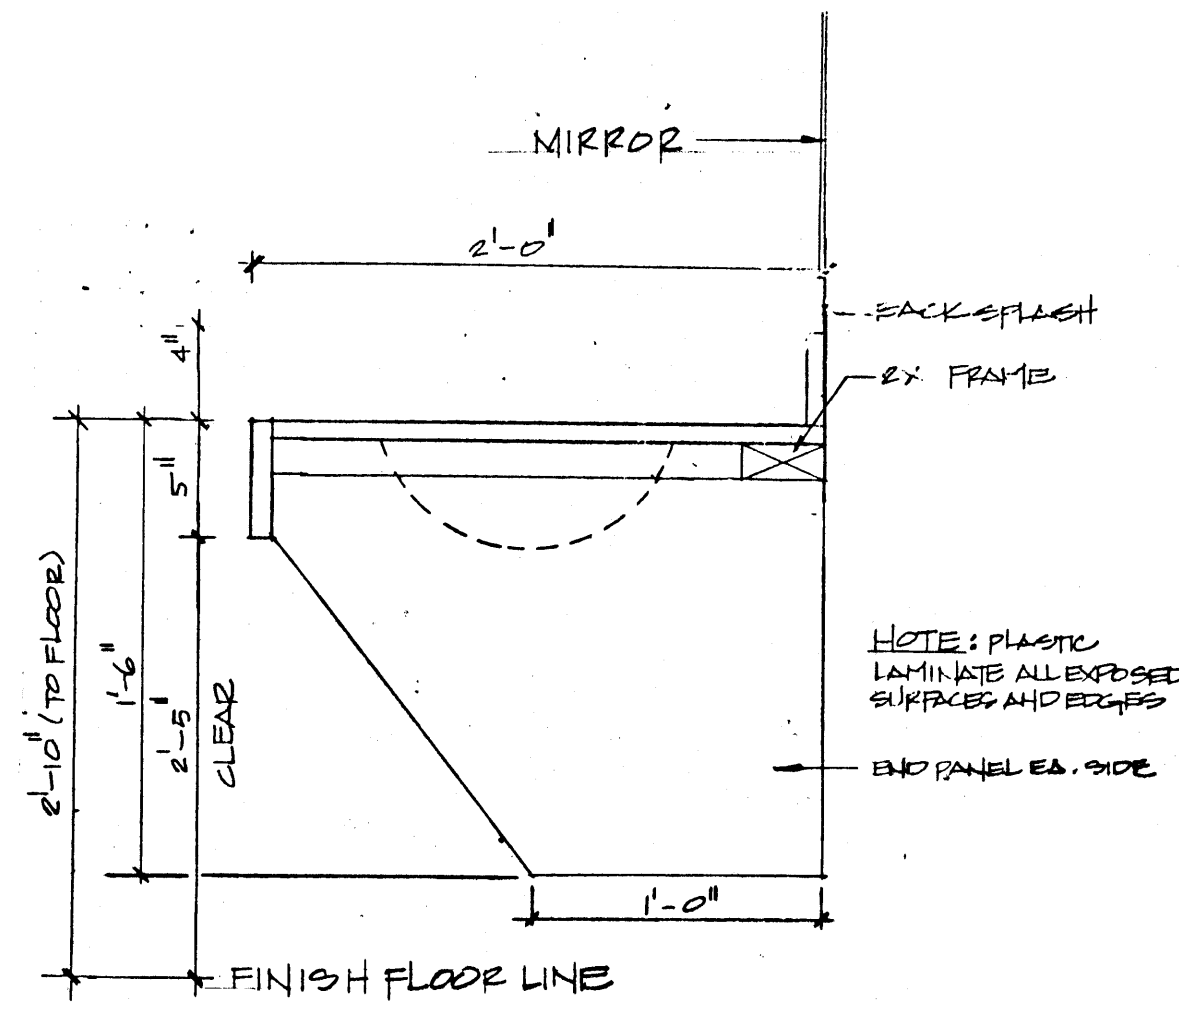

**VANITY DETAIL**

7  
A2.2

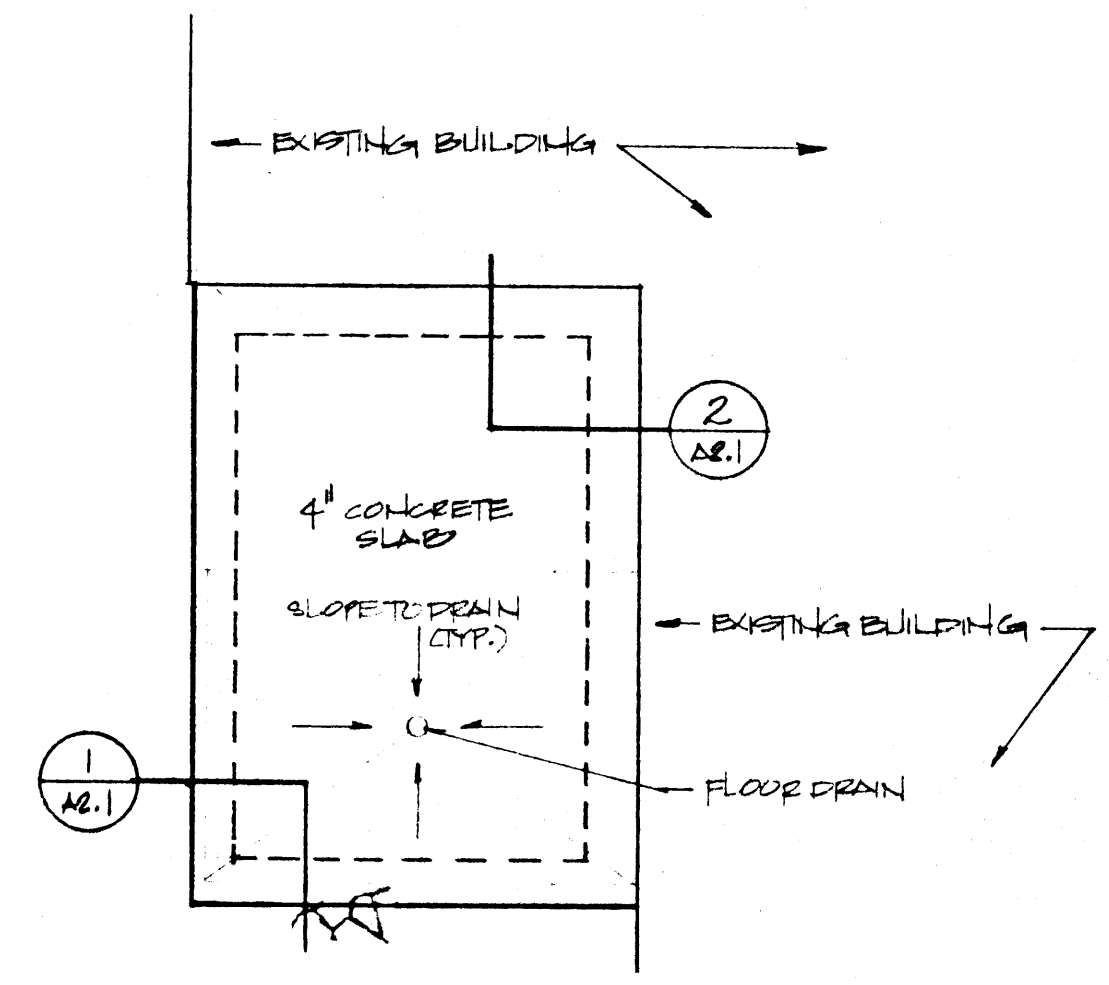

**FOUNDATION PLAN**

6  
A2.2

**DOOR SCHEDULE**

NUMBER	DOOR TYPE	DOOR SIZE	FRAME TYPE	FRAME PROFILE	HEAD DETAIL	SWHS DETAIL	SWMS DETAIL	THOLD DETAIL	HARDWARE SET	RATING WIND	REMARKS
103-1	A	2'-10" x 6'-8" x 1 3/4"	1	A	5/A6.0	5/A6.0	7/A6.0	7/A6.0	2	-	

**ROOM FINISH SCHEDULE**

(SEE SHEET A6.0 FOR FINISH SCHEDULE KEY)

NUMBER	NAME	FLOOR *	BASE	WALL 1	WALL 2	WALL 3	WALL 4	CEILING	CEILING HEIGHT	REMARKS
107	WOMEN'S BATHROOM	CT1	CT3	PS/ K/PP	PS/ K/PP	PS/ K/PP	PS/ K/PP	PS/ K/PP	8'-0"	

Patrick J. Mark AIA  
Wayne P. Schaefer AIA  
Thomas H. Sika AIA

**HSA ARCHITECTS, INC.**  
Architecture Planning Interiors  
1531 West Oakley Boulevard, Las Vegas, Nevada 89102  
(702) 383-0077 FAX (702) 383-0057

**FIRE STATION #5 - INTERIOR ELEVATIONS**  
**FEMALE FIRE FIGHTERS**  
**BATHROOM FACILITY ADDITIONS**

901002.0  
29 JAN 1991  
TRM  
TMS

Sheet  
**A2.2**

12

AS-BUILT DRAWINGS

4-145

630-83