




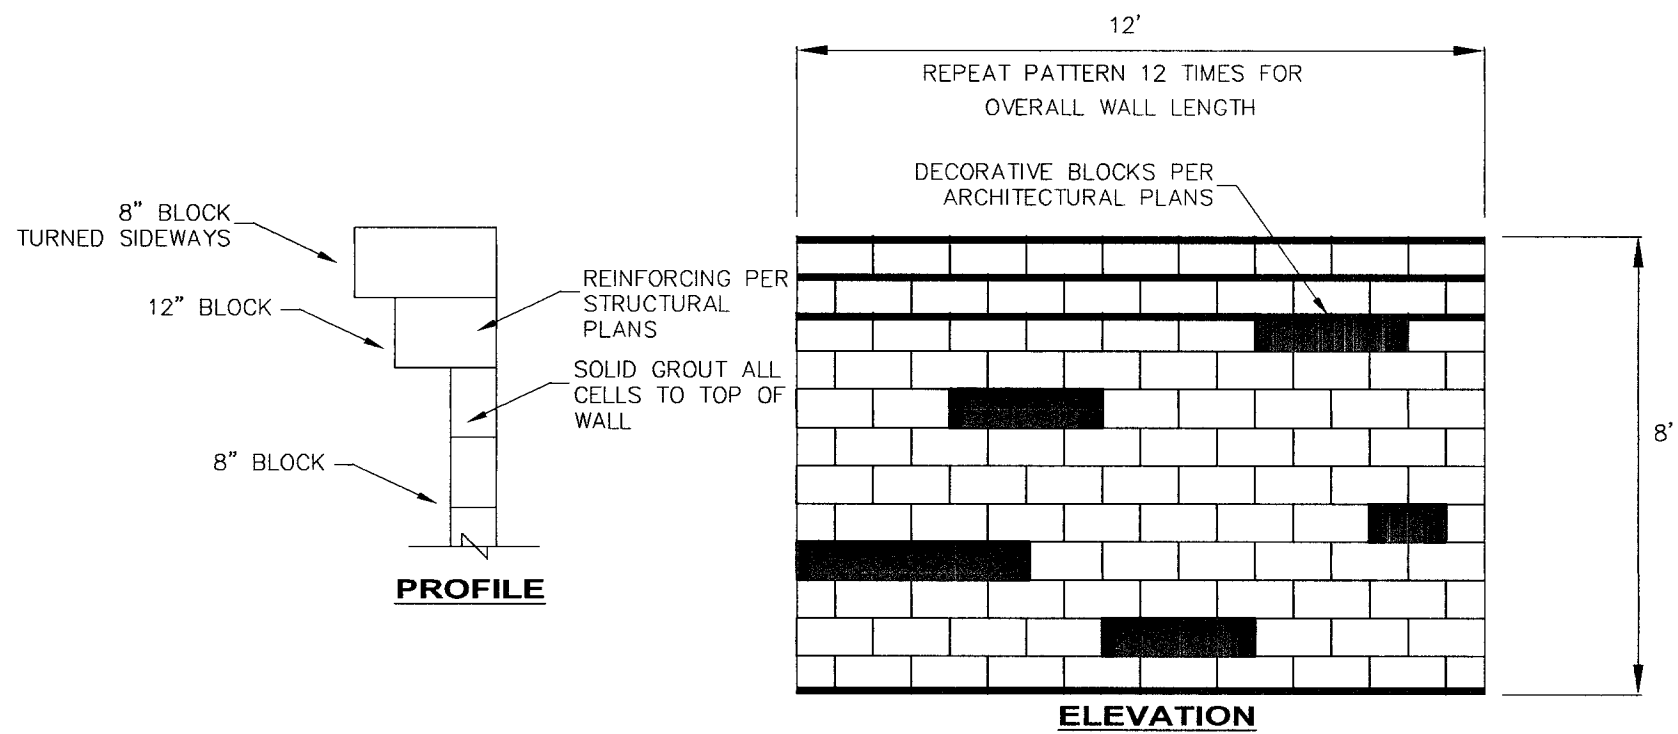

1 CMU BLOCK WALL DETAIL
NTS

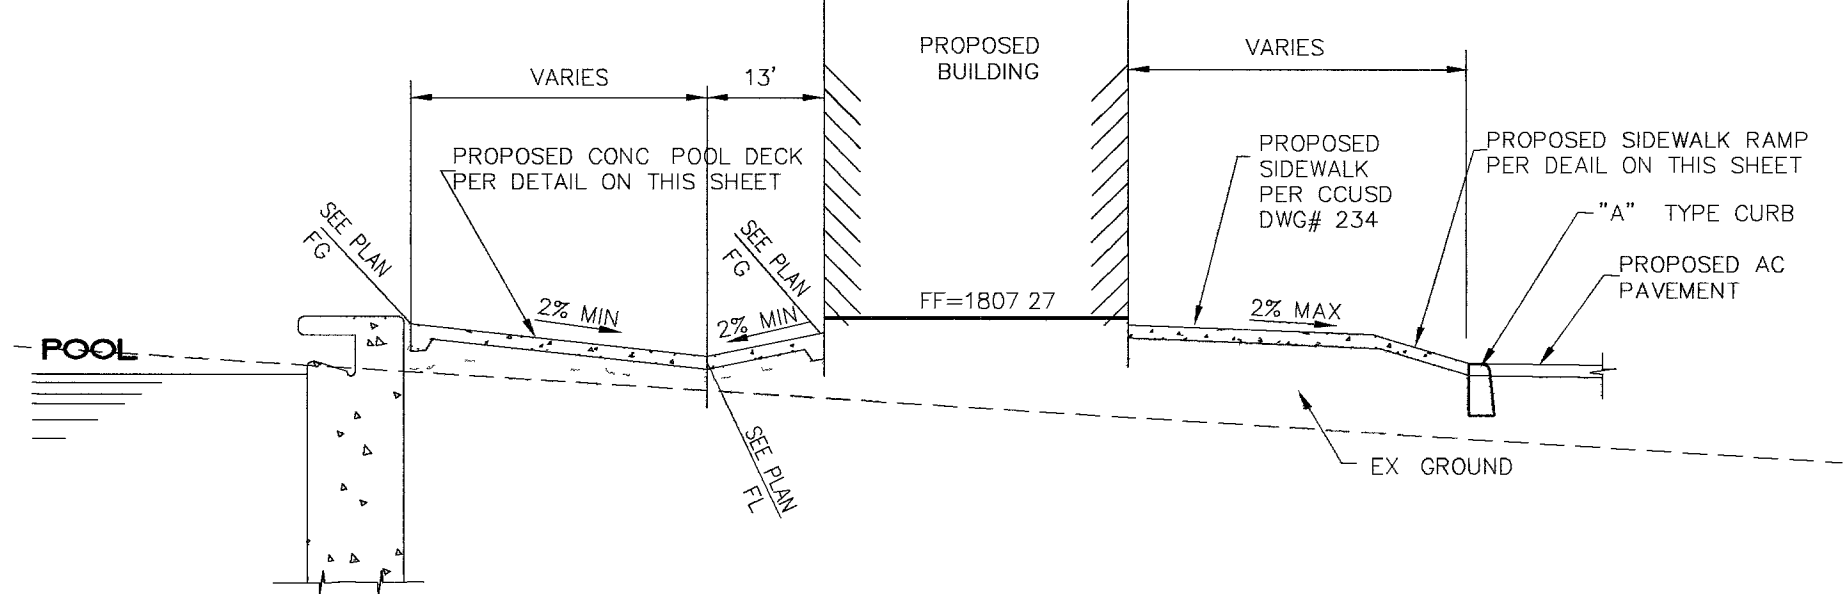


D SECTION D-D
NTS

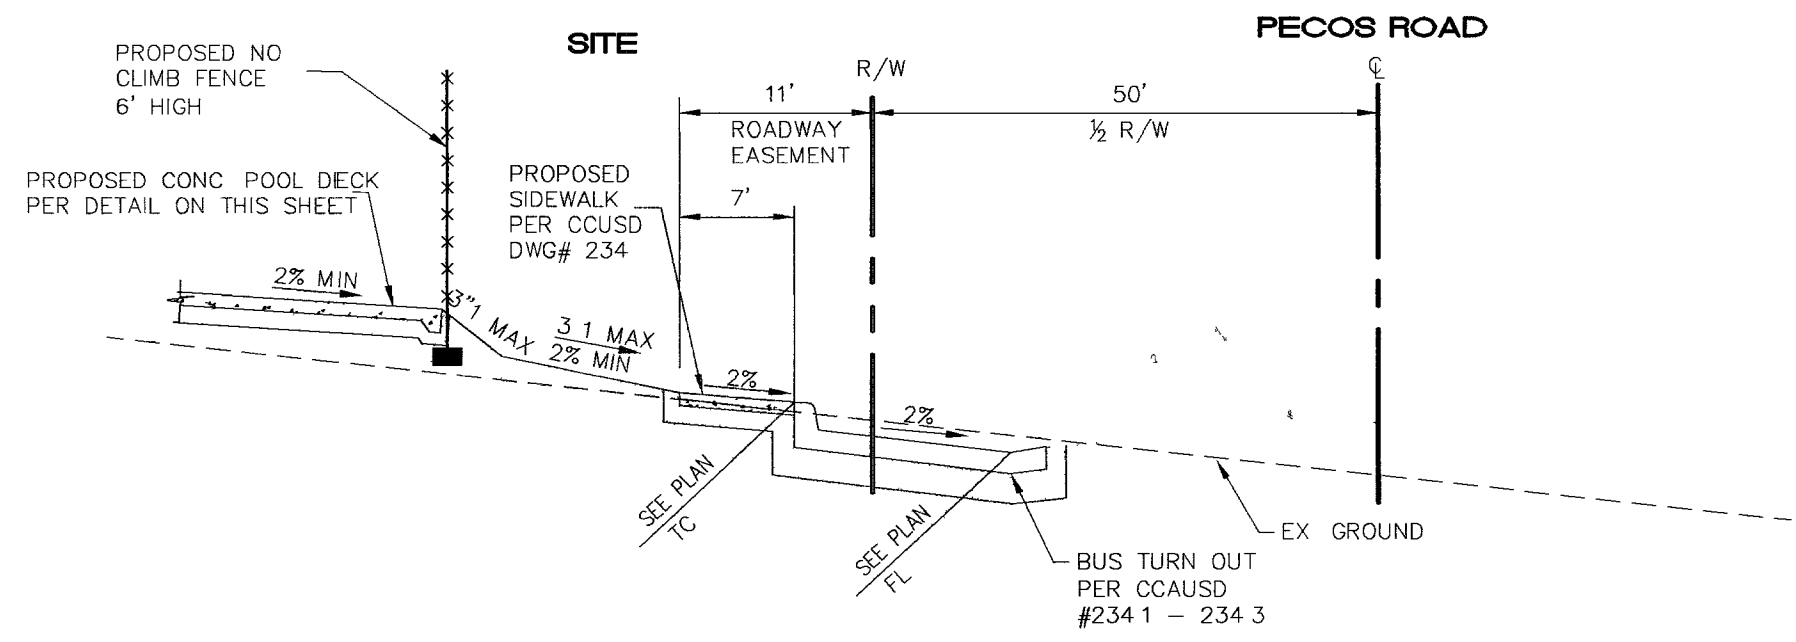


A SECTION A-A
NTS

A	B	
3"	6"	TRUCK
2"	6"	AUTO

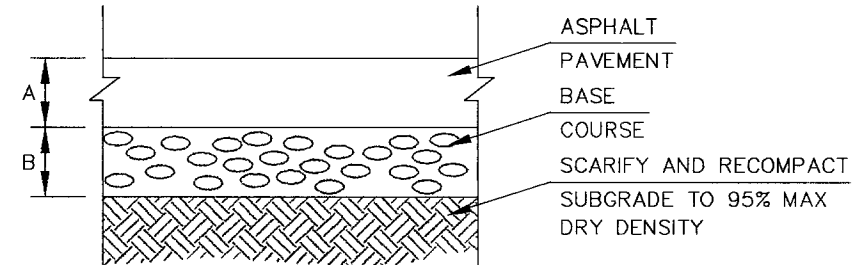


NOTE 1- REFERENCE GEOTECHNICAL REPORT AND ALL ADDENDA INCLUDED IN PROJECT DOCUMENTS FOR PAVEMENT CONSTRUCTION
2- CONSTRUCT ALL PARKING STALLS TO AUTO REQUIREMENTS
CONSTRUCT ALL OTHER AREAS INCLUDING DRIVE AISLES TO TRUCK REQUIREMENTS


AC PAVEMENT SECTION
NTS

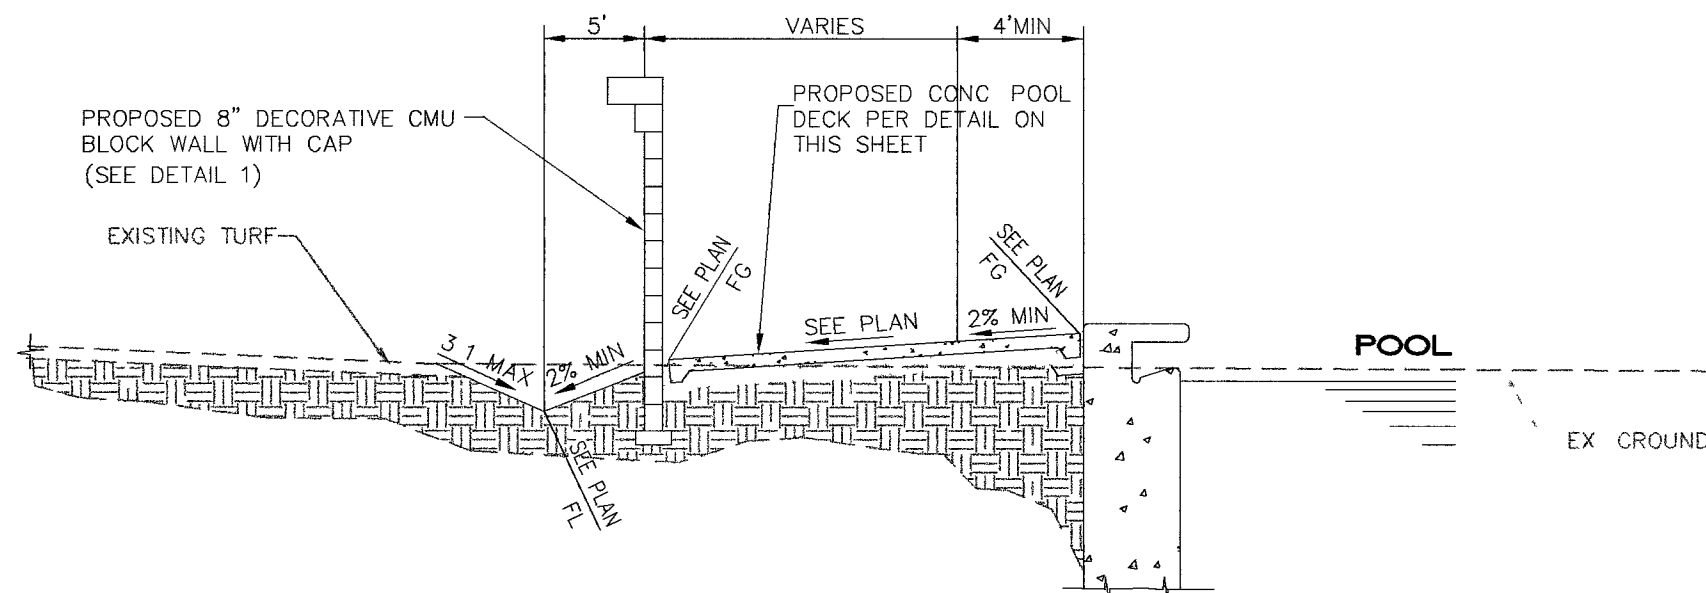

E SECTION E-E
NTS

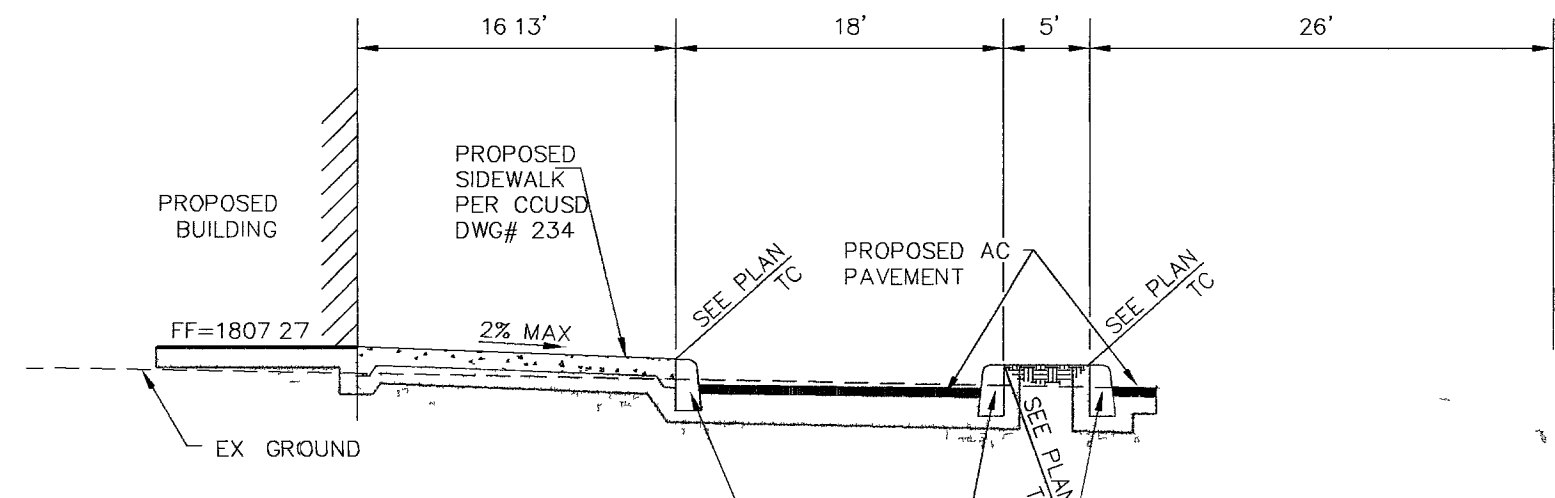


B SECTION B-B
NTS

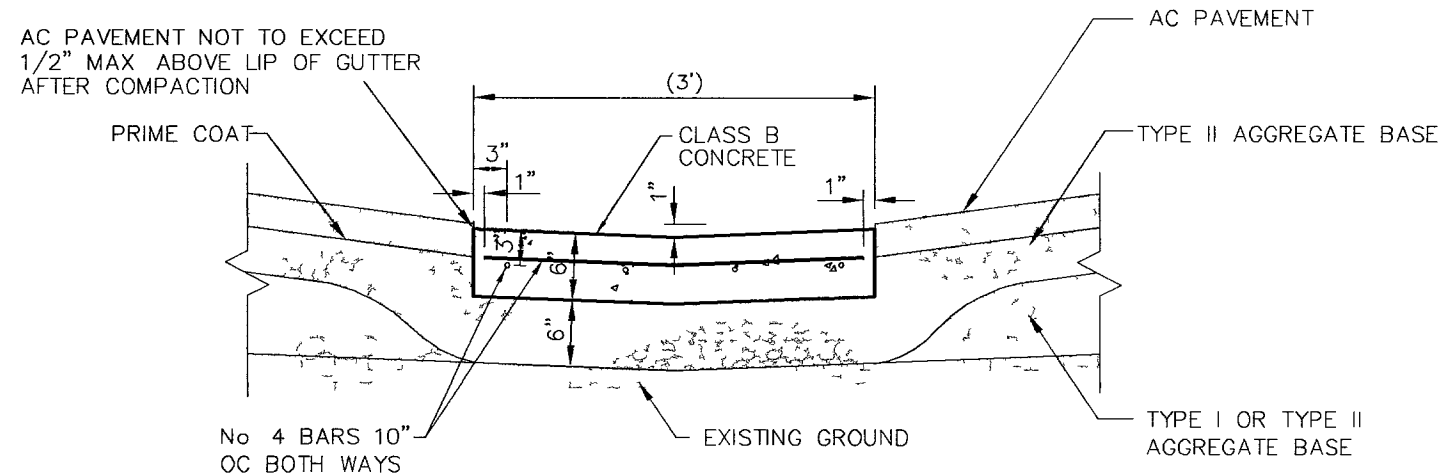


CONSTRUCT 1/2" EXPANSION JOINT AT ALL COLD JOINTS, INTERVALS NOT TO EXCEED 30' FOR DETAILS NOT SHOWN SEE CADD No. 234
REFER TO SOILS REPORT FOR THICKNESS OF AC STRUCTURAL SECTION

VALLEY GUTTER DETAIL
NTS

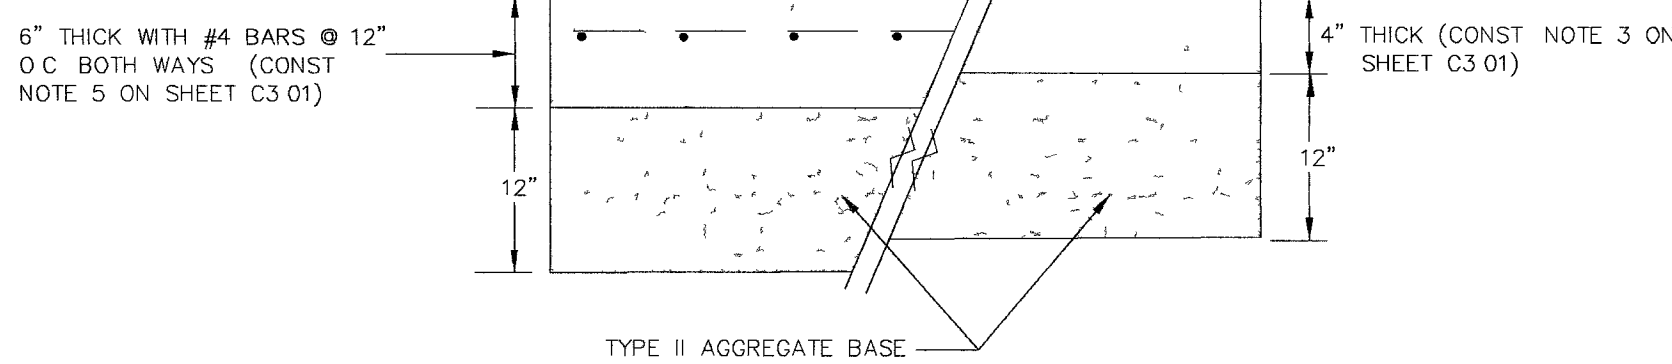

F SITE CONCRETE PAVEMENT SECTION
(SEE CONST. NOTE 5 ON SHEET C3 01)
NTS

NOTE
INSTALL EXPANSION JOINTS EVERY 30 FEET
CUT CONTROL JOINTS EVERY 5 FEET SQUARE
NOTE
ALL ADA ACCESSIBLE SIDEWALKS AND ROUTES WITHIN THE SITE DEVELOPMENT MUST BE CONSTRUCTED WITH LESS THAN 2.0% CROSS SLOPES

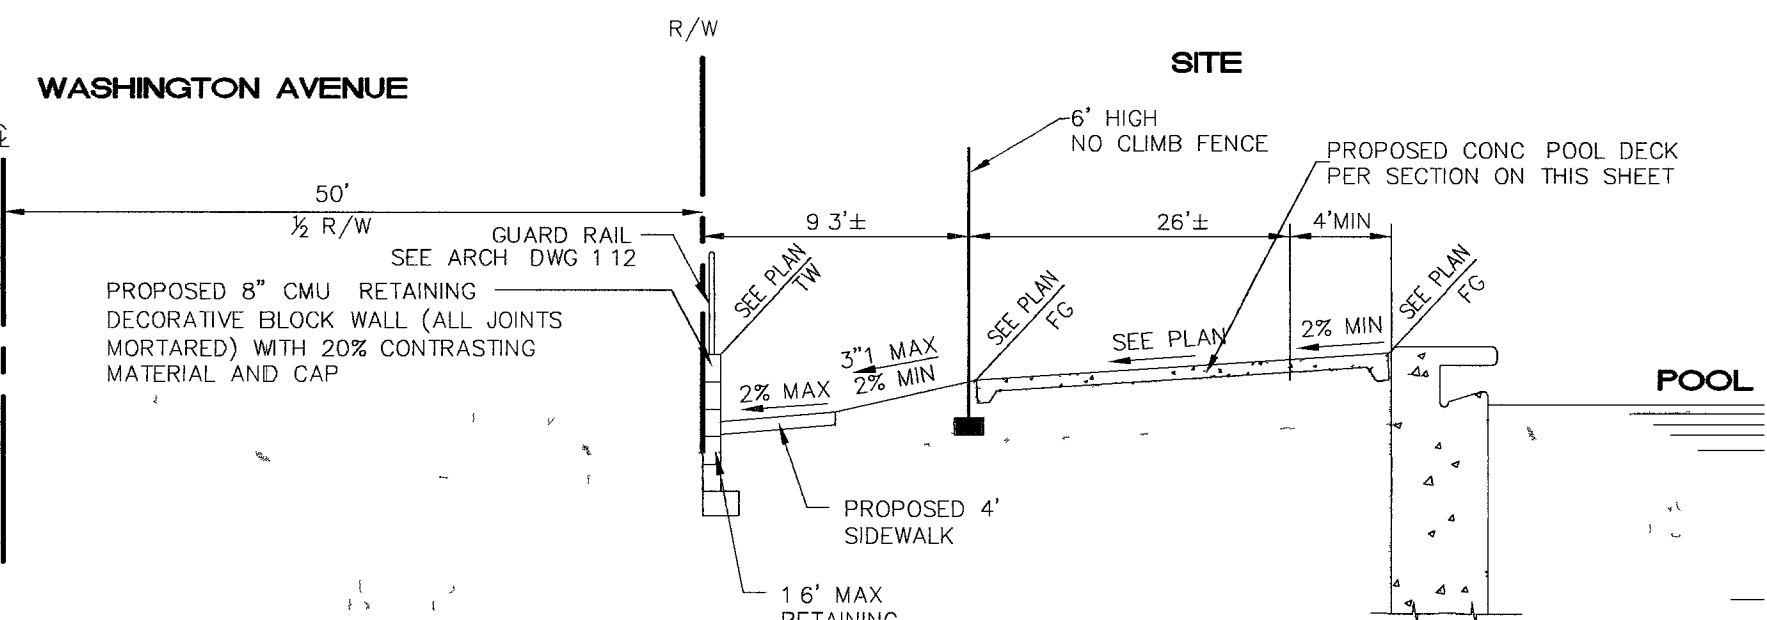

C SECTION C-C
NTS


RECORD DRAWING
These Record Drawings have been prepared based on information provided by others. The Engineer has not verified the accuracy of such information and shall not be responsible for any errors or omissions which may be incorporated herein as a result.

AVOID CUTTING UNDERGROUND UTILITY LINES IT'S COSTLY
Call before you Dig.
1-800-227-2600
UNDERGROUND SERVICE (USA)

AVOID HITTING OVERHEAD POWER LINES IT'S COSTLY
CALL BEFORE YOU CRANE
1-702-227-2929


AVOID HITTING UNDERGROUND UTILITY LINES IT'S COSTLY
Call before you UnderGround
1-702-455-7511
1-702-229-6611
CLARK COUNTY TRAFFIC OPERATIONS
FREIGHTWAY AND AIRPORT SYSTEMS OF TRANSPORTATION

OVEREXCAVATION NOTE(SEE SHEET C7.01):
ONSITE SOILS ARE NOT SUITABLE FOR SUPPORT OF FOUNDATIONS, SUPPORT OF THE SWIMMING POOL, FLOOR SLABS, POOL DECKS OR PAVING IN THEIR PRESENT STATE. THE NATURAL SOILS OCCURRING 3 FEET BELOW EXISTING GROUND SURFACE UNDER THE POOL DECK ONLY SHOULD BE OVEREXCAVATED, A GEOGRID (TENSAR BX 1100 OR EQUIVALENT) INSTALLED AT THE BOTTOM OF THE OVEREXCAVATED AREA, THEN 1" PROPERLY COMPACTED TYPE II OVER THE GEOGRID, AND THE REMAINDER REPLACED WITH PROPERLY PLACED AND COMPACTED TYPE II. THE OVEREXCAVATION SHOULD EXTEND 5 FEET BEYOND THE POOL DECK IN PLAN VIEW. ADDITIONAL OVEREXCAVATION AND TYPE II MATERIAL MAY BE REQUIRED TO IMPROVE THE STABILITY OF THE BOTTOM OF THE EXCAVATION. SPECIAL CONSIDERATIONS MAY BE REQUIRED DURING OVEREXCAVATION INCLUDING DEWATERING AND STABILIZING THE BOTTOM OF THE EXCAVATION.

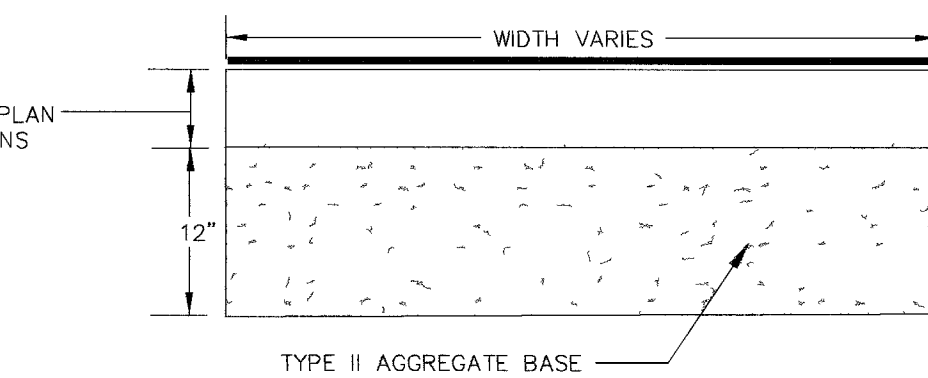

G CONCRETE POOL DECK SECTION
NTS

NOTE
INSTALL EXPANSION JOINTS EVERY 30 FEET
CUT CONTROL JOINTS EVERY 5 FEET SQUARE
NOTE
ALL ADA ACCESSIBLE SIDEWALKS AND ROUTES WITHIN THE SITE DEVELOPMENT MUST BE CONSTRUCTED WITH LESS THAN 2.0% CROSS SLOPES

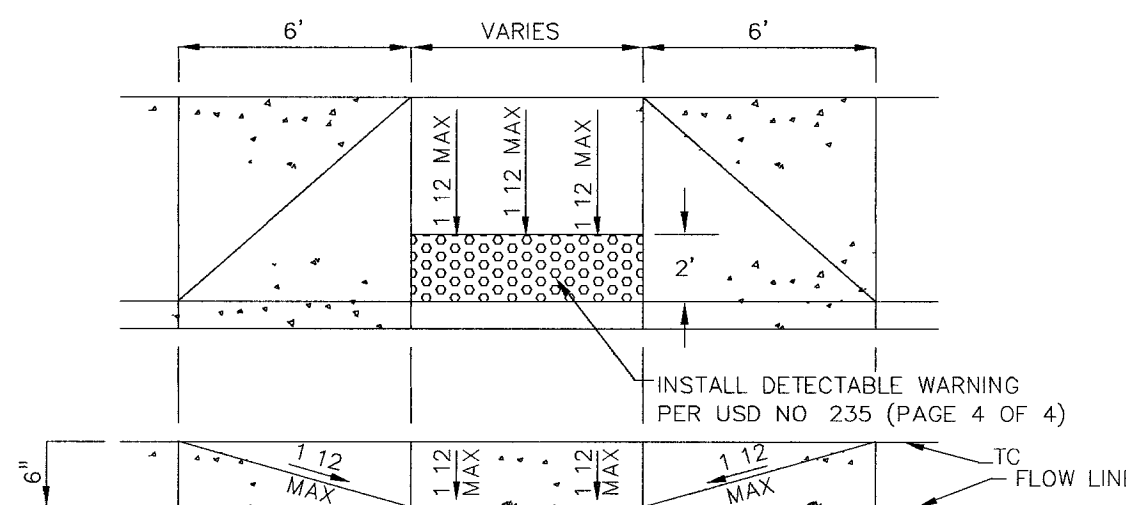

SIDEWALK RAMP
NTS

2480 E. Tompkins Ave.
Suite # 232
Las Vegas, NV 89121
phone: 702.456.4664
fax: 702.456.4919
INTEGRITY ENGINEERING

OWNER: CITY OF LAS VEGAS
DEPARTMENT OF PUBLIC WORKS
ARCHITECTURAL SERVICES

400 EAST STEWART AVENUE
LAS VEGAS, NEVADA 89101
PHONE: (702) 229-6535
FAX: (702) 382-3232
TDD: (702) 386-9108

DRAWN: IE
FILE:
DATE: 03-18-05
SCALE: NONE
SHEET NO: 04.15341.06
CLV DWG NO: 650.22-17
SHEET NO:

C6.01

FREEDOM PARK POOL AND BATHHOUSE
WASHINGTON AVE. & PECOS RD.
LAS VEGAS, NV

100% CONSTRUCTION DOCUMENTS
DETAIL SHEET

ESTAR ARCHITECTS
ARCHITECTURE • PLANNING • INTERIOR DESIGN
701 BRIDGER AVE., SUITE 400, LAS VEGAS, NEVADA 89101
TELEPHONE: (702) 878-0000 FAX: (702) 878-8430
www.wagnarchitects.com

REVISIONS

CONSULTANT

STAMP

ALL RIGHTS AS INSTRUMENTS OF SERVICE ARE RESERVED. NO PART OF THIS DRAWING OR SPECIFICATION MAY BE REPRODUCED OR TRANSMITTED IN ANY FORM OR BY ANY MEANS, ELECTRONIC OR MECHANICAL, WITHOUT PERMISSION IN WRITING FROM THE ENGINEER. THE ENGINEER'S RESPONSIBILITY IS LIMITED TO THE DESIGN AND CONSTRUCTION OF THE PROJECT. THE ENGINEER DOES NOT GUARANTEE THE ACCURACY OF THE INFORMATION PROVIDED BY OTHERS. THE ENGINEER'S LIABILITY IS LIMITED TO THE DESIGN AND CONSTRUCTION OF THE PROJECT. THE ENGINEER DOES NOT GUARANTEE THE ACCURACY OF THE INFORMATION PROVIDED BY OTHERS.