


MATCHLINE -- REFER TO SHEET LP-1c

MATCHLINE -- REFER TO SHEET LP-1b

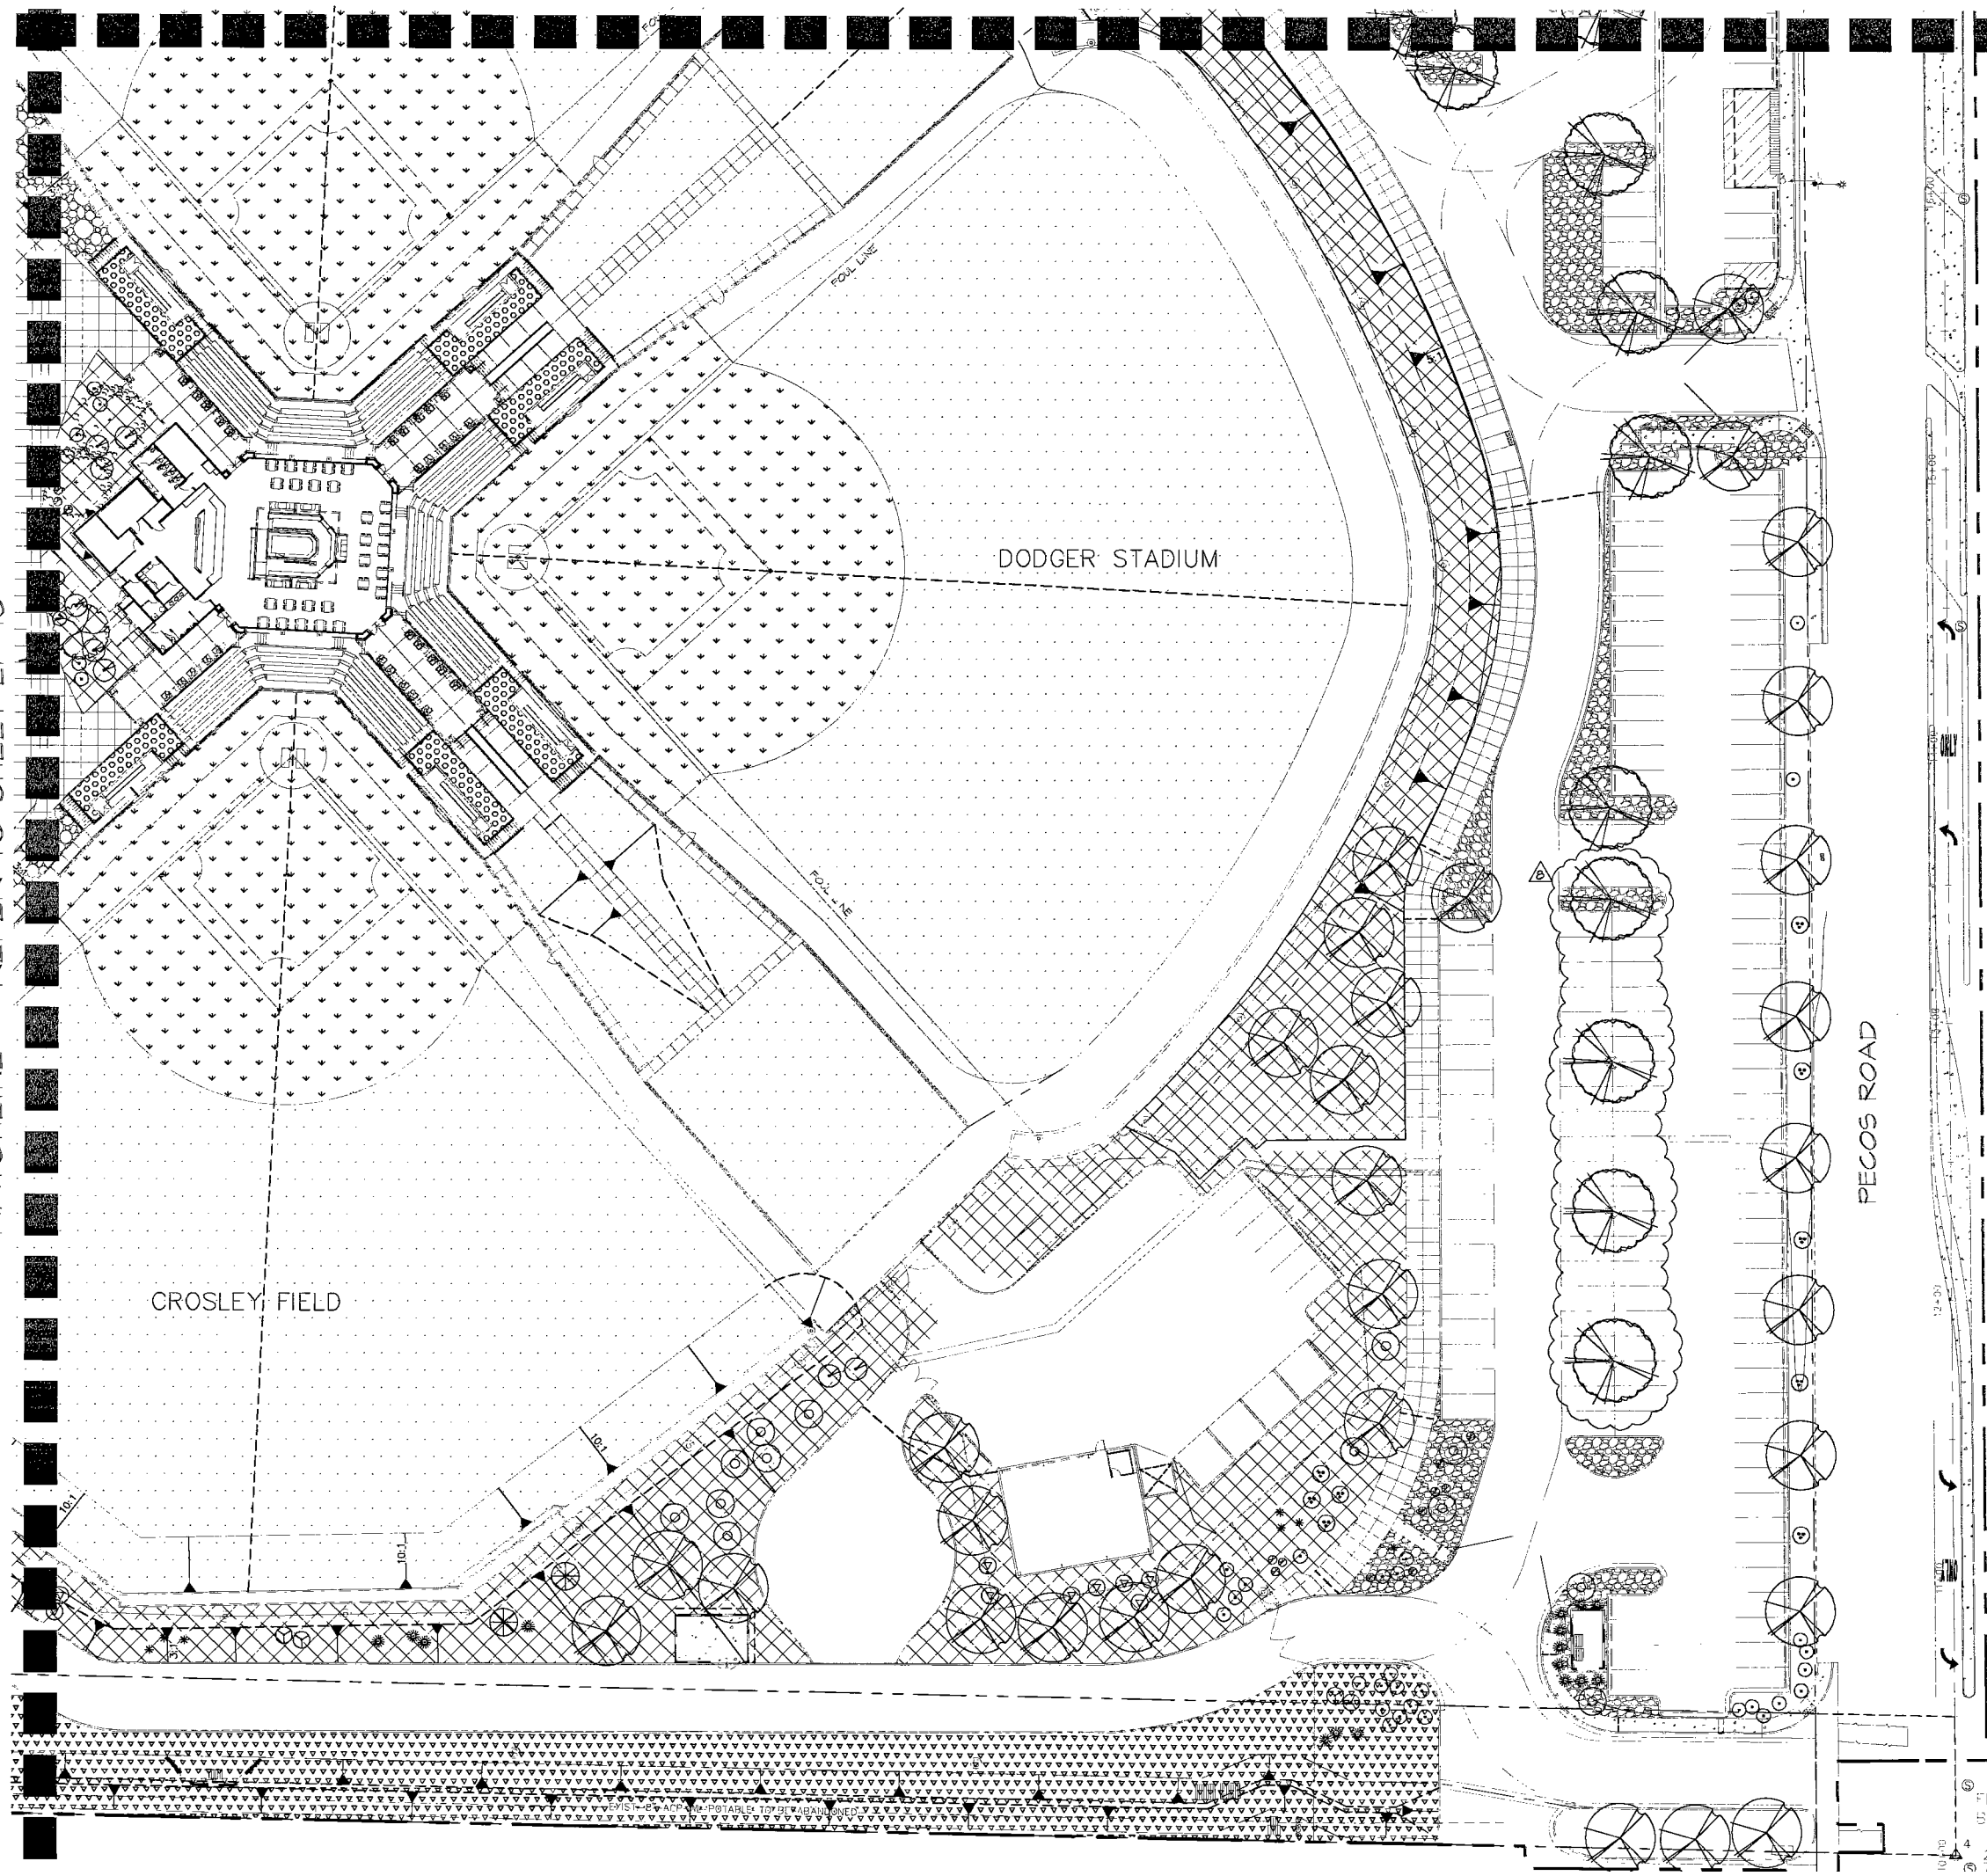

123085

PLANT SCHEDULE

SYMBOL	BOTANICAL NAME
(A)	ACACIA STENOPHYLLA
(B)	CHILOPSIS LINEARIS
(C)	CHITALPA TASHKENTENSIS
(D)	FRAXINUS VELUTINA 'RIO GRANDE'
(E)	PARKINSONIA 'DESERT MUSEUM'
(F)	PISTACIA X 'RED PUSH'

PLANT SCHEDULE

SYMBOL	BOTANICAL NAME
(A)	EXISTING TREES
(B)	ASH SPECIES
(C)	COTTONWOOD SPECIES
(D)	ELM SPECIES
(E)	MESQUITE SPECIES
(F)	MULBERRY SPECIES
(G)	OAK SPECIES
(H)	OLIVE SPECIES
(I)	PALM SPECIES
(J)	PINE SPECIES
(K)	PISTACHE SPECIES



PLANT SCHEDULE

SYMBOL	BOTANICAL NAME
(A)	PALM TREES
(B)	WASHINGTONIA ROBUSTA
(C)	SHRUBS
(D)	CAESALPINIA PULCHERRIMA
(E)	DASYLIRON WHEELERI
(F)	EREMOPHILA X 'SUMMERTIME BLUE'
(G)	HEPERALOE PARVIFLORA
(H)	LEUCOPHYLLUM FRUTESCENS 'GREEN CLOUD'
(I)	MULHENBERGIA RIGENS
(J)	RHUS OVATA
(K)	SALVIA GREGGII 'SIERRA LINDA'
(L)	SENNA ARTEMISIODIENSIS
(M)	TECOMA X 'SUNRISE'

PLANT SCHEDULE

SYMBOL	BOTANICAL NAME
(A)	GROUNDCOVERS
(B)	AGADA REDDING'S DESERT CARPET
(C)	DALEA GREGGII
(D)	MYOPORUM PARVIFOLIUM
(E)	VINES
(F)	MACFADYENA UNGUIS-CATI

- NOTES:
- REFER TO SHEET LP-1c FOR PLANTING NOTES.
 - REFER TO SHEET LP-1c FOR DETAILED PLANT SCHEDULE.
 - REFER TO SHEET LP-2a FOR PLANTING DETAILS.
 - REFER TO SPECIFICATIONS PROVIDED UNDER SEPARATE CO FOR LANDSCAPE AND IRRIGATION SPECIFICATIONS.

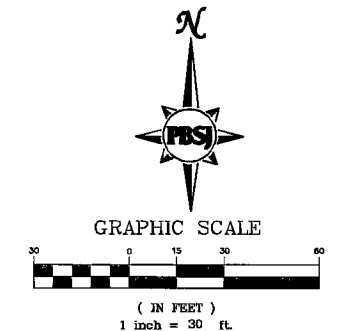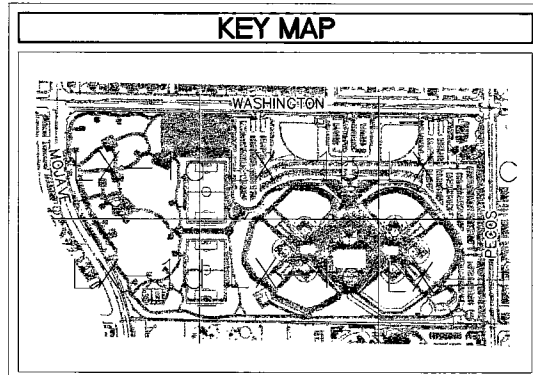

Call before you Underground
Call before you Overhead

REVISIONS

10.20.2008	BLDG. DEPT. REVIEW #1
11.07.2008	OWNER CHANGES
11.07.2008	BLDG. DEPT. REVIEW #2
12.15.2008	BLDG. DEPT. REVIEW #3
01.24.2009	BLDG. DEPT. REVIEW #4
03.13.2009	OWNER CHANGES
03.20.2009	CMA WALL CHANGES
05.08.2009	CONTRACTOR CHANGES
06.29.2009	CONTRACTOR CHANGES
12.15.2009	CONTRACTOR CHANGES
01.31.2010	RECORD DRAWINGS

architecture
interiors
planning
engineering

Dekker Perich Sabatini

6860 Bermuda Road, Ste. 100
Las Vegas, Nevada 89119
702.436.1006
fax 436.1050
info@dpsdesign.org

PBSJ

ENGINEERING PLANNING SURVEYING
CONSTRUCTION SERVICES

2270 Corporate Circle
Suite 100
Henderson, Nevada 89074
Telephone: 702/263-7272
Fax: 702/263-7200

CITY OF LAS VEGAS
FREEDOM PARK RENOVATION
850 NORTH MOJAVE, LAS VEGAS, NEVADA 89101
PLANTING PLAN

Russ Mauger
Russ Mauger
Roche Constructors, Inc.

RECORD
DRAWINGS
01-31-2010

OWNER: CITY OF LAS VEGAS
DEPARTMENT OF PUBLIC WORKS
ARCHITECTURAL SERVICES

4400 EAST STEWART AVENUE
LAS VEGAS, NEVADA 89113
PHONE: (702) 228-6236
FAX: (702) 228-4848
TDD: (702) 228-9838

FILE: 3006-LP-1f
DATE: FEBRUARY 13, 2009
ROLE: AS NOTED
JOB NO: 070354
DRAWING NO: 650.22-18

SHEET NO:
LP-1f

RECORD DRAWING

FOR THE PURPOSES OF RECORD DRAWINGS, THE CITY OF LAS VEGAS, NEVADA, DEPARTMENT OF PUBLIC WORKS, ARCHITECTURAL SERVICES, HAS REVIEWED AND APPROVED THE INFORMATION CONTAINED HEREIN FOR THE CITY OF LAS VEGAS, NEVADA, DEPARTMENT OF PUBLIC WORKS, ARCHITECTURAL SERVICES. THE CITY OF LAS VEGAS, NEVADA, DEPARTMENT OF PUBLIC WORKS, ARCHITECTURAL SERVICES, DOES NOT WARRANT THE ACCURACY OR COMPLETENESS OF THE INFORMATION CONTAINED HEREIN, NOR DOES IT WARRANT THE ACCURACY OR COMPLETENESS OF THE INFORMATION CONTAINED HEREIN FOR ANY PURPOSES OTHER THAN THE USE OF RECORD DRAWINGS. THE CITY OF LAS VEGAS, NEVADA, DEPARTMENT OF PUBLIC WORKS, ARCHITECTURAL SERVICES, SHALL NOT BE RESPONSIBLE FOR ANY PROBLEMS OR RELATED COSTS THAT MAY ARISE OUT OF THE USE OF RECORD DRAWINGS.