

MATCHLINE -- REFER TO SHEET LI-1b



MATCHLINE -- REFER TO SHEET LI-1f

IRRIGATION LAYOUT IS SCHEMATIC GRAPHIC SHOWN FOR CLARITY
 KEEP MAINLINE MINIMUM 3' FROM EDGE OF CONCRETE & WALK EXCEPT WHERE SLEEVES ARE REQUIRED

IRRIGATION SCHEDULE	
SYMBOL	DESCRIPTION
	POINT OF CONNECTION
	CONTROLLER
	CLUSTER CONTROL UNIT
	GATE VALVE
	BALL VALVE
	FLOW SENSOR
	IRRIGATION PUMP
	IRRIGATION PUMP
	CHANGES REQUESTED BY CONTRACTOR

IRRIGATION SCHEDULE	
SYMBOL	DESCRIPTION
	REMOTE CONTROL VALVE (DRIP VALVE)
	W/VALVE FILTER & PRESSURE REGULATOR
	REMOTE CONTROL VALVE
	QUICK COUPLER
	IRRIGATION MAINLINE
	PVC LATERAL LINE (XTG TREES)
	PVC LATERAL LINE (TURF)
	PVC LATERAL LINE (TREES)
	PVC LATERAL LINE (GRUBS)
	PVC FLEXIBLE TUBING
	NOT SHOWN DRIP EMITTER
	NOT SHOWN INLINE TUBING (EXISTING TREES)
	NOT SHOWN IRRIGATION SLEEVE

- NOTES:**
- REFER TO SHEET LI-0 FOR FULL IRRIGATION EQUIPMENT SCHEDULE.
 - REFER TO SHEET LI-0 FOR IRRIGATION NOTES.
 - REFER TO SHEETS LC-2b, LC-2c, LC-2d, and LC-2e FOR IRRIGATION DETAILS.
 - REFER TO SPECIFICATIONS PROVIDED UNDER SEPARATE COVER, WHICH ARE PART OF THESE CONSTRUCTION DOCUMENTS.

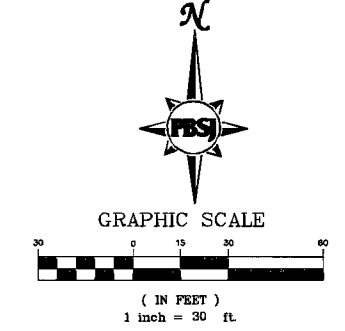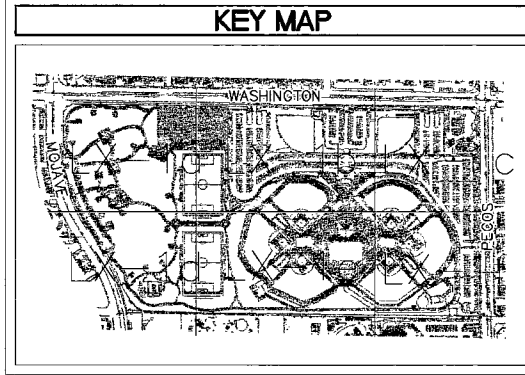

Call before you Undergrad
 1-702-227-2529
 1-702-227-2529

Call before you Overhead
 1-800-227-2600
 1-702-659-7544

DATE	DESCRIPTION
10.20.2009	BLDG. DEPT. REVIEW #1
10.20.2009	OWNER CHANGES
11.07.2009	BLDG. DEPT. REVIEW #2
12.15.2009	BLDG. DEPT. REVIEW #3
01.24.2010	BLDG. DEPT. REVIEW #4
03.12.2009	OWNER CHANGES
03.20.2009	CMU WALL CHANGES
05.08.2009	CONTRACTOR CHANGES
06.29.2009	CONTRACTOR CHANGES
12.15.2009	CONTRACTOR CHANGES
01.31.2010	RECORD DRAWINGS

Dekker Perich Sabatini
 architects
 interiors
 planning
 engineering

6860 Bermuda Road, Ste. 100
 Las Vegas, Nevada 89119
 702.438.1008
 fax 438.1050
 info@pdsdesign.org

PBSJ
 ENGINEERING PLANNING SURVEYING
 CONSTRUCTION SERVICES

2270 Corporate Circle
 Suite 100
 Henderson, Nevada 89074
 Telephone 702.263.7275
 Fax: 702.263.7200

CITY OF LAS VEGAS
 FREEDOM PARK RENOVATION
 850 NORTH MOJAVE, LAS VEGAS, NEVADA 89101
 IRRIGATION PLAN

Russ Mauger
 Russ Mauger
 Design Architect

RECORD DRAWINGS
 01-31-2010

OWNER: CITY OF LAS VEGAS
 DEPARTMENT OF PUBLIC WORKS
 ARCHITECTURAL SERVICES

DATE	3006-LI-1c
DATE	FEBRUARY 13, 2009
SCALE	AS NOTED
EDWG NO	070354
CU DWG NO	650.22-18

LI-1c

FOR THE PURPOSE OF ARCHITECTURE, ENGINEERING, PLANNING AND SURVEYING, THE INFORMATION CONTAINED HEREIN IS THE PROPERTY OF DEKKER PERICH SABATINI, LTD. AND IS NOT TO BE REPRODUCED OR TRANSMITTED IN ANY FORM OR BY ANY MEANS, ELECTRONIC OR MECHANICAL, INCLUDING PHOTOCOPYING, RECORDING, OR BY ANY INFORMATION STORAGE AND RETRIEVAL SYSTEM, WITHOUT THE WRITTEN PERMISSION OF DEKKER PERICH SABATINI, LTD. THE INFORMATION CONTAINED HEREIN IS THE PROPERTY OF DEKKER PERICH SABATINI, LTD. AND IS NOT TO BE REPRODUCED OR TRANSMITTED IN ANY FORM OR BY ANY MEANS, ELECTRONIC OR MECHANICAL, INCLUDING PHOTOCOPYING, RECORDING, OR BY ANY INFORMATION STORAGE AND RETRIEVAL SYSTEM, WITHOUT THE WRITTEN PERMISSION OF DEKKER PERICH SABATINI, LTD.