


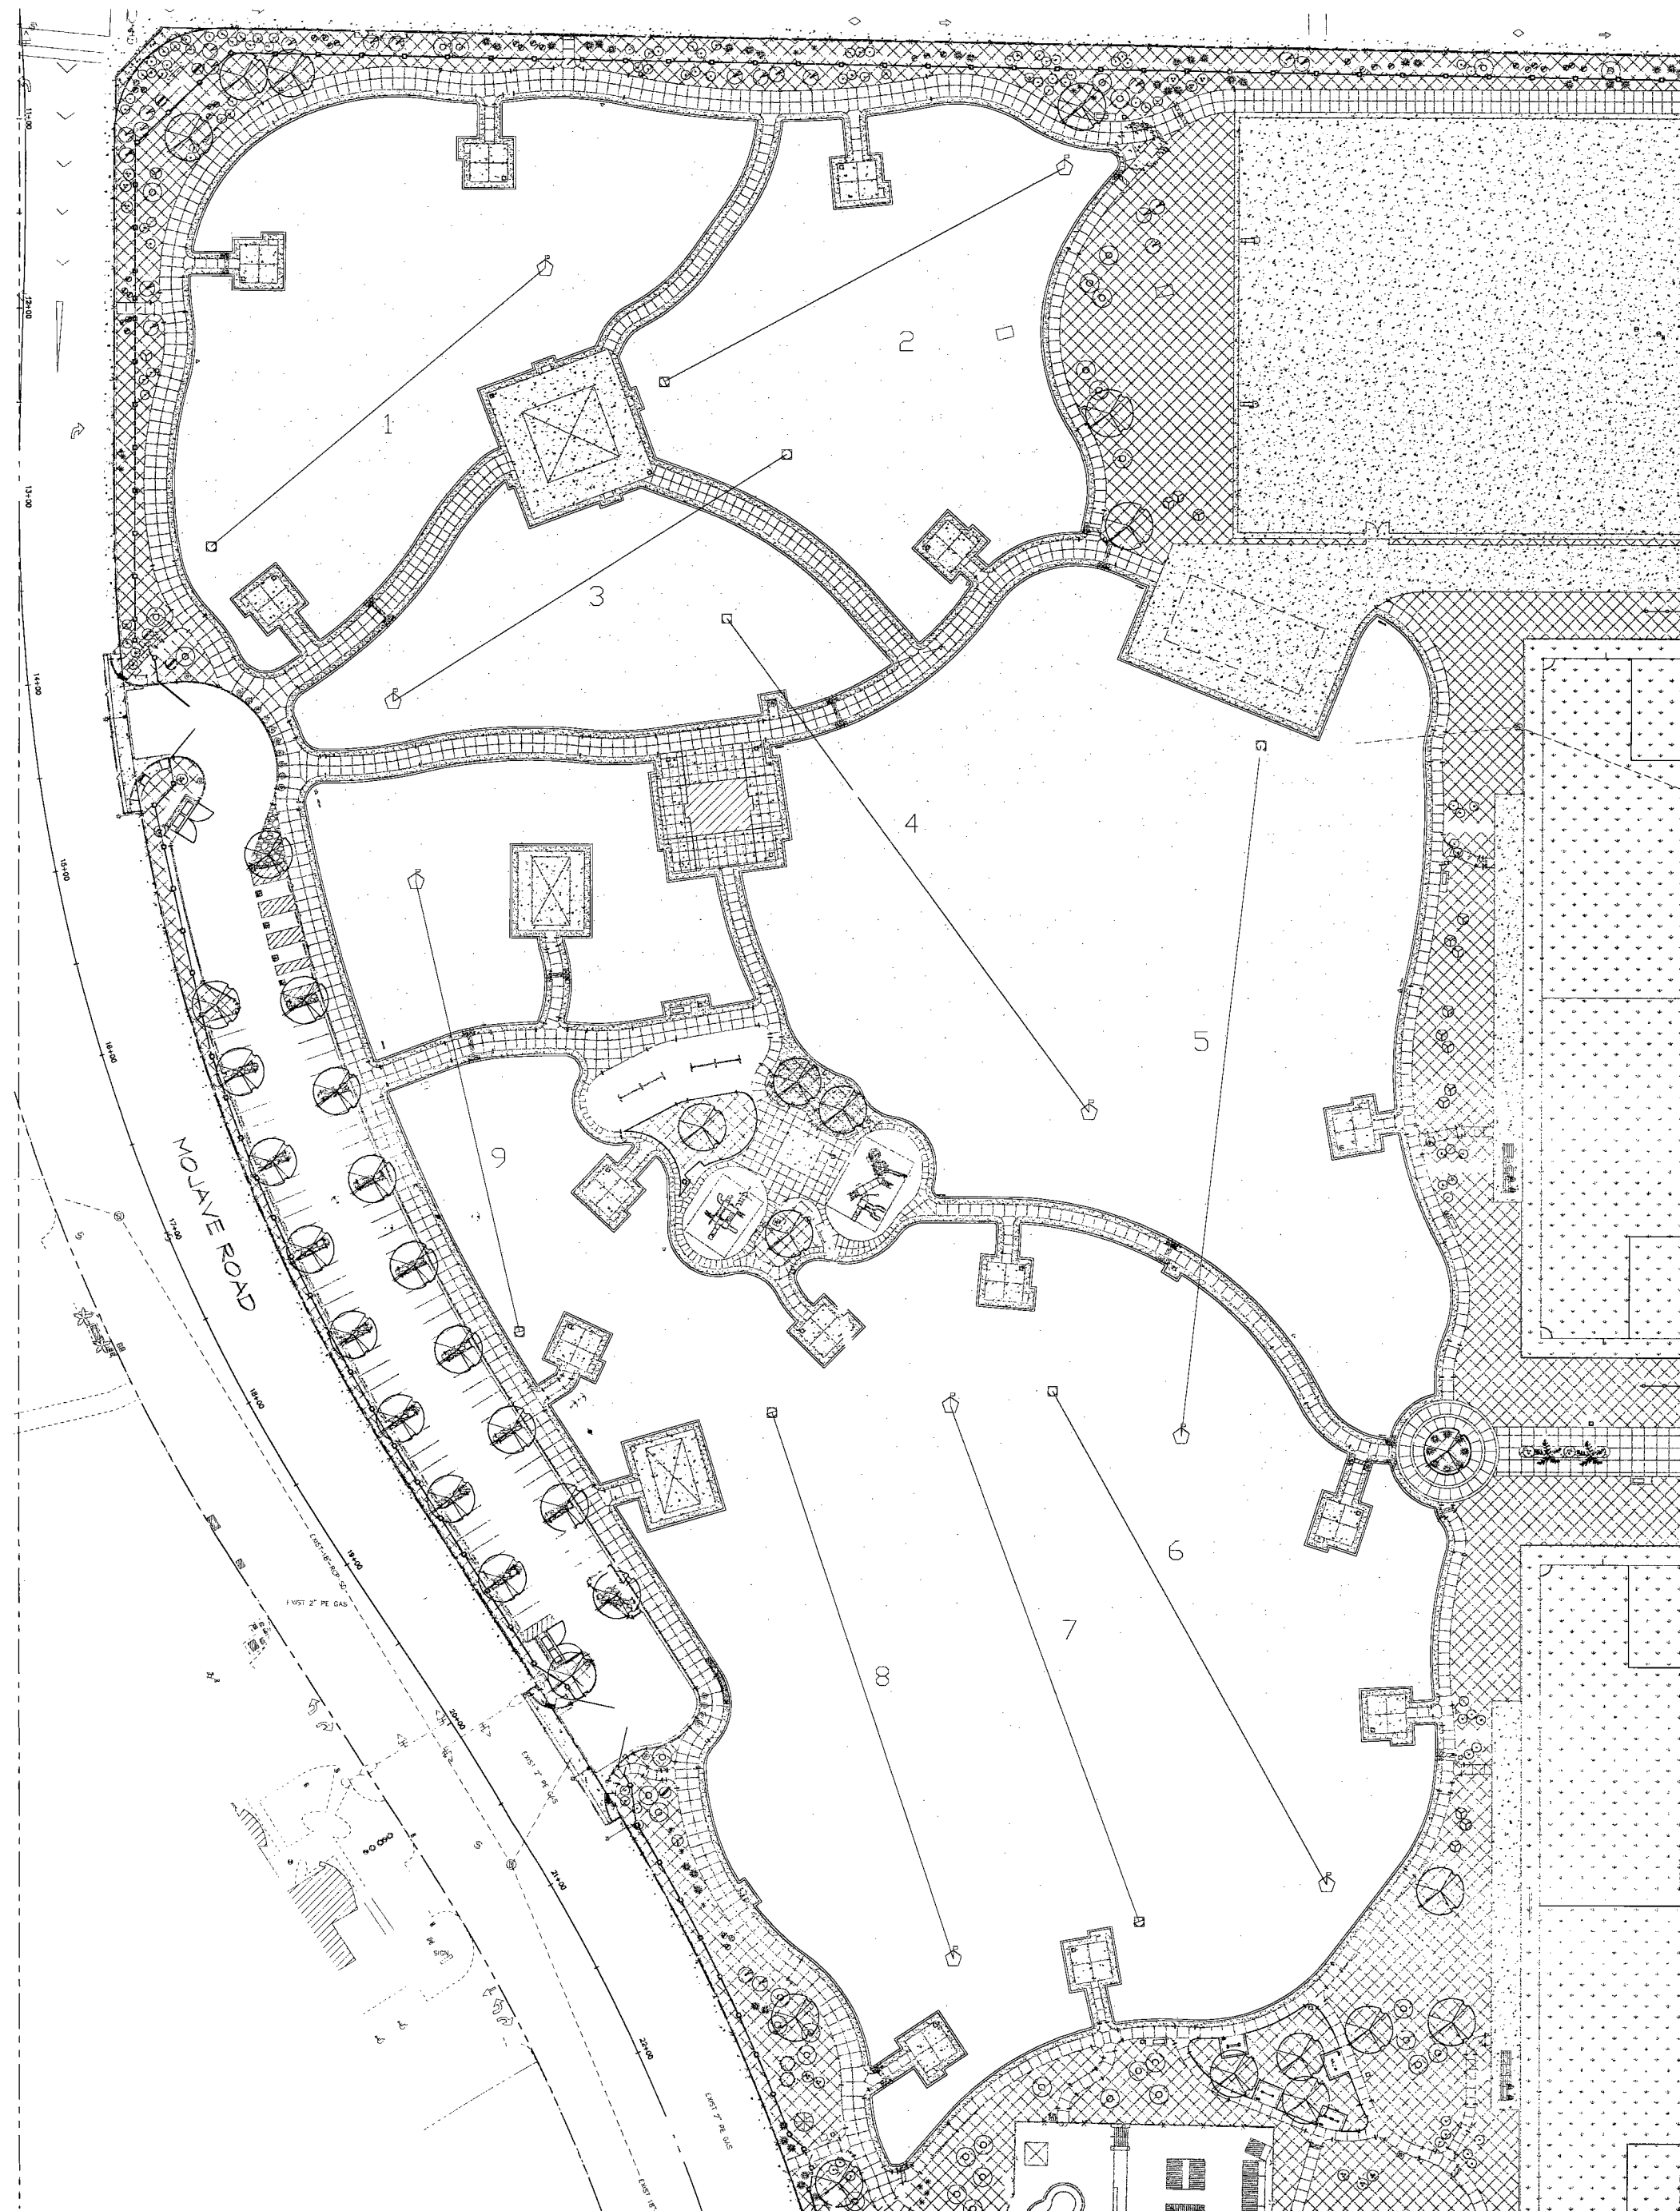


DISC GOLF SCHEDULE		
HOLE	DISTANCE	PAR
1	460'	4
2	210'	3
3	385'	3
4	405'	4
5	590'	4
6	360'	3
7	565'	4
8	450'	4
9	535'	4
TOTAL	3,960'	33

- NOTES:
1. COURSE LAYOUT IS CONCEPTUAL ONLY. VERIFY ROUTING WITH CITY.
 2. PAR5 HAVE BEEN SET BASED ON WHITE TEE RATING WITH LIGHT FOLIAGE DENSITY. THIS INFORMATION IS BASED FROM PDGA REGULATIONS.
 3. CONTRACTOR TO SALVAGE ALL DISC GOLF BASKETS AND CITY REPRESENTATIVE SHALL APPROVE WHICH (9) NINE BASKETS WILL BE RE-USED FOR THE COURSE.
 4. BASKETS SHALL BE INSTALLED PER MANUFACTURER'S SPECIFICATIONS AND/OR ACCORDING TO CITY OF LAS VEGAS STANDARDS IF APPLICABLE.
 5. TEES WILL BE NATURAL TURF WITH CITY SUPPLIED SIGNS WITH THE HOLE IDENTIFICATION, DISTANCE AND PAR.

SYMBOL LEGEND

-  TEE
 BASKET
 HOLE IDENTIFICATION

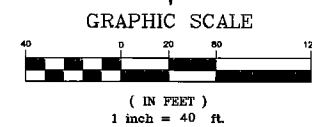

REVISIONS		
1	10.20.2008	BLDG. DEPT. REVIEW #1
2	10.20.2008	OWNER CHANGES
3	11.07.2008	BLDG. DEPT. REVIEW #2
4	12.15.2008	BLDG. DEPT. REVIEW #3
5	01.24.2009	BLDG. DEPT. REVIEW #4
6	03.13.2009	OWNER CHANGES
7	03.20.2009	CMJ WALL CHANGES
8	05.08.2009	CONTRACTOR CHANGES
9	06.22.2009	CONTRACTOR CHANGES
10	12.15.2009	CONTRACTOR CHANGES
11	01.31.2010	RECORD DRAWINGS



**Dekker
Perich
Sabatini**
6860 Bermuda Road, Ste. 100
Las Vegas, Nevada 89119
702.436.1006
fax 436.1050
Info@dpsdesign.org



2270 Corporate Circle
Suite 100
Henderson, Nevada 89072
Telephone: 702/263-7275
Fax: 702/263-7200

CITY OF LAS VEGAS
FREEDOM PARK RENOVATION
850 NORTH MOJAVE, LAS VEGAS, NEVADA 89101
DISC GOLF CONCEPT

Russ Mauger
Russ Mauger
Roche Constructors, Inc.

RECORD
DRAWINGS
01-31-2010

OWNER: CITY OF LAS VEGAS
DEPARTMENT OF PUBLIC WORKS
ARCHITECTURAL SERVICES

400 EAST STEWART AVENUE
LAS VEGAS, NEVADA 89101
PHONE: (702) 229-6535
FAX: (702) 384-4846
TDD: (702) 386-9108

DRAWN	
FILE	3006-LC-8a
DATE	FEBRUARY 13, 2009
SCALE	AS NOTED
SHP NO	070354
CLY DWG NO	650.22-18

SHEET NO

LC-8a

RECORD DRAWING