



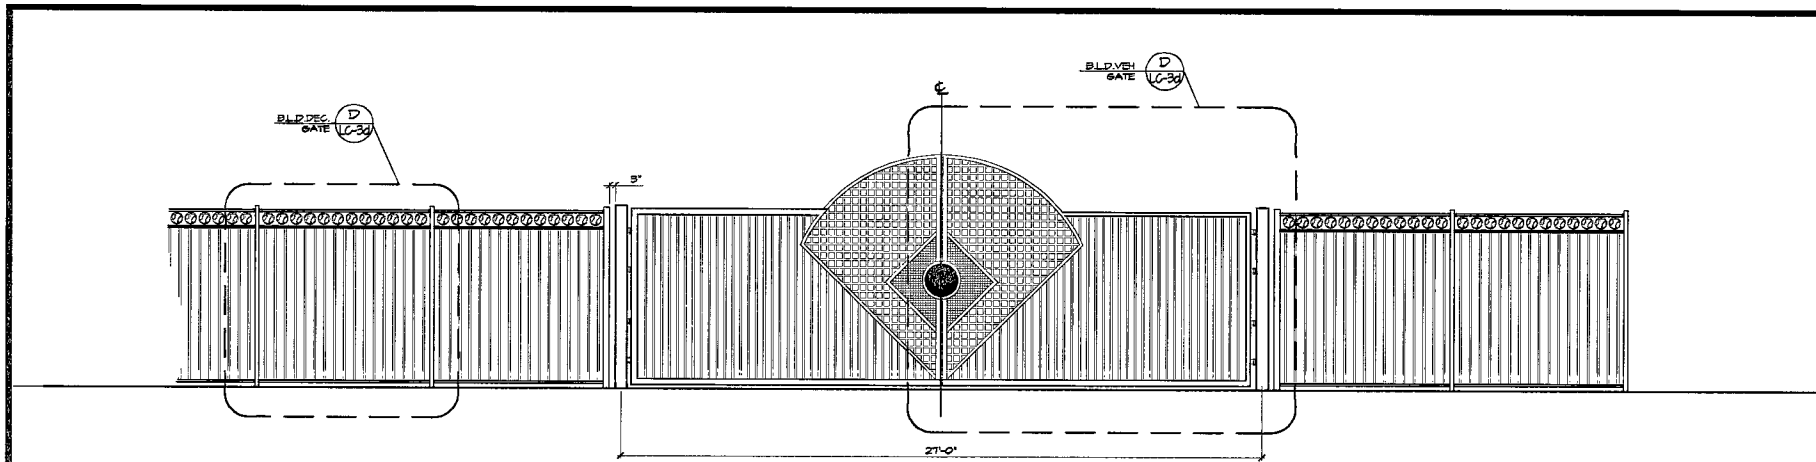


A B.L.D. VEHICULAR GATE

SCALE:
1/4" = 1'-0"

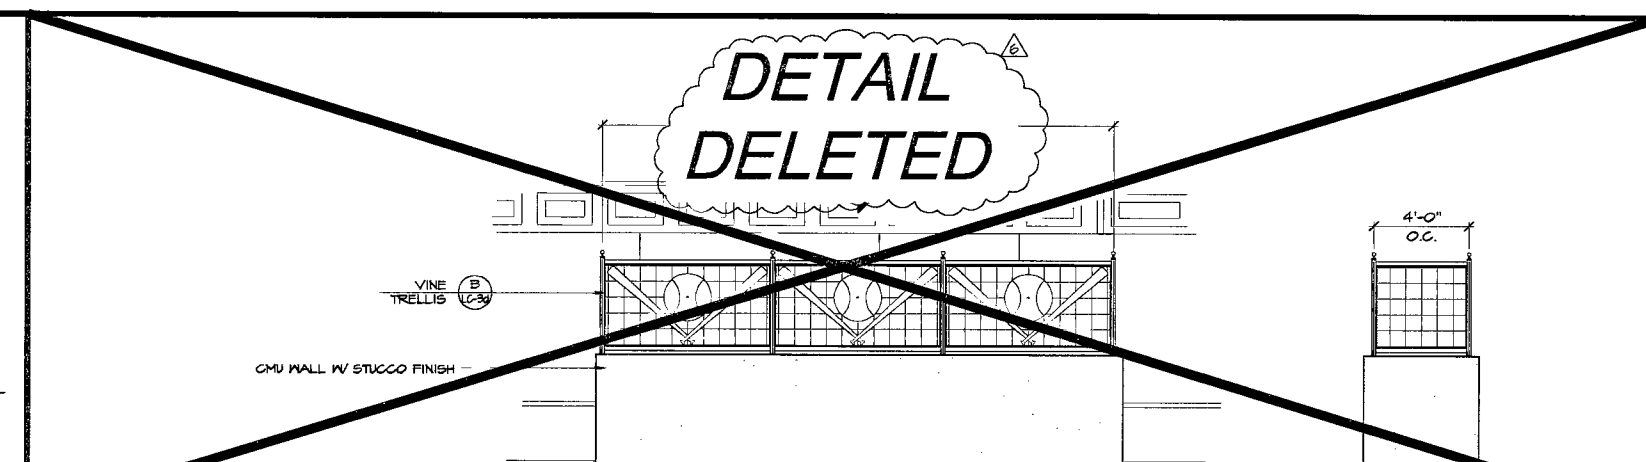


B SCREEN WALL

SCALE:
1/4" = 1'-0"

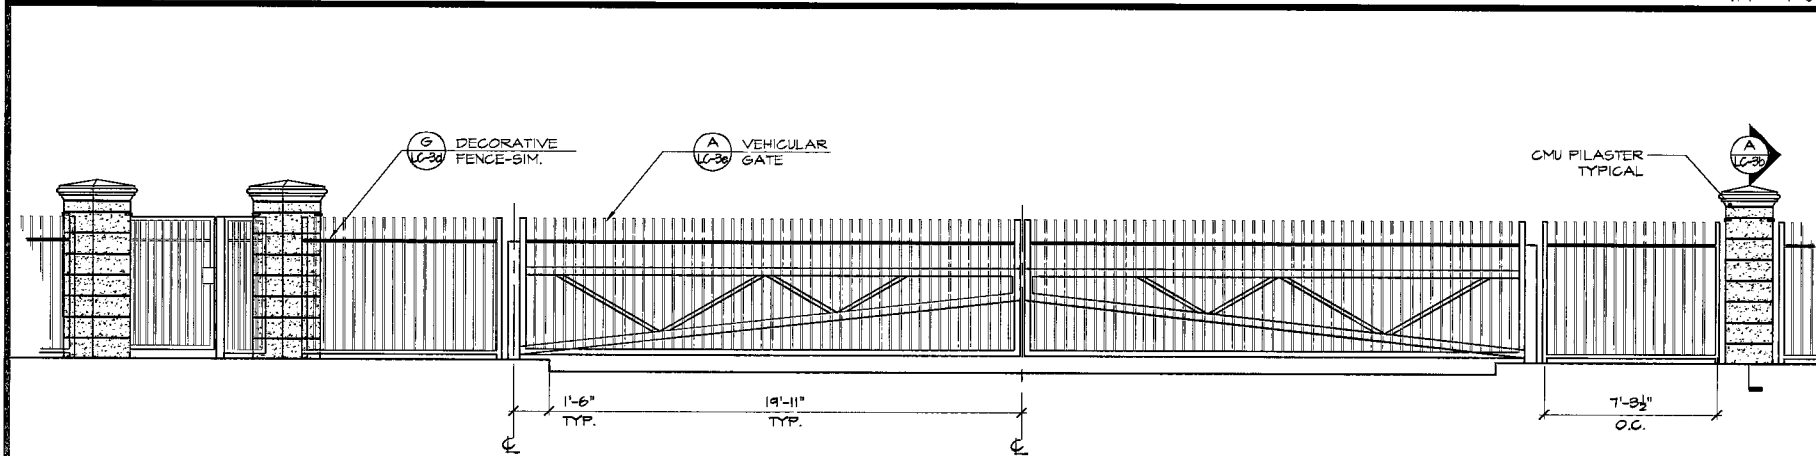


C VEHICULAR GATE 'A'

SCALE:
1/4" = 1'-0"

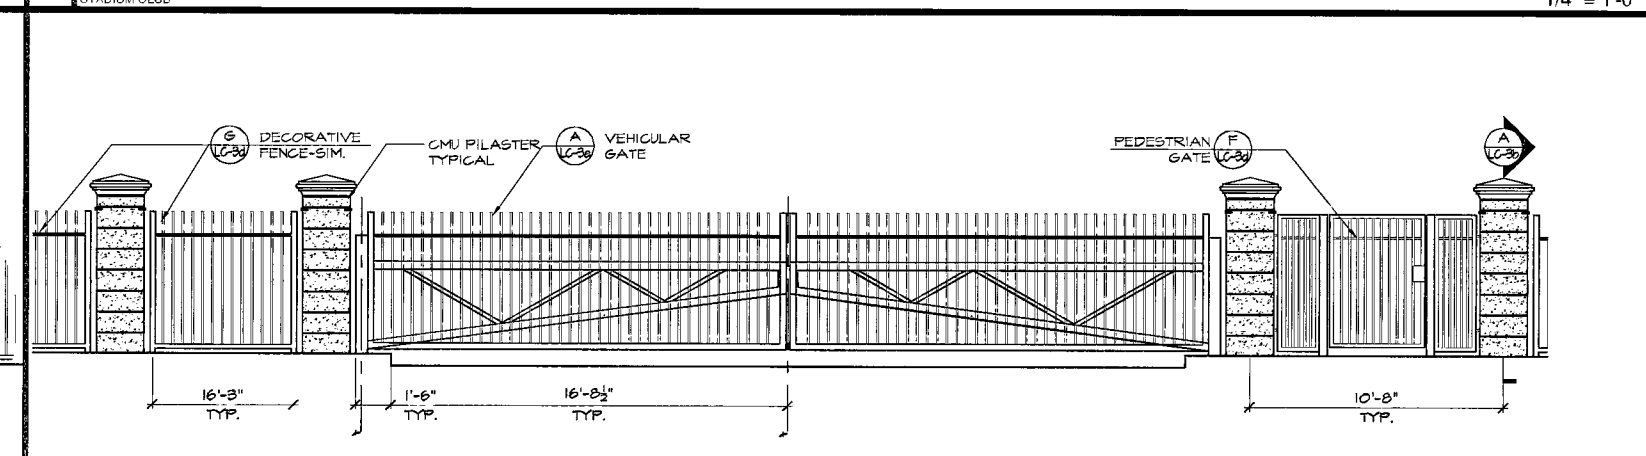


G VEHICULAR GATE 'E'

SCALE:
1/4" = 1'-0"

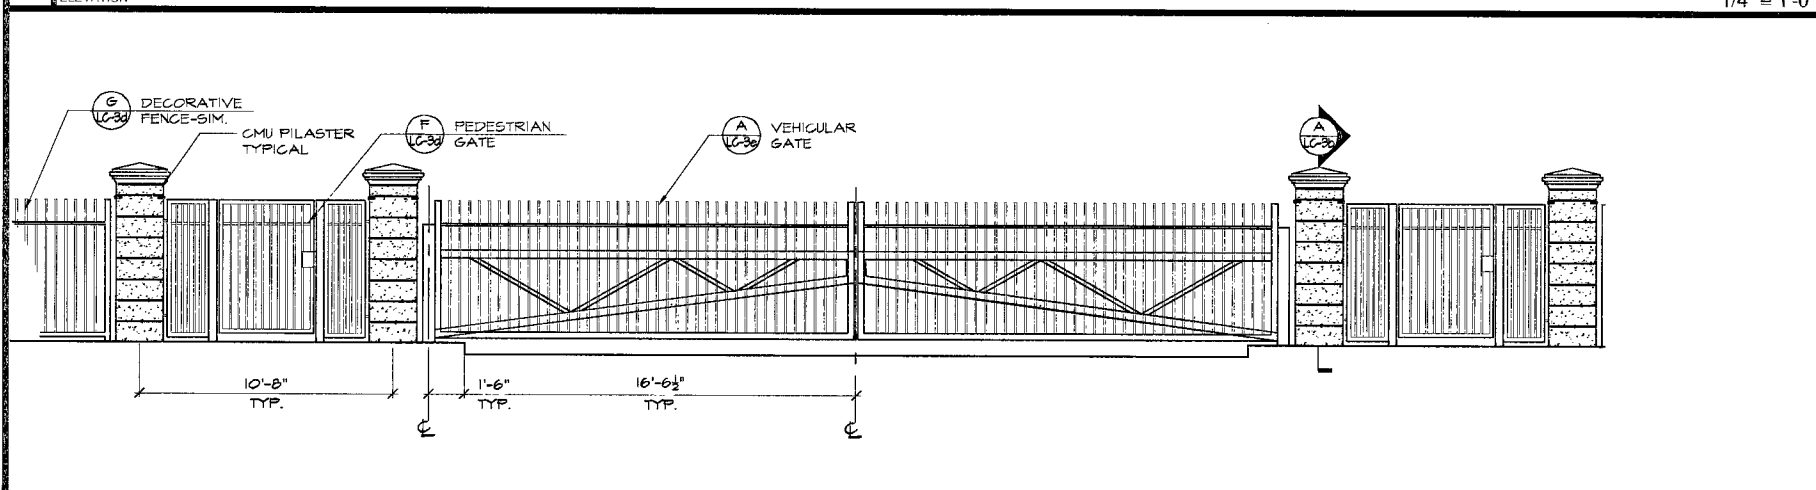


E VEHICULAR GATE 'C'

SCALE:
1/4" = 1'-0"

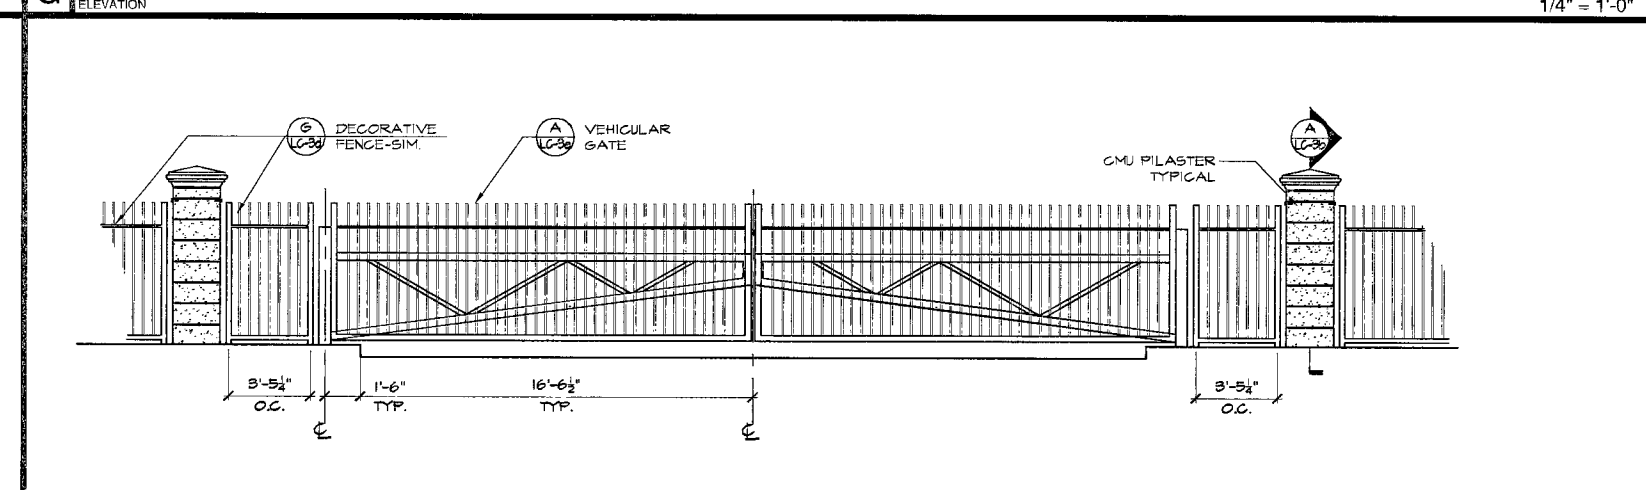


F VEHICULAR GATE 'D'


SCALE:
1/4" = 1'-0"

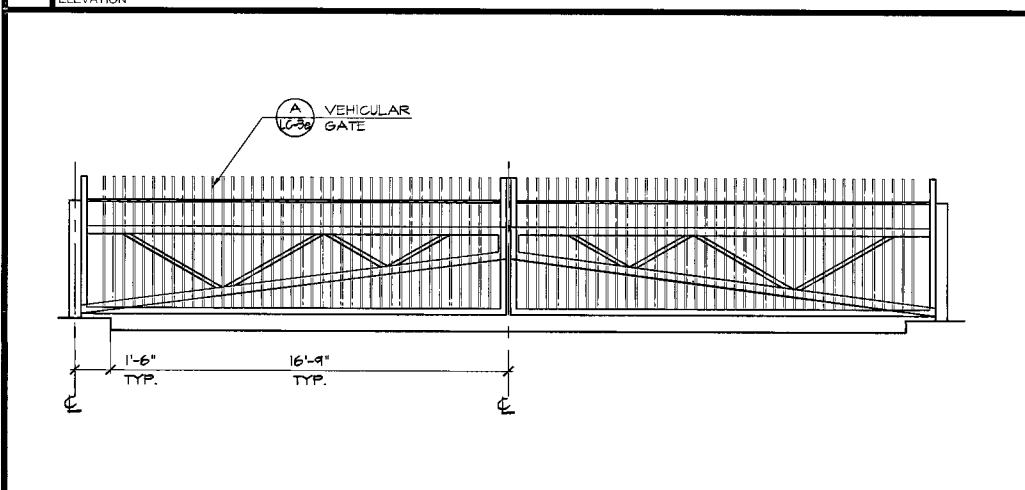


H VEHICULAR GATE 'F'

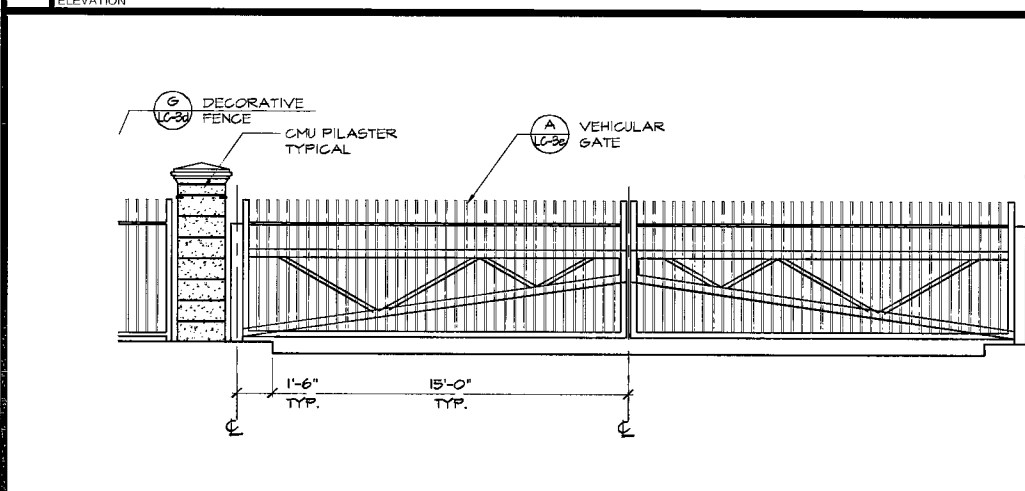


I VEHICULAR GATE 'G'

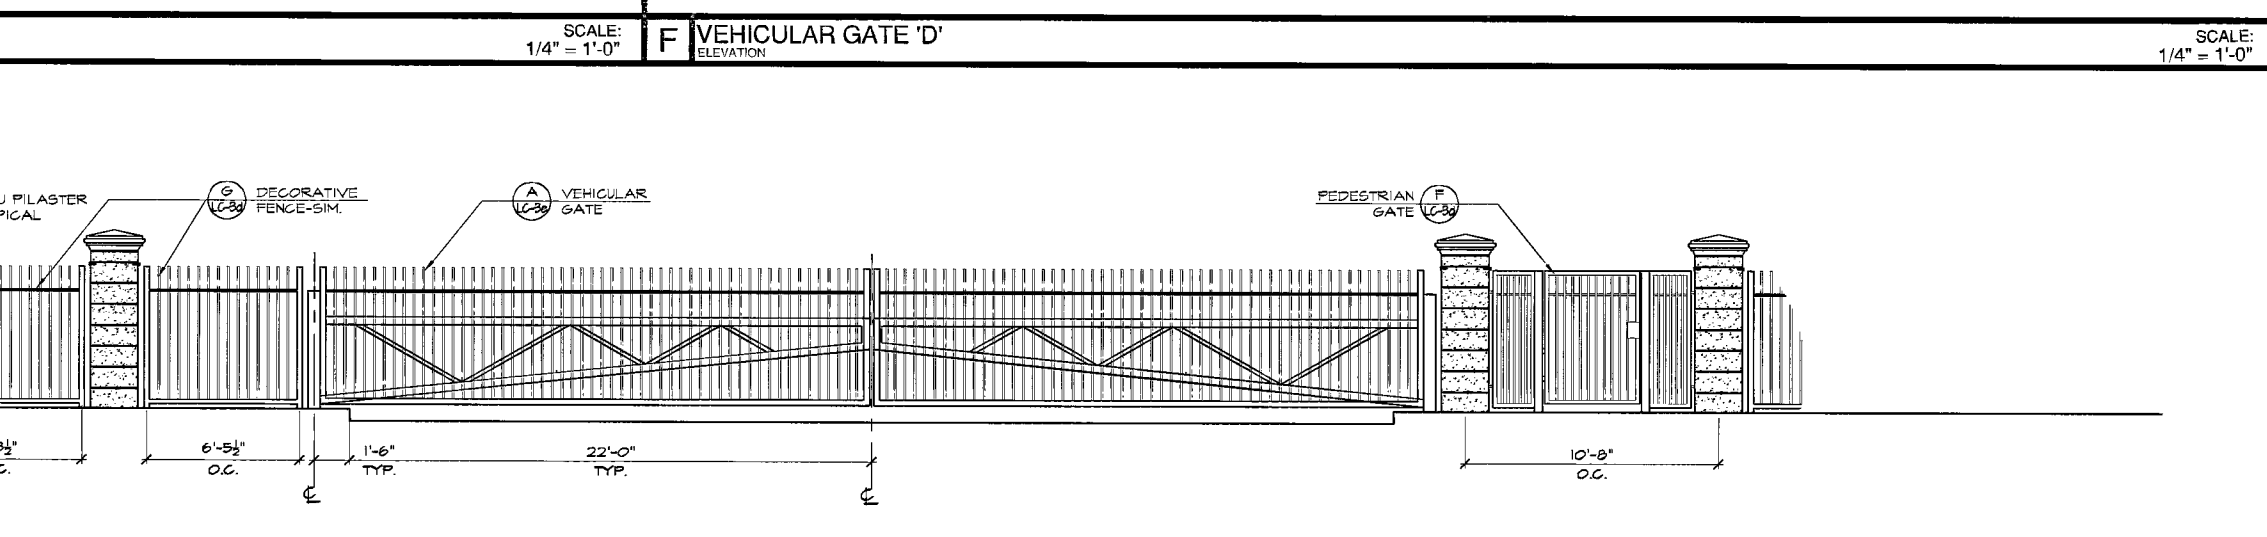

D VEHICULAR GATE 'B'

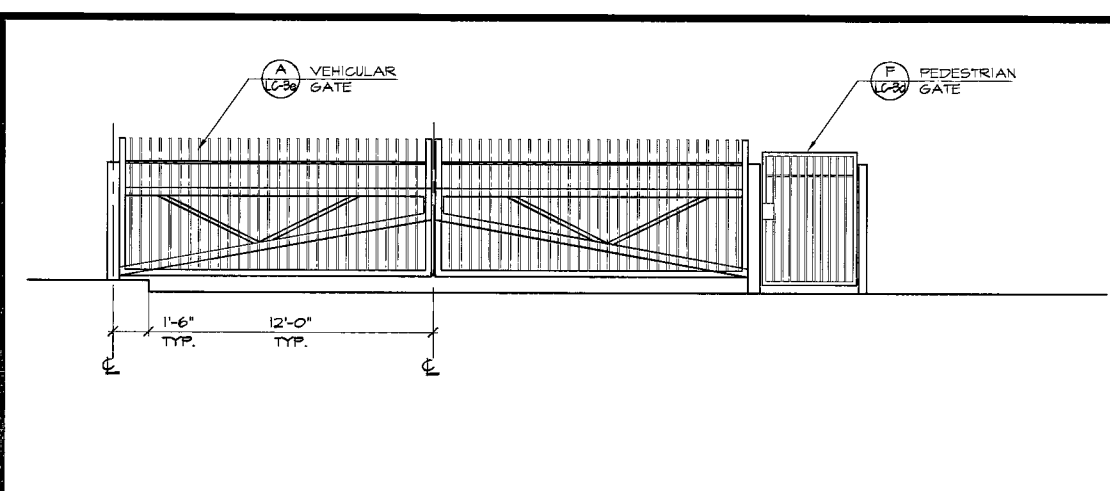

J VEHICULAR GATE 'H'

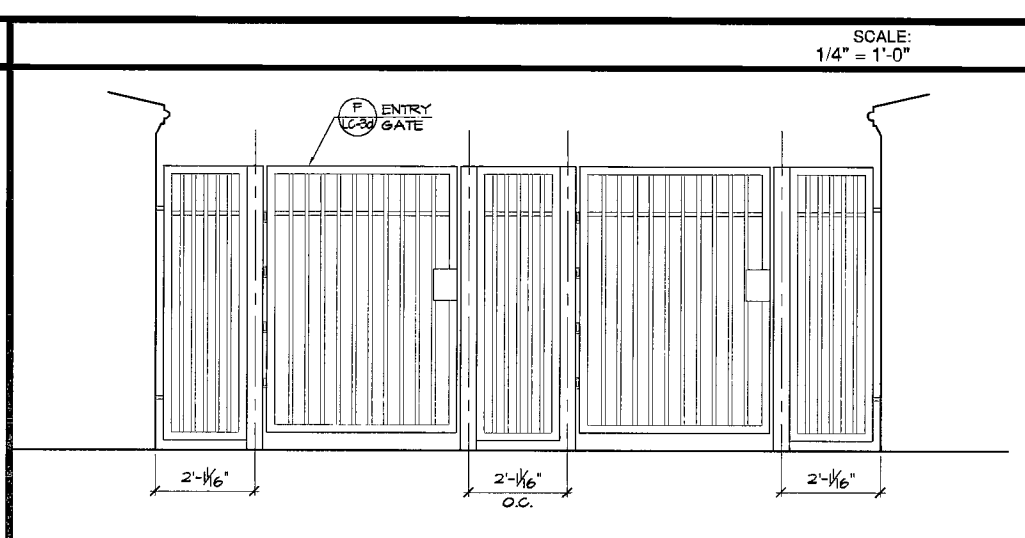

K PEDESTRIAN GATE AT FREEDOM PARK ENTRY

SCALE:
1/2" = 1'-0"

Revisions

10.20.2008	B.L.D. DEPT. REVIEW #1
10.20.2008	OWNER CHANGES
11.07.2008	B.L.D. DEPT. REVIEW #2
12.15.2008	B.L.D. DEPT. REVIEW #3
01.24.2009	B.L.D. DEPT. REVIEW #4
02.13.2009	OWNER CHANGES
03.20.2009	CMU WALL CHANGES
05.08.2009	CONTRACTOR CHANGES
06.29.2009	CONTRACTOR CHANGES
12.16.2009	CONTRACTOR CHANGES
01.31.2010	RECORD DRAWINGS

Architecture
interiors
planting
engineering

Bekker Perich Sabatini
6860 Bermuda Road, Ste. 100
Las Vegas, Nevada 89119
702.436.1006
fax 436.1050
info@bpdesign.org

PBSJ
ENGINEERING PLANNING SURVEYING
CONSTRUCTION SERVICES

2270 Corporate Circle
Suite 100
Henderson, Nevada 89074
Telephone 702.263.7175
Fax 702.263.7200

CITY OF LAS VEGAS
FREEDOM PARK RENOVATION
850 NORTH MOJAVE, LAS VEGAS, NEVADA 89101
CONSTRUCTION DETAILS

Russ Manger
Russ Manger
Reiche Constructors, Inc.

RECORD DRAWINGS
01-31-2010

OWNER: CITY OF LAS VEGAS
DEPARTMENT OF PUBLIC WORKS
ARCHITECTURAL SERVICES

400 EAST STEWART AVENUE
LAS VEGAS, NEVADA 89101
PHONE: (702) 228-6335
FAX: (702) 384-4846
TDD: (702) 384-9108

3006-LC-3a
FEBRUARY 13, 2009
AS NOTED
070354
550.22-18

LC-3a