


Use of the information contained in this instrument for other than the specific purpose for which it was intended and for other than the client for whom it was prepared is forbidden unless expressly permitted in writing in advance by t&grf Civil Engineering, and t&grf Civil Engineering shall have no liability to any use of this information without their written consent.

Avoid cutting underground utility lines. It's costly.
Call before you Dig
1-800-227-2600
UNDERGROUND SERVICE ALERT (U.S.A.)

Avoid overhead power line contact.
Call before you CRANE
1-702-593-6111
NEVADA POWER ENVIRONMENT & SAFETY SERVICES DEPARTMENT

NOTICE 1
EXISTING UTILITIES ARE LOCATED ON THE PLANS FOR THE CONVENIENCE OF THE CONTRACTOR ONLY. THE ENGINEER BEARS NO RESPONSIBILITY FOR THE LOCATION OF UTILITIES SHOWN OR NOT SHOWN ON THE PLANS. THE CONTRACTOR SHALL NOTIFY ALL UTILITY COMPANIES BEFORE STARTING CONSTRUCTION AND IT SHALL BE THE RESPONSIBILITY OF THE CONTRACTOR TO VERIFY THE LOCATION OF ALL UTILITIES WITH THE UTILITY COMPANIES.

Avoid cutting underground utilities. It's costly.
CALL BEFORE YOU Dig
1-800-227-2600
UNDERGROUND SERVICE (USA)

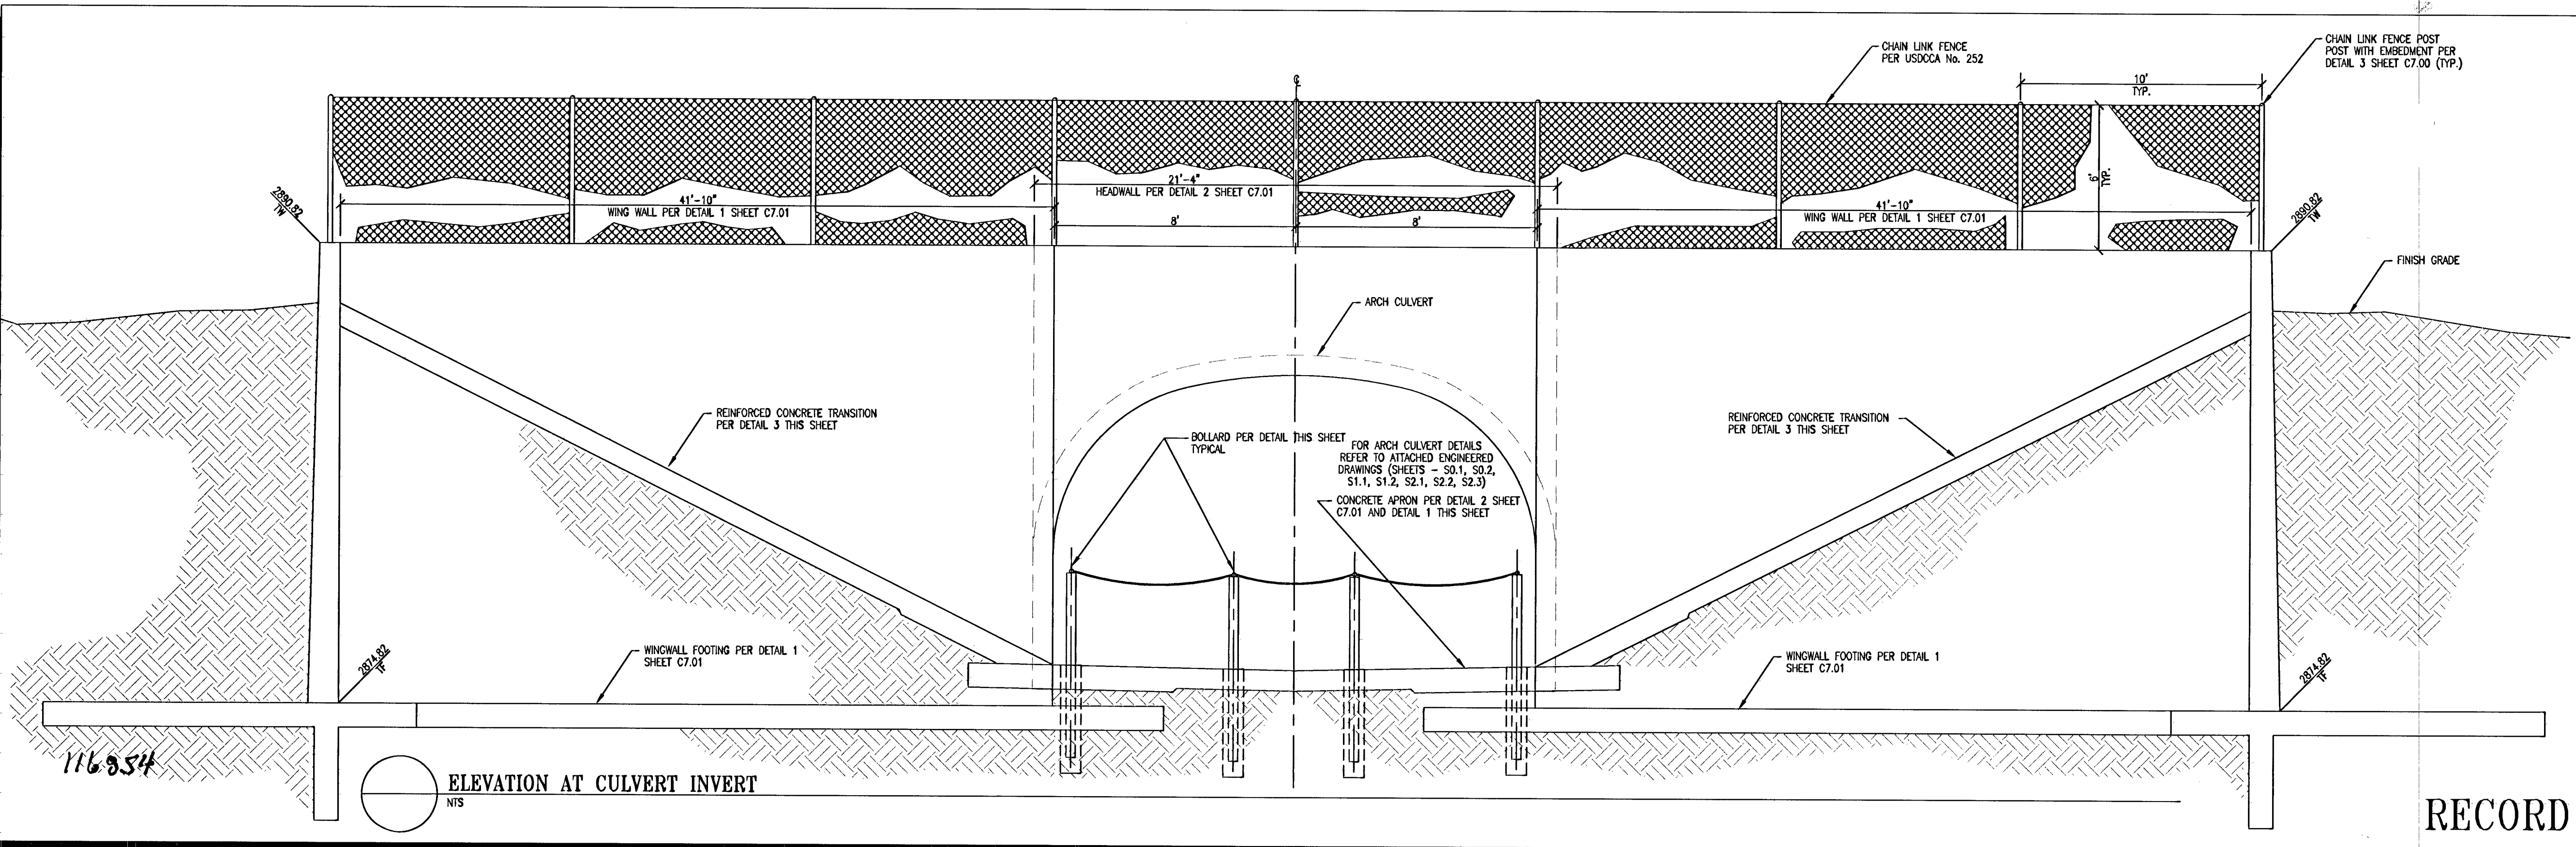

REVISIONS
CONSULTANT
t&grf
CIVIL-ENGINEERING
1231 DARMARAK DRIVE
LAS VEGAS, NV 89102
PHONE: 702-870-2660
FAX: 702-870-6033

GOWAN LONE MOUNTAIN SYSTEM
CLIFF SHADOWS PARK
DRAINAGE STRUCTURE NOTES,
SECTIONS AND DETAILS

STAMP
F. GUY
12/31/09
CIVIL
113-19-09

OWNER: CITY OF LAS VEGAS
DEPARTMENT OF PUBLIC WORKS
ARCHITECTURAL SERVICES

400 EAST STEWART AVENUE
LAS VEGAS, NEVADA 89101
PHONE: (702) 229-5532
FAX: (702) 388-4848
TDD: (702) 388-9108

DRAWN	gfr
FILE	C:\03\004\arch
DATE	MARCH 2009
SCALE	NA
SHEET NO.	24
CIV. DWS. NO.	65023
PROJECT NO.	116.854
SHEET NO.	C7.03

RECORD DRAWING