



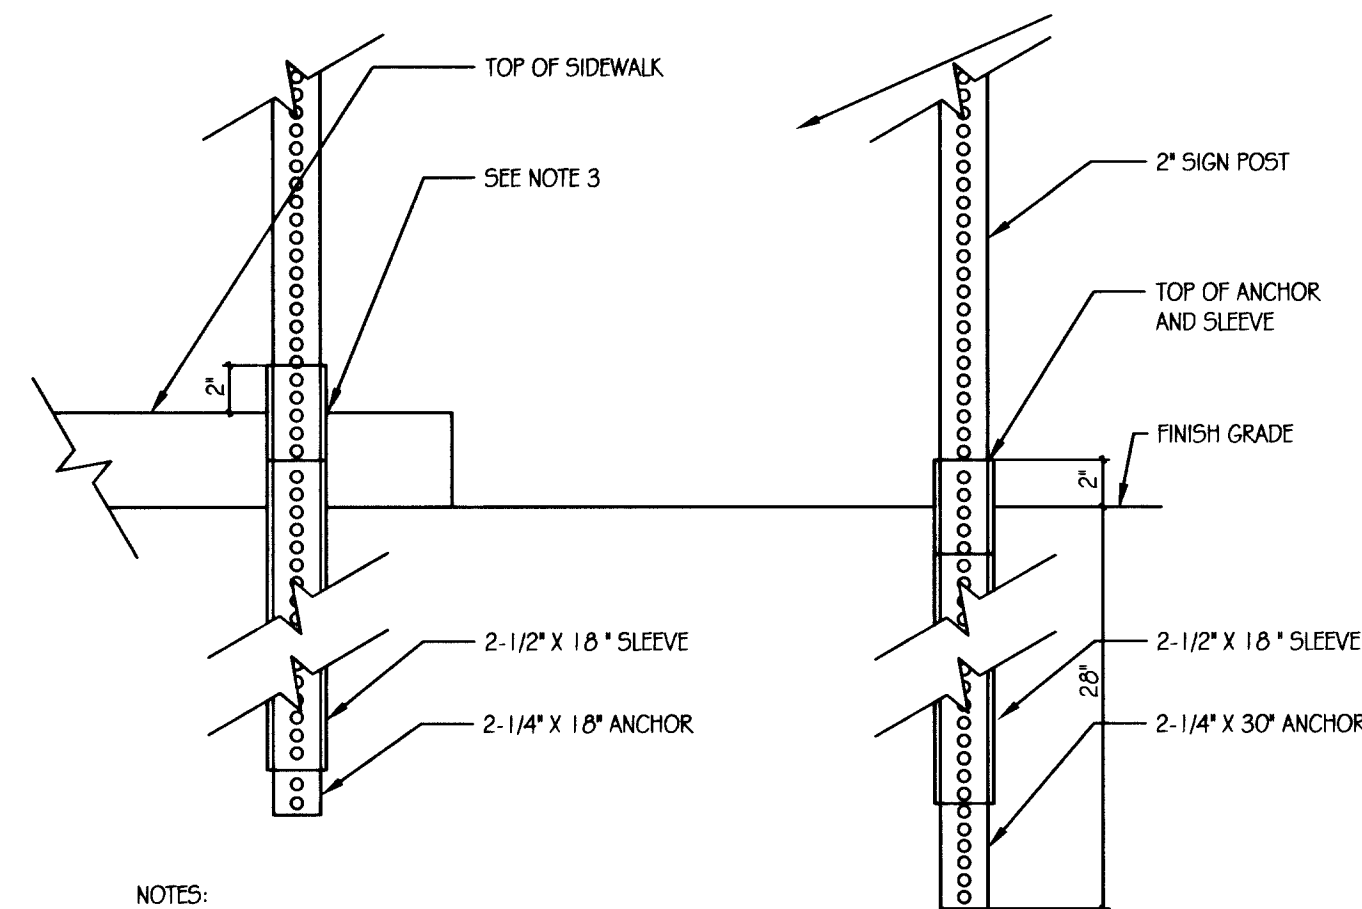


NOTES:

1. ALL COMPONENTS SHALL BE SQUARE POST, PERFORATED ON ALL FOUR SIDES.
2. ATTACH ANCHOR AND SLEEVE TOGETHER PRIOR TO DRIVING INTO GROUND. LEAVE AT LEAST ONE HOLE, BUT NO MORE THAN TWO, ABOVE GROUND OR ABOVE SIDEWALK.
3. FOR SIDEWALK INSTALLATION, DRILL SIDEWALK WITH A 3" HOLE, THE CENTER TO BE 6" FROM BACK OF SIDEWALK.
4. ATTACH POST TO ANCHORING SYSTEM BY USING AT LEAST TWO 3/8" DIA DRIVE RIVETS.
5. PROVIDE 4" MINIMUM LAP BETWEEN POST AND THE ANCHOR/SLEEVE ASSEMBLY.

A SIGN POST INSTALLATION

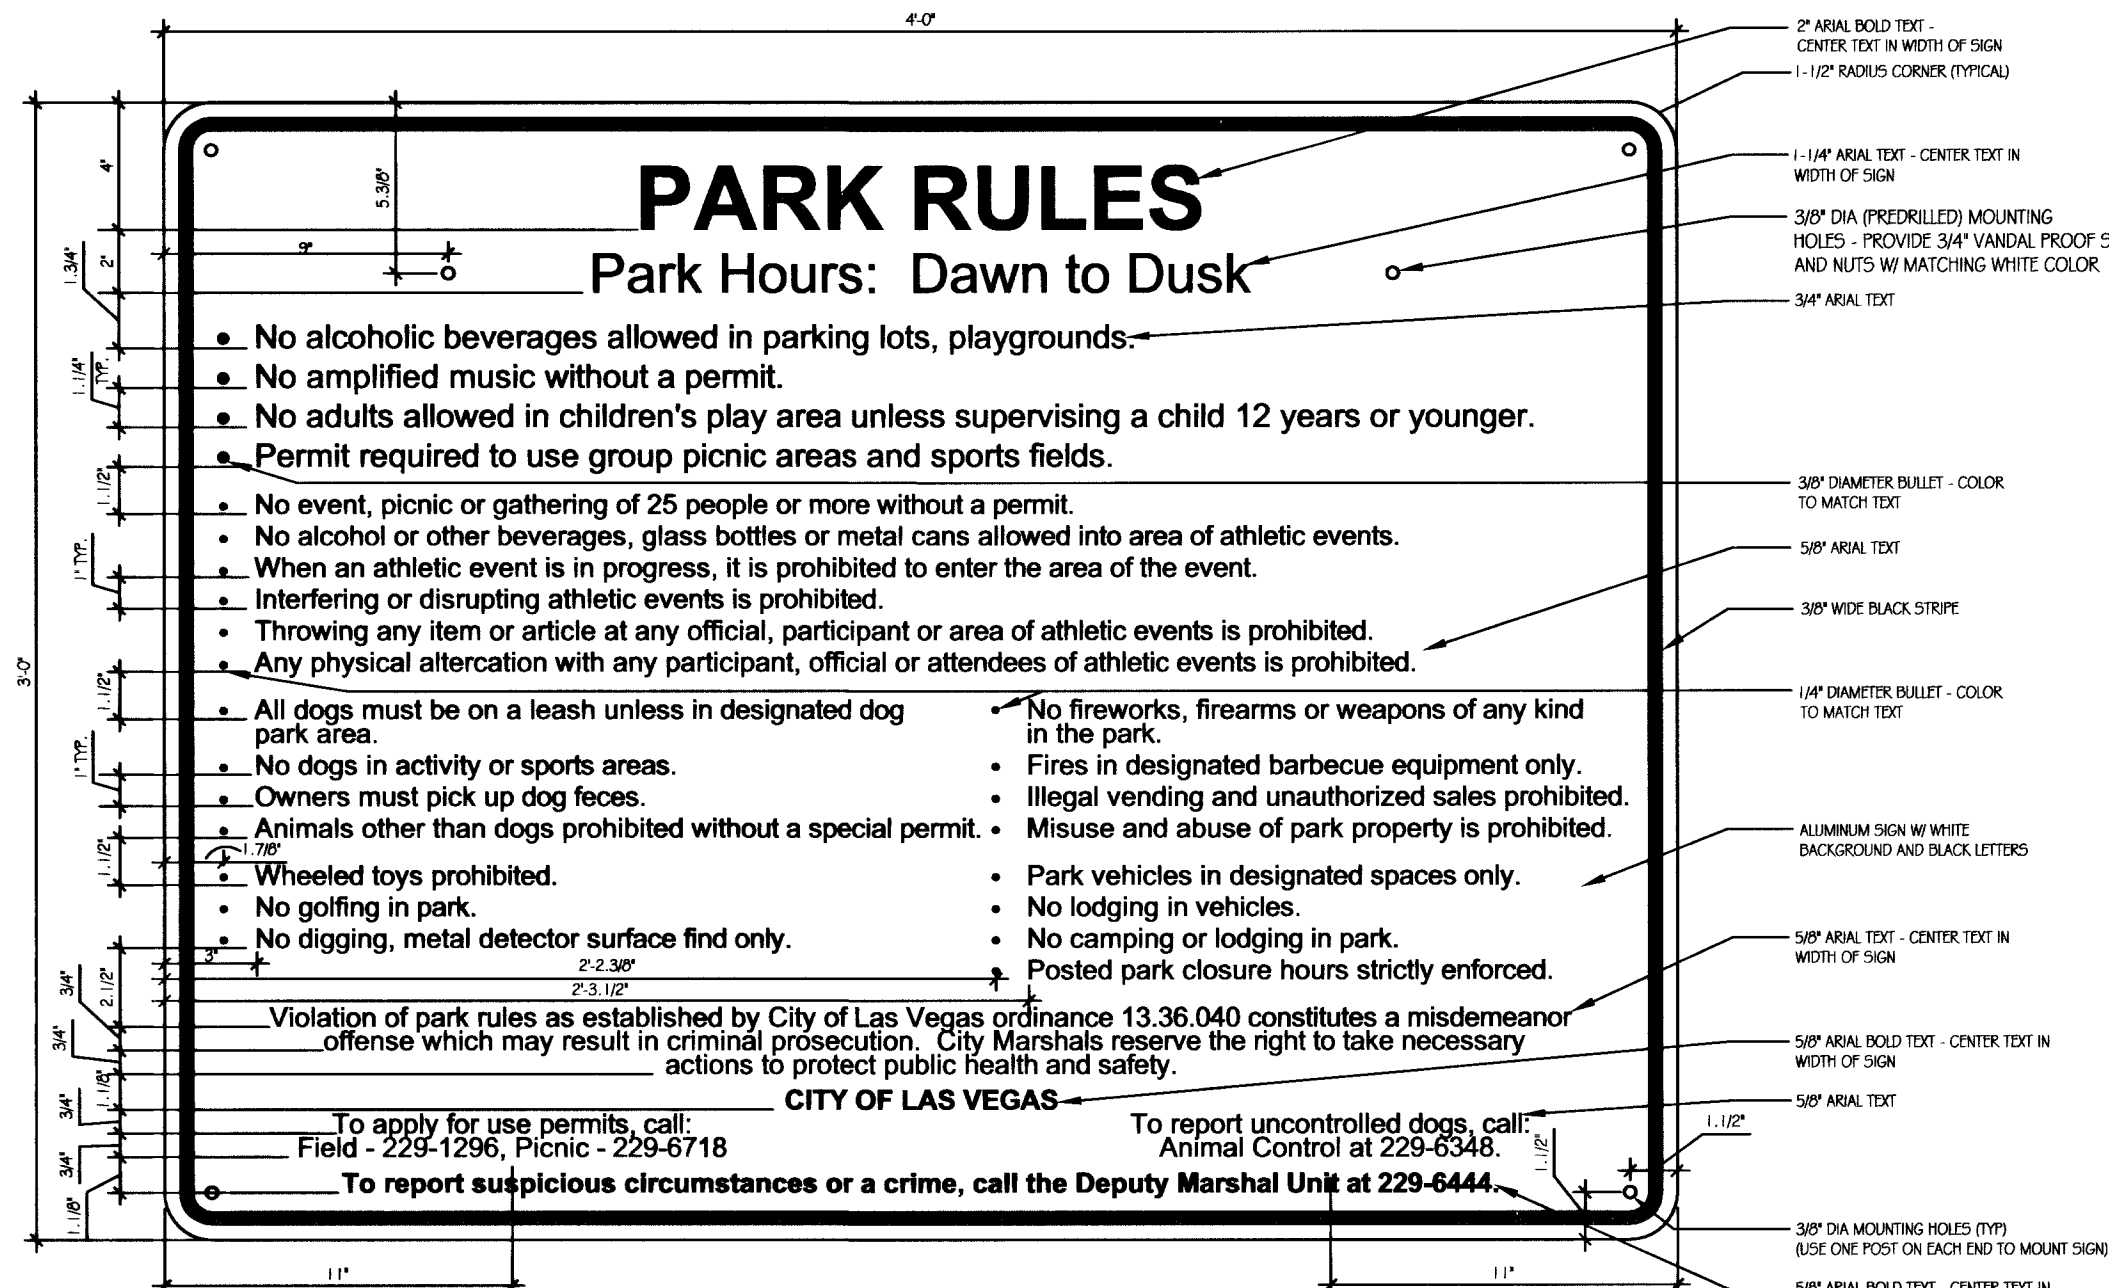

B PARK RULES SIGN

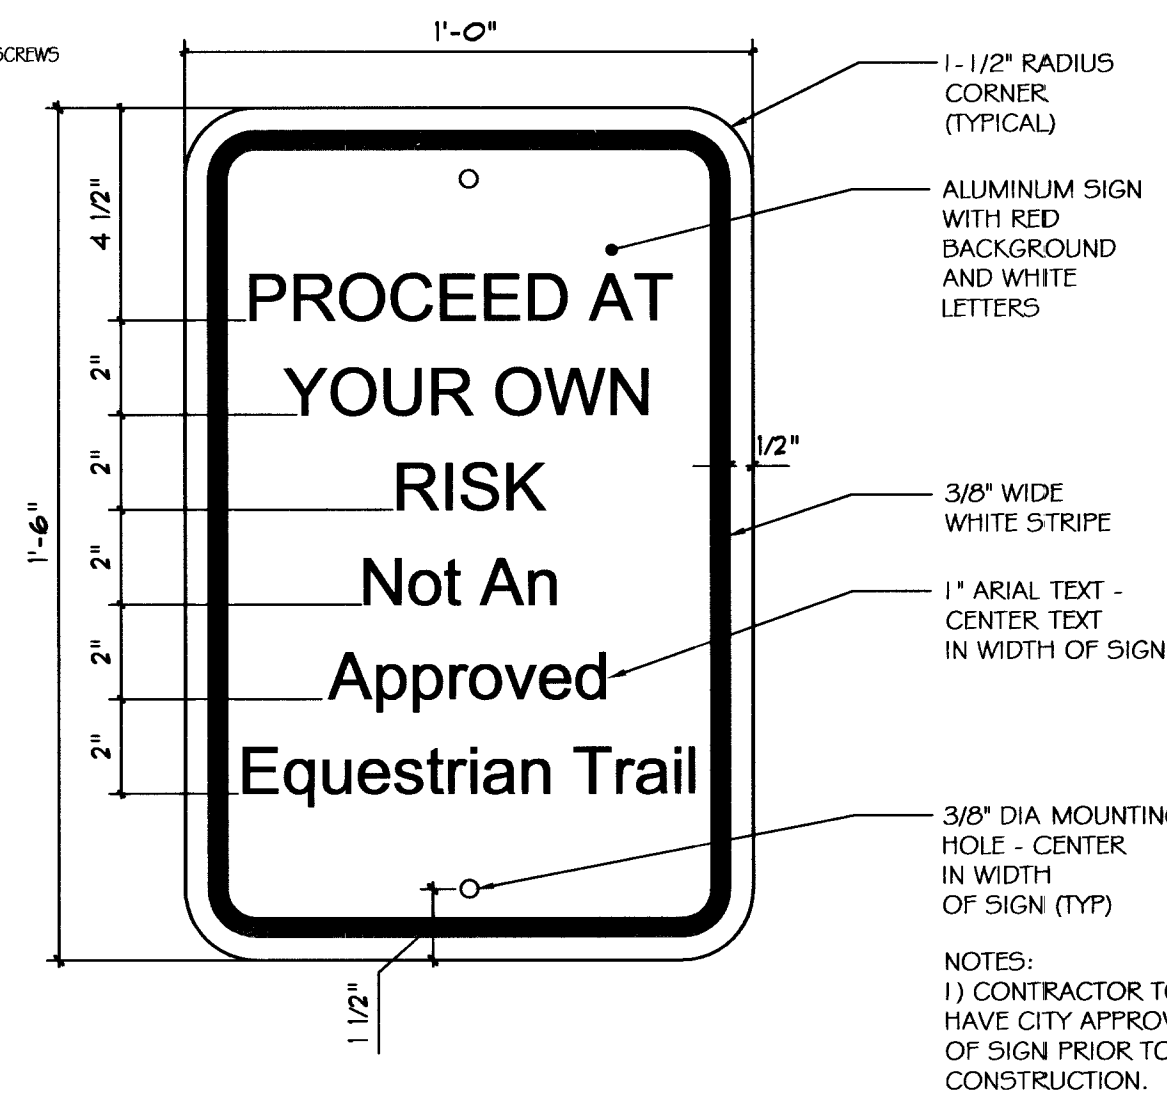


C NOT APPROVED HORSE TRAIL SIGN

**RECORD DRAWINGS
NOT FOR CONSTRUCTION**


1. TO ALTER THESE DOCUMENTS FOR ANOTHER PROJECT BY ANYONE OTHER THAN THE ORIGINAL ARCHITECT IS A VIOLATION OF NRS 623.

2. THIS RECORD DRAWING HAS BEEN PREPARED IN PART, BASED UPON INFORMATION FURNISHED BY THE GENERAL CONTRACTOR, WHILE THIS INFORMATION IS BELIEVED TO BE RELIABLE, THE DESIGN PROFESSIONAL CANNOT ASSURE ITS ACCURACY, AND THUS IS NOT RESPONSIBLE FOR THE ACCURACY OF THIS RECORD DRAWING OR FOR ANY ERRORS OR OMISSIONS WHICH MAY HAVE BEEN INCORPORATED INTO IT AS A RESULT. THE DESIGN PROFESSIONAL CANNOT AND DOES NOT WARRANT THEIR ACCURACY.


3. INFORMATION THAT MAY BE INCLUDED WOULD BE SIGNIFICANT CHANGES TO PLANTING OR IRRIGATION LAYOUT PLANS AND ASSOCIATED DRAWINGS, MINOR DIMENSION OR CONSTRUCTION DETAIL CHANGES MAY NOT BE INCLUDED.

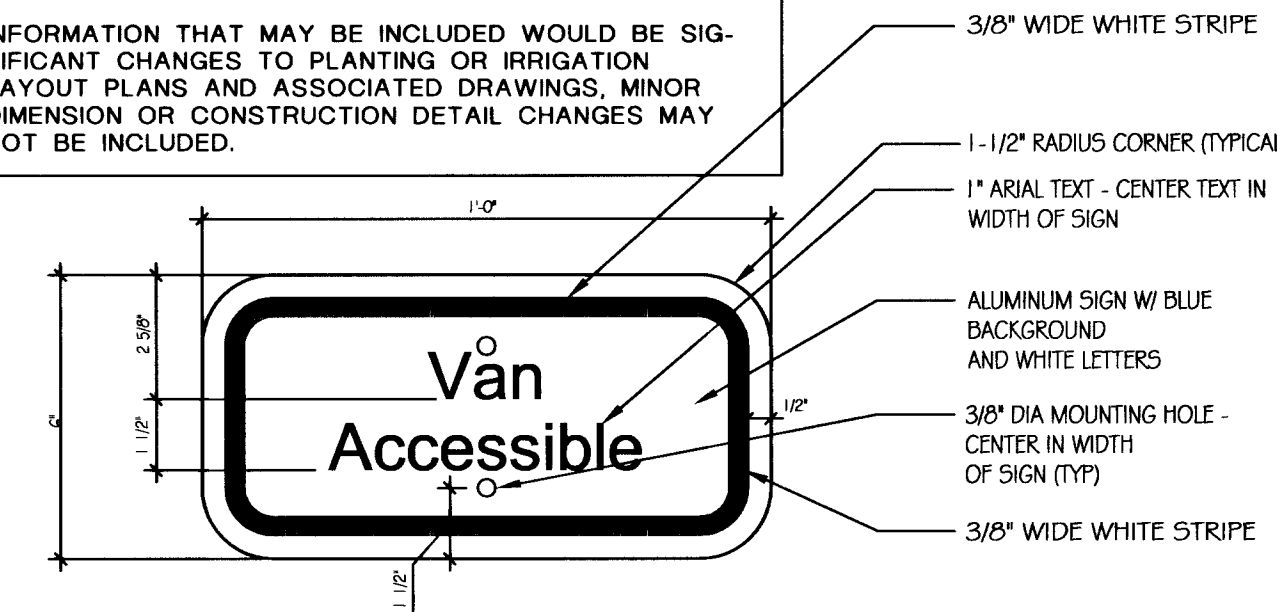


D VAN ACCESSIBLE SIGNS

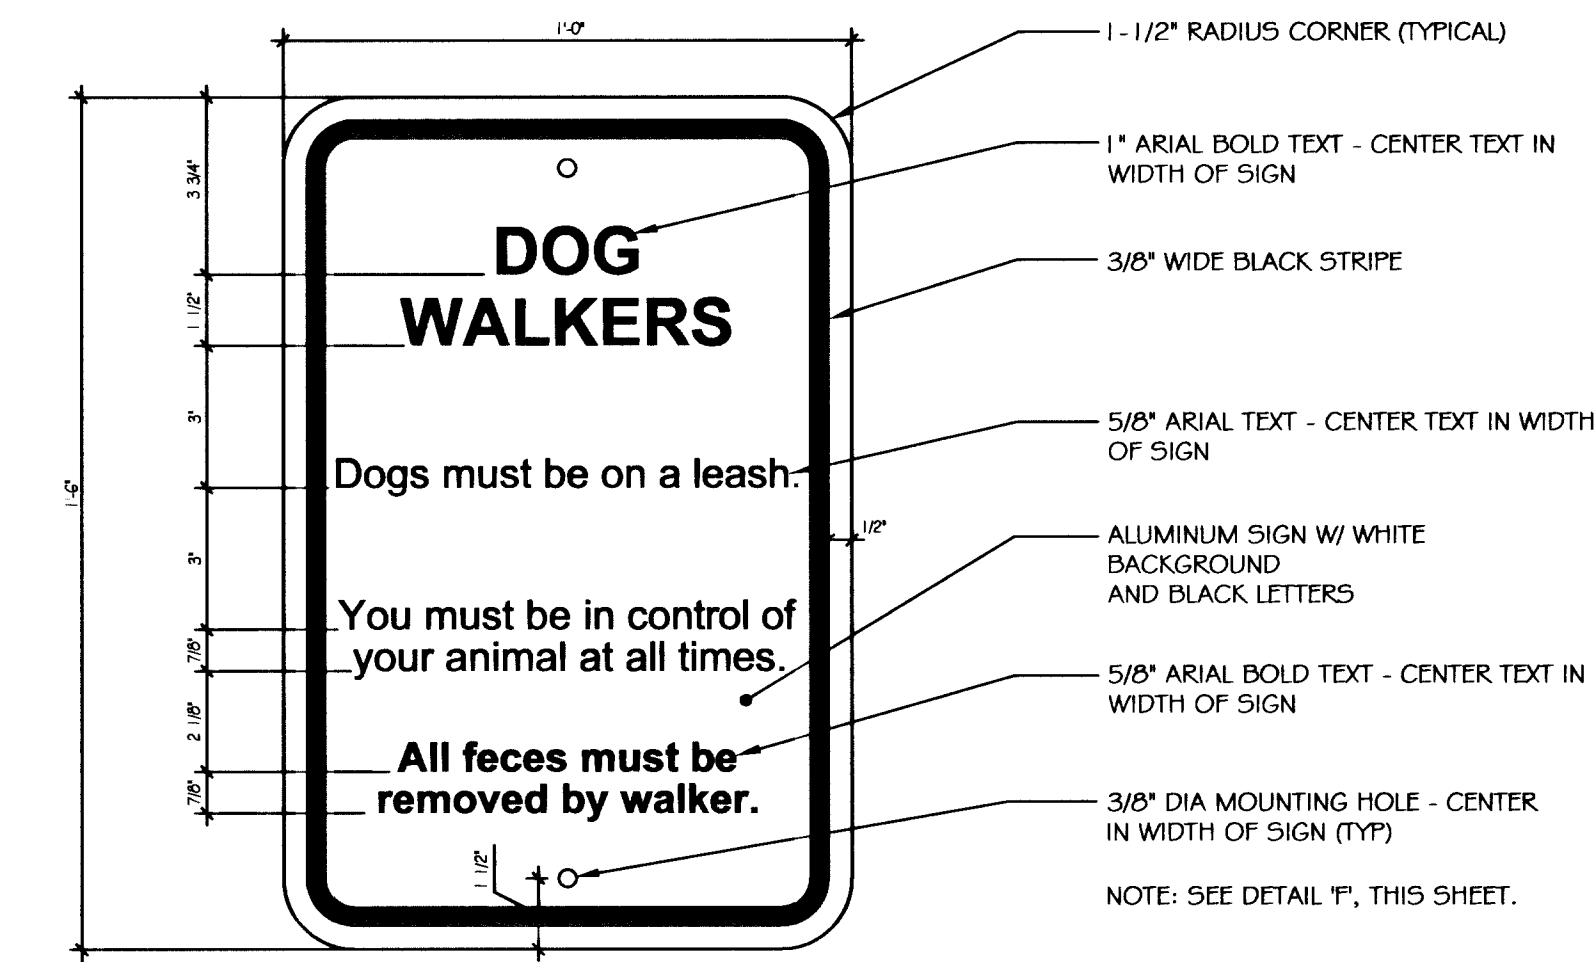


E DOG SIGN

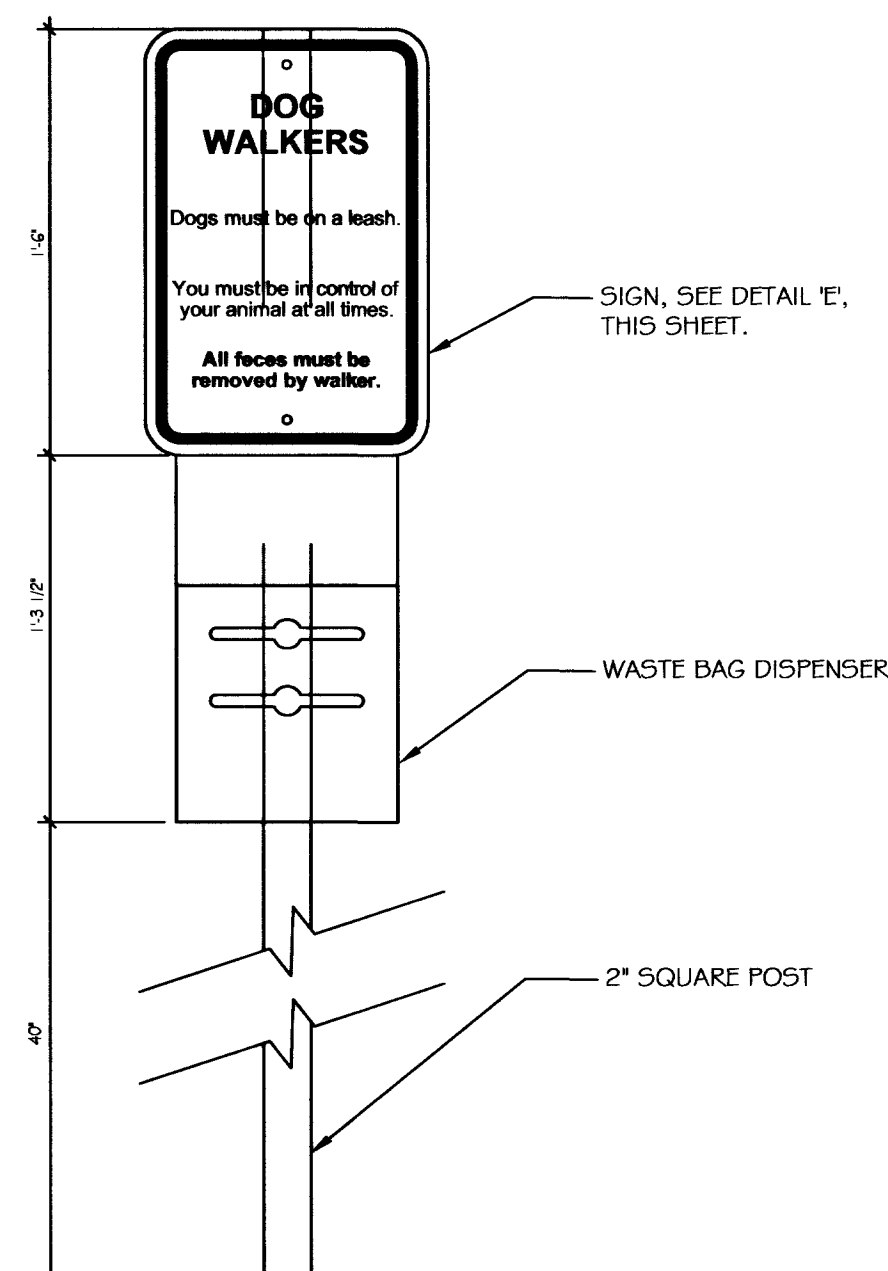


F DOG SIGN WITH BAG DISPENSER

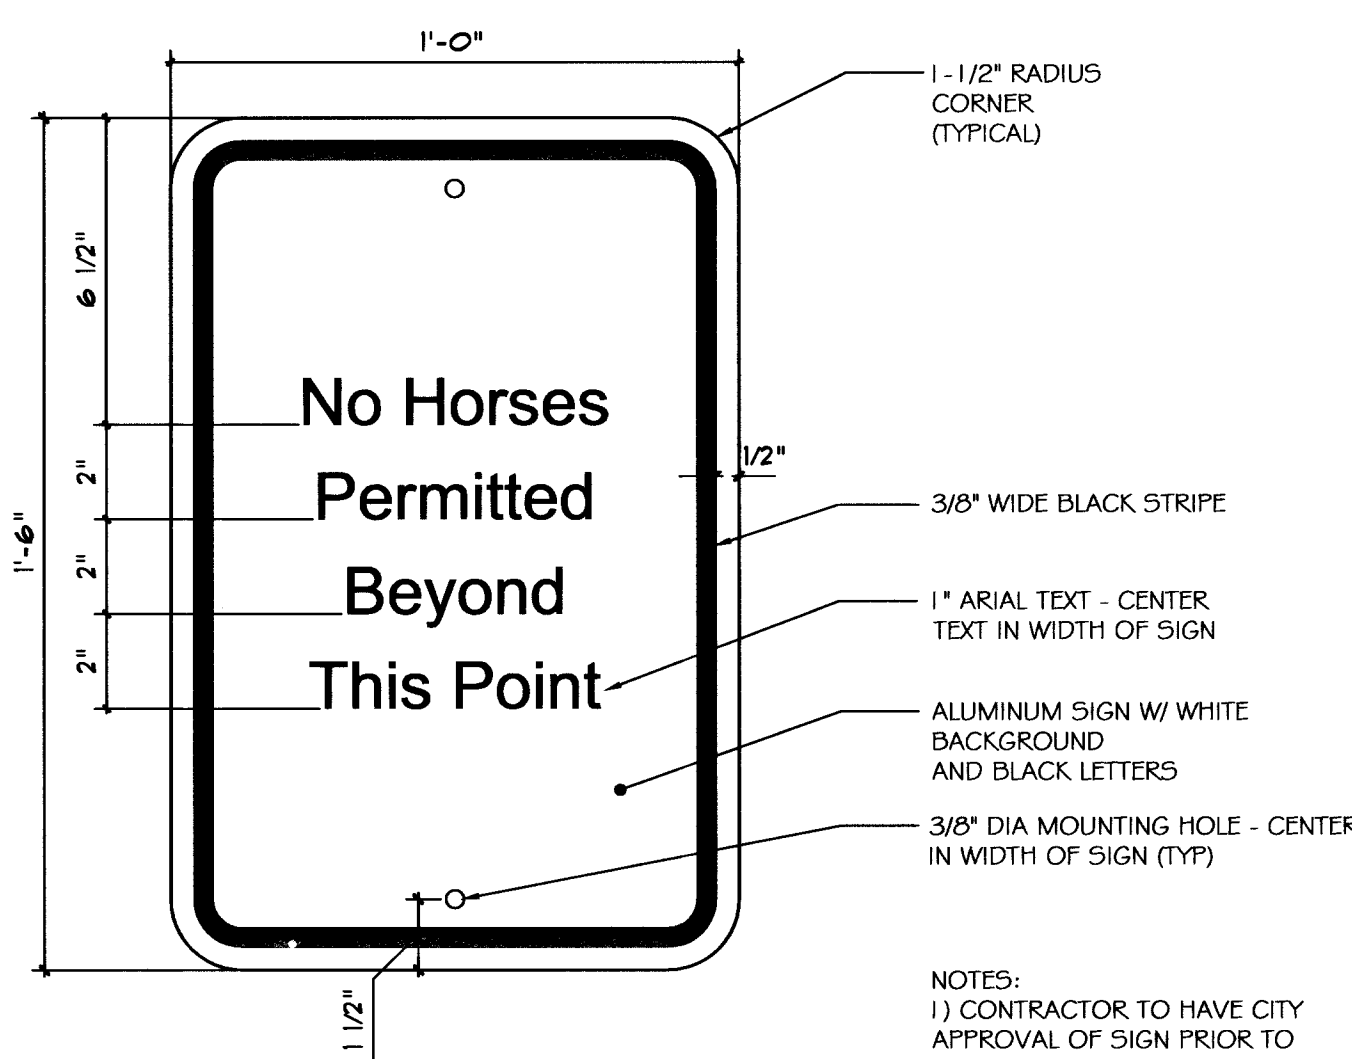


G NO HORSES SIGN

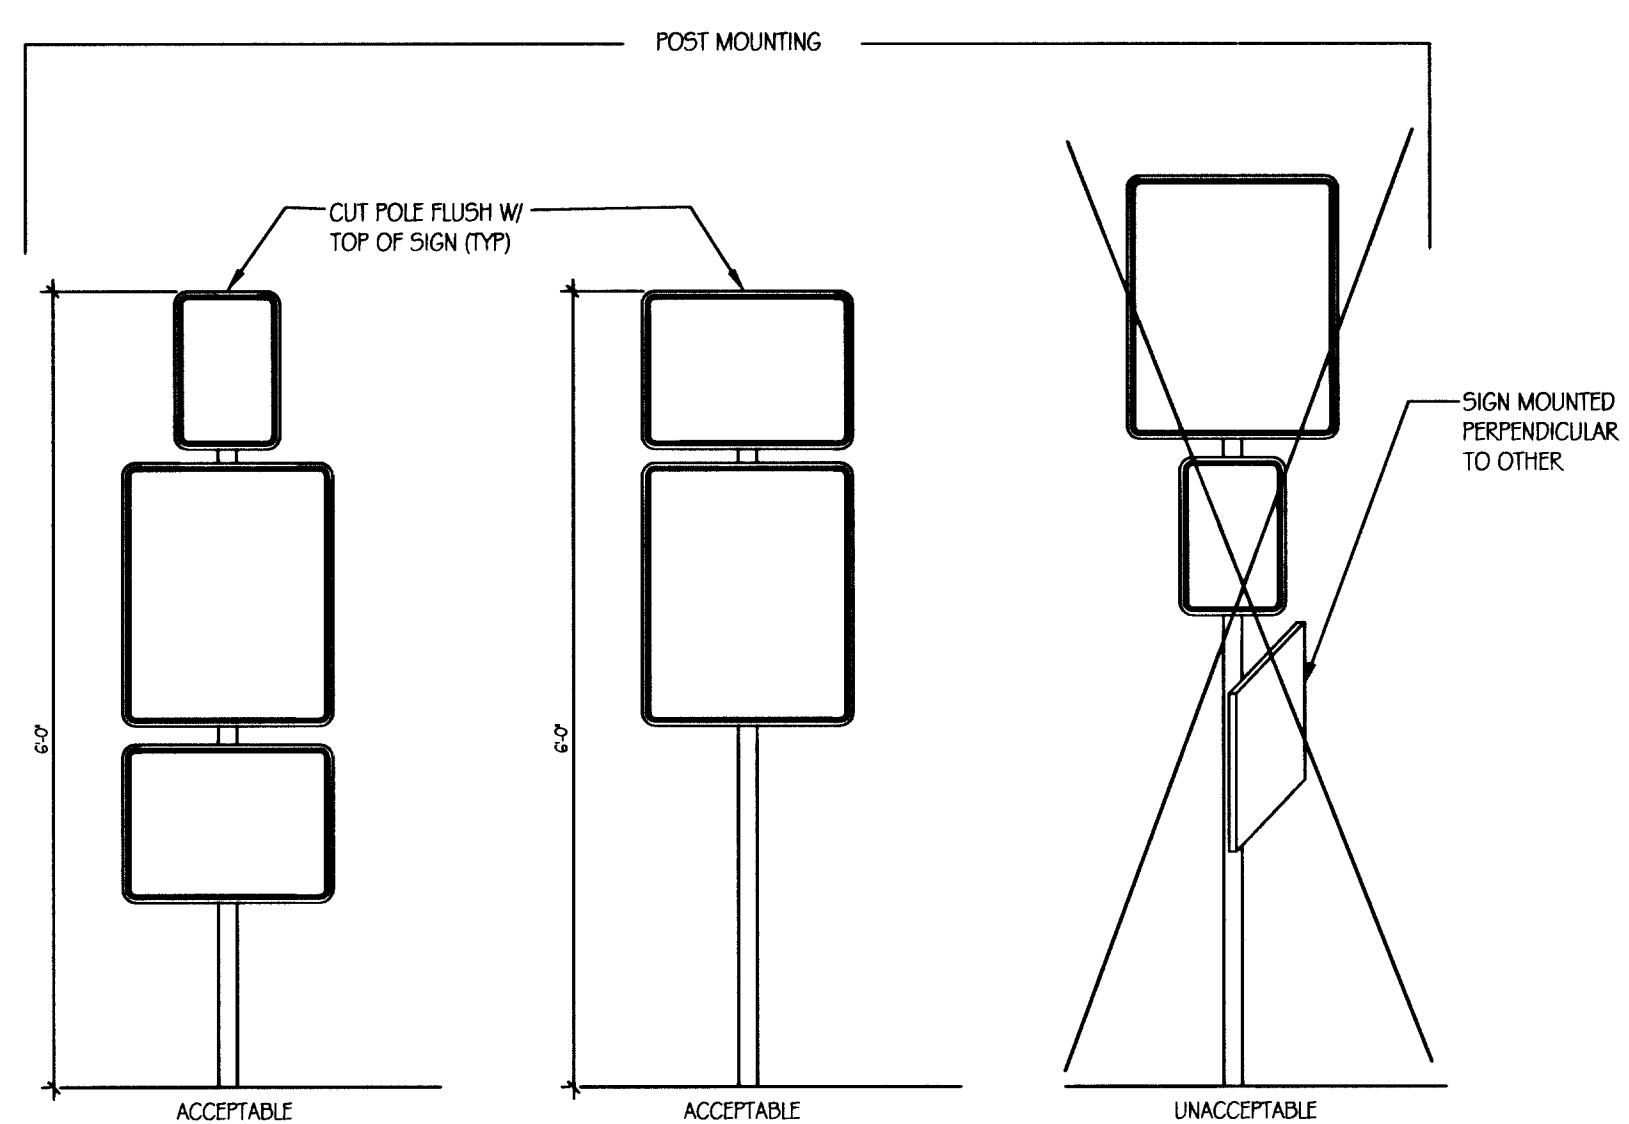


H TYPICAL SIGN MOUNTING

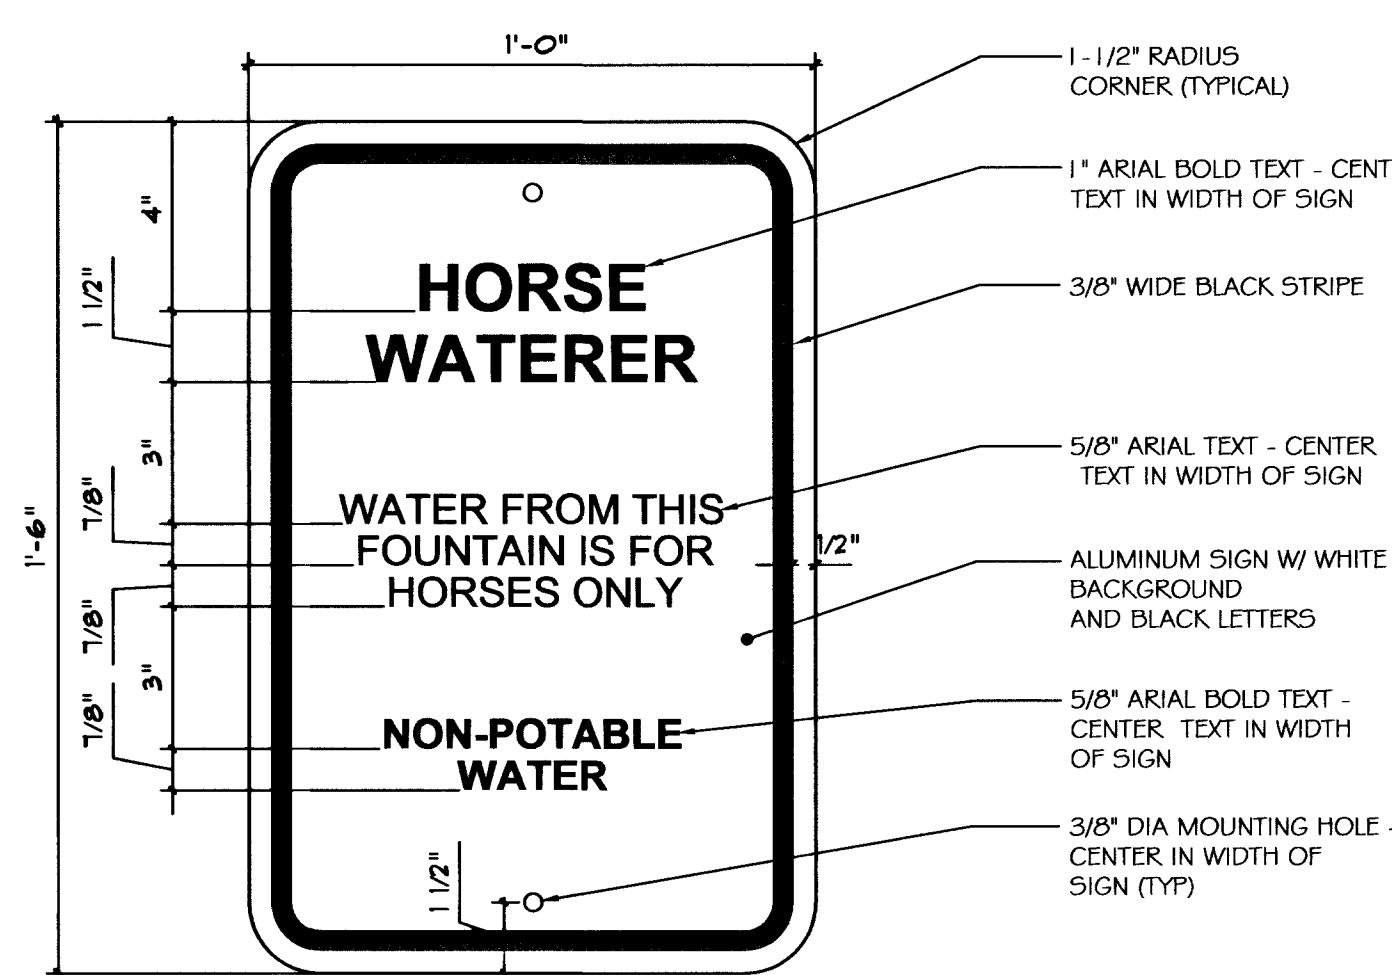

I HORSE WATERER SIGN

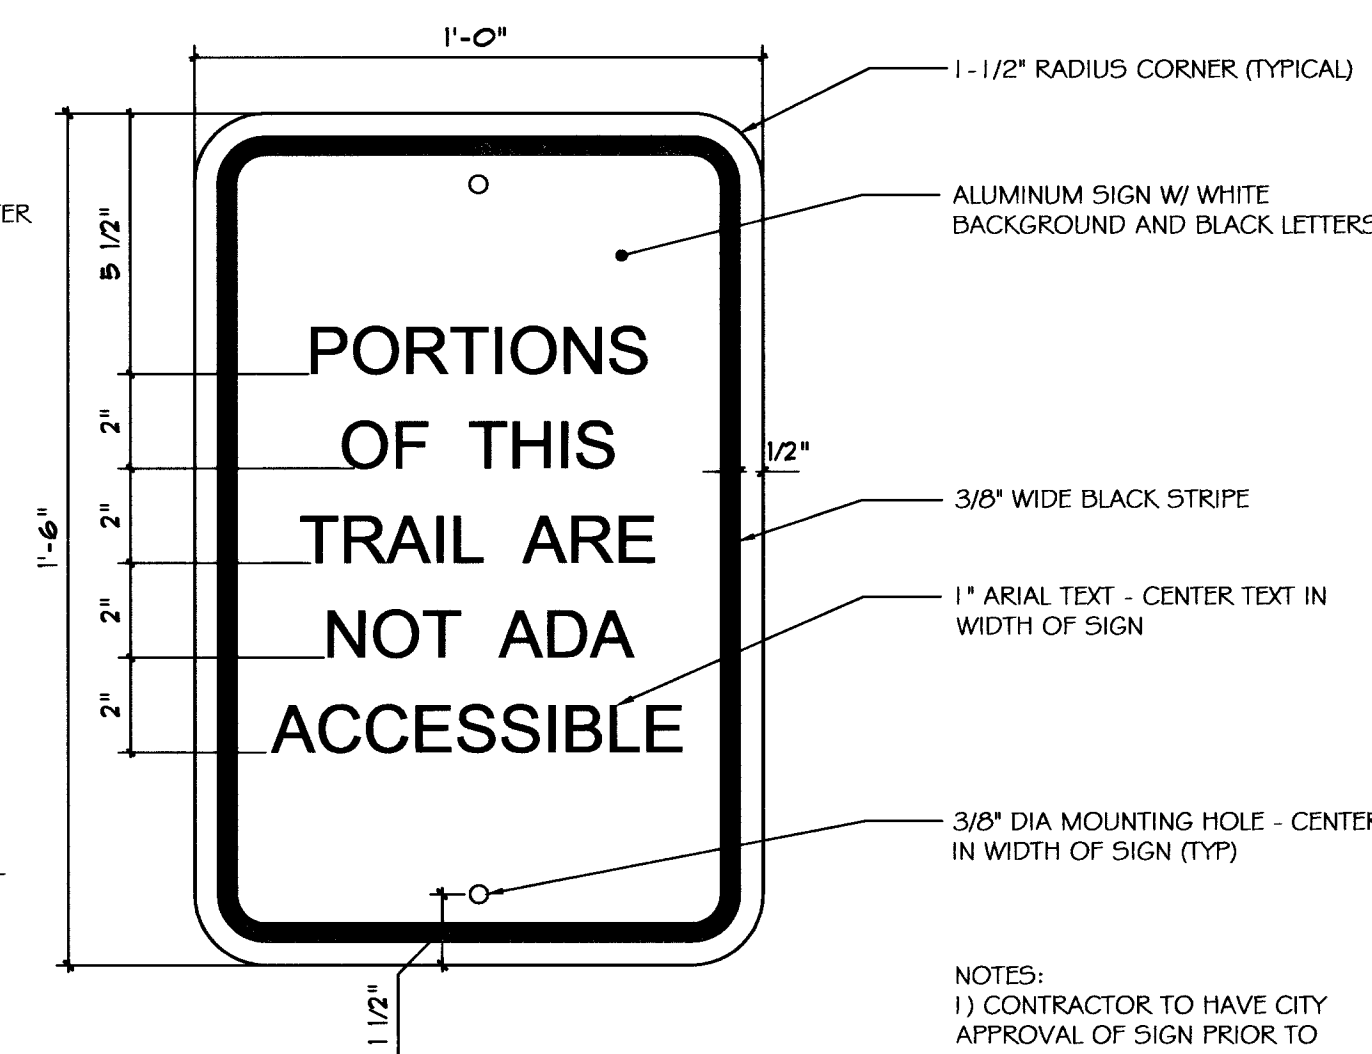

J TRAIL SIGN

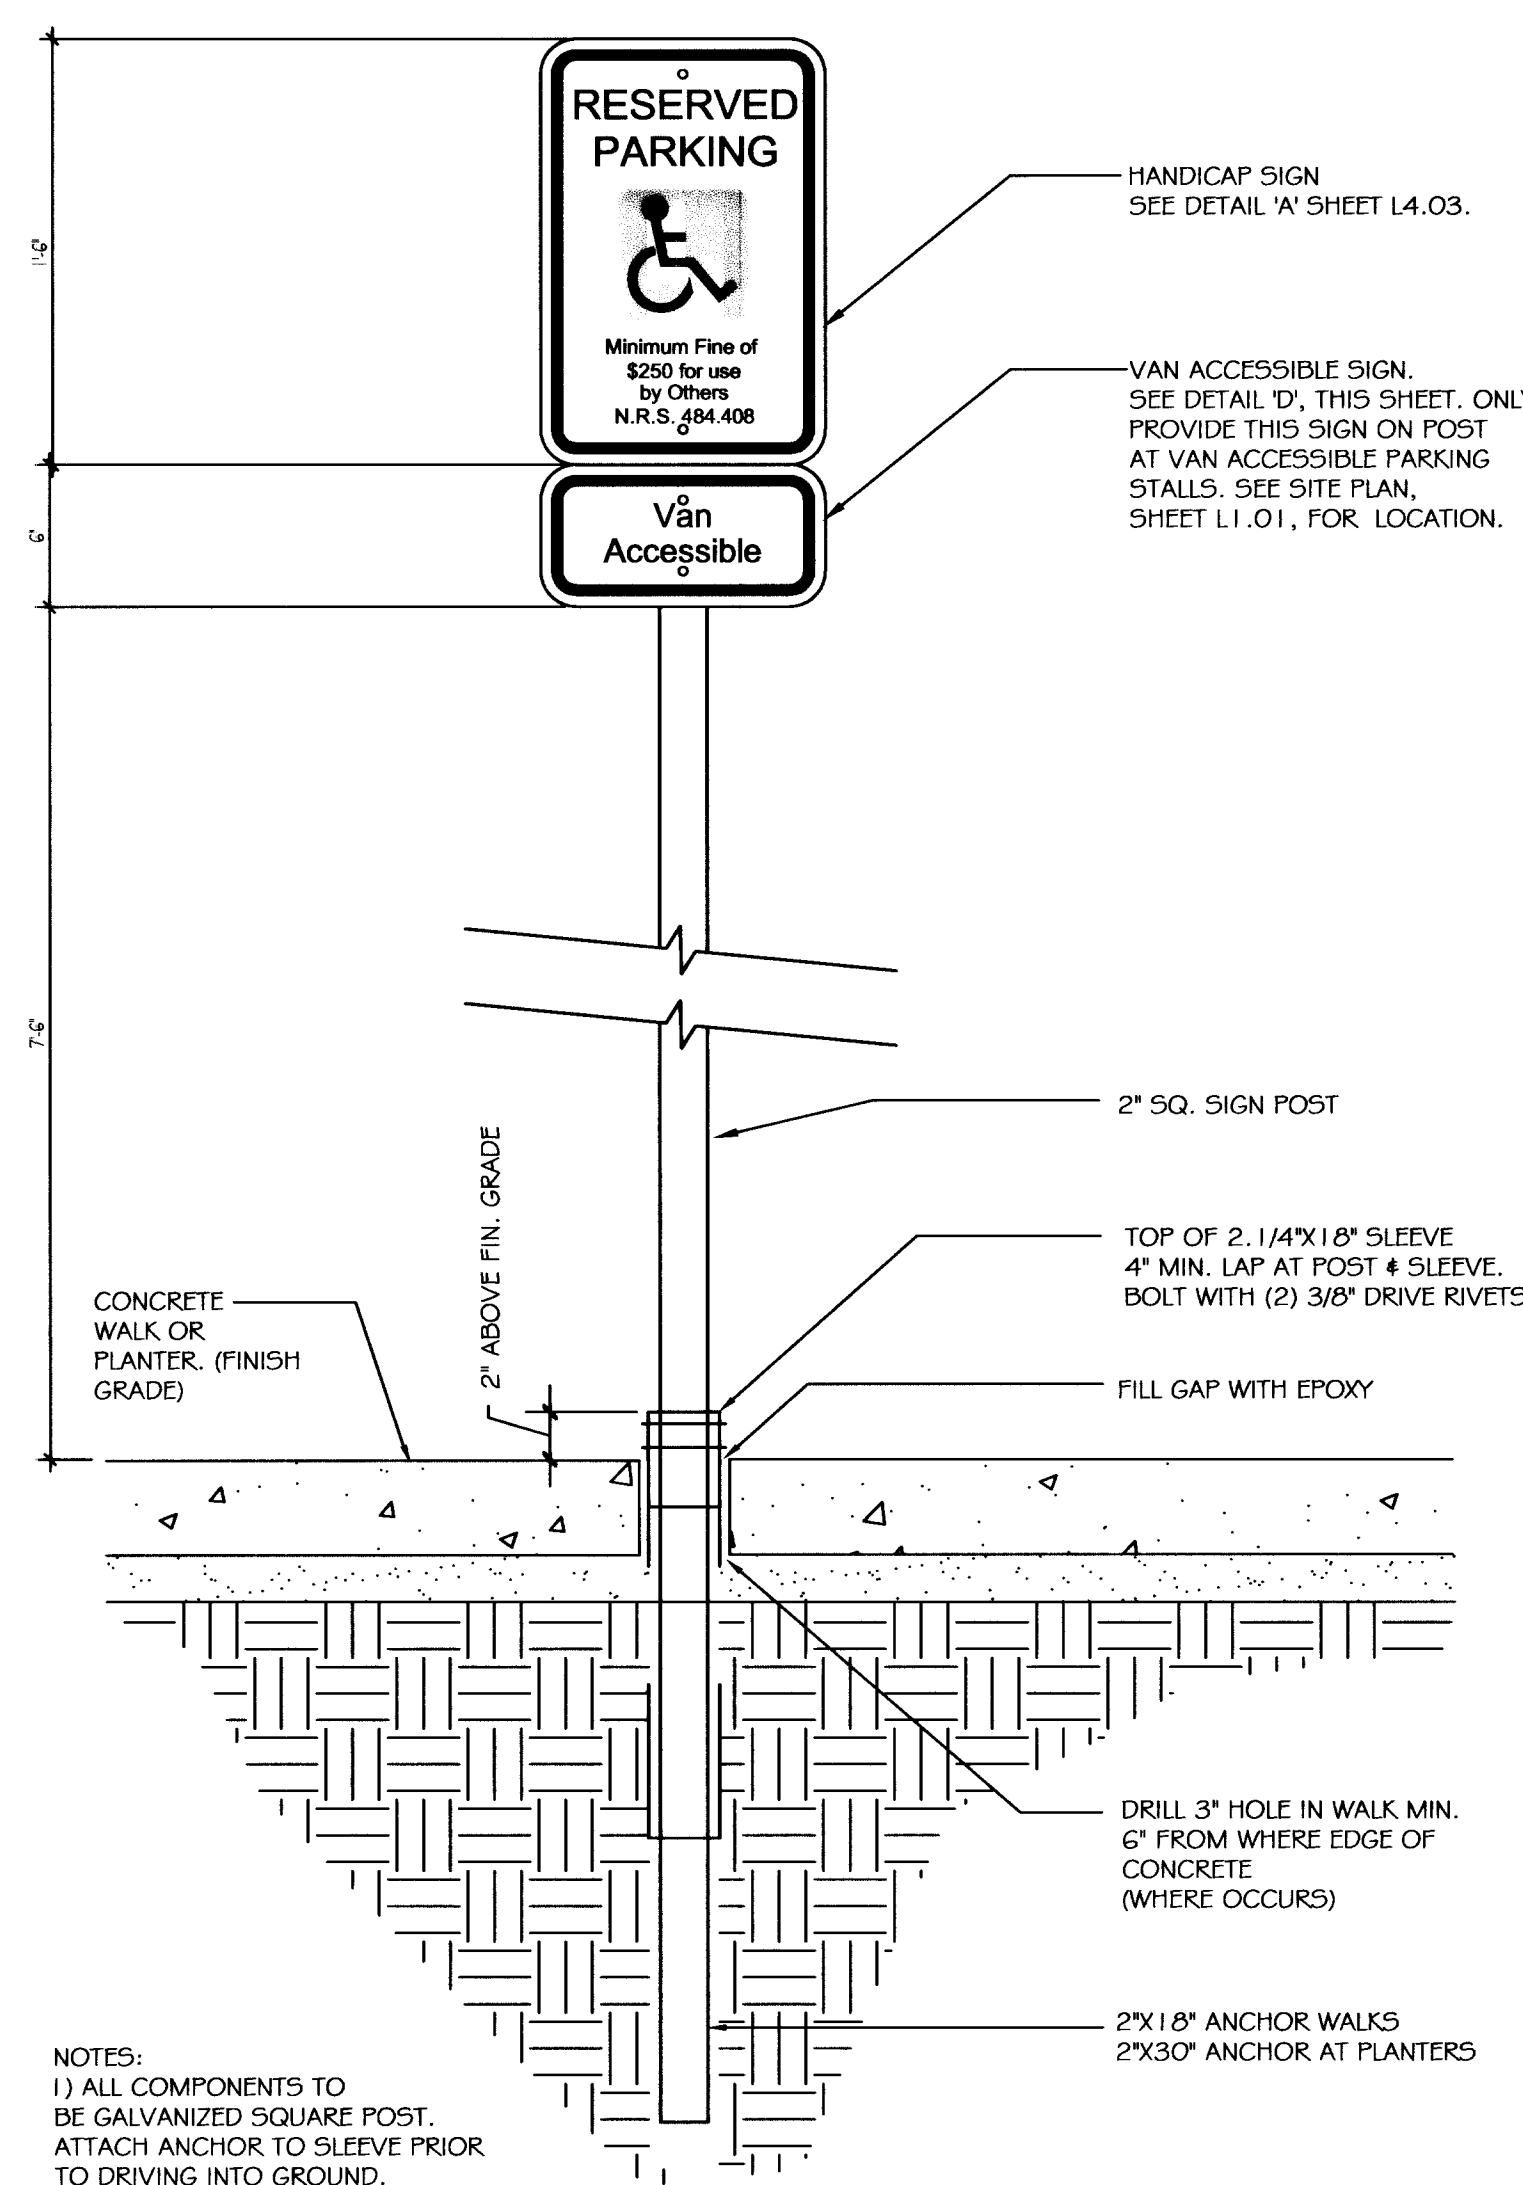

K HANDICAP PARKING SIGN WITH POST

REVISIONS
1 RECORD DWG 9/17/06

CONSULTANT
**SOUTHWICK
LANDSCAPE
ARCHITECTS**
12 Commerce Center Drive Suite D-44
Henderson, NV 89014
Phone: 702.597.9108 Fax: 702.597.3177

City of Las Vegas
Gilmore Cliff Shadows Trail Head
SITE DETAILS

OWNER: CITY OF LAS VEGAS
DEPARTMENT OF PUBLIC WORKS
ARCHITECTURAL SERVICES

400 EAST STEWART AVENUE
LAS VEGAS, NEVADA 89101
PHONE: (702) 229-6535
FAX: (702) 388-4846
TDD: (702) 386-9108

DRAWN: SEWCD
FILE: L04-093T
DATE: SEPTEMBER 2006
SCALE: AS SHOWN
BID NO: 061534111
CLV DWG NO: 65083

SHEET NO: **L4.02**