
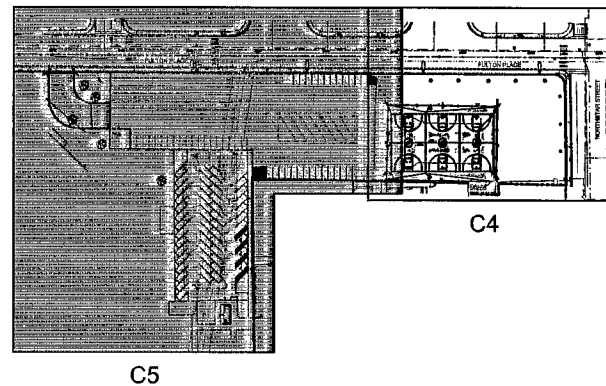
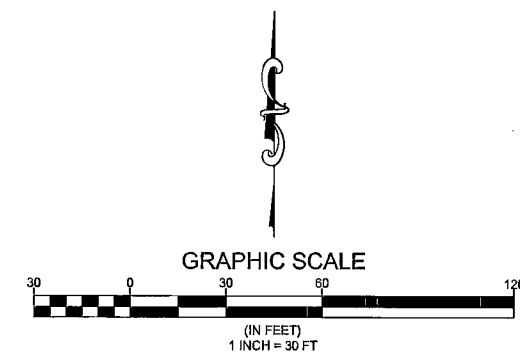


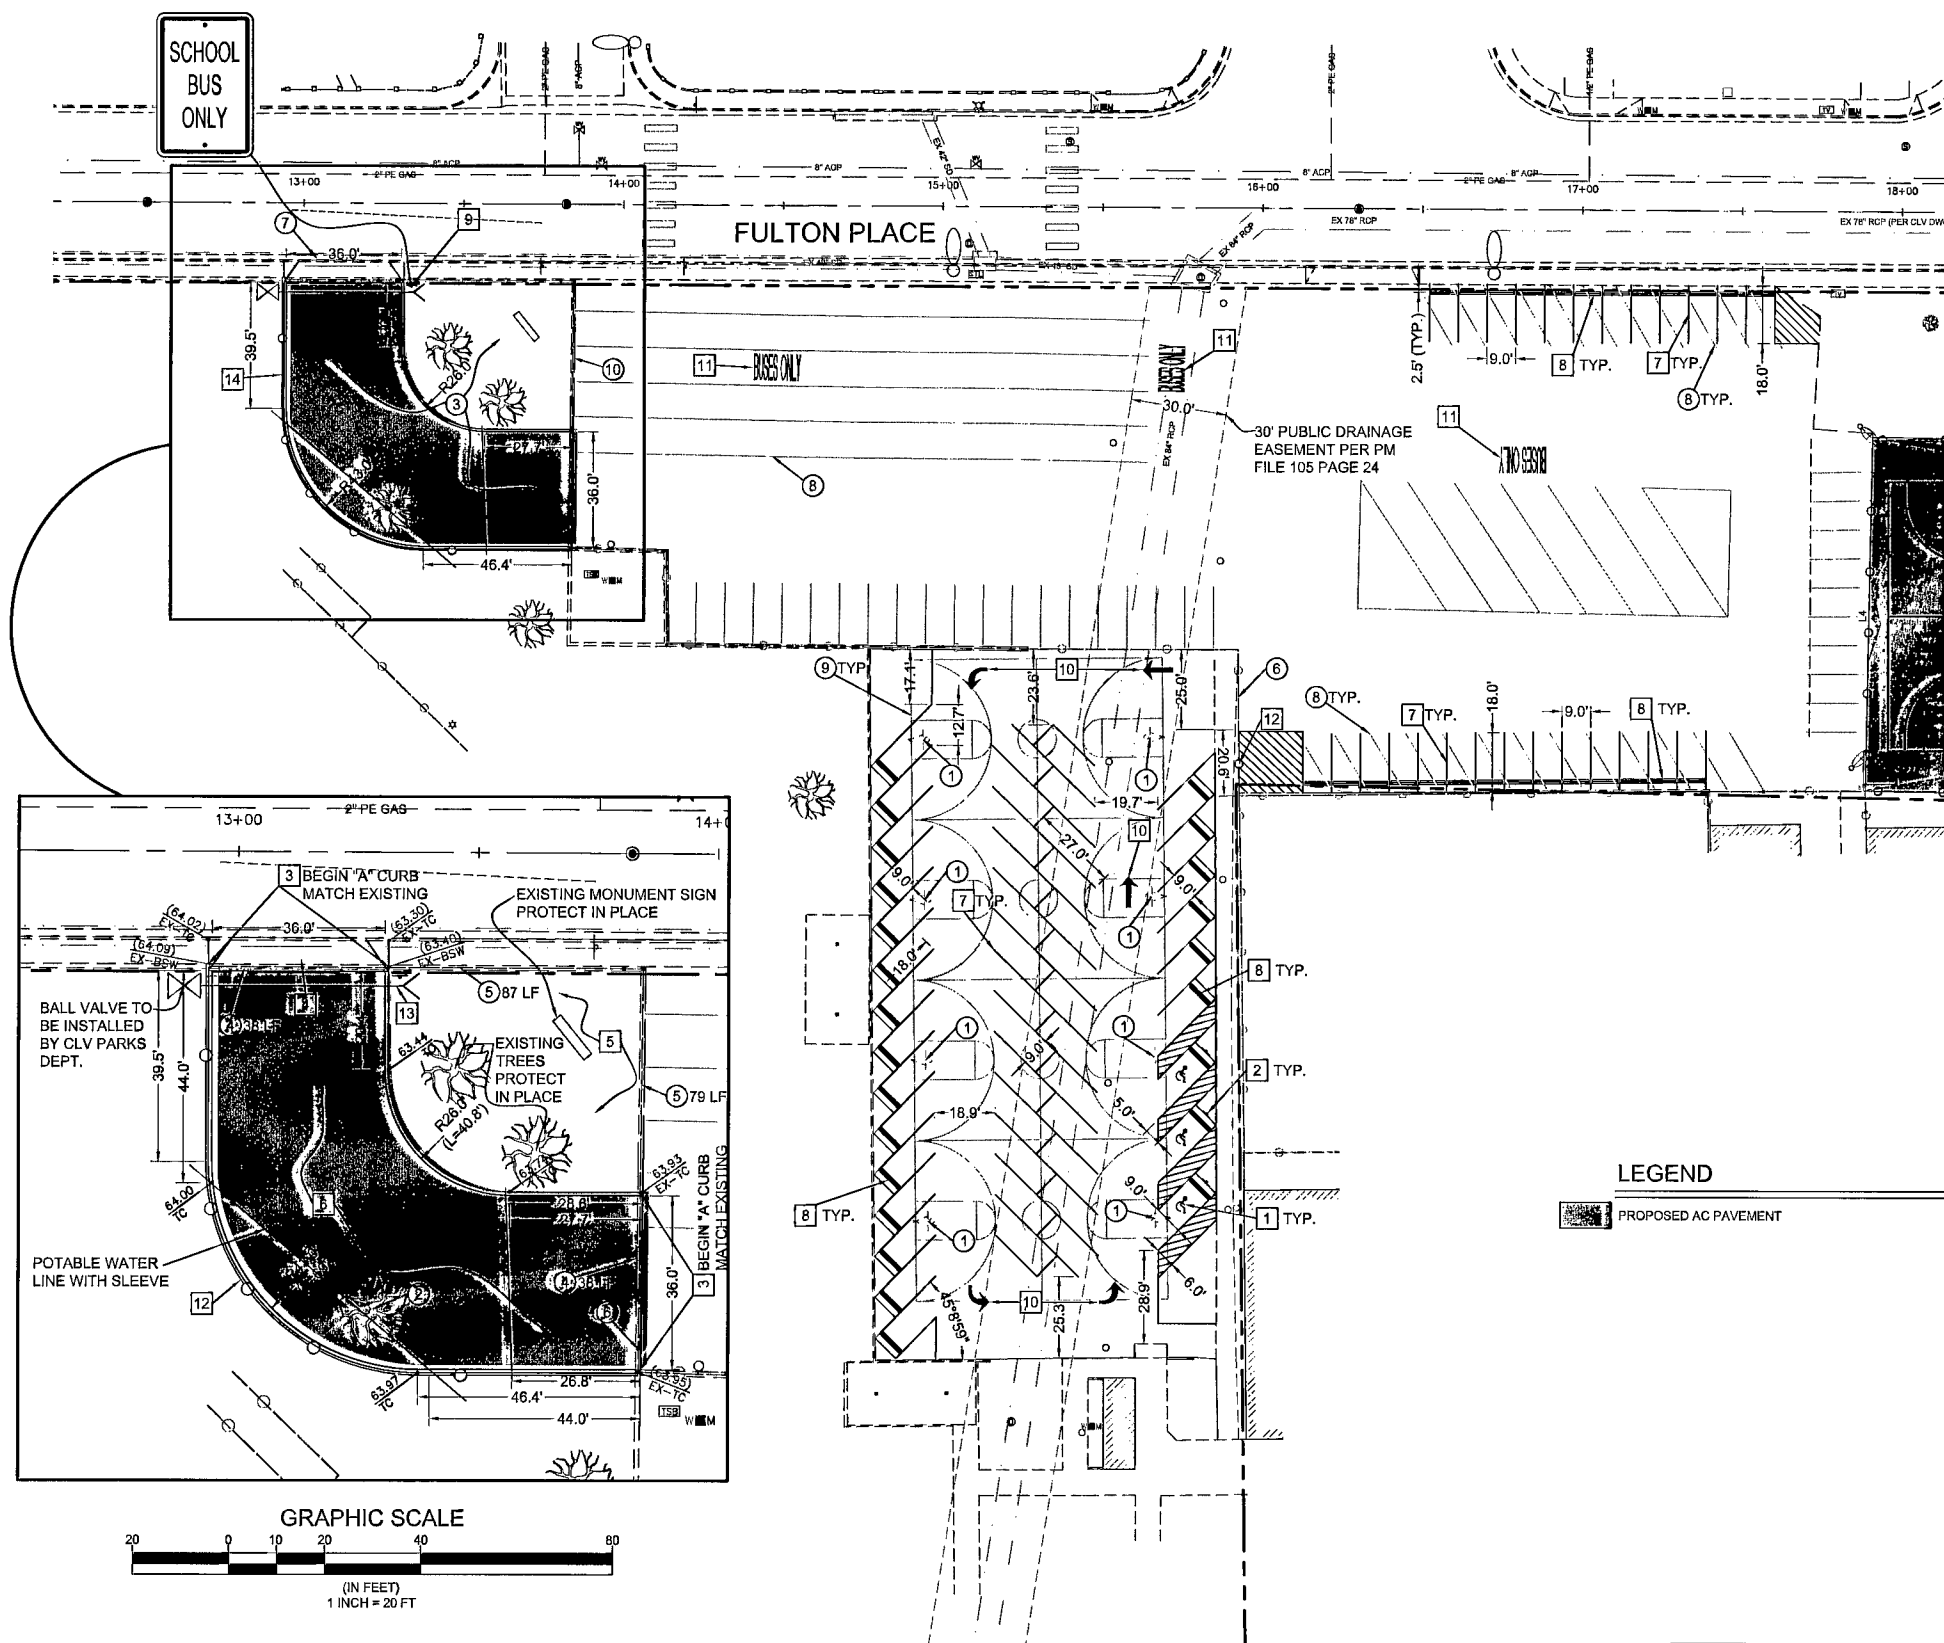

- ### CONSTRUCTION NOTES
1. INSTALL WHITE PAINT HANDICAP PAVEMENT MARKINGS.
 2. INSTALL HANDICAP SIGNS PER DETAIL 8 SHEET C8
 3. INSTALL "A" CURB PER USD DRAWING NO. 219
 4. INSTALL COMMERCIAL DRIVEWAY (OPTION A) PER USD NO. 224
 5. PLACE DECOMPOSED GRANITE
 6. CONSTRUCT AC PAVEMENT PER DETAIL 9 SHEET C8
 7. INSTALL 4" SOLID WHITE PAINT STRIPE
 8. INSTALL PRECAST BUMPER BLOCK PER USD NO. 238
 9. INSTALL "SCHOOL BUS ONLY" SIGN SEE DETAIL 7 SHEET C8
 10. INSTALL ARROWS PER MUTCD 3B-29
 11. INSTALL "BUSES ONLY" PAVEMENT MARKINGS PER MUTCD 3B-29
 12. INSTALL 6" CHAIN LINK FENCE PER USD NO. 252 AND ATTACH TO EXISTING FENCE
 13. INSTALL 2" SCHEDULE 40 SLEEVE
 14. REPLACE EXISTING SIGN (SEE REMOVAL NOTE 10 THIS SHEET)

- ### REMOVAL NOTES
1. REMOVE BASKETBALL POLES AND FOUNDATIONS - BACKFILL HOLES AND PATCH WITH A/C
 2. REMOVE TREE
 3. REMOVE LANDSCAPING
 4. REMOVE CHAIN LINK FENCE AND 12" CONCRETE BAND
 5. REMOVE CHAIN LINK FENCE
 6. REMOVE GATE
 7. REMOVE SIDEWALK AND "L" CURB
 8. REMOVE EXISTING STRIPING
 9. REMOVE EXISTING BASKETBALL COURT STRIPING
 10. REMOVE EXISTING SIGN

BASIS OF BEARING

CENTERLINE OF FULTON PLACE, BEARS N 89°46'33" W, BETWEEN VALLEY VIEW BLVD AND CRAGIN PARK DR, AS SHOWN ON A PARCEL MAP RECORDED IN FILE 105, PAGE 24 OF PARCEL MAPS, CLARK COUNTY, NEVADA RECORDS.

BENCHMARK

CLV BM 2LV0131S6B; RIVET & PLATE IN TOP OF CURB, SW CORNER OF FULTON PL AND VALLEY VIEW BLVD ELEV. 2144.84' (NAVD88)

DEPARTMENT OF PUBLIC WORKS ENGINEERING DESIGN SECTION		CITY ENGINEER: JORGE CERVANTES, P.E. PROJECT MANAGER: ROSA A. CORTES, P.E. DESIGNED BY: OFF DRAWN BY: OFF CHECKED BY: RAC	DATE: 3/24/08 NO. 1 DESCRIPTION: CLARIFICATIONS FOR ADDENDUM 1
HYDE PARK MIDDLE SCHOOL BASKETBALL COURTS		RESTRIPING PLAN	
TITLE: SHEET:		PROFESSIONAL ENGINEER - STATE OF NV ROSA A. CORTES Exp. 12-31-08 CIVIL No. 17505	
119405		Sheet C5 5 of 6 DRAWINGS NO. 715-2-1	

AS BUILT DRAWINGS

Call before you Dig

Call 811

1-800-237-2500

1-702-455-7500

SAFETY ALERT

Call before you Dig

227-2929

EVAN'S SERVICE CENTER