



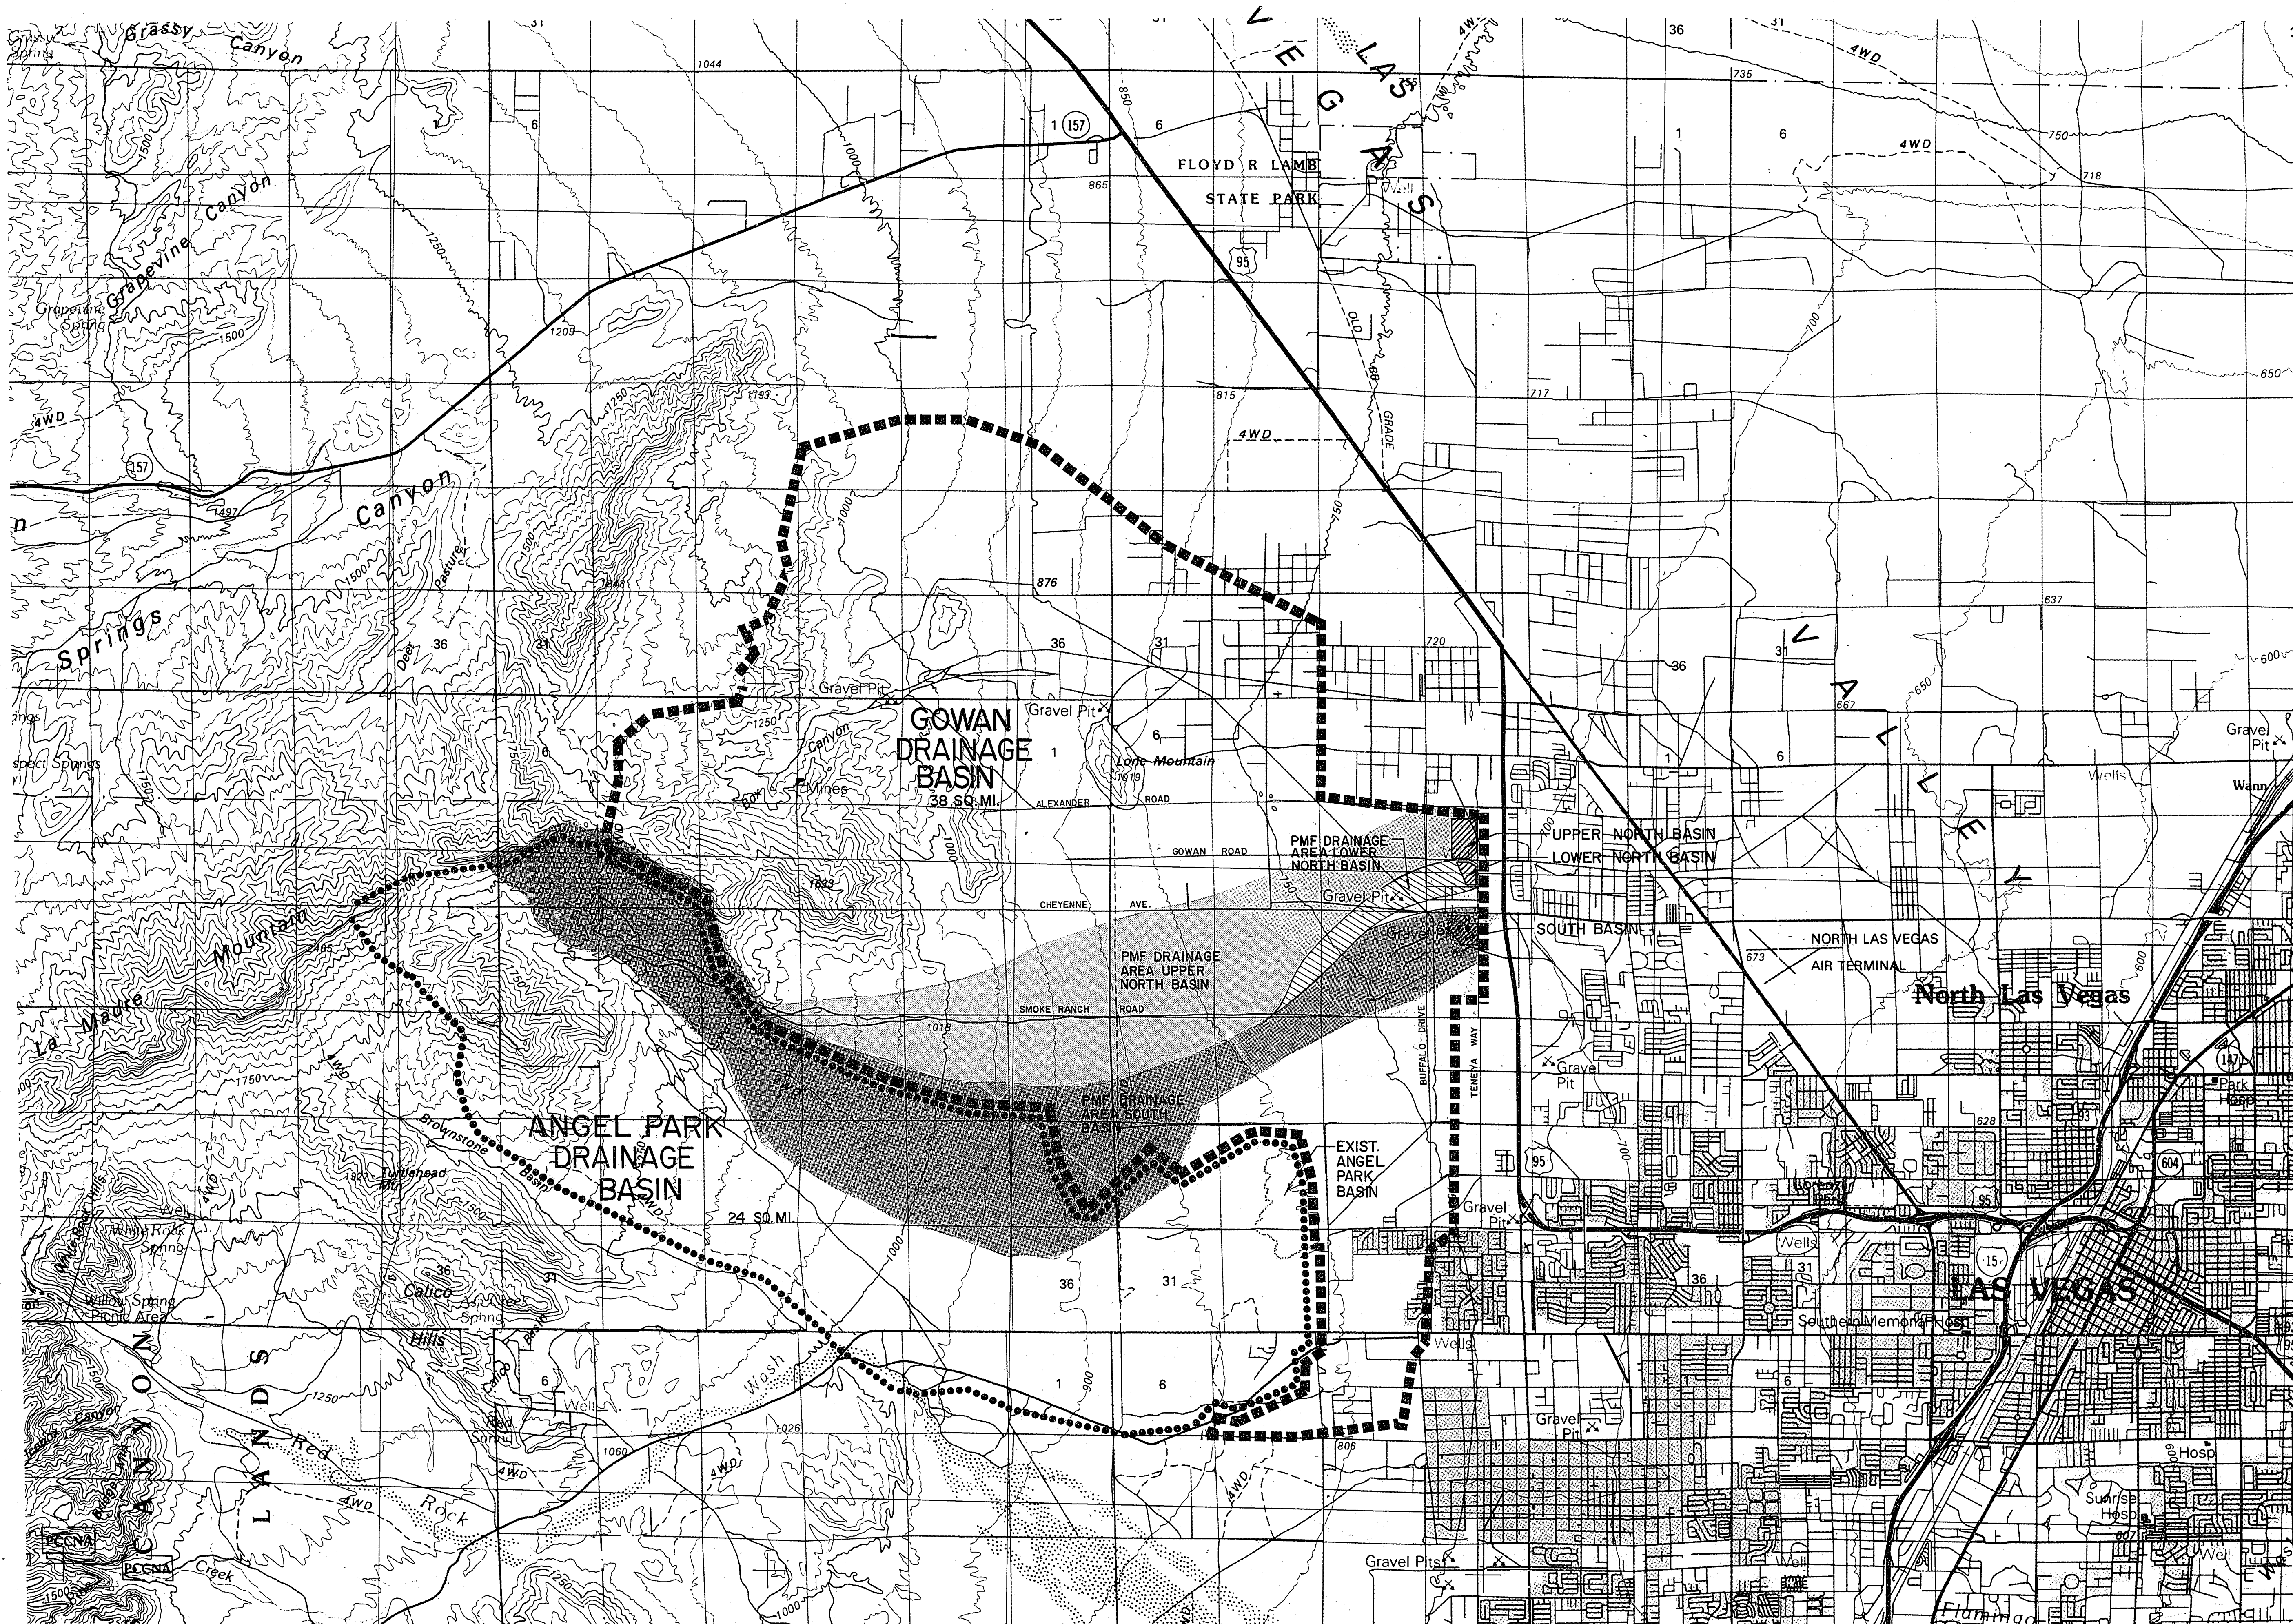

1" = 4000'

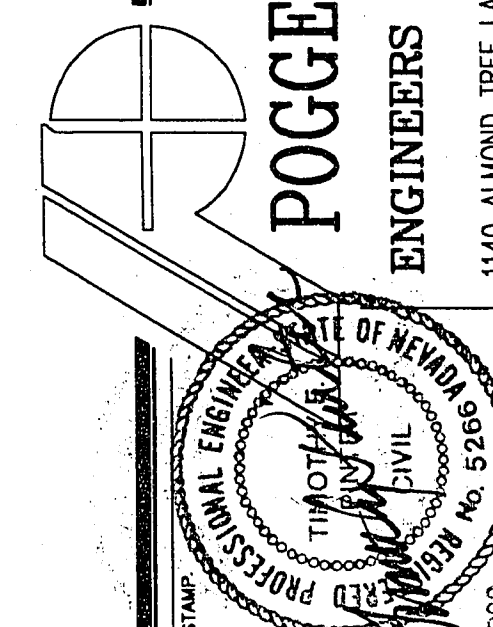

DRAINAGE BASIN MAP

GOWAN DETENTION BASINS

JOB NUMBER 90001
DESIGNED BY WH
DRAWN BY MB
CHECKED BY WH/TEP
DATE 1-17-92
SHEET NUMBER

CB-1
3 OF 80

POGGEMEYER DESIGN GROUP
ENGINEERS
PLANNERS
SURVEYORS
1140 ALMOND TREE LANE, SUITE 306 LAS VEGAS, NEVADA 89104 (702) 735-5108

ANY INFORMATION OR DATA ON THIS DRAWING IS NOT INTENDED TO BE SUITABLE FOR REUSE BY ANY PERSON, FIRM, CORPORATION, OR ANY REUSE WITHOUT WRITTEN VERIFICATION AND ADAPTATION BY THE ENGINEER FOR THE SPECIFIC PURPOSE. INTENDED WILL BE AT THE USER'S SOLE RISK AND WITHOUT LIABILITY OR LEGAL EXPOSURE TO THE ENGINEER.

DWG. NO. 731-53A

RECORD DRAWINGS