
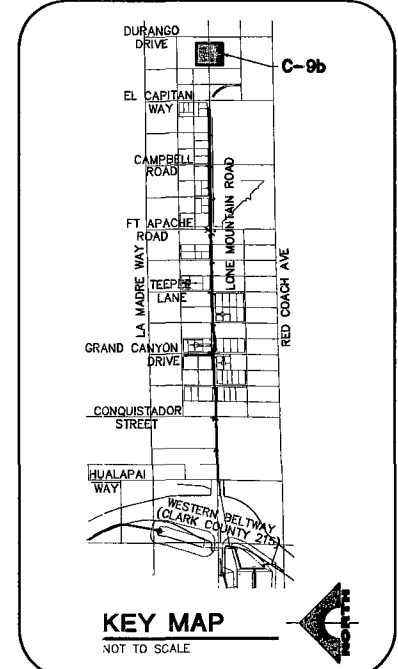


Note:
 Call Southwest Gas at
 365-2296 for Standby
 when excavating over or
 near High Pressure Gas lines.

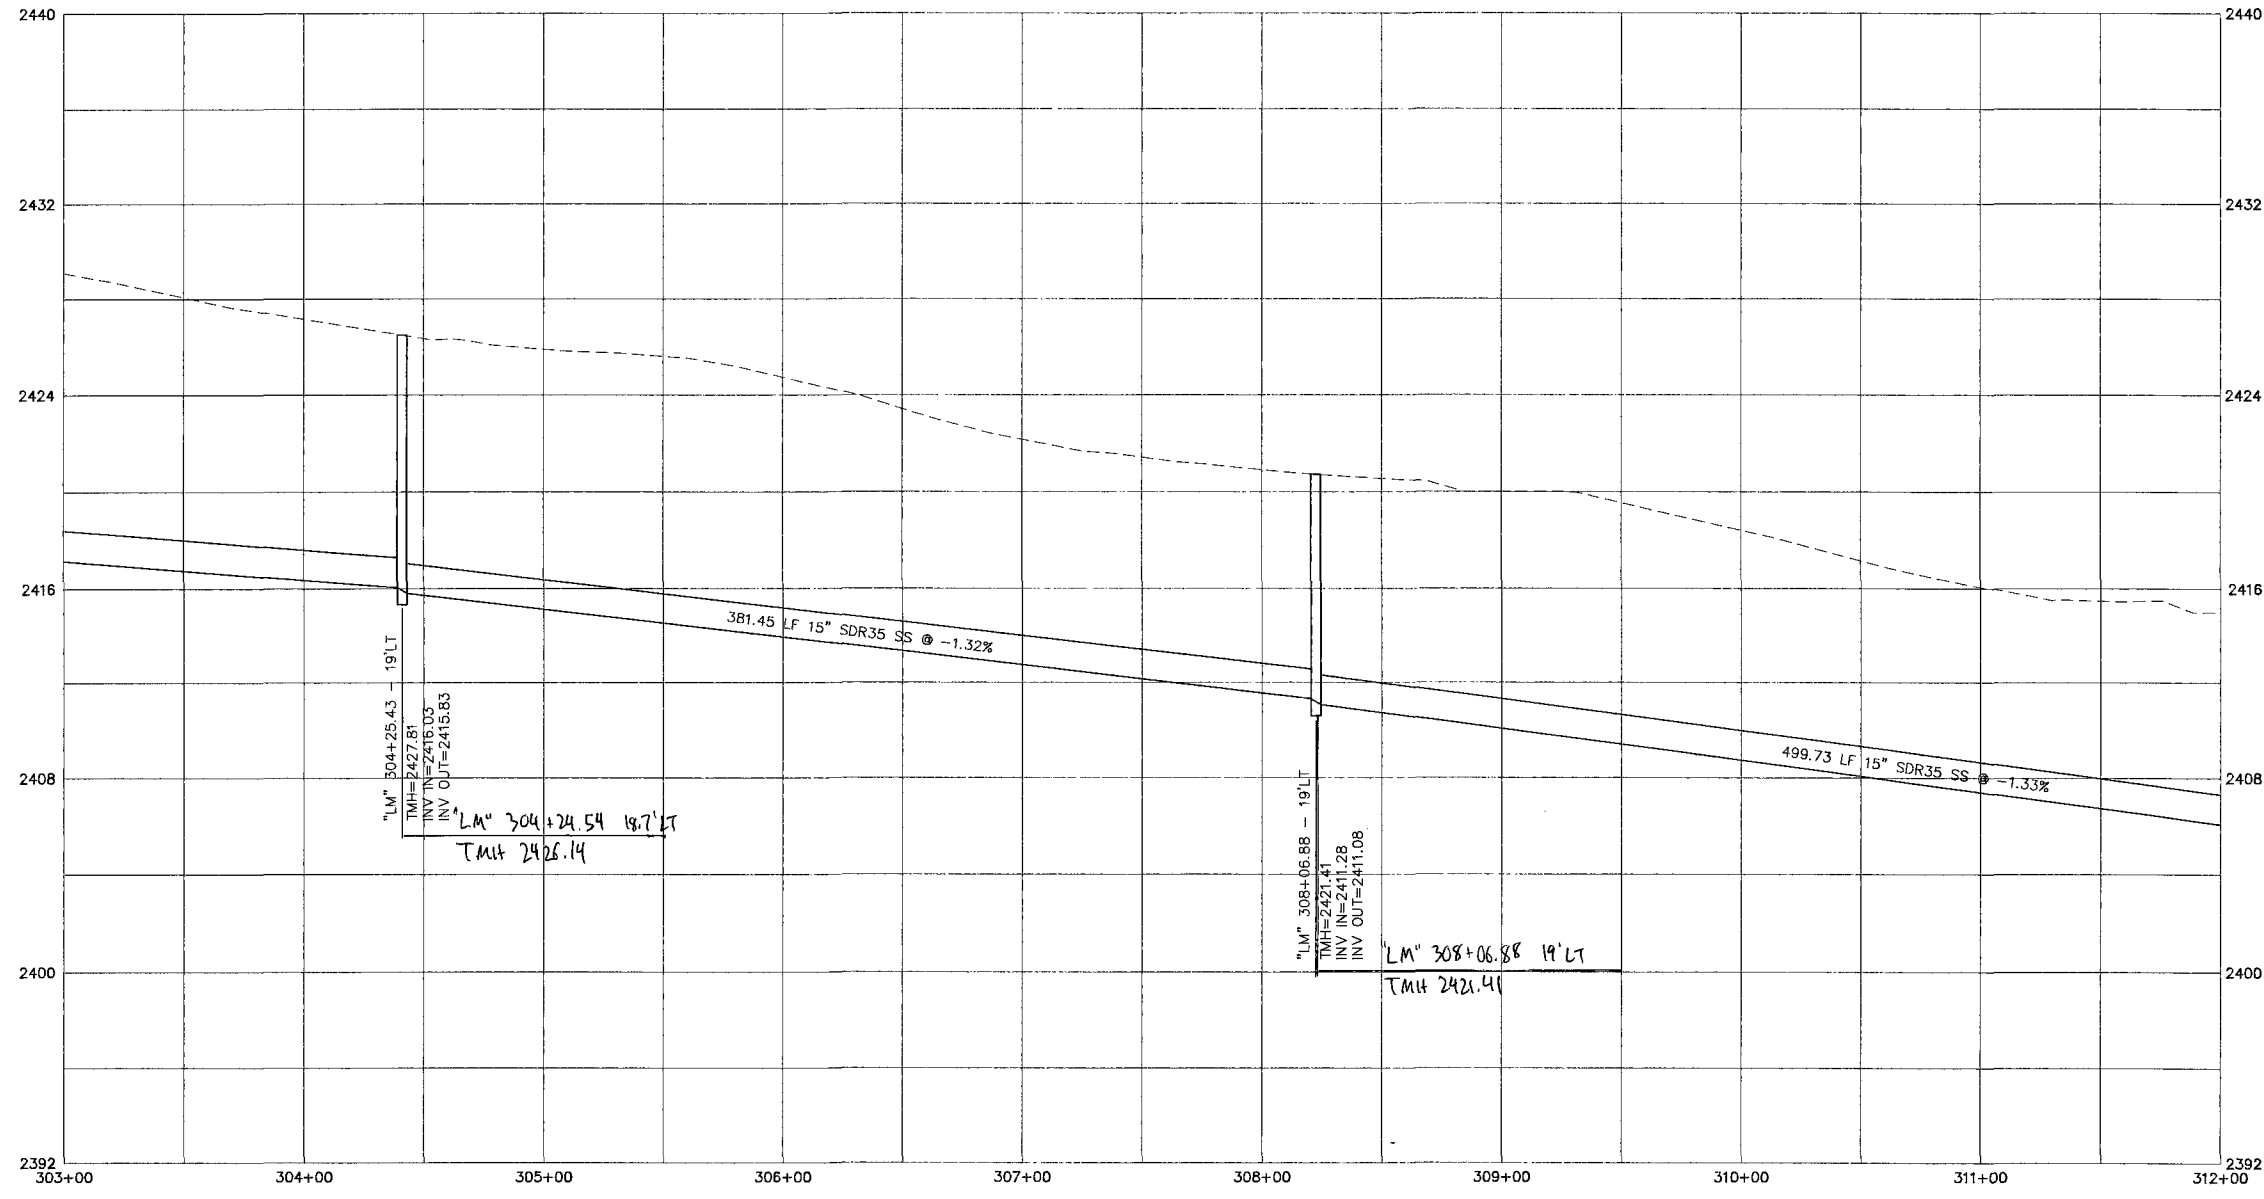

DISCLAIMER NOTE

UTILITY LOCATIONS SHOWN HEREON ARE APPROXIMATE ONLY. IT SHALL BE THE CONTRACTOR'S RESPONSIBILITY TO DETERMINE THE EXACT HORIZONTAL AND VERTICAL LOCATION OF ALL EXISTING UNDERGROUND AND OVERHEAD UTILITIES PRIOR TO COMMENCING CONSTRUCTION. NO REPRESENTATION IS MADE THAT ALL EXISTING UTILITIES ARE SHOWN HEREON. THE ENGINEER ASSUMES NO RESPONSIBILITY FOR UTILITIES NOT SHOWN OR UTILITIES NOT SHOWN IN THEIR PROPER LOCATION.

Avoid hitting underground utility lines. It's costly.
Call before you Dig.
 1-800-227-2600
 UNDERGROUND SERVICE (USA)

Avoid hitting overhead power lines. It's costly.
CALL BEFORE YOU DO OVERHEAD.
 1-702-227-2929

AS-BUILT	5-22				
REVISION	DATE	BY	DATE	BY	DATE

DEPARTMENT OF PUBLIC WORKS
 400 STEWART AVENUE
 LAS VEGAS, NEVADA, NV 89101
 (702) 223-8278

G. C. WALLACE, INC.
 Engineers/Planners/Surveyors
 TELEPHONE: (702) 864-2000 • FAX: (702) 864-2299



SHEET
15" SANITARY SEWER LINE
"LM" 303+00.00 TO "LM" 312+00.00
PHASE IV
 GOWAN NORTH CHANNEL

DRAWN BY: DVA	DESIGNED BY: CWL	CHECKED BY: MEH	PROJECT NO: 412.627	SCALE: 1" = 40' 1" = 4'
------------------	---------------------	--------------------	------------------------	-------------------------------

Professional Engineer Seal for William E. Hunter III, License No. 8533, State of Nevada, expires 06/30/2009.

SHEET
C-9b
 25 OF 45 SHEETS
 DRAWING NO.
 731-65C

F:\412-627\map\map\mproca\inc_c09b.dwg
 05-22-07 08:21:12 D:\pineson
 1016947

GOWAN NORTH CHANNEL - PHASE IV