
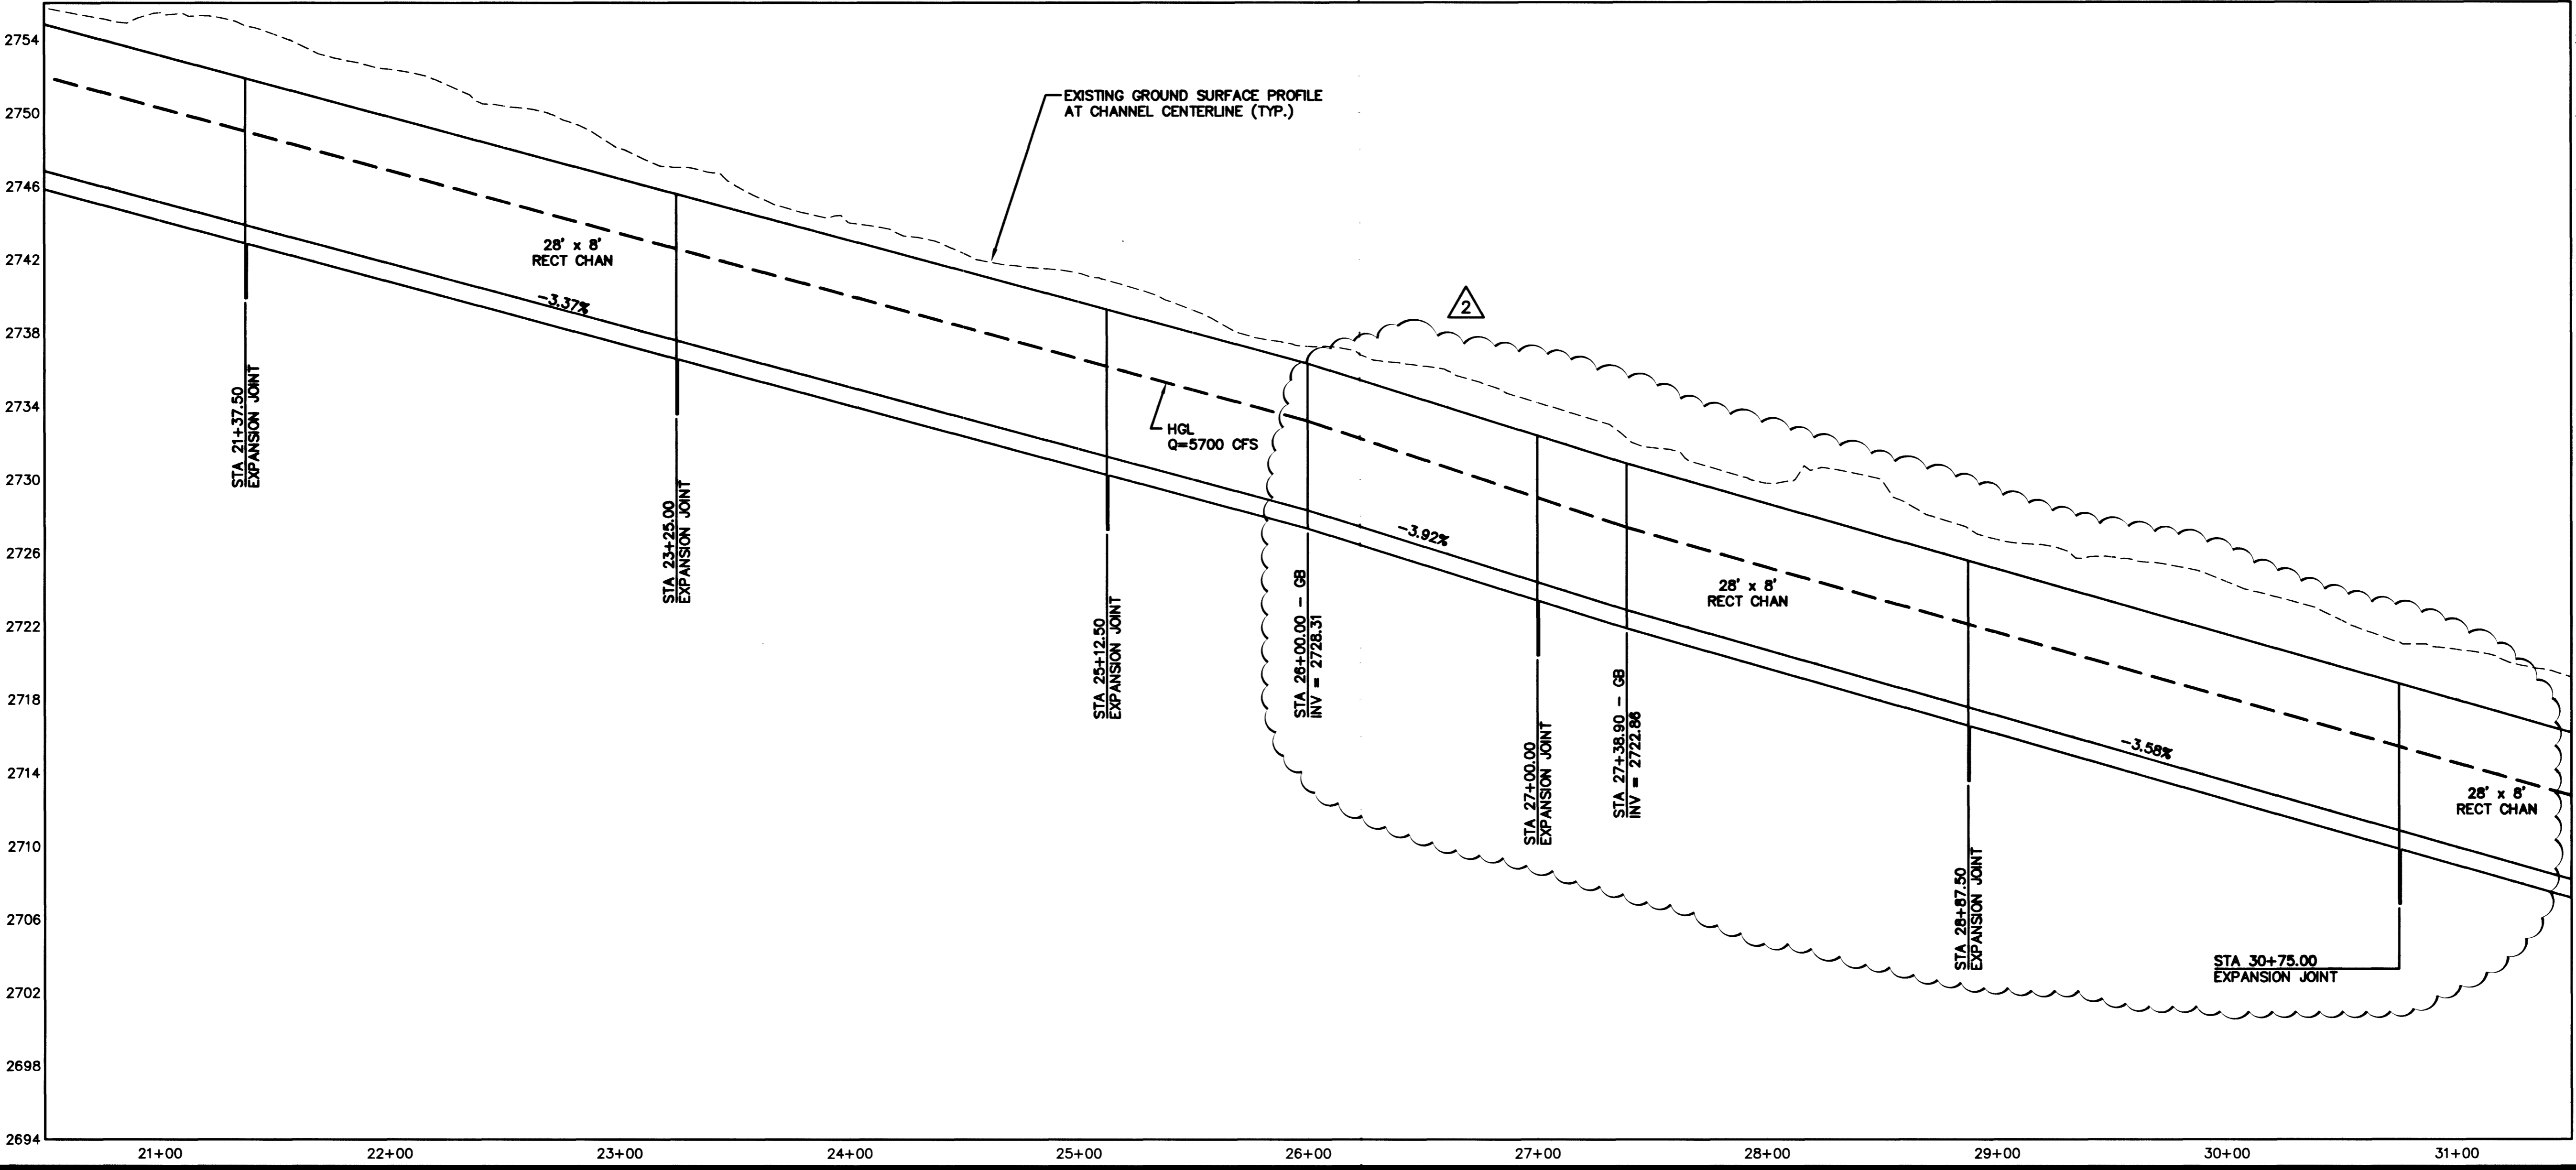


2720

NOTES:
1. REFER TO SHEET D1 FOR CHANNEL ACCESS LADDER LOCATIONS.
2. REFER TO SHEETS S1 THROUGH S9 FOR STRUCTURAL DETAILS.

MATCH LINE - SEE SHEET C2

MATCH LINE - SEE SHEET C4

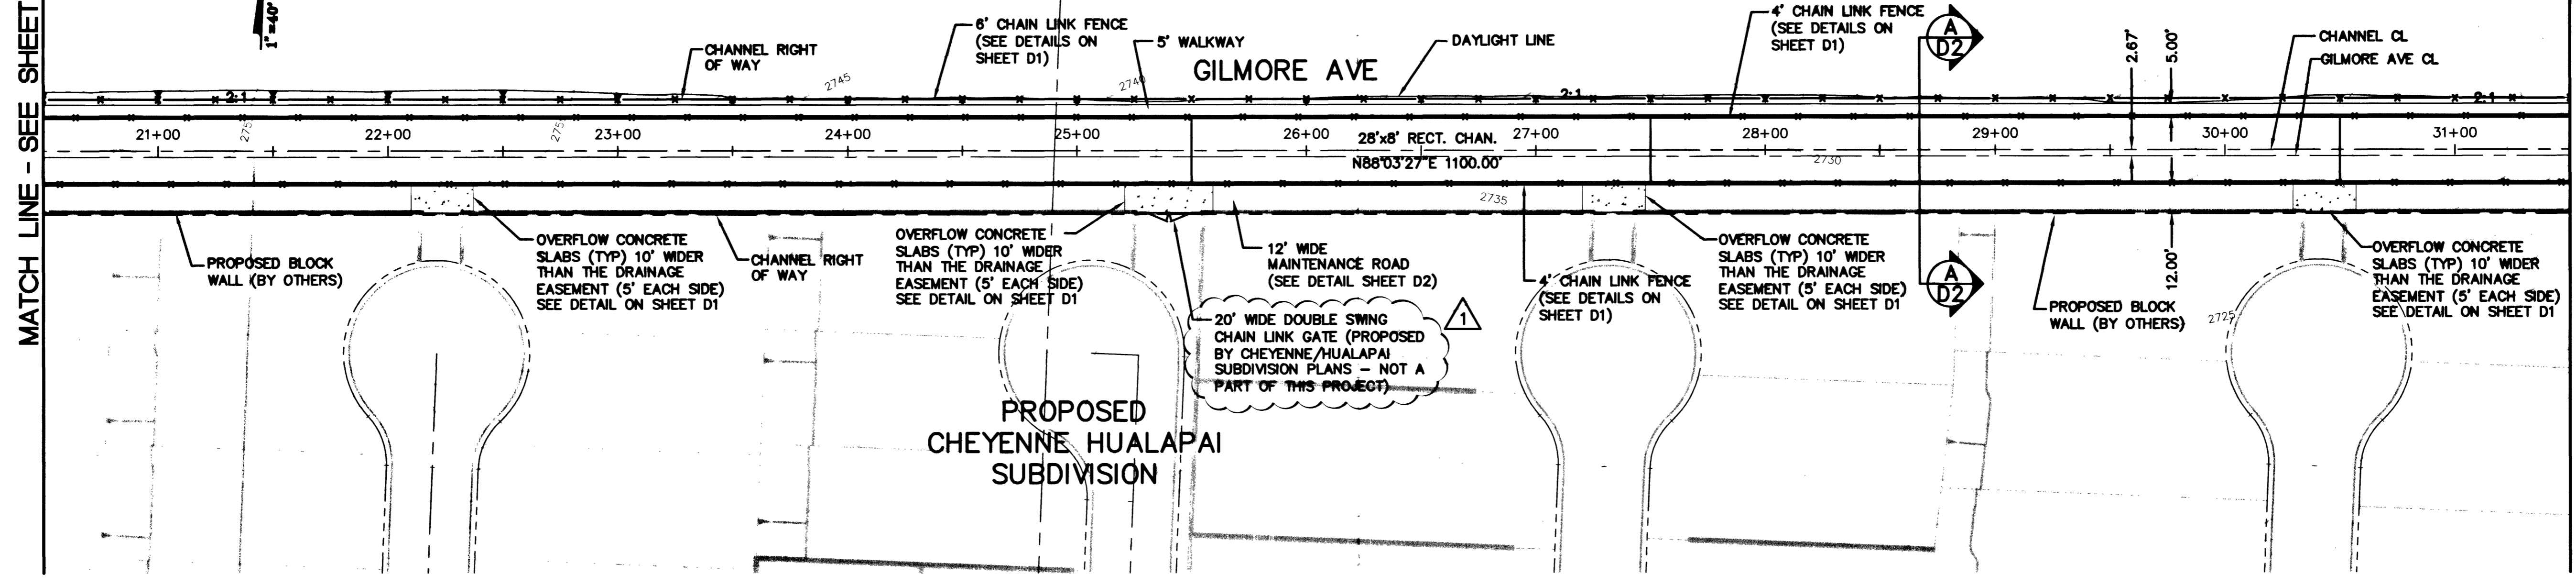

PERMA-BILT HOMES		2727 SOUTH RAINBOW BOULEVARD LAS VEGAS, NEVADA 89102-5148 PH. (702) 873-7550 FAX (702) 362-5997	
7150 POLLOCK DRIVE, SUITE 104 LAS VEGAS, NEVADA 89119 (702) 898-9100		vtm nevada CONSULTING ENGINEERS • PLANNERS • LAND SURVEYORS	
FLOOD CONTROL CHANNEL PLAN AND PROFILE STA. 20+60 TO STA. 34+50		GILMORE CHANNEL FLOOD CONTROL IMPROVEMENTS	
DRAWN BY: DAB/BKP	DESIGNED BY: 12/10/99	CHECKED BY:	SCALE: 1"=40' HORIZ. 1"=5' VERT.
4/20/01			
PROJECT NO: 5893		SHEET C3 7 OF 22 SHEETS	
DRAWING NO. 731-74		DANIEL W. BENDER CIVIL No. 12806	

Avoid cutting underground utility lines. It's costly.
2 working days
Call before you Dig
1-800-227-2600
Underground Service Alert (U.S.A.)
42427

RECORD DRAWINGS INFORMATION SUPPLIED BY CONTRACTOR - MAY 2002