



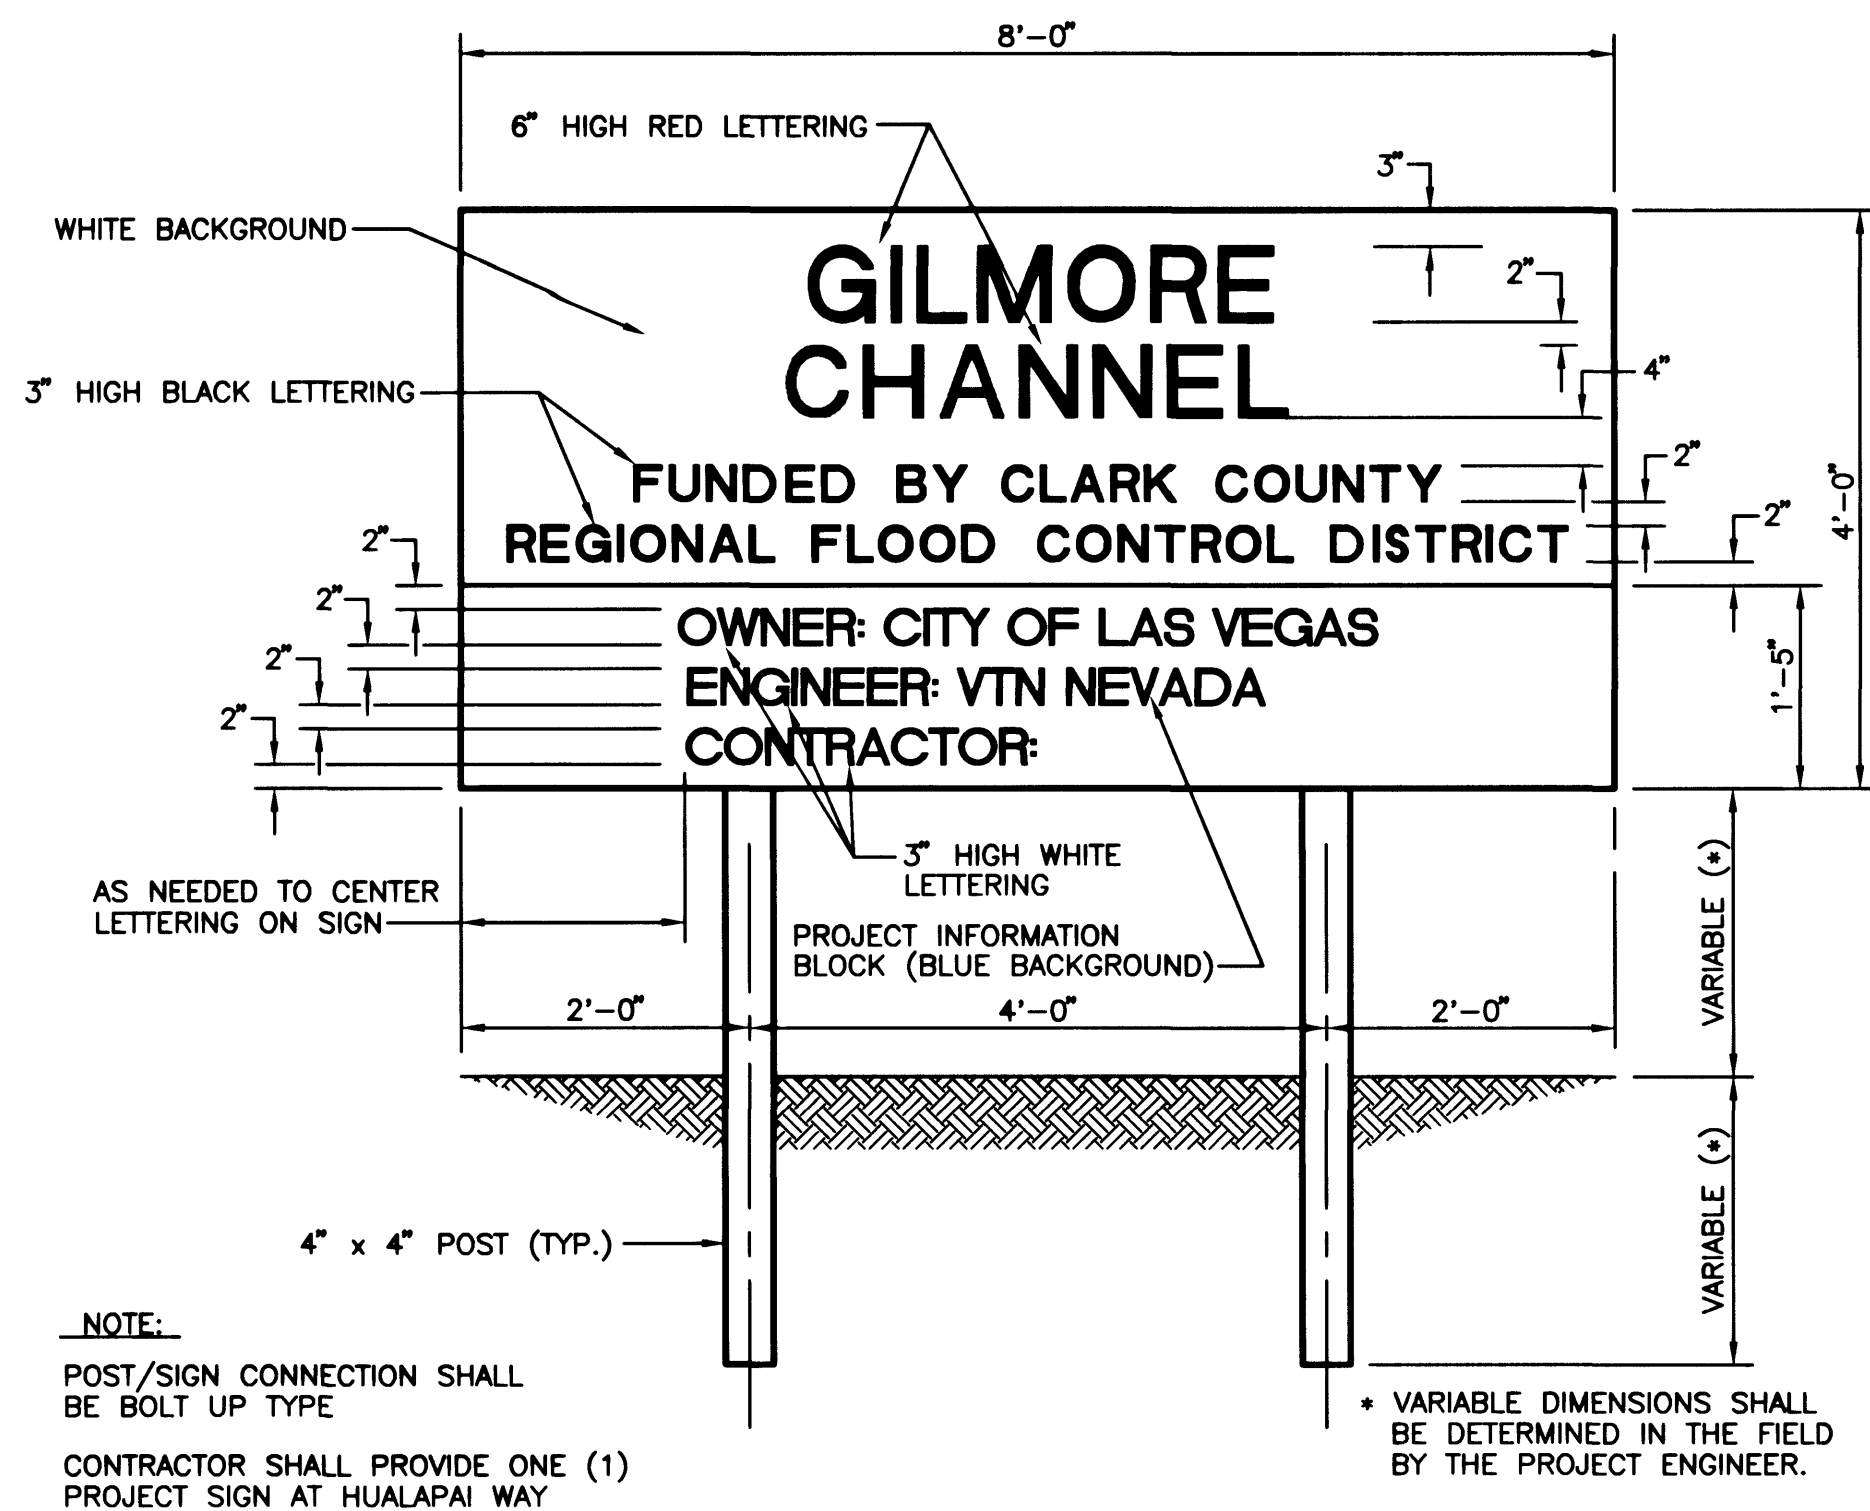


TYPICAL PROJECT SIGN FOR REGIONAL FLOOD CONTROL DISTRICT PROJECTS
SCALE: 1/2" = 1'-0"

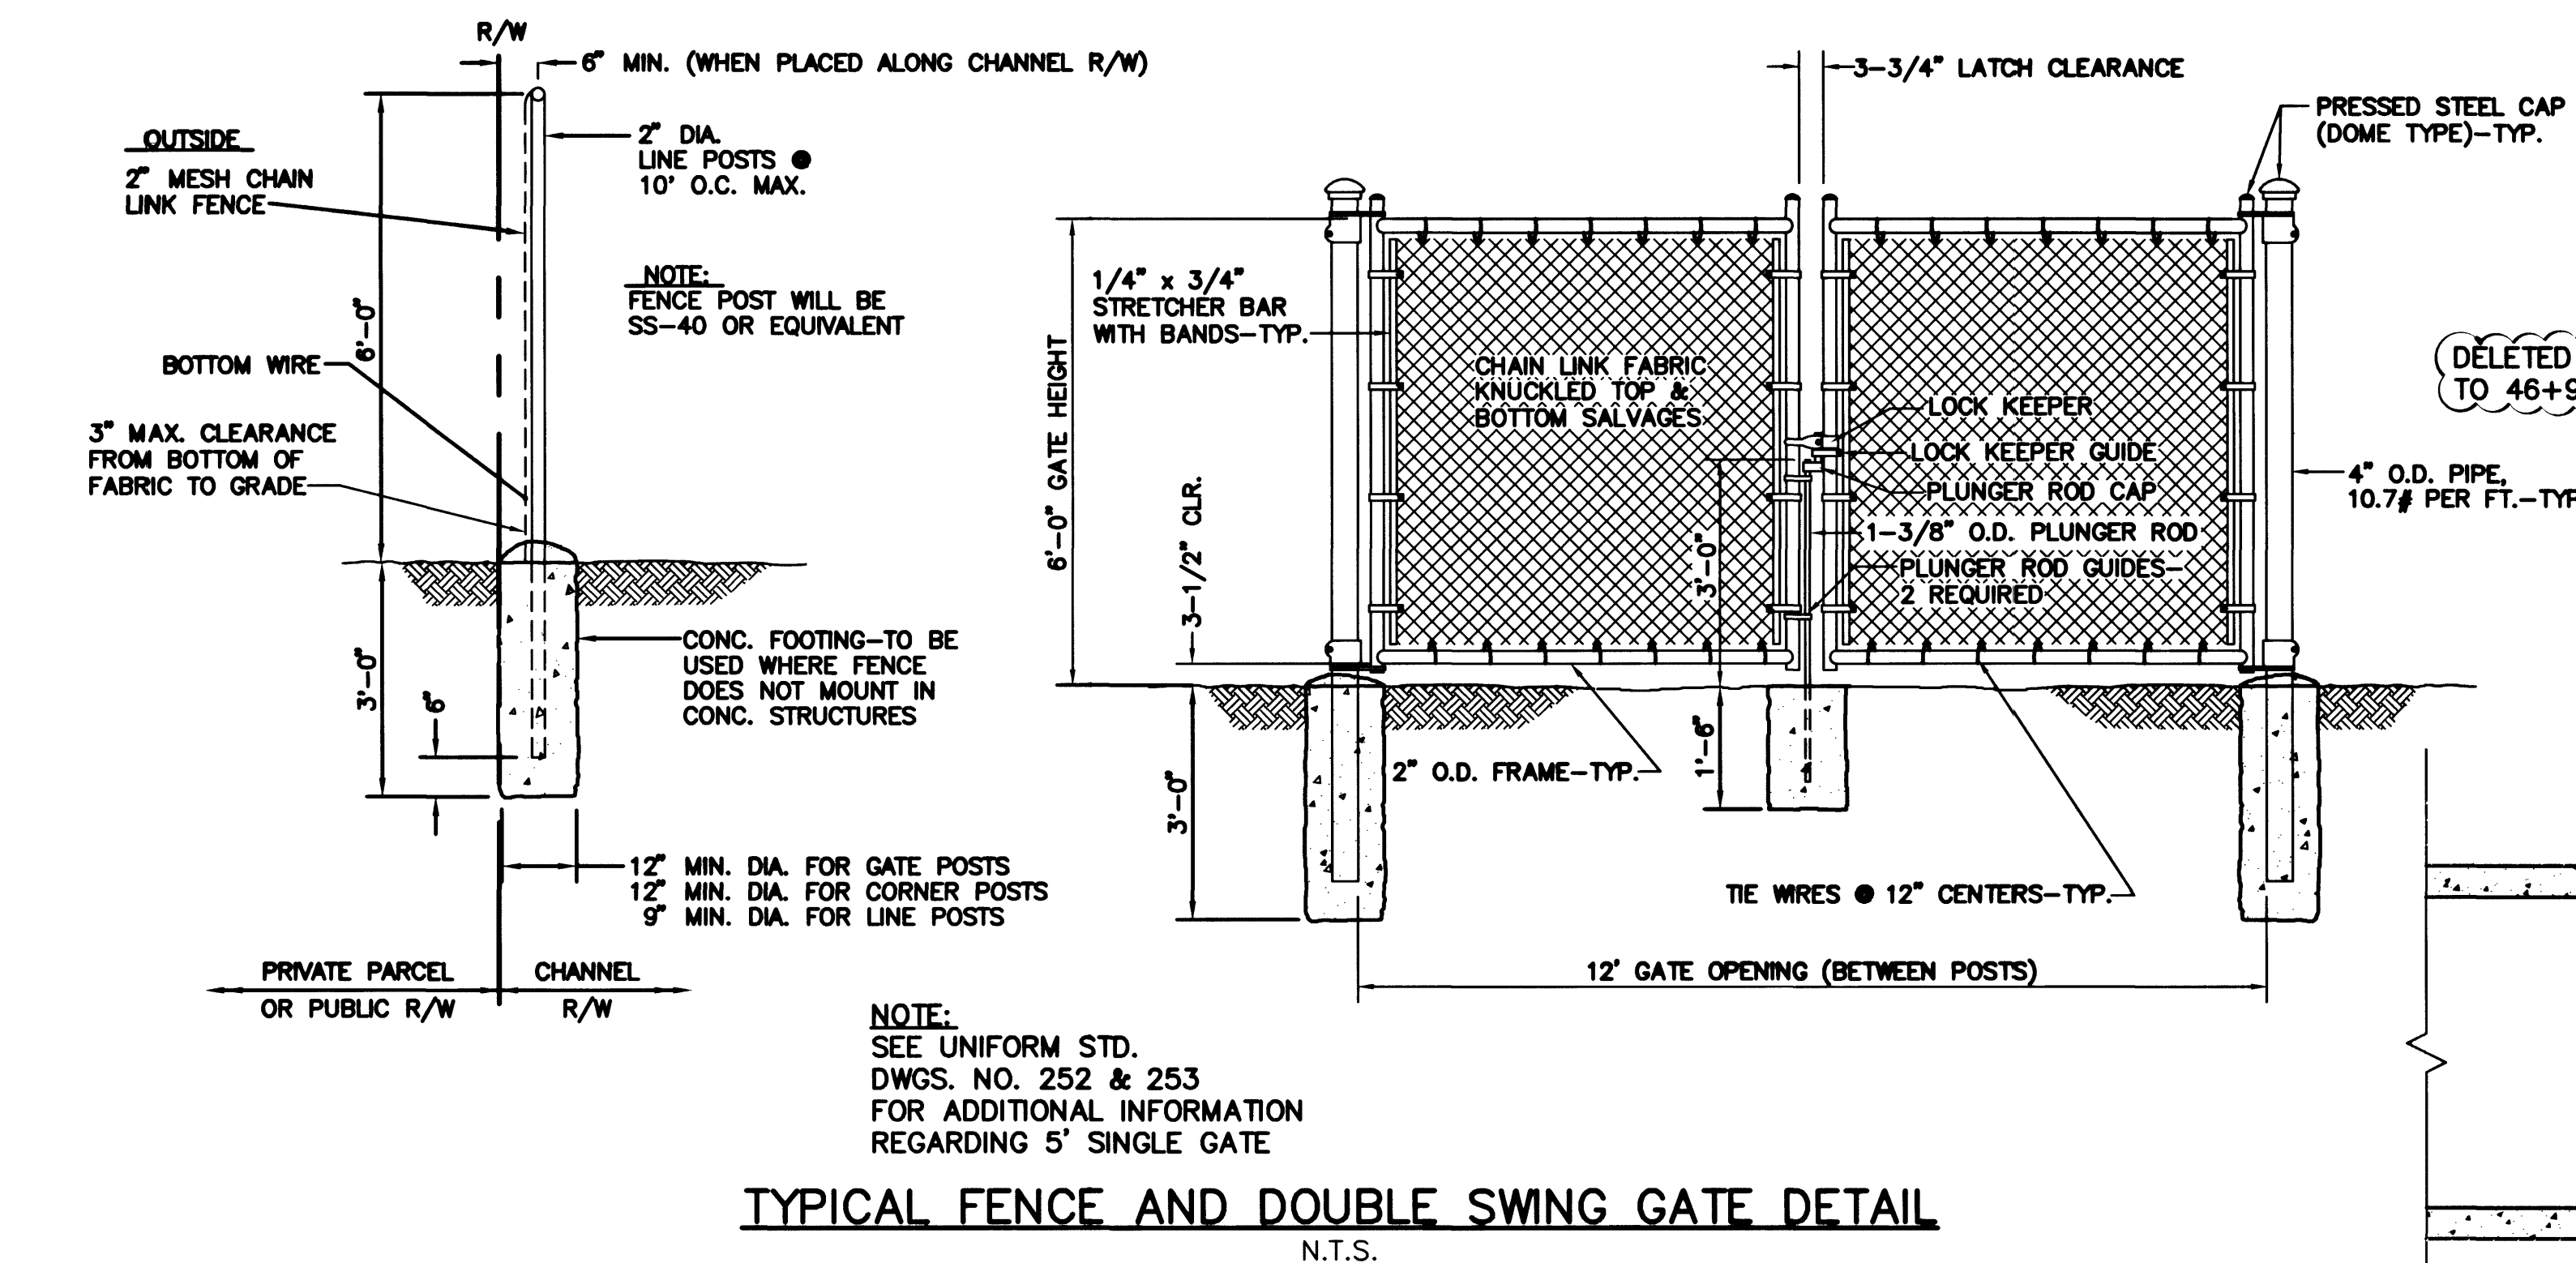


TYPICAL FENCE AND DOUBLE SWING GATE DETAIL
N.T.S.


TYPE I RIPRAP GRADATION	
d15	9"
d50	18"
d85	24"

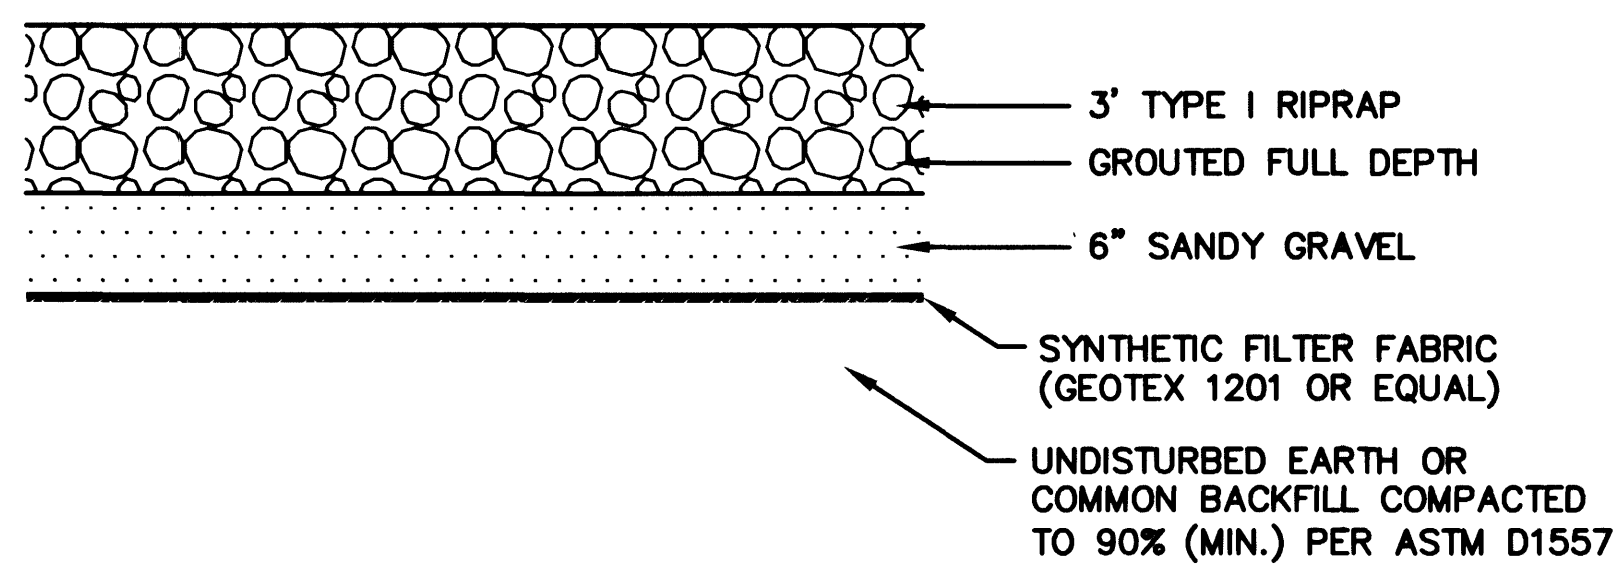



RIPRAP DETAIL
N.T.S.

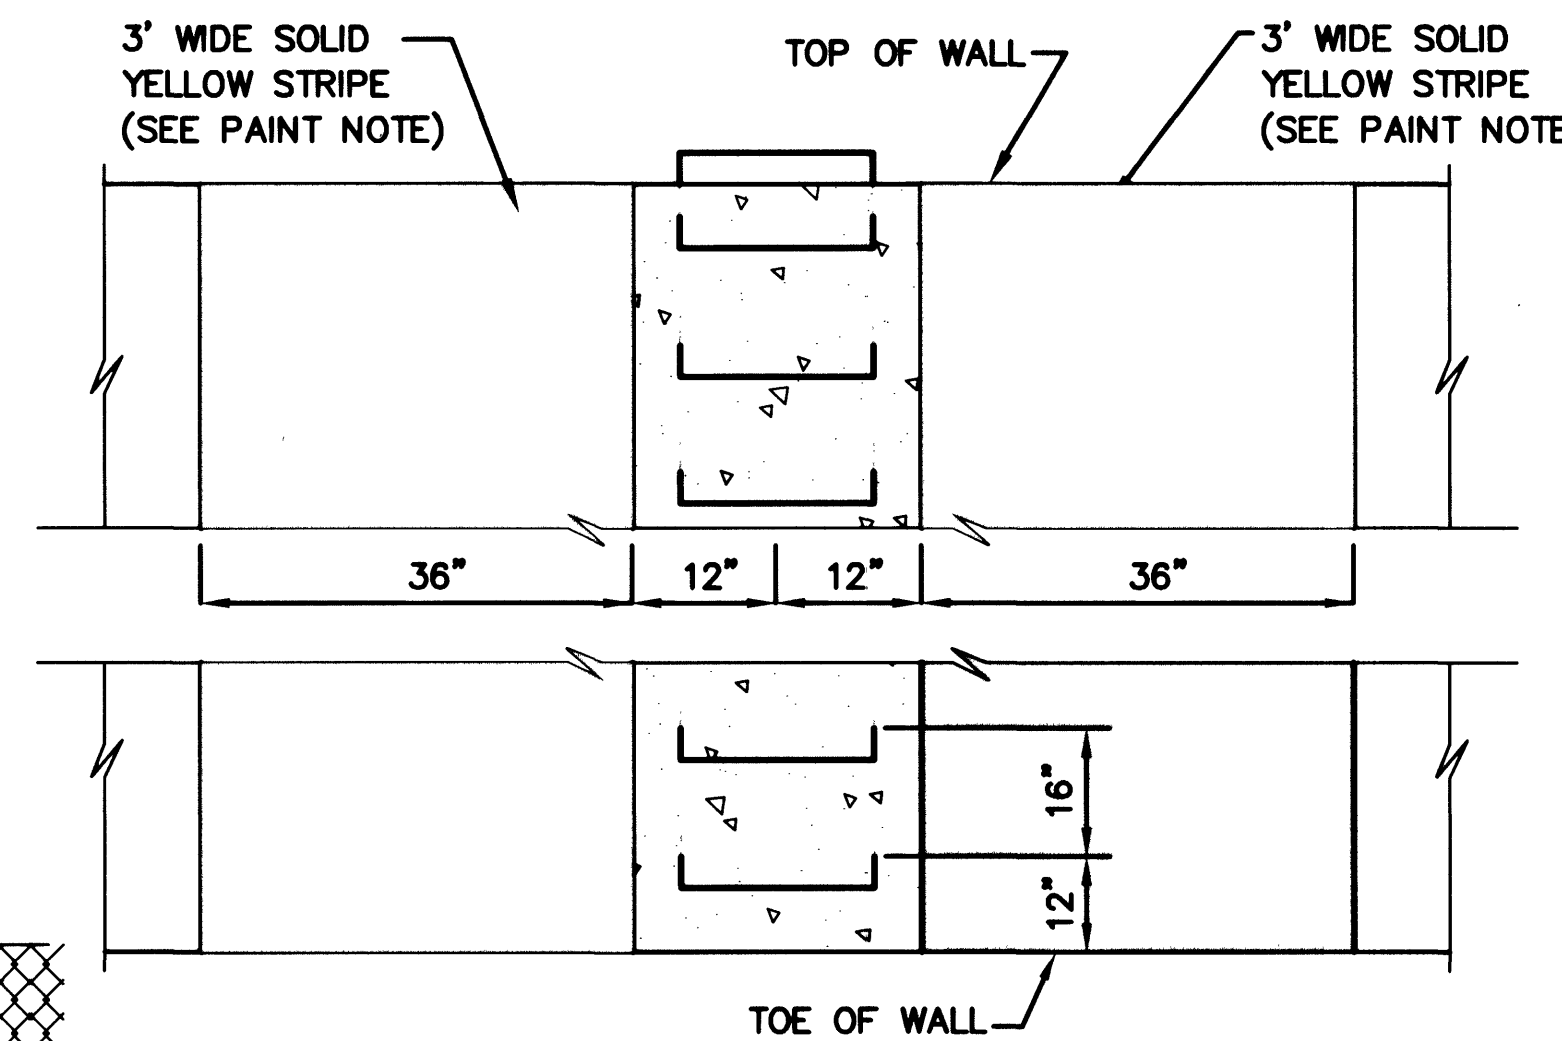


CHANNEL LADDER ELEVATION VIEW

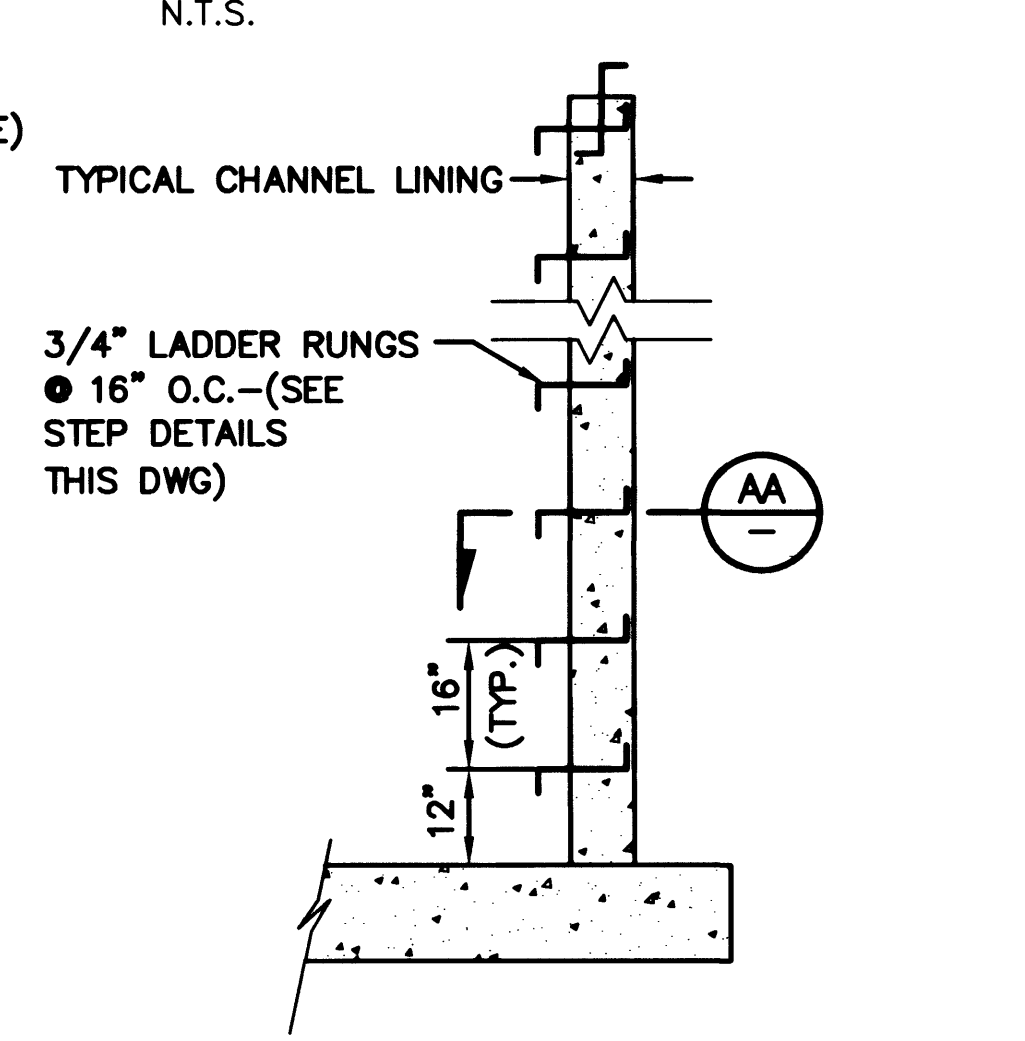

VERTICAL CHANNEL LADDER SECTION

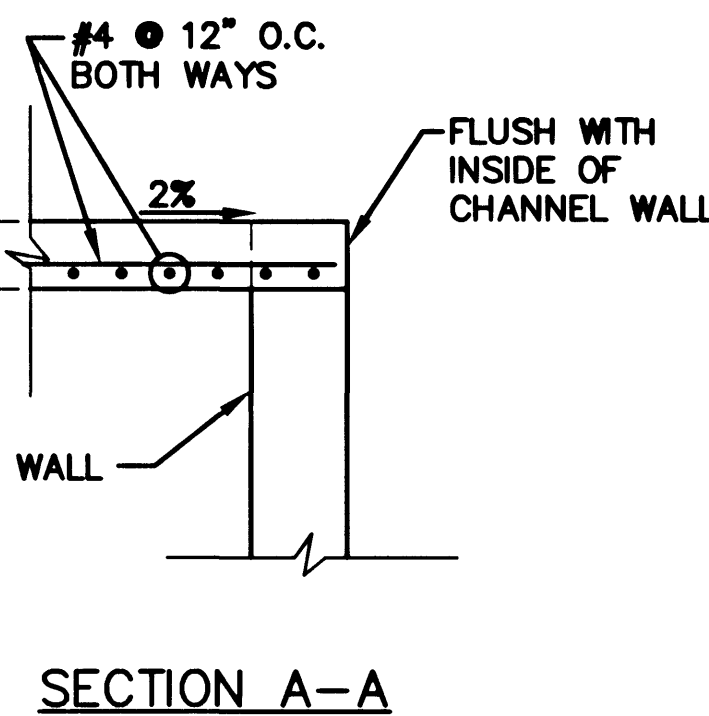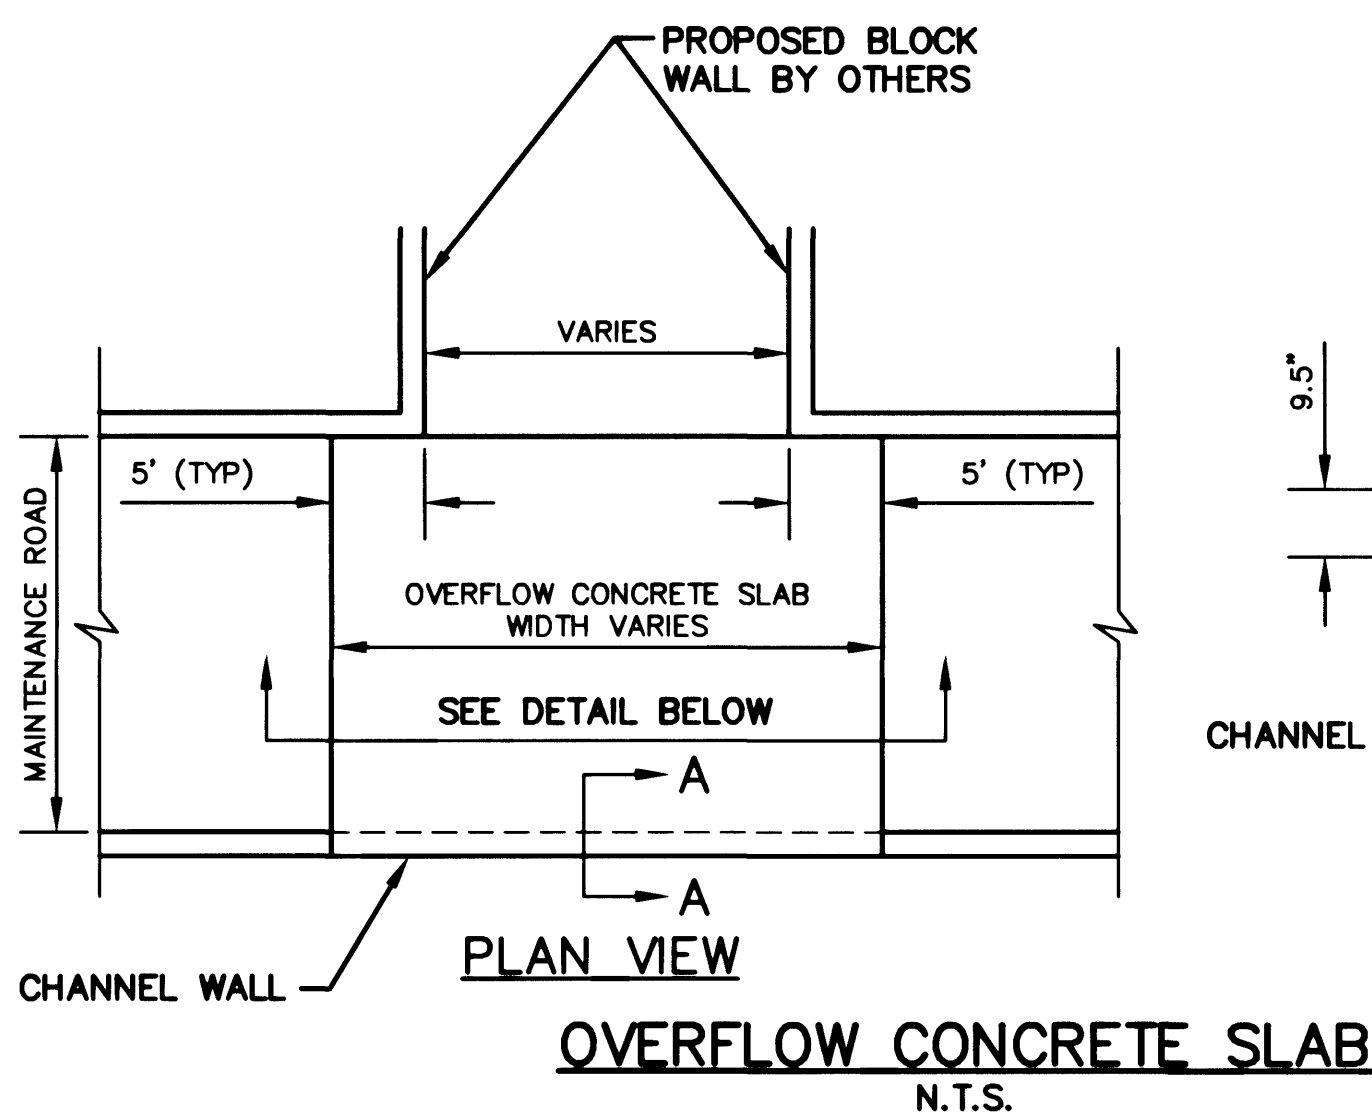


SECTION A-A

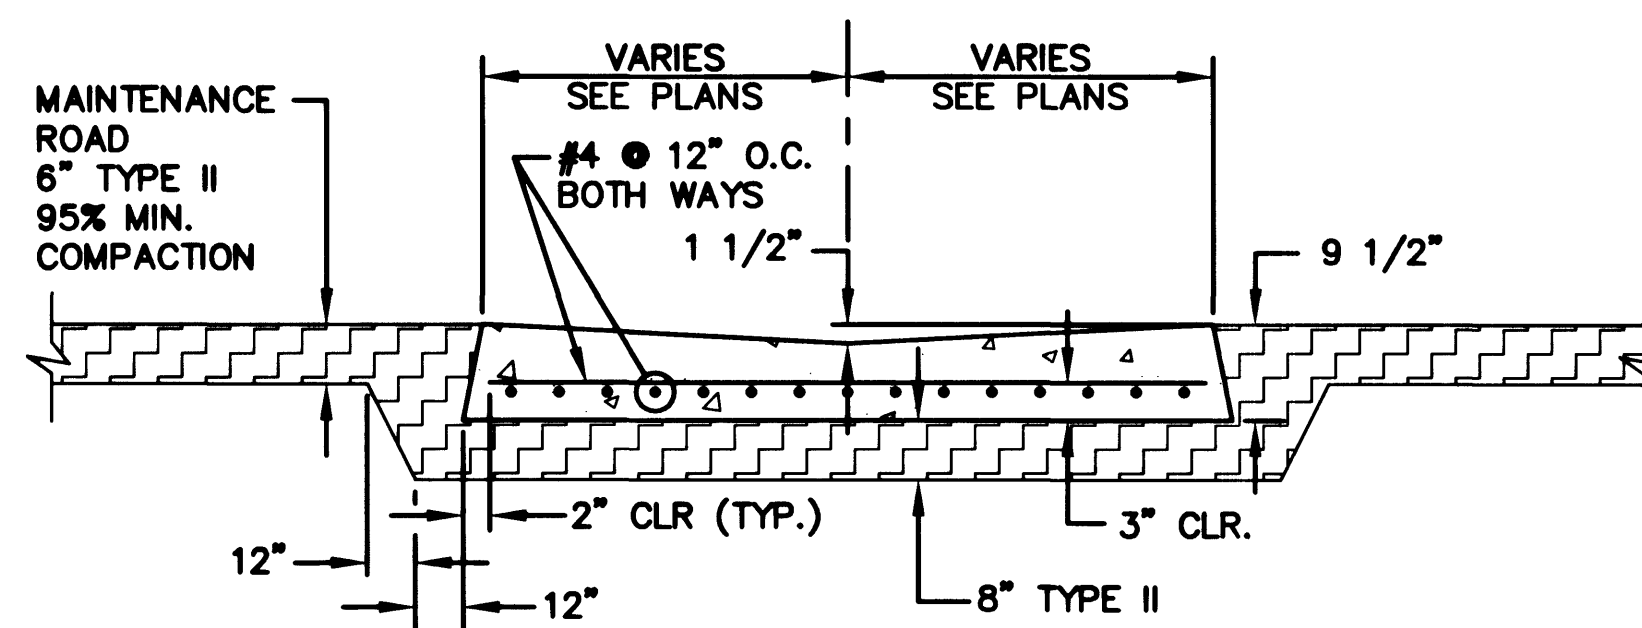

- NOTES:**
1. FINISHED MAINTENANCE ROAD SURFACE TO BE FLUSH WITH CROSS GUTTER LIP.
2. CONCRETE SHALL BE CLASS B.

OVERFLOW CONCRETE SLAB DETAIL
N.T.S.

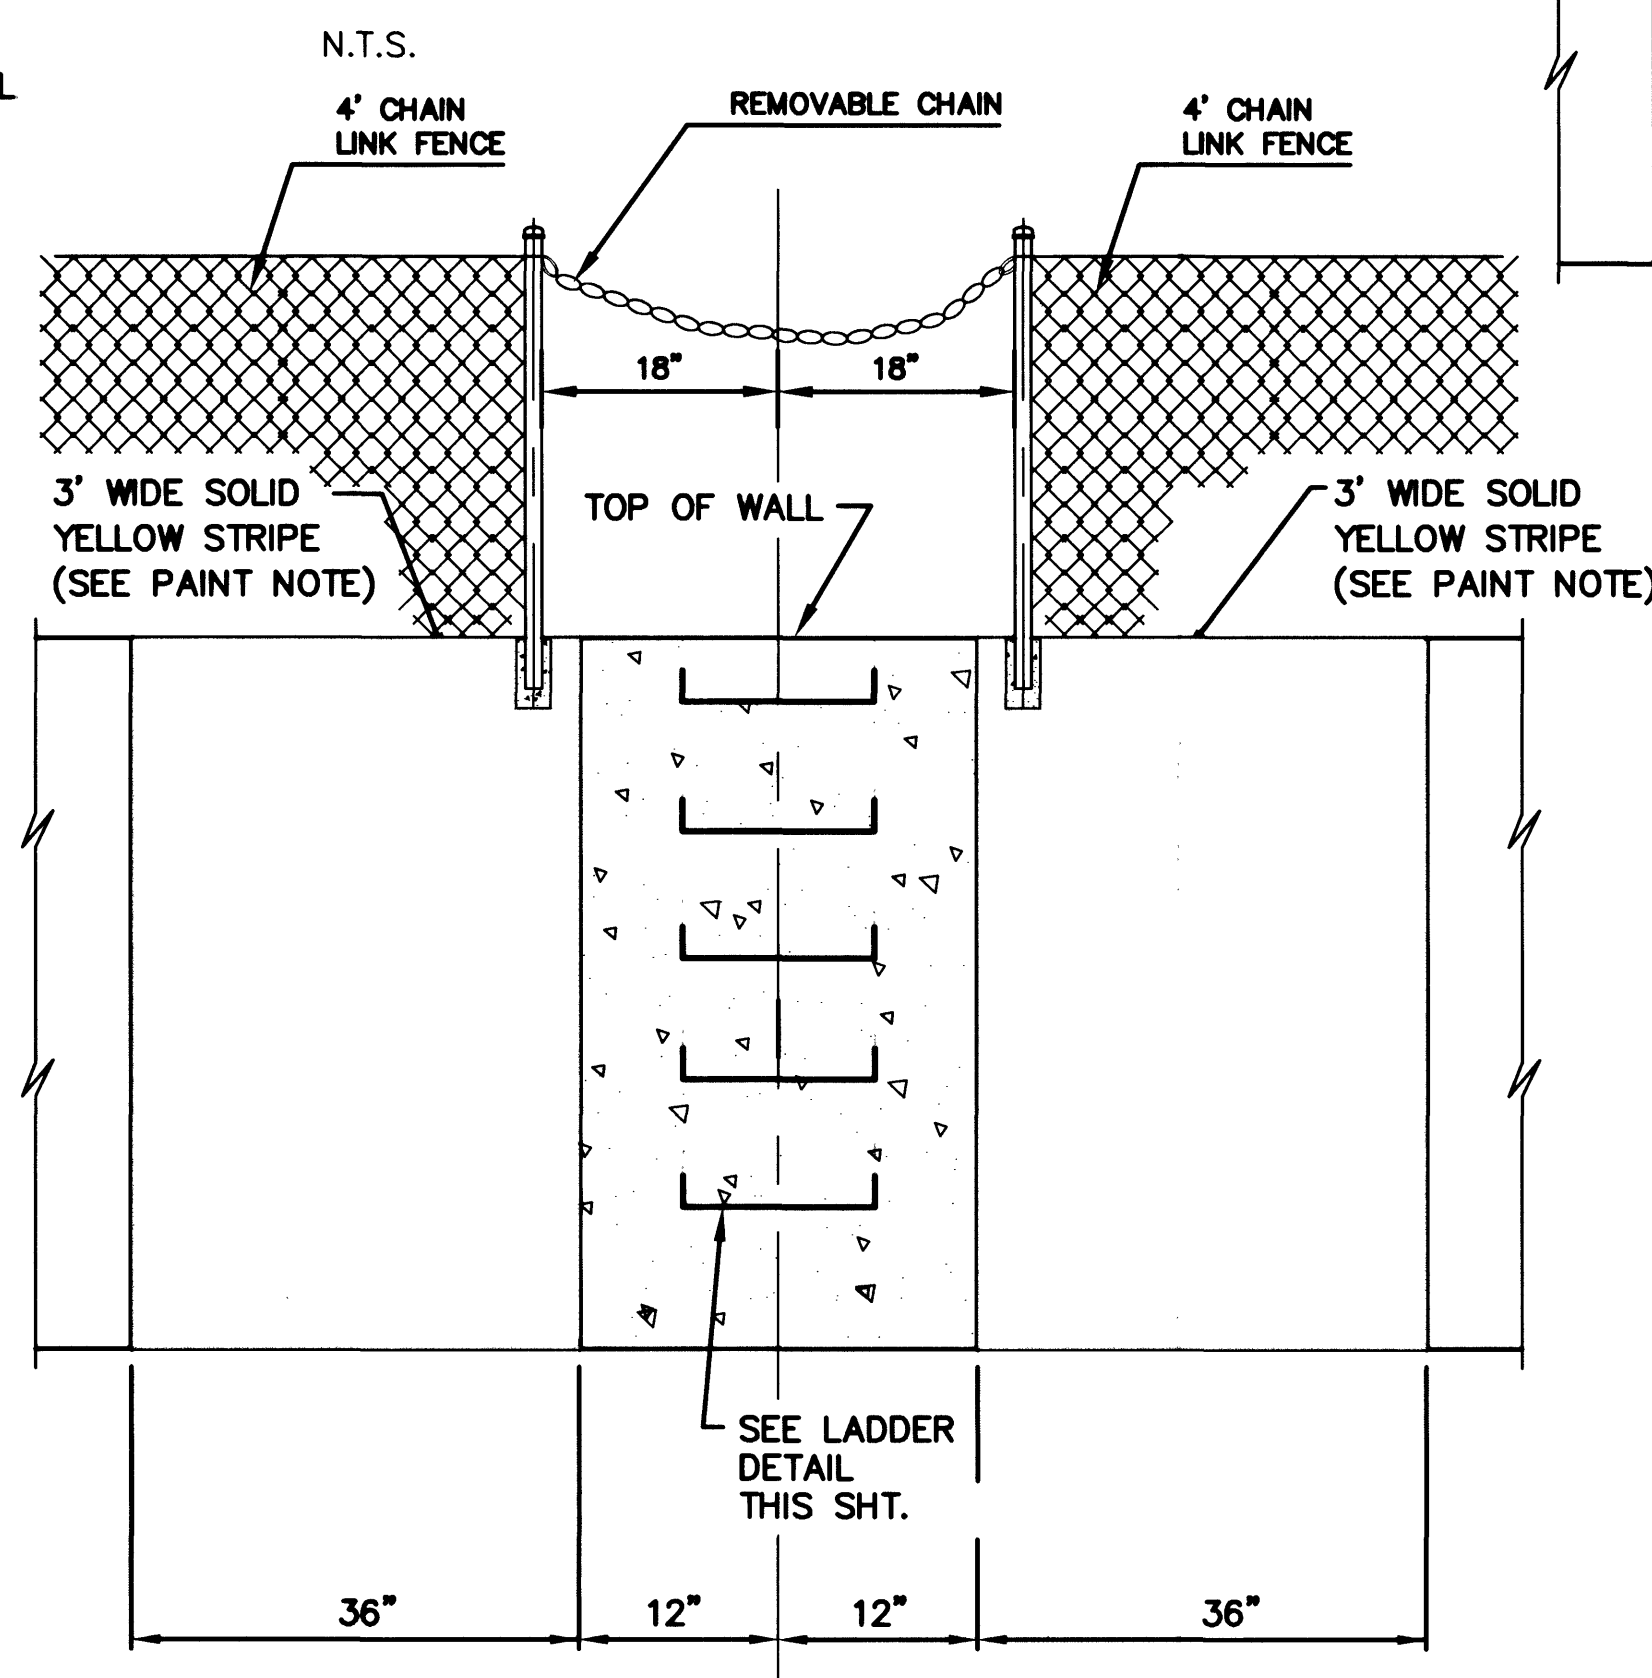


FENCE OPENING AT CHANNEL LADDER
N.T.S.

CHANNEL LADDER LOCATION SCHEDULE	
STATION	OFFSET
13+72	RT.
14+00	LT.
19+72	RT.
20+00	LT.
25+72	RT.
26+00	LT.
31+72	RT.
32+00	LT.
37+72	RT.
38+00	LT.
44+60	RT.
45+00	LT.

PAINT NOTE:

ALL PAINTS SHALL BE HIGH-GLOSS ENAMEL. CONTRACTOR SHALL SUBMIT PAINT DATA SHEET FOR REVIEW AND APPROVAL PRIOR TO APPLICATION. PAINTING SHALL CONFORM TO SECTION 614 OF THE "UNIFORM STANDARD SPECIFICATIONS FOR PUBLIC WORKS" CONSTRUCTION OFF-SITE IMPROVEMENTS, CLARK COUNTY AREA, NEVADA (LATEST EDITION)

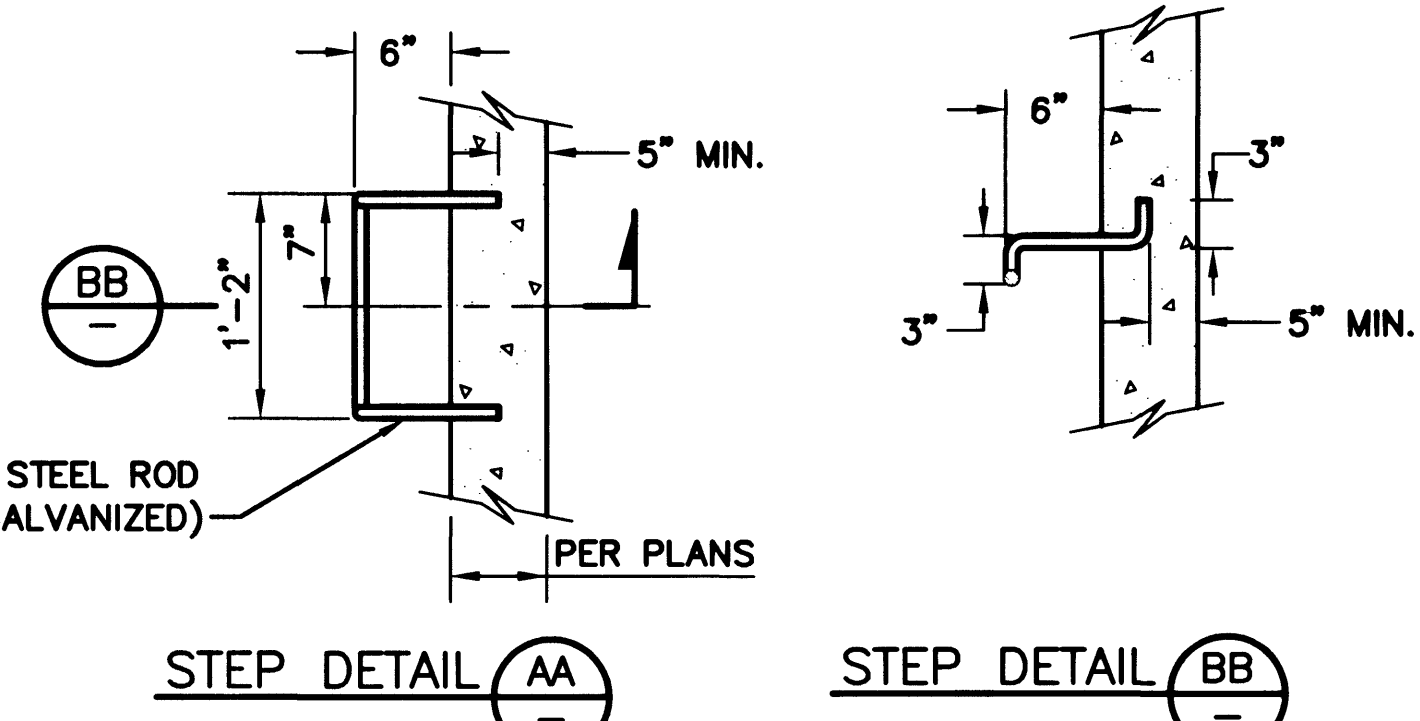

FOR STRUCTURAL DETAILS, REFER TO SHEETS S1 THROUGH S9

PERMA BILT HOMES
7150 POLLOCK DRIVE, SUITE 104
LAS VEGAS, NEVADA 89119
(702) 886-9100

MISCELLANEOUS DETAILS

GILMORE CHANNEL FLOOD CONTROL IMPROVEMENTS

DANIEL W. BENDER
CIVIL
No. 12806

D1
10 OF 22 SHEETS
DRAWING NO. 731-74

RECORD DRAWINGS INFORMATION SUPPLIED BY CONTRACTOR - MAY 2002