



MATCH LINE SEE SHEET 18

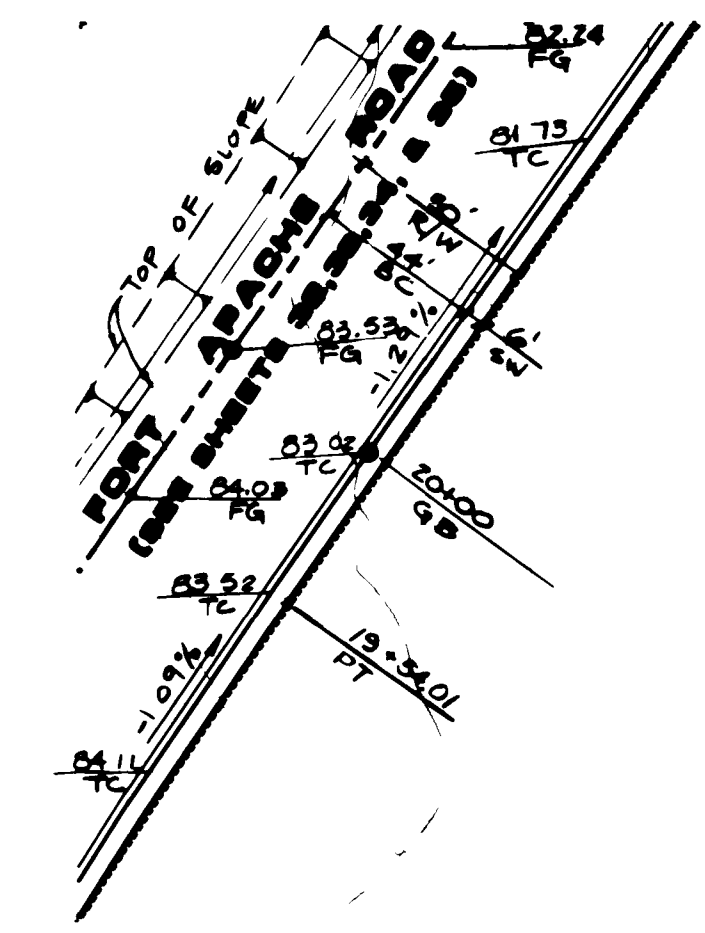

LOT D

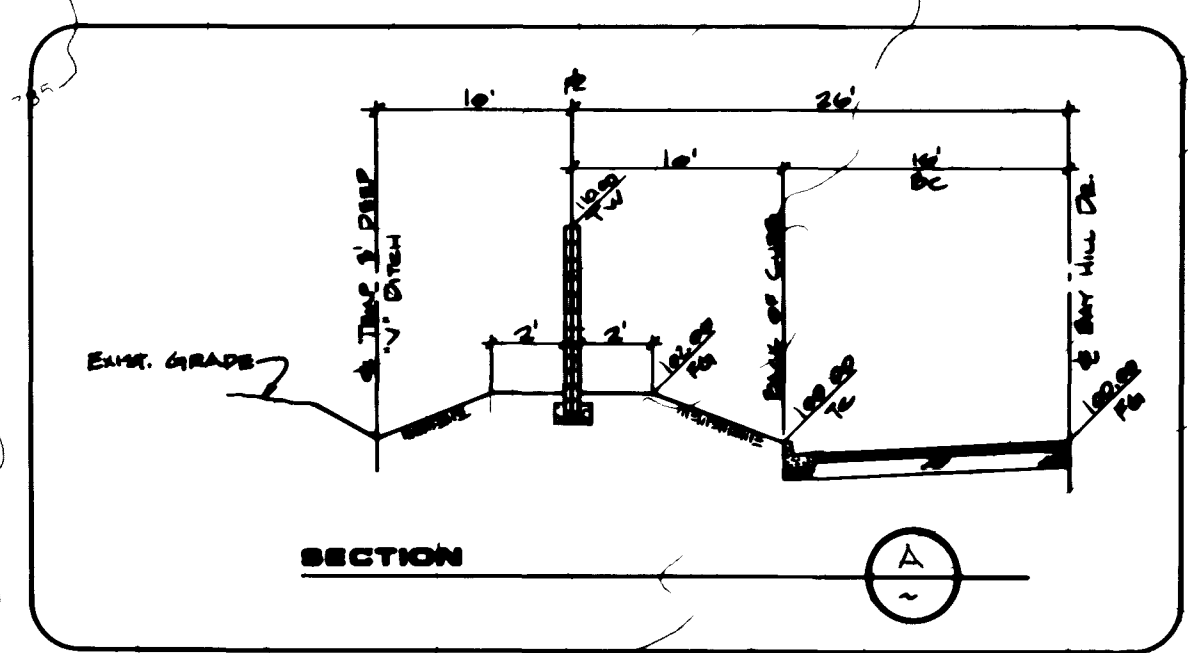

AREA TO BE FILLED

MATCH LINE SEE SHEET 20

WL 56.0

UNIT NO. 3
GOLF COURSE



FUTURE
FOOTHILLS COUNTRY CLUB UNIT NO. 4
LOT C

SEE UNIT NO. 4 GRADING PLAN

Handwritten note: 4.0' 5.0' 10' 15'

UNIT NO. 3
GOLF COURSE

MATCH LINE SEE SHEET 18

REV	DATE	DESCRIPTION	APPROVAL
1	9/21/91	REV LOT LAYOUT & GRADING TO LOT ONLY	<i>[Signature]</i>
2	5/8/91	SEAL FOR REV # 1 ONLY	GARY PRESSACON, CLV ENGINEER


FOOTHILLS COUNTRY CLUB UNIT NO. 3 AT PEBBLE RANCH	GRADING PLAN
SHEET 19	OF 50 SHEETS

G.C. WALLACE, INC.
Engineering/Architecture

JOB
DATE
DRAWN
CHECK

LOCATION
DATE
DRAWN
CHECK

DESCRIPTION
REV
DATE

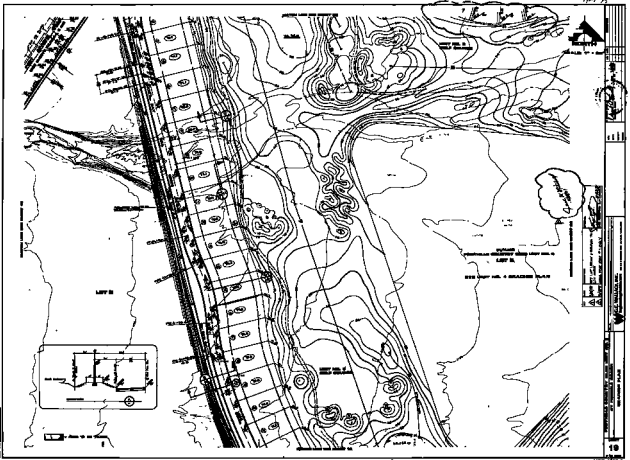

1" = 100'

1" = 200'

1" = 400'

1" = 800'

1" = 1600'

1" = 3200'

1" = 6400'