


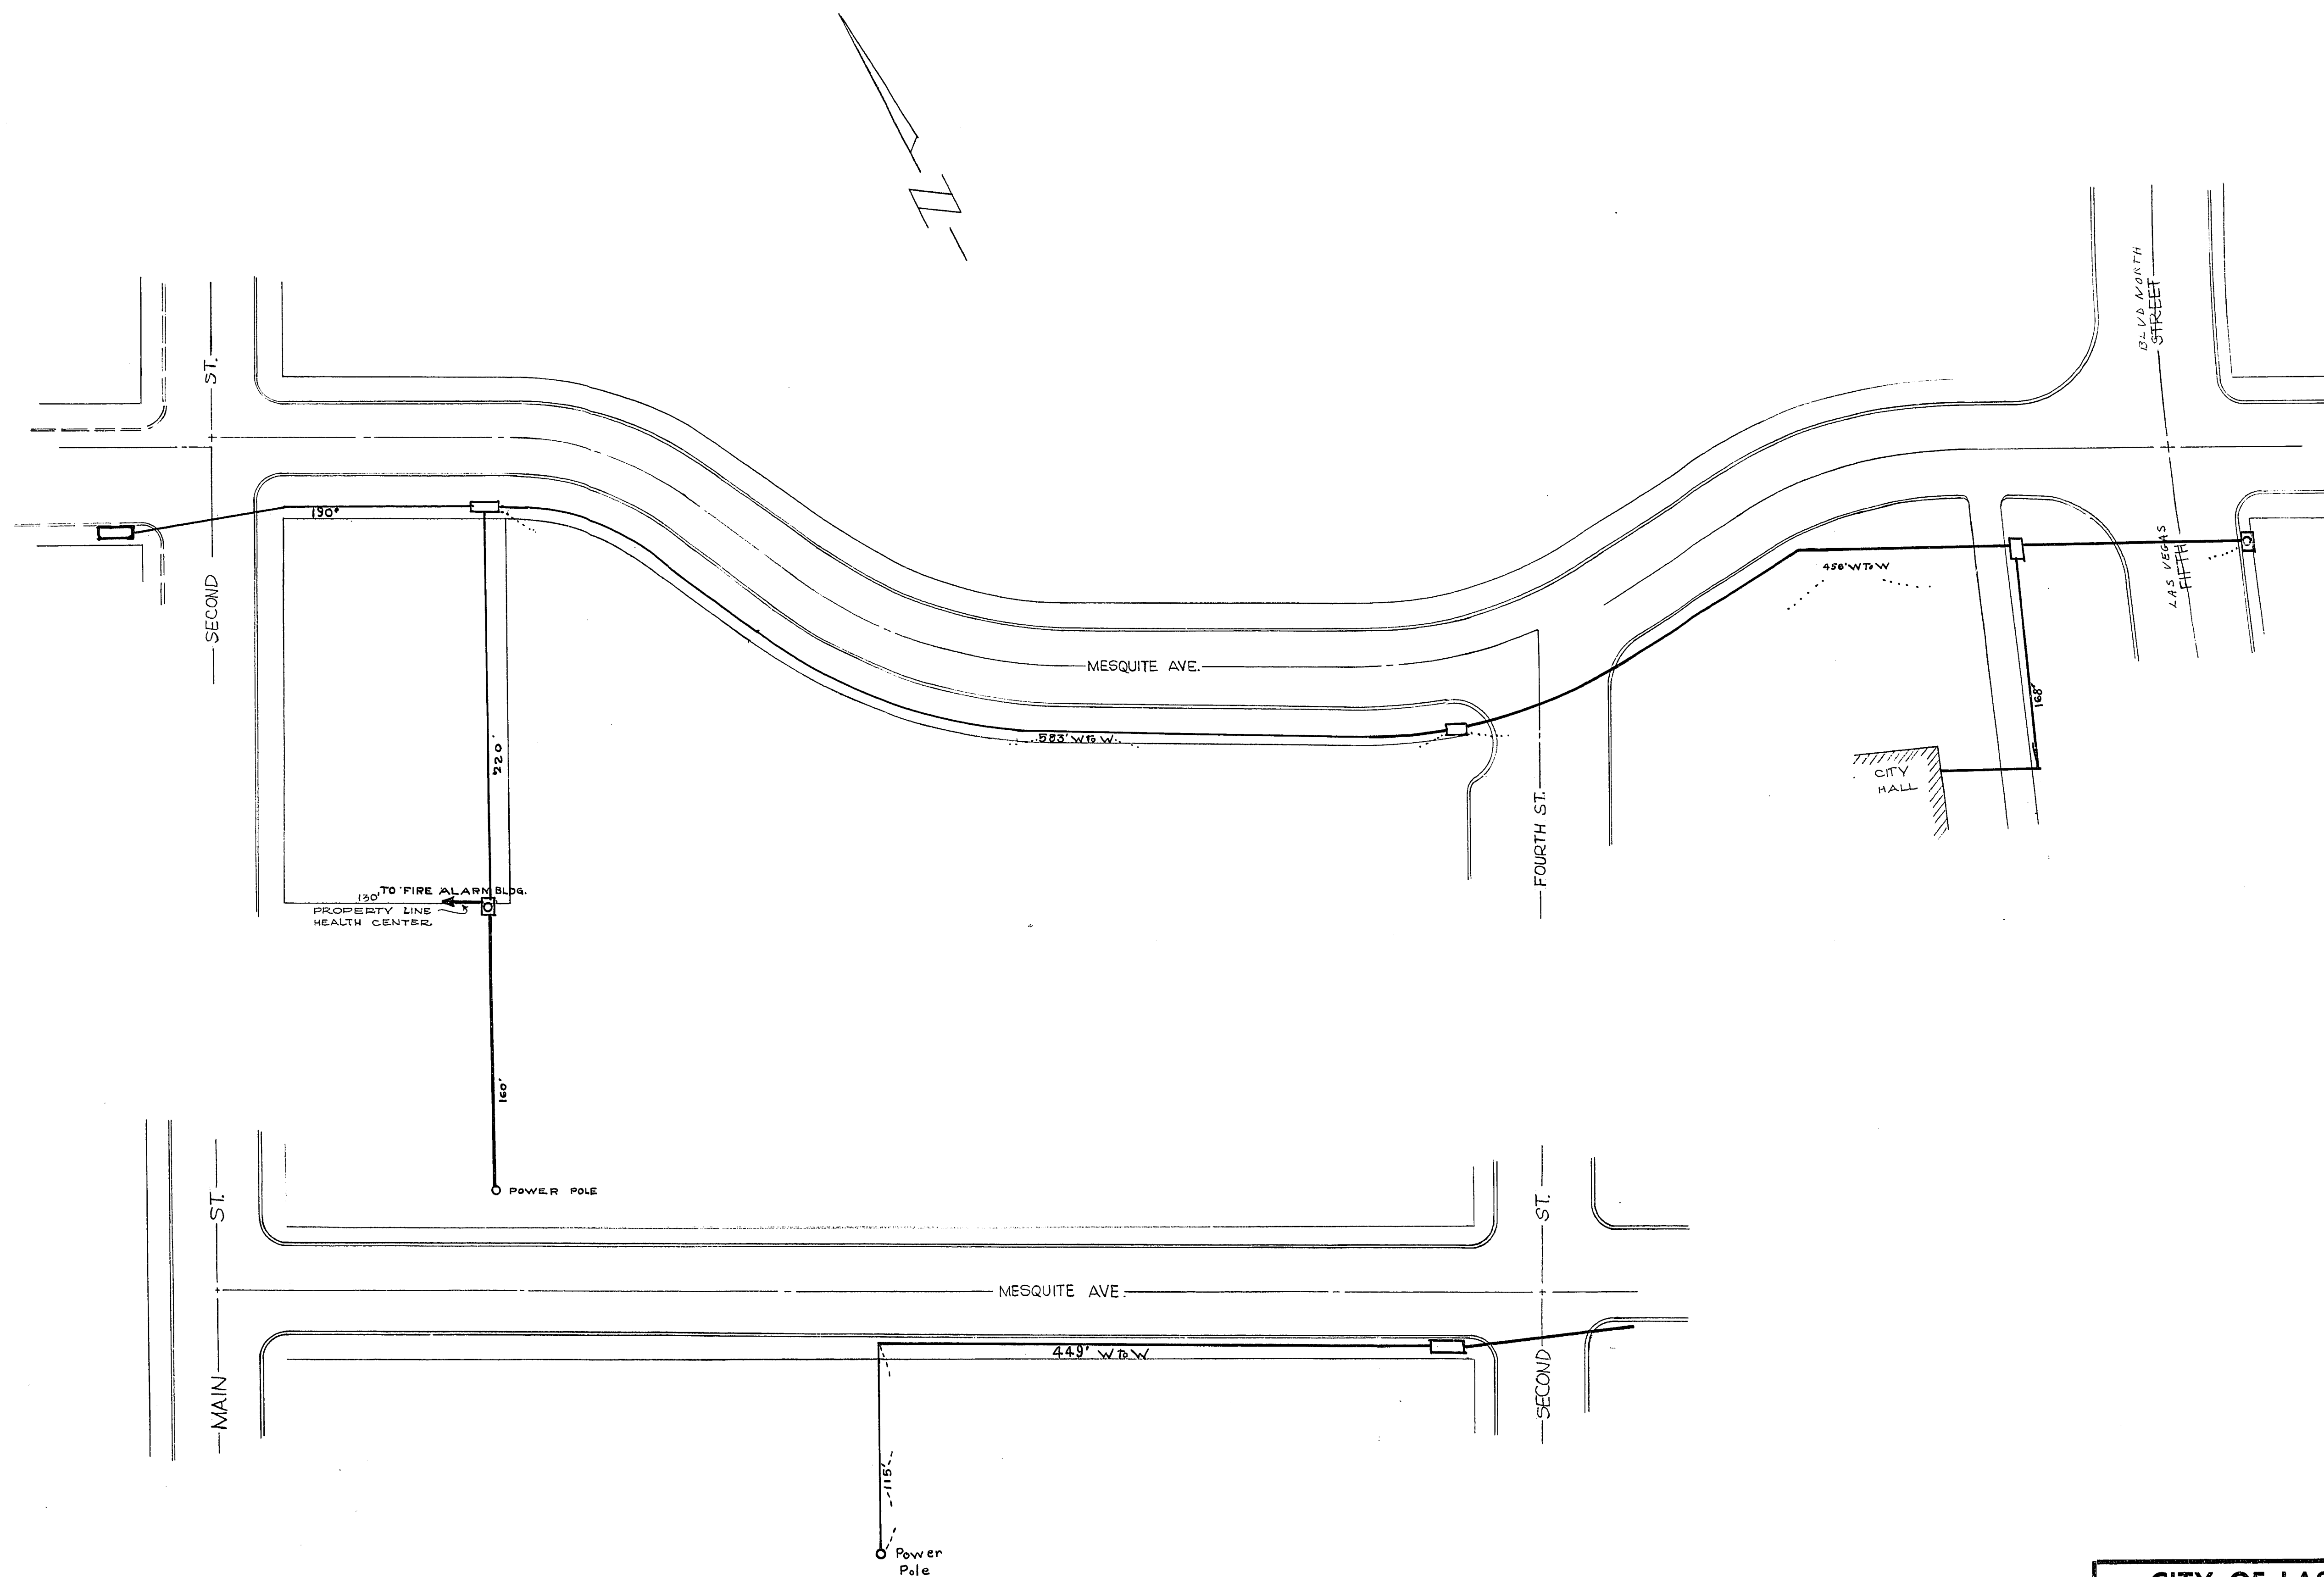

REVISIONS		
NO.	BY	DESCRIPTION

CITY OF LAS VEGAS NEVADA ENGINEERING DEPT.	
FIRE ALARM & COMMUNICATIONS SYSTEM STREET MAP MESQUITE AVE. 3RD ST. TO MAIN ST.	
DESIGNED BY	DATE
DRAWN BY J. MAST	SCALE 1" = 80'
CHECKED BY	FIELD BOOK NO.
APPROVED	WORK ORDER NO. /002
CITY ENGR.	DRAWING NO.
	636-1

4-55