


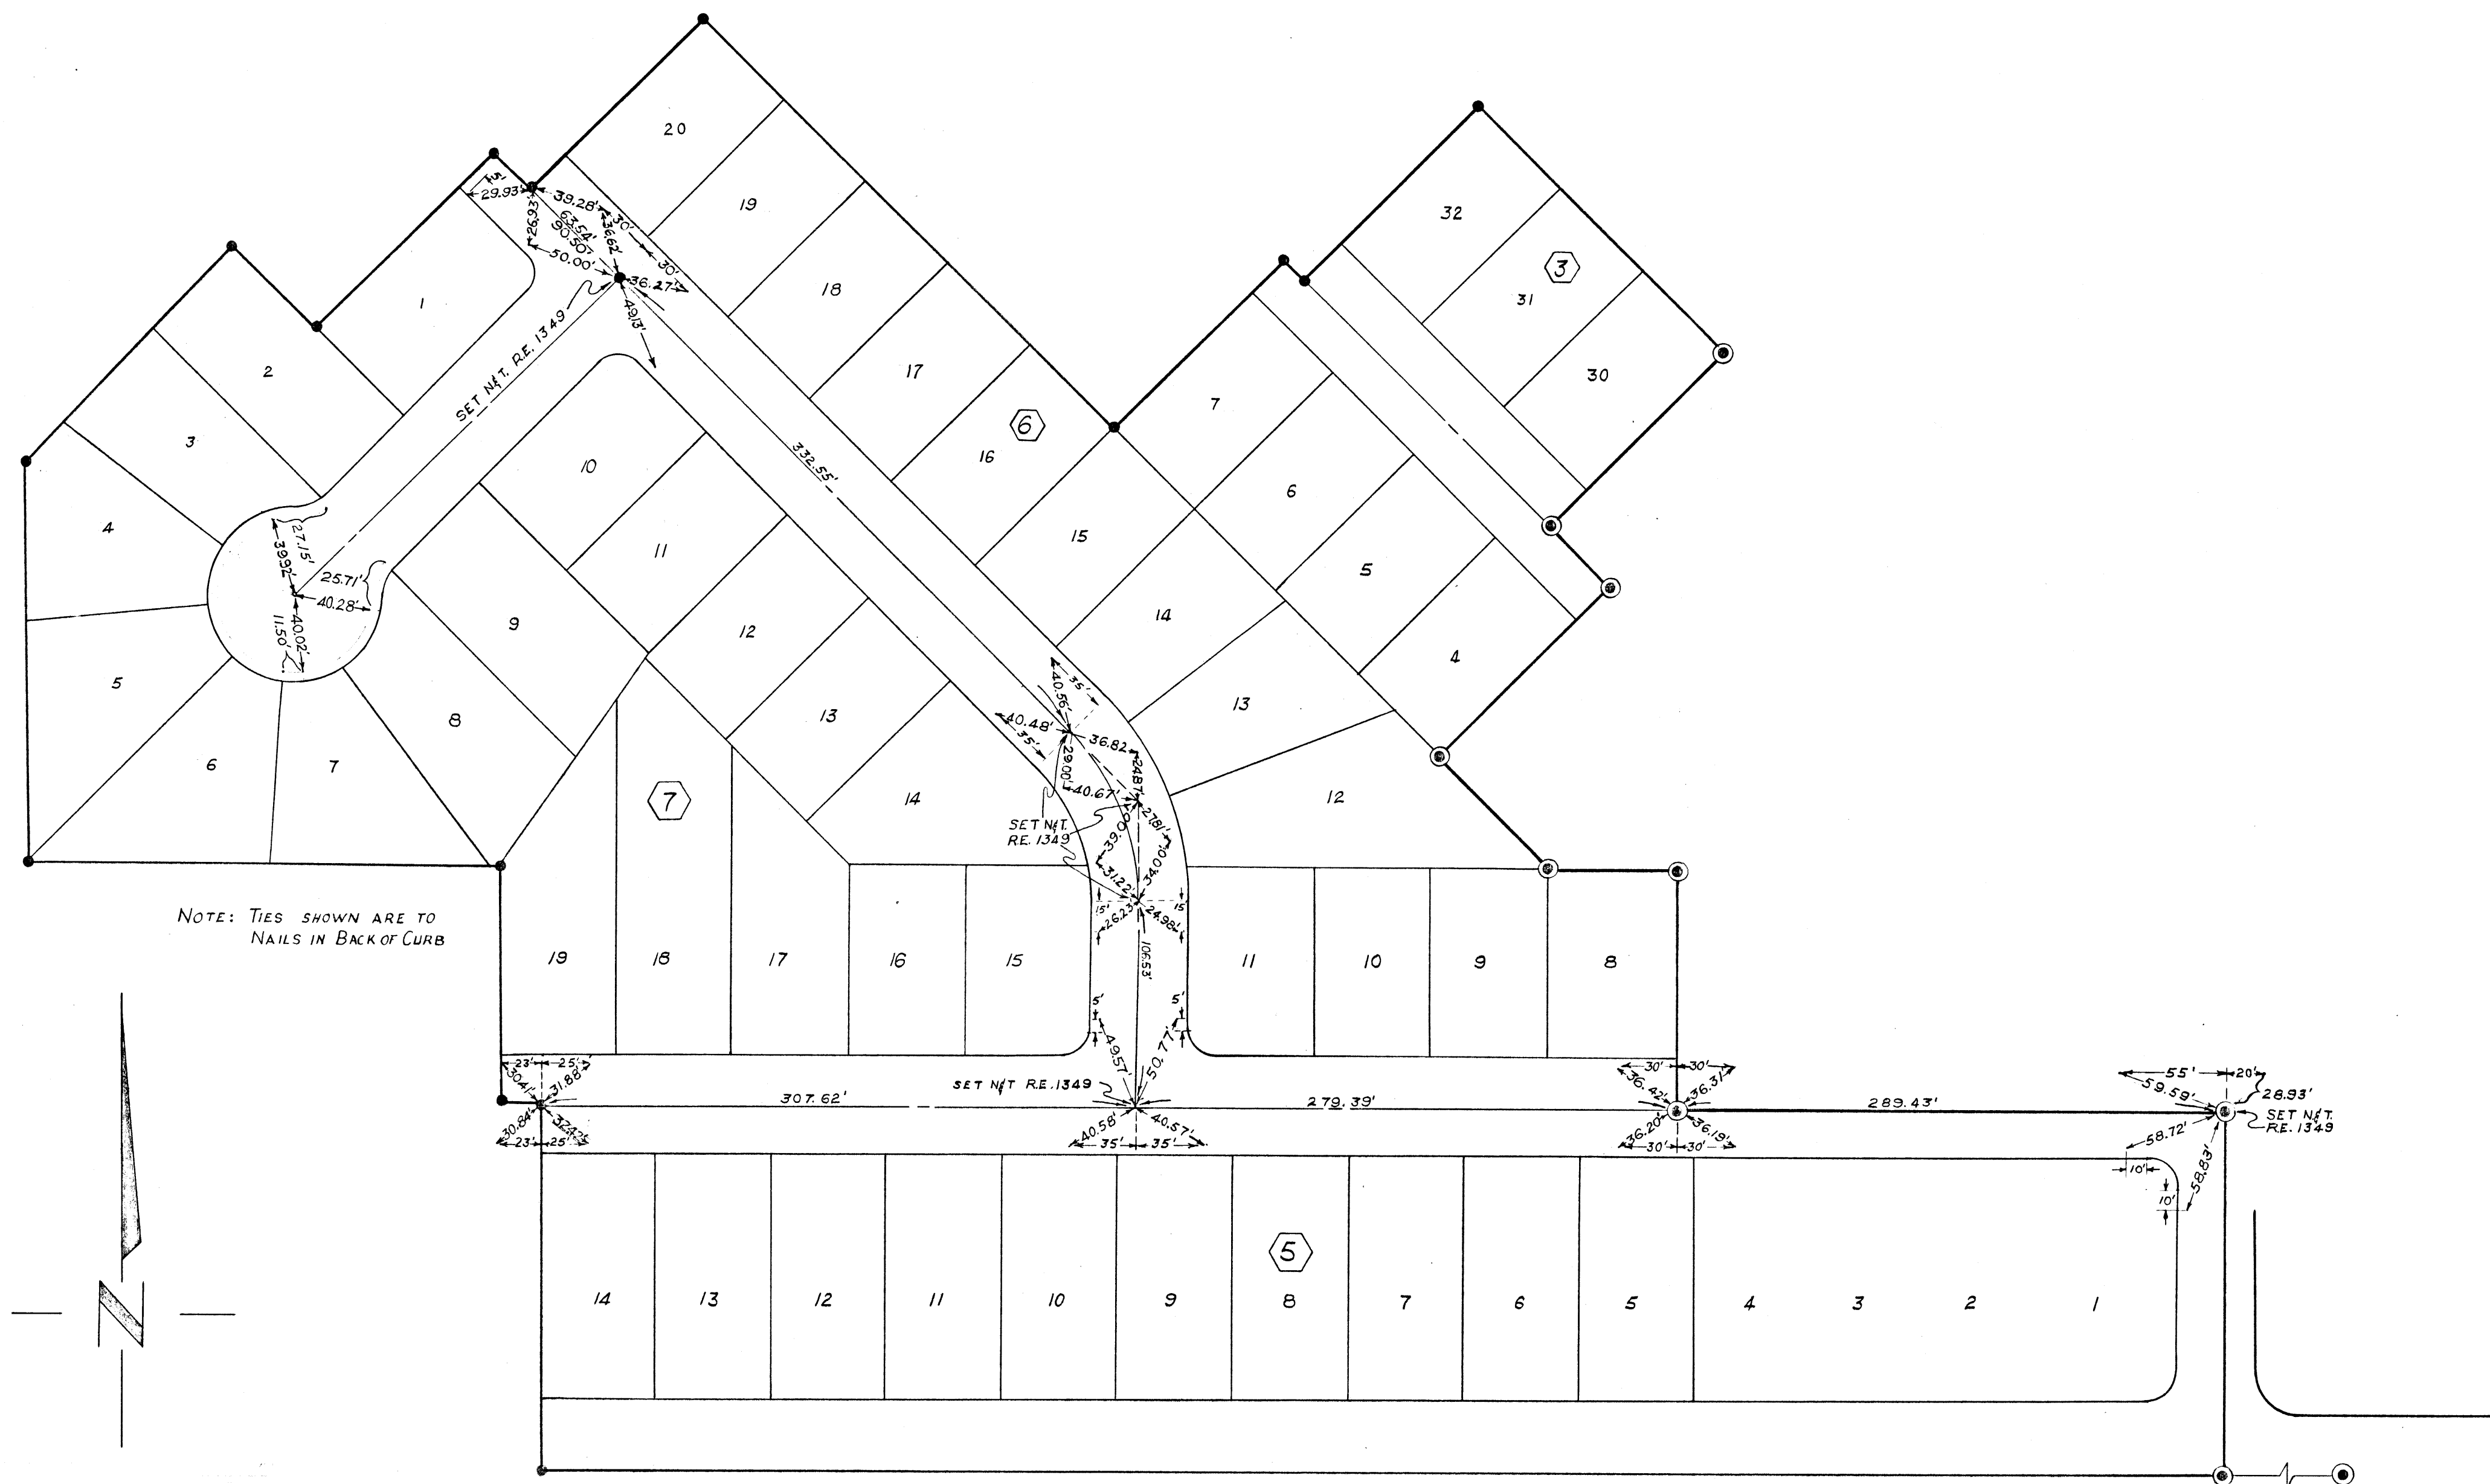

NOTE: TIES SHOWN ARE TO
NAILS IN BACK OF CURB

SCALE 1" = 60'-0"

GOLF RIDGE TERRACE
UNIT 3 & AMENDED UNIT 2 (LOT 1
BLOCK 5)
CONTROL & TIES

DESIGNED	WESTERN ENGINEERS, INC.		SHEET
DRAWN	LAS VEGAS	NEVADA	OF
CHECKED	APPROVED	DATE	

4-6-56

058-1580-3-2