
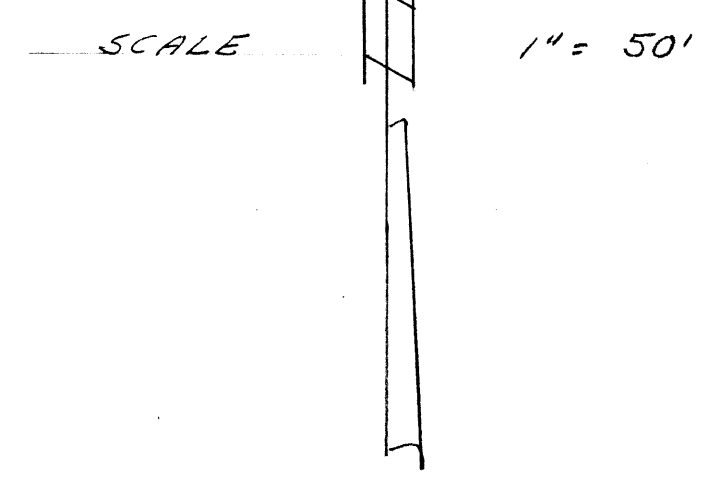


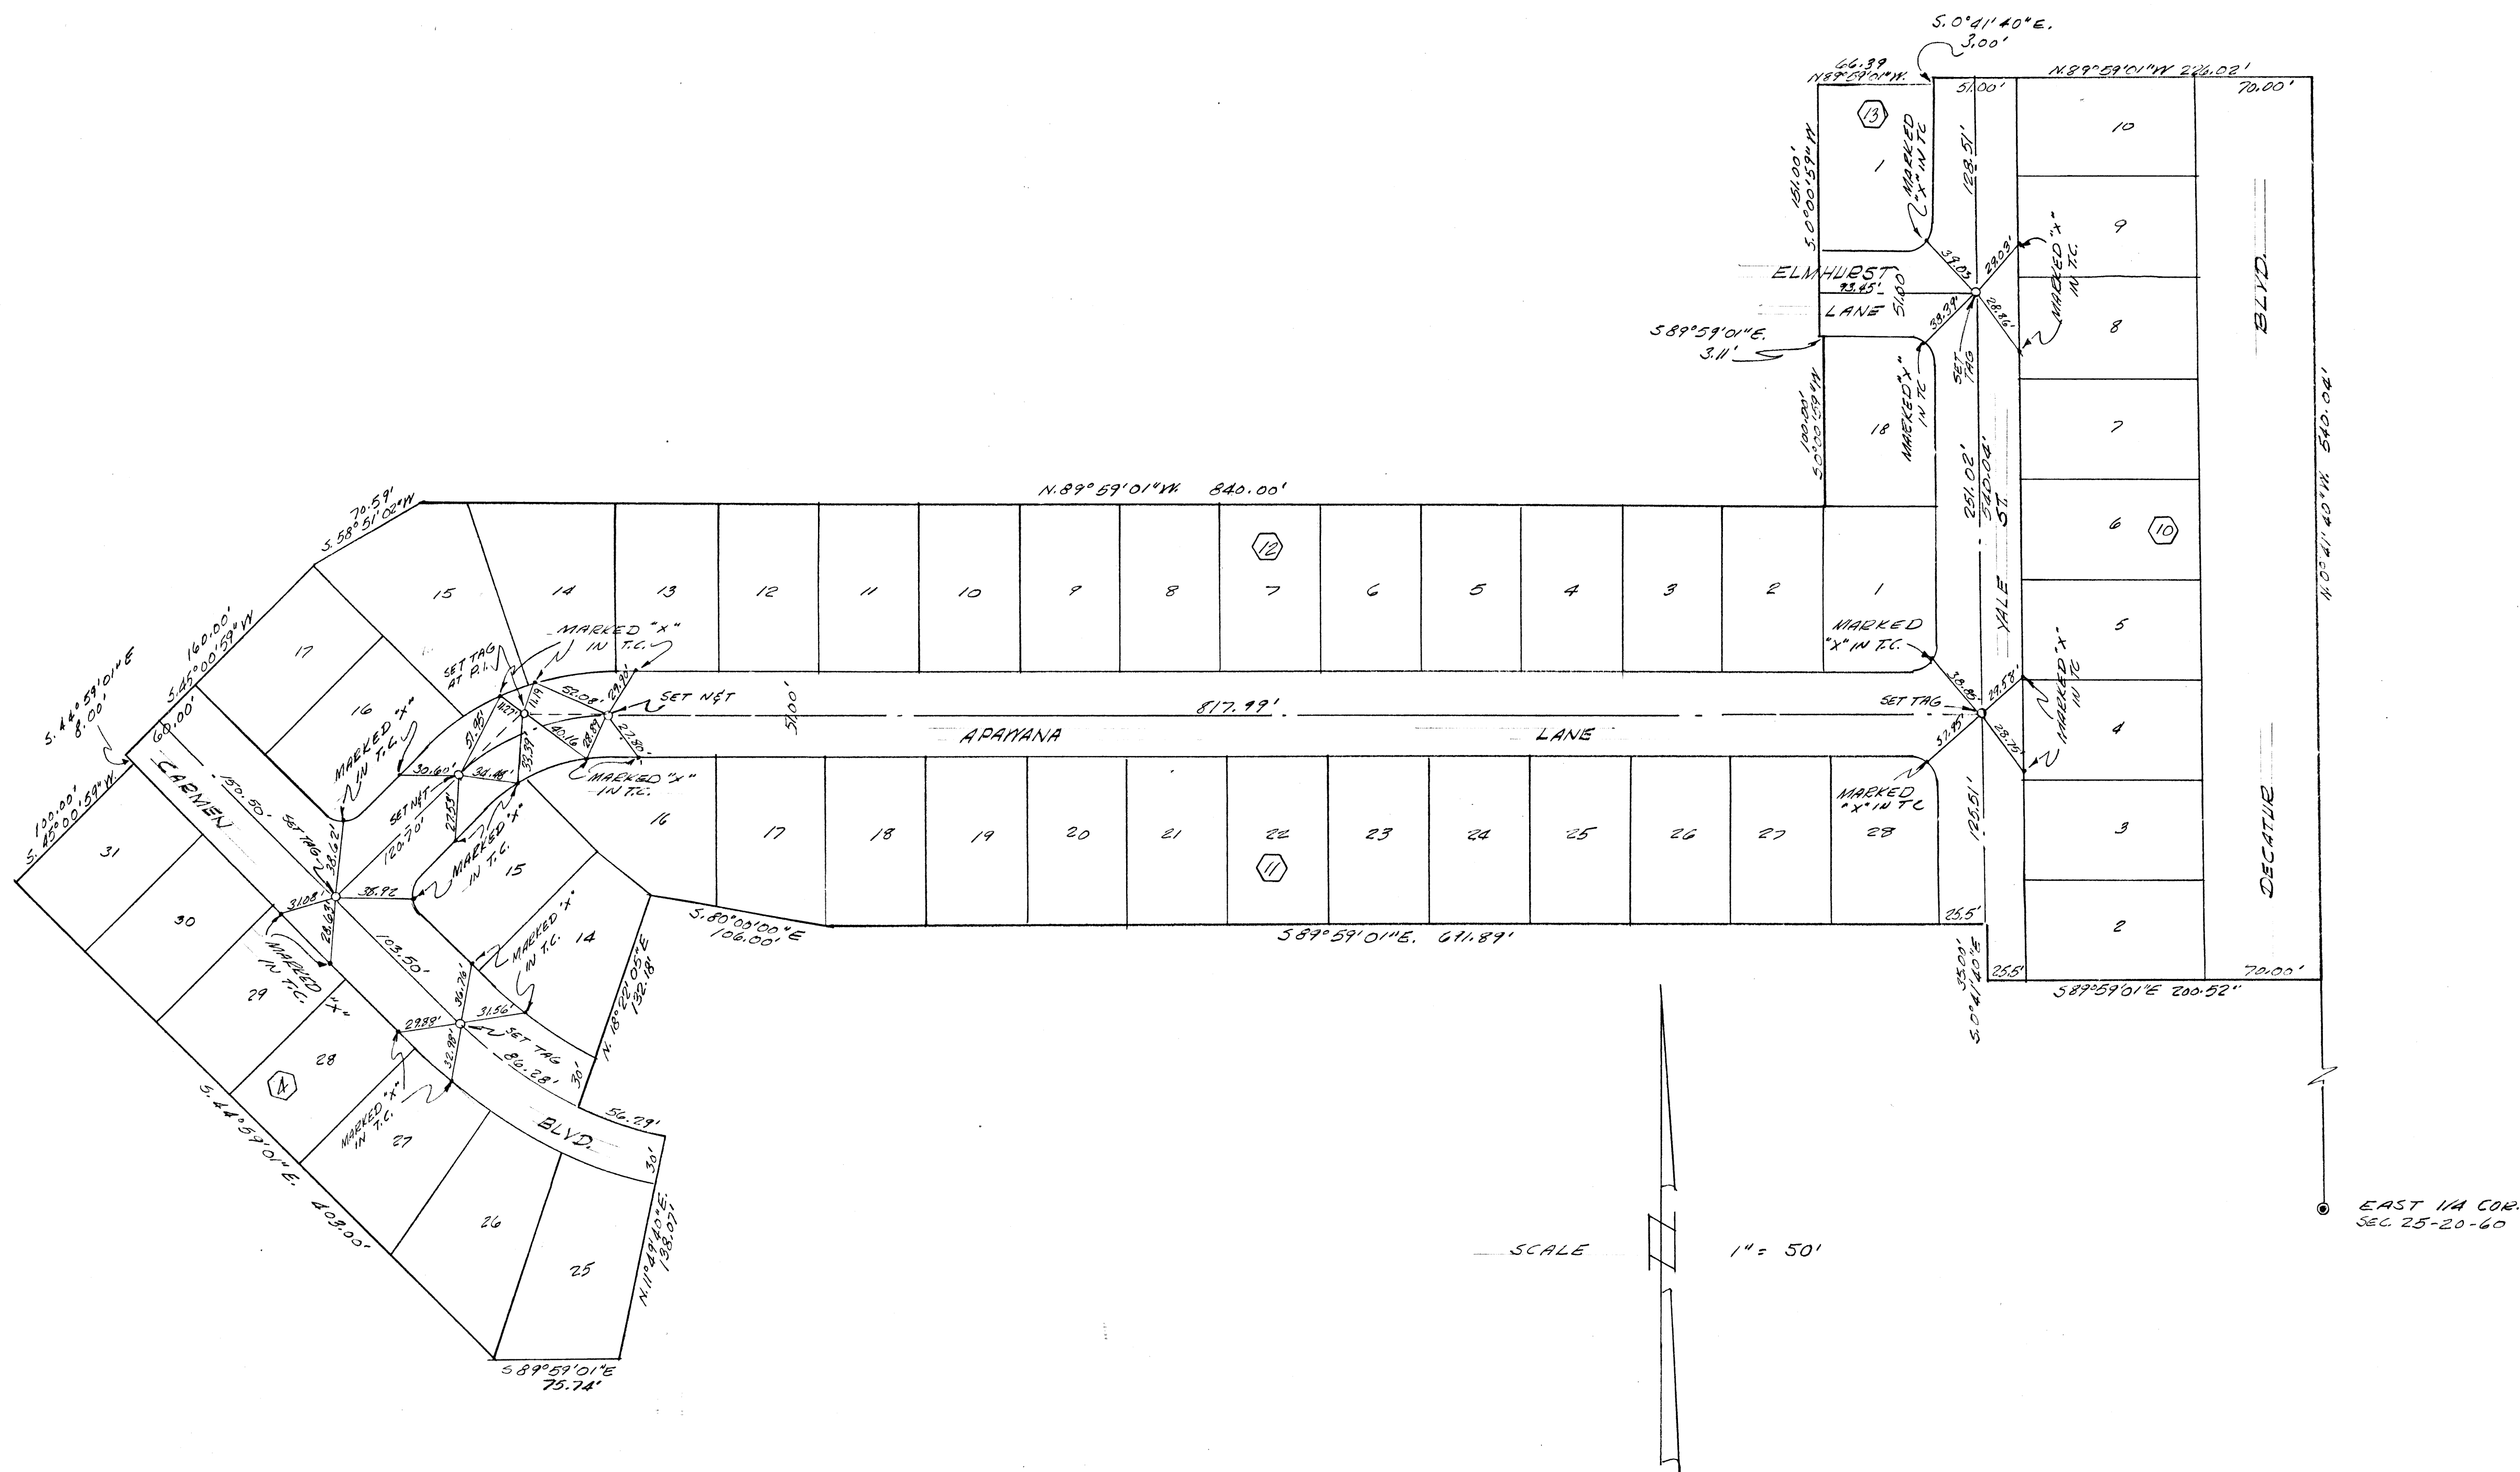

NOTE: R.E. TAG # 1349 IS SET AT
POINTS MARKED SET TAG

GOLFRIDGE TERRACE
UNIT NO. 5
MONUMENT MAP

DESIGNED	WESTERN ENGINEERS, INC.	SHEET /
DRAWN <i>RP</i>	LAS VEGAS NEVADA	OF /
CHECKED	APPROVED	DATE

4-6-57

058-1580-5