


General Notes:

- 1. DIMENSIONS * CHU ARE TO FACE OF CHU WALLS.
- 2. HINGE SIDE OF DOOR JAMBS TO BE: STUDWALLS - FINISHED JAMBS OPENING TO BE 5" FROM NEAREST FINISHED CORNER UNO. MASONRY WALLS - R.O. TO BE 8" FROM NEAREST MASONRY CORNER UNO.
- 3. DIMENSIONS OF INTERIOR STUDWALLS ARE TO FACE OF STUD UNO.
- 4. DIMENSIONS OF FURRED CHU WALLS ARE TO FACE OF CHU UNO.
- 5. COORDINATE WIDTH OF TRENCH DRAINS IN APPARATUS BAYS W/ PLUMBING CONTRACTOR PRIOR TO POURING SLAB FOR DRAINS.
- 6. PROVIDE DEPRESSION IN SLAB FOR SHOWER BASES IN ROOMS 103 & 106. COORDINATE SIZE AND DEPTH W/ SHOWER PAN MANUFACTURER SEE SHEET 011 FOR AREAS OF DEPRESSIONED SLAB.
- 7. SEE SHEET A82 & DETAILS ON SHEET A104 FOR DIMENSIONS OF KITCHEN CABINETRY.
- 8. DIMENSIONS FOR ALL MILLWORK ARE FROM FACE OF LAMINATE FINISH AND/OR GYPSUM WALL BOARD FINISH.
- 9. DIMENSIONS FOR ALL BATH FIXTURES ARE FROM FACE OF TILE OR FINISHED FLOOR.
- 10. ALL HANDICAPPED SHOWERS SHALL HAVE AN EXACT 3'-0" CLEAR INTERIOR DIMENSION FROM FACE OF FINISH IN BOTH DIRECTIONS (3'-0" LENGTH BY 3'-0" WIDTH). NOTE: SHOWER PAN SIZE IS 3'-4" X 3'-2" (VERIFY W/ MFR). SHOWER WALLS TO BE 3/8" THK TILE O/ 3/8" THK MORTAR OVER (2) LAYERS OF 5/8" CEMENT BOARD OVER 3-5/8" MTL STUDS UNO.
- 11. HANDICAPPED DIMENSIONS WITH "CLR" ASSOCIATED WITH THEM INDICATE THE REQUIRED EXACT DIMENSION TO FACE OF WALL FINISH. CONTRACTOR IS REQ'D TO COORDINATE ROUGH FRAMING DIM. REFER TO SHEET A82 FOR CLARIFICATION OF CLEAR DIMENSIONS TO FINISHED SURFACES.
- 12. RECESSES IN CONCRETE SLAB TO BE 3'-4" SQUARE FOR ADA SHOWER PANS (VERIFY THIS SIZE W/ SHOWER PAN MFR PRIOR TO POURING SLAB).



RECORD DRAWING
THIS DRAWING REPRESENTS AS
BUILT CONDITIONS FOR THE WORK
UNDER THIS CONTRACT ONLY.
By: [Signature]
Date: 11/17
THE KORTE COMPANY
General Contractor

CITY OF LAS VEGAS, NEVADA
FIRE STATION #47
Dimension
Floor Plan

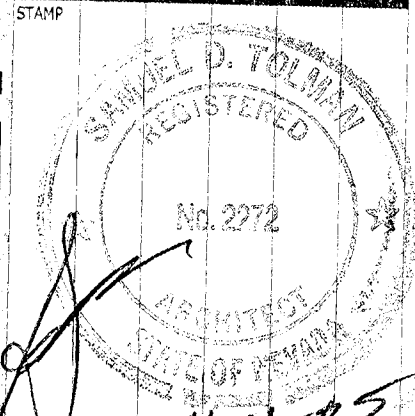

OWNER: THE HOWARD
HUGHES CORPORATION
10000 W. CHARLESTON BLVD., STE. 200
LAS VEGAS, NEVADA 89135
PHONE: (702) 791-0000
ARCHITECT OF RECORD
SAMUEL D. TOLMAN, AIA, NCARB
4000 EAST STEWART AVENUE
LAS VEGAS, NEVADA 89101
PHONE: (702) 229-6535
FAX: (702) 382-3232
TDD: (702) 386-9108


APPROVED FOR CONSTRUCTION
Date: 6.1.00 By: [Signature]

PLANS APPROVED
ARCHITECTURAL
Building & Safety Dept.
City of Las Vegas, Nevada

T.S. MAR 22 2006

Does Not Include Structural, Electrical,
Plumbing/Mechanical or Civil-Sea
Improvements Slabs No Change
Without Approval Plan is
Not a Permit to Violate Any Ordinance

A1.2

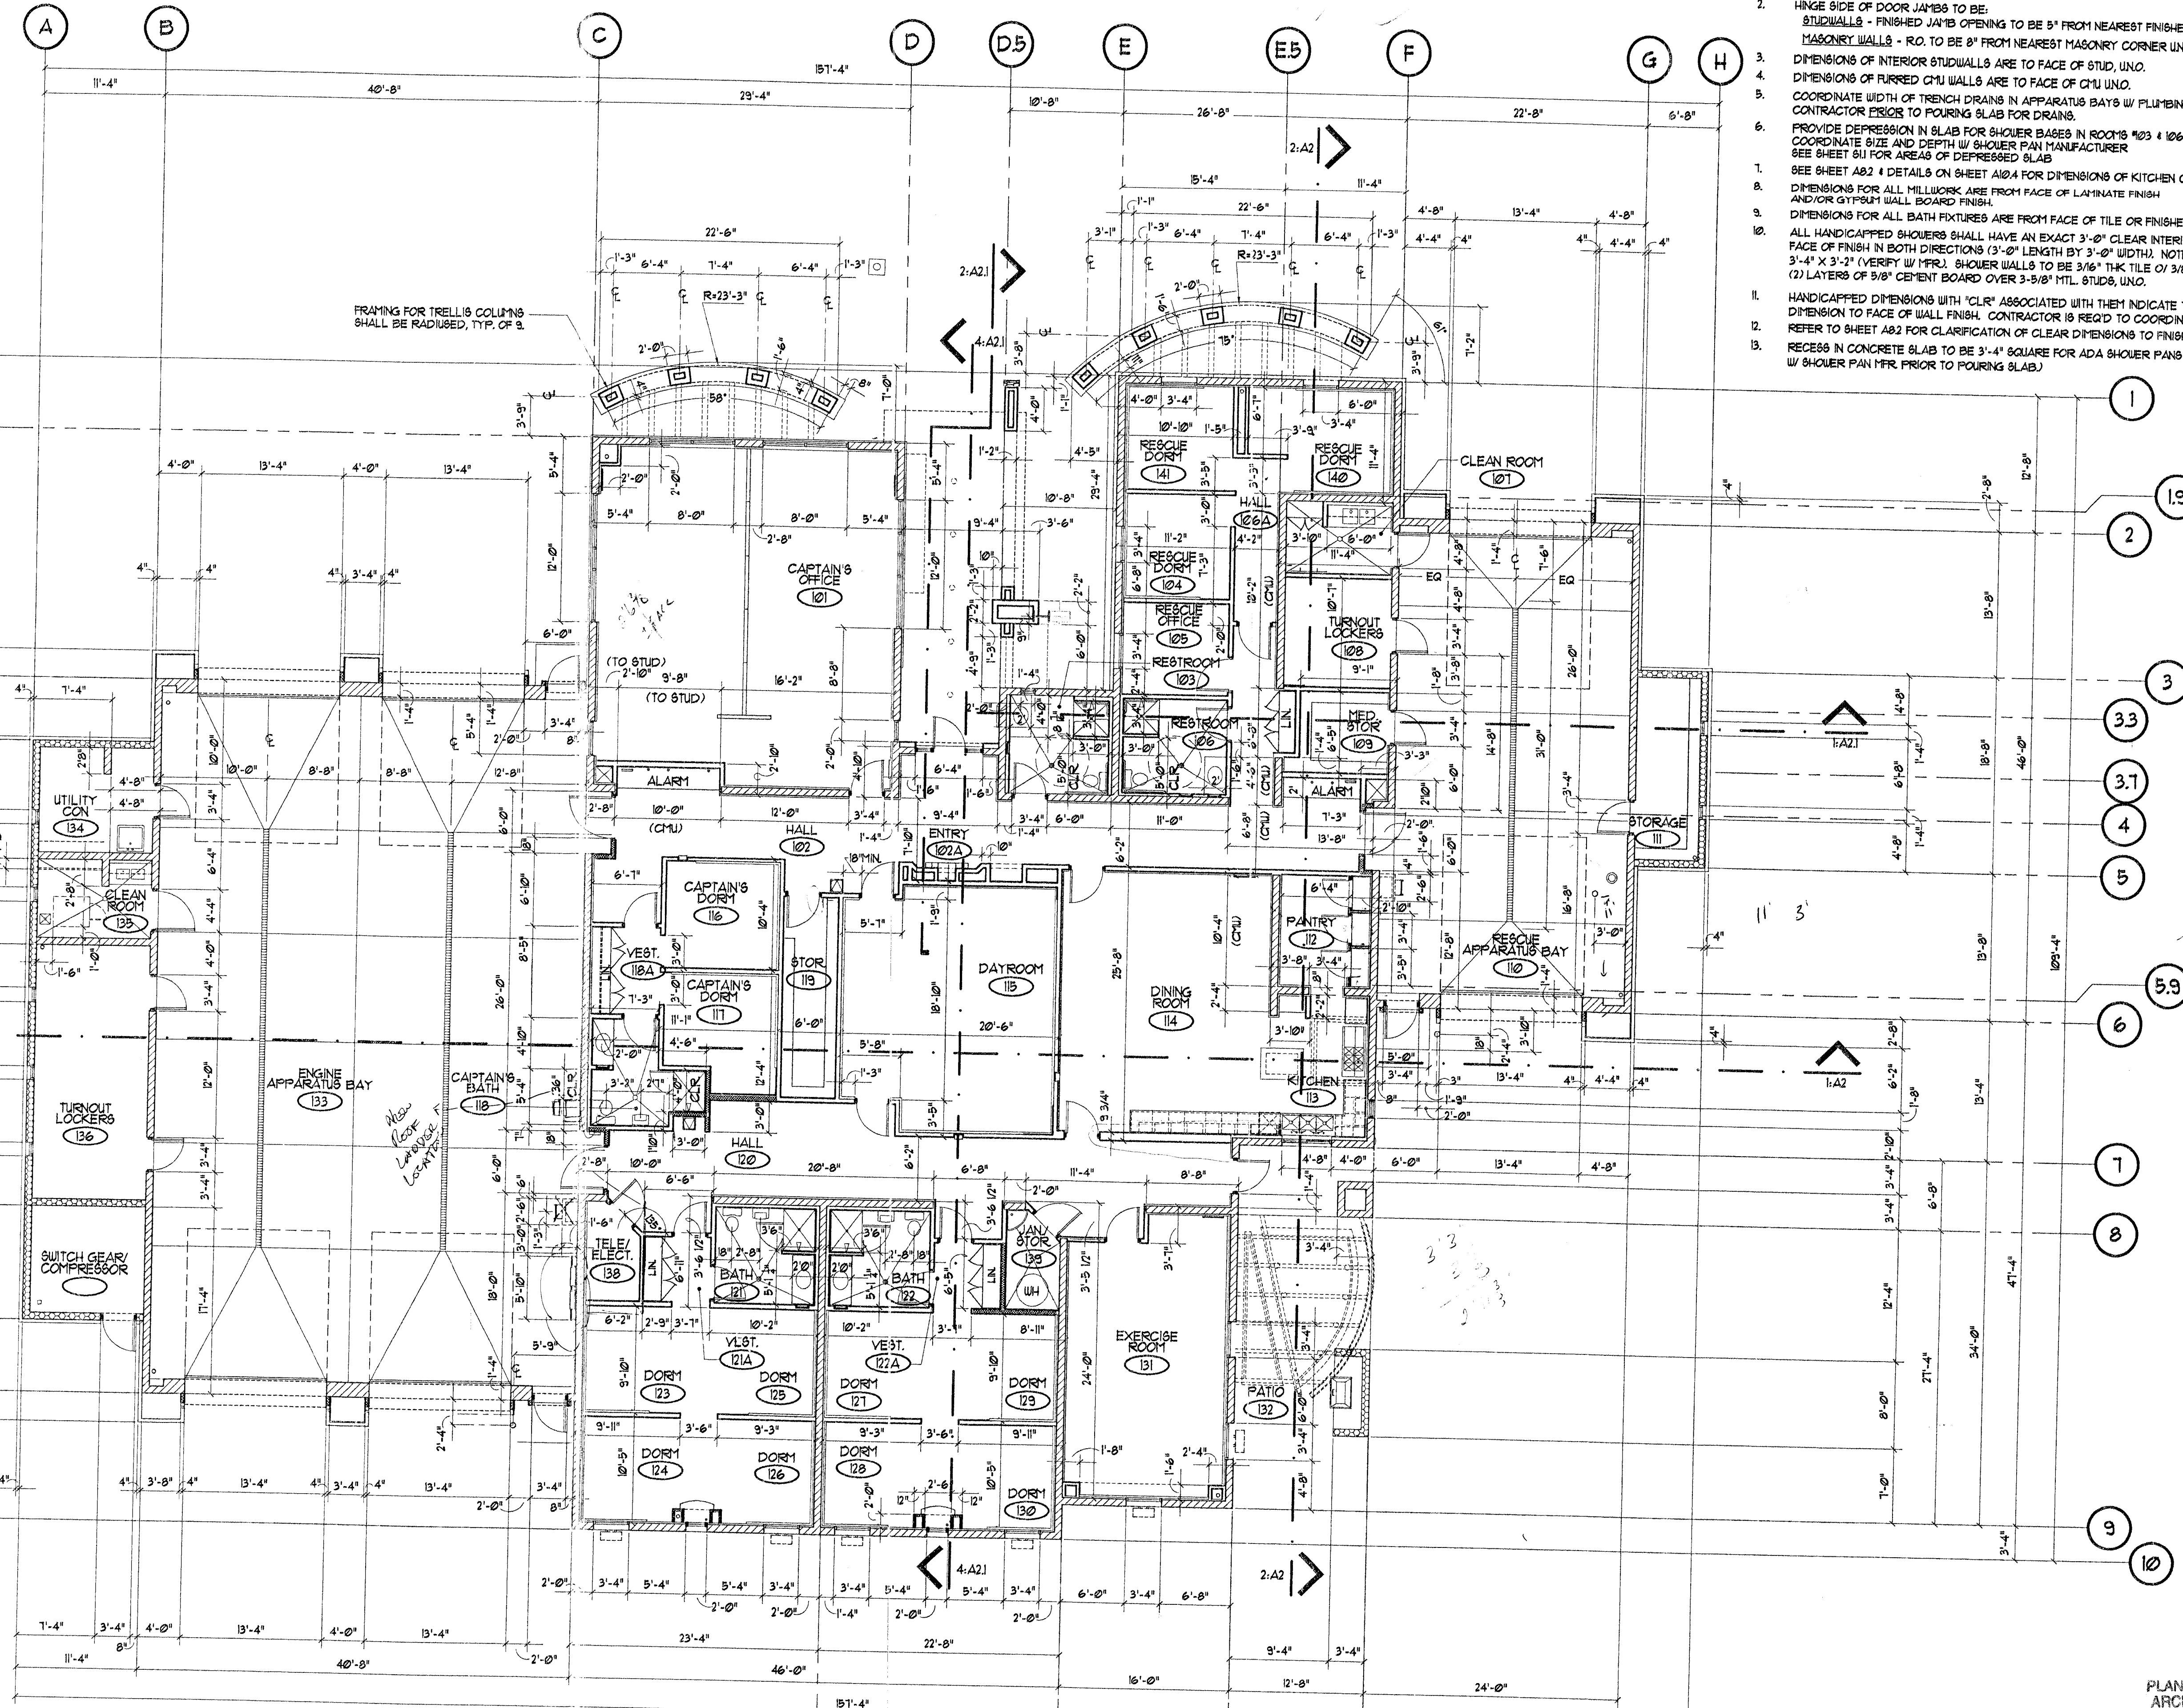

Dimensional Floor Plan
Scale: 1/8"=1'-0"

Project North