
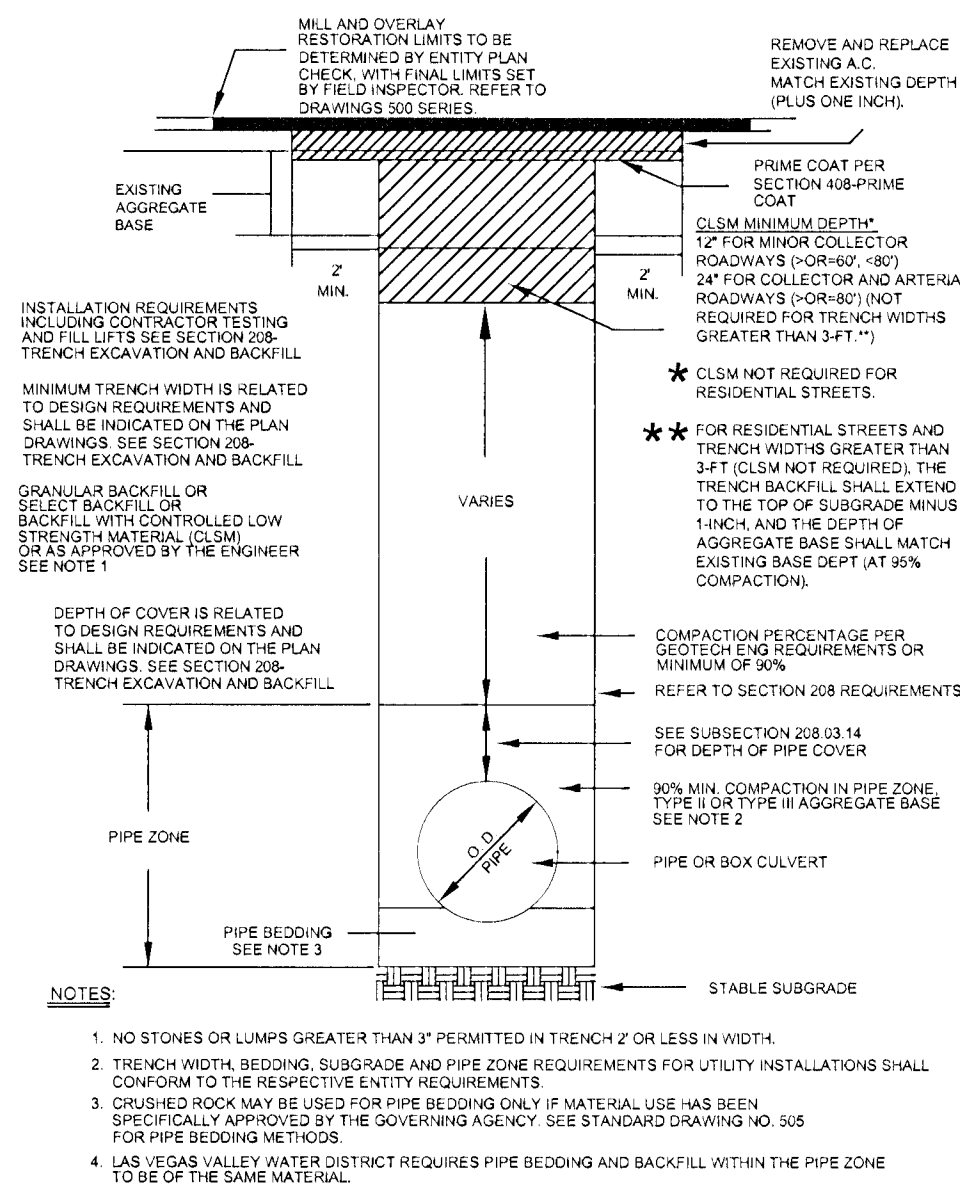


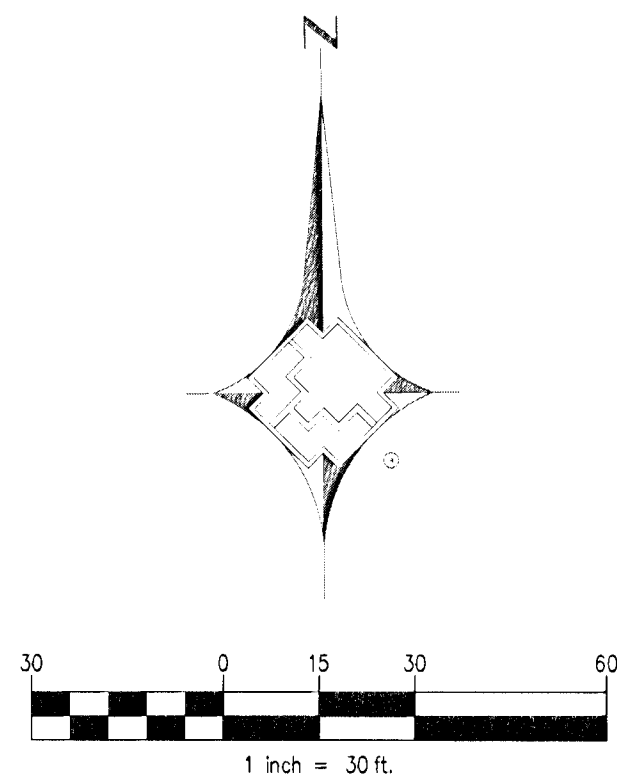

RTC STD 503

RTC NOTES:

BACKFILL SHALL CONFORM TO RTC STD. 503.
PAVEMENT REPAIR SHALL CONFORM TO RTC
STANDARD(S):

A1 RTC STD 500.4

A2 RTC STD 500.5



NO.	DESCRIPTION	BY	DATE	APPVD.
1	FOOTAGE UPDATE	RAM	4/15/13	pk
2	ALLEY LOCATION RE-DESIGN	TCT	4/10/13	
3	REVISED PROPOSED DESIGN	TCT	2/28/13	2-28-13



UNIT NO.	UNIT TYPE	INSTL. PROPOSED	RET. COMPLETED
SEE SHEET 1			

AS-BUILT DRAWING-PRESSURE TEST DATA			
PIPE DIA.	TEST MEDIUM	TEST METHOD	
PIPE LENGTH	☐ AIR	☐ GAUGE	
PIPE TYPE	☐ NITROGEN	☐ CHART	
MIN. DURATION	☐ WATER	☐ GAUGE/	
	☐ SOAP	PRESS REC SN#	
TEST PRES. (PSIG)	START	END	
TIME			
DATE			
PERFORMED BY			

VISUAL INSPECTION CERTIFICATION	
I HAVE VISUALLY INSPECTED ALL HEATED FUSIONS, SOLVENT, MECHANICAL JOINTS, AND WELDS THAT I HAVE PERFORMED	
NAME	DATE
AS-BUILTS ACCEPTED BY	DATE
POSTED BY	DATE
POSTING QC'D BY	DATE

CONSTRUCTION	
INSPECTOR	
FOREMAN	
REVIEWED BY	
PERMIT INFORMATION	
CITY OF LAS VEGAS	
TAX CODE	
02-0203	

ISOLATION AREA	W. R. NO.
DIST 96	1536317
LOCATION	ATLAS #/TILE #
T20S R61E S34 M.D.M. NEVADA	x627y514 x627y512

ENGINEER/TECHNICIAN: BOB MIDDAG	PHONE 365-2071
ACCOUNT REP:	PHONE
PROJECT CONTACT:	PHONE
SHEET NO. 3 OF 6	SCALE 1"=30'
DWN. BY: ZONEENG	CHKD. BY
DATE 12-12-12	UPDATED
TITLE	
SI-CLV-GARCES AND ALLEY	
2" PVC REPLACEMENT	

REVISED

Repro