

DEPARTMENT OF PUBLIC WORKS

Mayor:
OSCAR B. GOODMAN

City Council:
GARY REESE (Mayor Pro-Tem)
STEVE WOLFSON
LOIS TARKANIAN
STEVEN D. ROSS
RICKI Y. BARLOW
STAVROS S. ANTHONY

City Manager:
ELIZABETH N. FRETWELL

Director of Public Works:
JORGE CERVANTES, P.E., P.T.O.E.

City Engineer:
DAVID BOWERS, P.E., P.T.O.E.



TAND, INC
AS-BUILT

2-28-13
DATE

DANIEL MEYER

HUNTRIDGE PHASE 6 STREET REHABILITATION (CLV TARGETED NEIGHBORHOOD) BID NO. 10.1730.07

Reviewed By:

Dave Jim 6/8/11
CLV CITY ENGINEER DATE

Mike Jones 5/25/11
CLV PROJECT MANAGER DATE

Mike Jones 6/1/11
CLV CITY TRAFFIC ENGINEER DATE

Mike Jones 6-1-11
CLV CONSTRUCTION MANAGER DATE

Kyma 6/6/11
LAS VEGAS FIRE & RESCUE DATE

Roger Rasmussen 6/6/11
SOUTHWEST GAS CORPORATION DATE

Mark Kayser 5/26/11
CENTURY LINK DATE

THE AFFIXED CENTURY LINK NEVADA APPROVAL DOES NOT ASSUME OR GUARANTEE LIABILITY FOR KNOWN OR UNKNOWN CONFLICTS WITH EXISTING OR PROPOSED IMPROVEMENTS. RESOLUTION OF ANY CONFLICT WILL BE ACCOMPLISHED PURSUANT TO LOCAL ORDINANCES, NEVADA REVISED STATUTES AND/OR PUBLIC UTILITY COMMISSION STANDARD REGULATIONS.

Dan P. 5/26/11
COX COMMUNICATIONS, Las Vegas, NV DATE

Dora Gregory
LAS VEGAS VALLEY WATER DISTRICT ENGINEERING SERVICE MANAGER
DATE 5/26/11 PROJECT NO. 114579
SHEETS SH#1-SH#3, DT 1, DT 2, C1-C27, UT1-UT4

Barbara Garrison 5-26-11
NV ENERGY - DISTRIBUTION DATE
NV ENERGY ACKNOWLEDGES THAT WE HAVE RECEIVED YOUR PLANS AND WILL PROVIDE SERVICE TO ALL ELECTRICAL NEEDS ASSOCIATED WITH THIS PROJECT. NEVADA POWER COMPANY RESERVES THE RIGHT TO ADDRESS ANY EXISTING OR FUTURE CONFLICTS ONCE THE FINAL DESIGN IS COMPLETED. THE NEW SERVICE AND THE RESOLUTION OF ANY CONFLICTS WILL BE ACCOMPLISHED PURSUANT TO THE NEVADA PUBLIC UTILITY COMMISSION'S RULES AND REGULATIONS.

N/A
NV ENERGY - TRANSMISSION DATE

THE SIGNATURE ABOVE ACKNOWLEDGES THAT THE UTILITY COMPANY REPRESENTATIVE HAS REVIEWED THE PLANS, AND THAT TO THE BEST OF HIS OR HER KNOWLEDGE THE UTILITY LINES ARE SHOWN IN THE CORRECT LOCATIONS AND ARE THE CORRECT SIZES. WHILE SUCH DATA HAS BEEN COLLECTED WITH REASONABLE CARE, THERE IS NO EXPRESSED OR IMPLIED GUARANTEE THAT THE LOCATIONS ARE EXACT. THE CONTRACTOR SHALL BEAR THE RESPONSIBILITY OF OBTAINING THE ACTUAL FIELD LOCATIONS.


THE SIGNATURE ABOVE FURTHER ACKNOWLEDGES THAT THE UTILITY COMPANY DOES NOT ANTICIPATE CONSTRUCTION OR MAINTENANCE IN THE PROJECT AREA FOR FIVE (5) YEARS IN CONFORMANCE WITH THE CLV NO-CUT POLICY.

Funded By:
CITY OF LAS VEGAS

REVISIONS	NO.	DATE	SHEET	DESCRIPTION	APP'D

DEPARTMENT OF PUBLIC WORKS	CITY ENGINEER: DAVID BOWERS, P.E.	DATE: APRIL 2011
CAPITAL PROJECT MANAGEMENT	PROGRAM MANAGER: MARK SORESEN, P.E.	
	DESIGNED BY: RG	
	DRAWN BY: RG	
	CHECKED BY: CWP	

HUNTRIDGE PHASE 6 STREET REHABILITATION	COVER SHEET
TITLE:	SHEET:

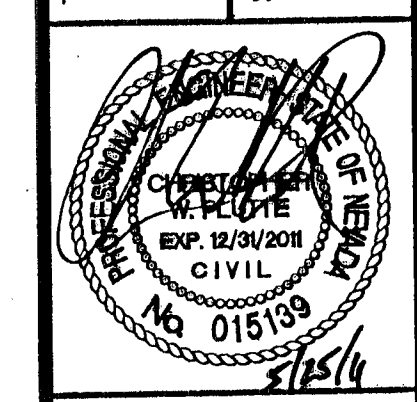

Sheet	SH 1
	1 of 38
DRAWING NO.	107V-3027-6

HANSEN NO. 18931