


SHEET INDEX

SHEET	DESCRIPTION
1 SH 1	COVER SHEET
2 SH 2	NOTES
3 SH 3	SHEET INDEX AND LVWD SERVICE ACCOUNTS
4 SH 4	HORIZONTAL CONTROL PLAN
5 DT 1	TYPICAL SECTIONS
6 DT 2	DETAILS
7 C 1	PARK PASEO PLAN AND PROFILE STA: 38+38.6 TO STA: 45+81.81
8 C 2	SWEENEY AVENUE PLAN AND PROFILE STA: 47+00 TO STA: 52+63.69
9 C 3	BRACKEN AVENUE (WEST) PLAN AND PROFILE STA: 53+00 TO STA: 57+18.36
10 C 4	BRACKEN AVENUE (EAST) PLAN AND PROFILE STA: 58+00 TO STA: 64+00
11 C 5	BRACKEN AVENUE (EAST) PLAN AND PROFILE STA: 64+00 TO STA: 69+45.38
12 C 6	GRIFFITH AVENUE (WEST) PLAN AND PROFILE STA: 70+00 TO STA: 74+50
13 C 7	GRIFFITH AVENUE (WEST) PLAN AND PROFILE STA: 74+50 TO STA: 78+53.31
14 C 8	GRIFFITH AVENUE (EAST) PLAN AND PROFILE STA: 79+00 TO STA: 84+50
15 C 9	GRIFFITH AVENUE (EAST) PLAN AND PROFILE STA: 84+50 TO STA: 87+40.56
16 C 10	REXFORD PLACE PLAN AND PROFILE STA: 0+00 TO STA: 8+50
17 C 11	REXFORD PLACE PLAN AND PROFILE STA: 8+50 TO STA: 11+50
18 C 12	REXFORD PLACE PLAN AND PROFILE STA: 11+50 TO STA: 14+73.81
19 C 13	HOUSSELS AVENUE PLAN AND PROFILE STA: 103+00 TO STA: 110+00
20 C 14	HOUSSELS AVENUE PLAN AND PROFILE STA: 110+00 TO STA: 117+28.99
21 C 15	5TH PLACE PLAN AND PROFILE STA: 118+00 TO STA: 125+00
22 C 16	5TH PLACE PLAN AND PROFILE STA: 125+00 TO STA: 132+00
23 C 17	5TH PLACE PLAN AND PROFILE STA: 132+00 TO STA: 138+27.43
24 C 18	6TH STREET PLAN AND PROFILE STA: 10+00 TO STA: 17+00
25 C 19	6TH STREET PLAN AND PROFILE STA: 17+00 TO STA: 24+00
26 C 20	6TH STREET PLAN AND PROFILE STA: 24+00 TO STA: 31+00
27 C 21	6TH STREET PLAN AND PROFILE STA: 31+00 TO STA: 36+61.6
28 C 22	7TH STREET PLAN AND PROFILE STA: 139+00 TO STA: 146+00
29 C 23	7TH STREET PLAN AND PROFILE STA: 146+00 TO STA: 152+34.27
30 C 24	8TH STREET PLAN AND PROFILE STA: 153+00 TO STA: 160+00
31 C 25	8TH STREET PLAN AND PROFILE STA: 160+00 TO STA: 166+09.75
32 C 26	9TH STREET PLAN AND PROFILE STA: 167+00 TO STA: 171+00
33 C 27	9TH STREET PLAN AND PROFILE STA: 171+00 TO STA: 174+99.91
34 C-28	OAKLEY BOULEVARD AND REXFORD PLACE SEWER MODIFICATION
35 UT-1	LVWD WATER PLAN - LEGEND, NOTES, QUANTITIES
36 UT-2	LVWD WATER PLAN - 6TH STREET, STA: 24+00 TO STA: 36+46
37 UT-3	LVWD WATER PLAN - 6TH STREET, STA: 24+00 TO STA: 10+16
38 UT-4	LVWD WATER PLAN - PARK PASEO, STA: 38+00 STA: 44+50

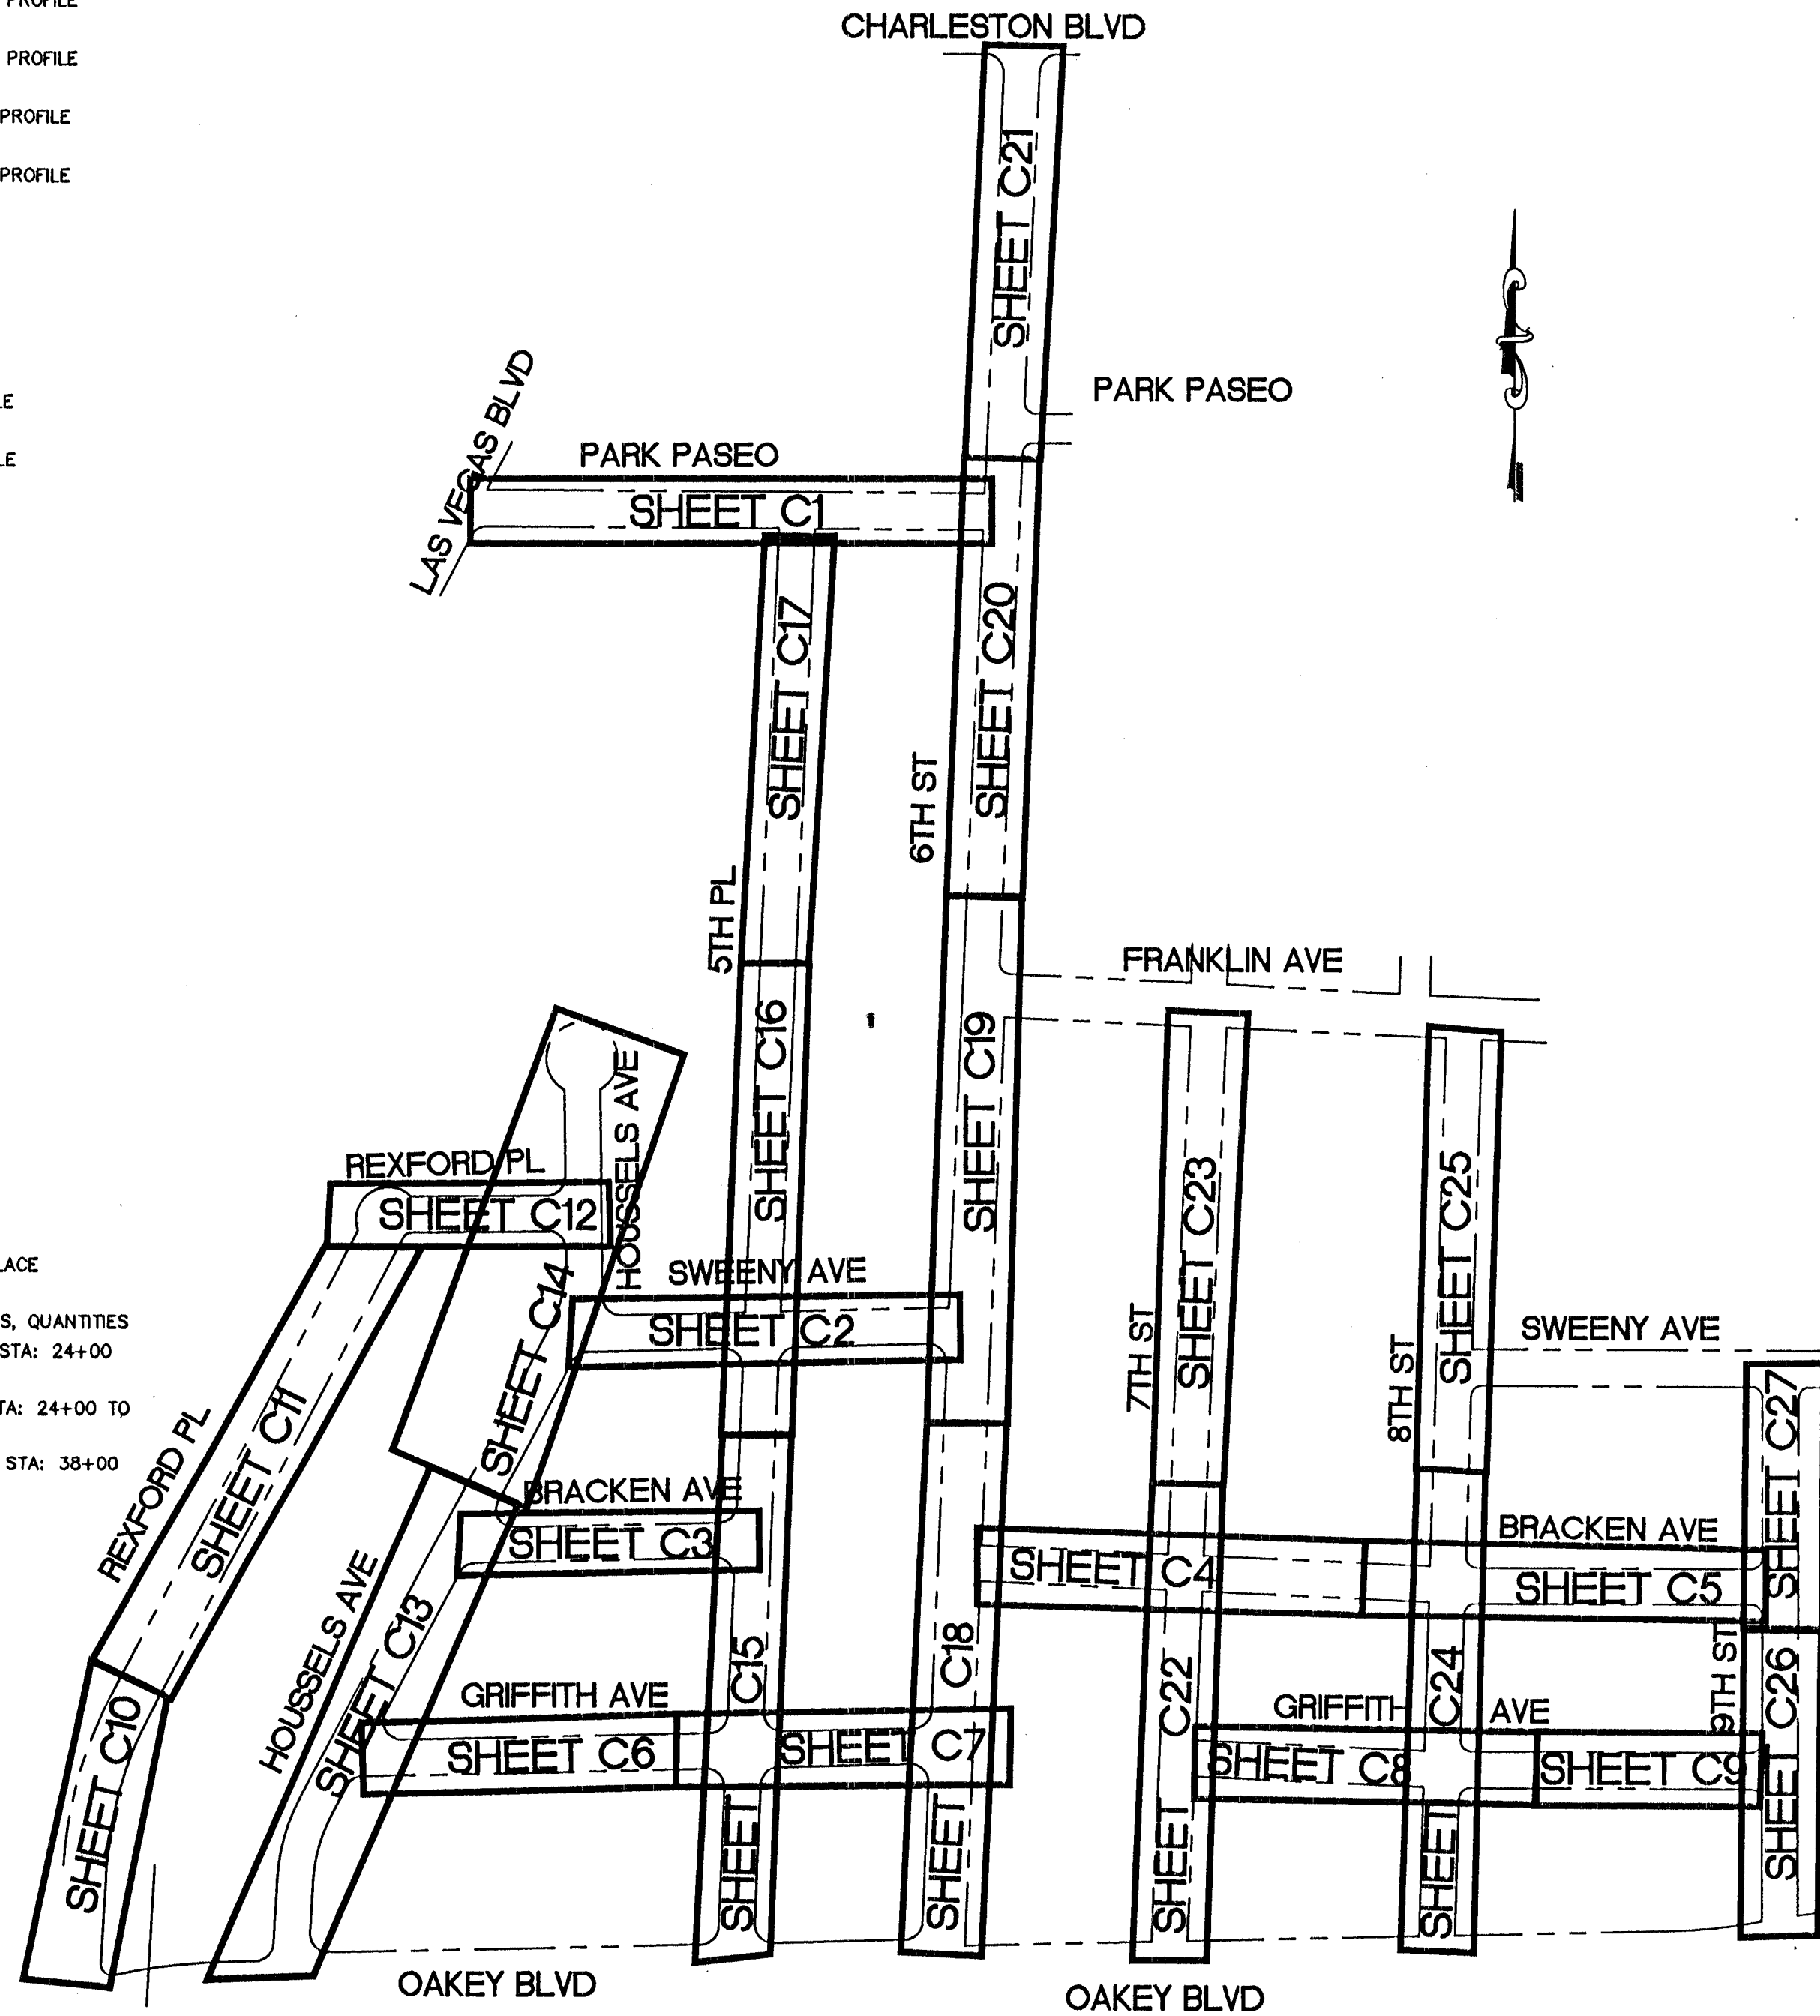

**HUNTRIDGE PHASE 6
STREET REHABILITATION
LAS VEGAS VALLEY WATER DISTRICT SERVICE ACCOUNT LIST**

ADDRESS	SERVICE TYPE	ACCT.#	ADDRESS	SERVICE TYPE	ACCT.#	ADDRESS	SERVICE TYPE	ACCT.#
550 E Charleston	Poly	126392	554 Cahey Blvd	??	5516	1510 Rexford Pl	Copper	12206
600 E Charleston	Copper	3691	552 Cahey Blvd	Copper	5515	1506 Rexford Pl	Copper	12207
1013 S 6th St	Poly	8839	550 Cahey Blvd	Copper	5514	1488 Rexford Pl	Copper	12209
1044 S 6th St	Poly	5664	551 Cahey Blvd	Copper	5527	1410 Rexford Pl	Copper	12211
1103 S 6th St	Copper	82461	613 Cahey Blvd	Copper	6667	1417 Rexford Pl	Copper	12233
1105 S 6th St	Poly	21058	617 Cahey Blvd	??	6665	1405 Rexford Pl	Copper	12230
1107 S 6th St	Poly	6042	705 Cahey Blvd	Copper	6671	523 Rexford Pl	Copper	12200
1111 S 6th St	Poly	6047	711 Cahey Blvd	Copper	6672	1304 7th St	Poly	10470
1119 S 6th St	Poly	6005	715 Cahey Blvd	Copper	6673	1312 7th St	Poly	10479
1127 S 6th St	Poly	6046	719 Cahey Blvd	Copper	6674	1320 7th St	Poly	10477
1133 S 6th St	Poly	6004	801 Cahey Blvd	Copper	5552	1330 7th St	Poly	10480
1137 S 6th St	Poly	6001	807 Cahey Blvd	Copper	5560	1470 7th St	Poly	6224
1141 S 6th St	Copper	6002	811 Cahey Blvd	Copper	5503	1480 7th St	Poly	6259
1255 S 6th St	Copper	6036	821 Cahey Blvd	Copper	5561	1321 7th St	Poly	10472
1102 S 6th St	Poly	6635	825 Cahey Blvd	Copper	5567	1311 7th St	Poly	10474
1112 S 6th St	Poly	6740	829 Cahey Blvd	Copper	5521	1321 7th St	Poly	10480
1122 S 6th St	Copper	6622	1611 Houssels Ave	Copper	18059	1329 7th St	Poly	10476
1126 S 6th St	Copper	6621	1611 Houssels Ave	Copper	18057	1469 7th St	Poly	6253
1130 S 6th St	Poly	6637	1505 Houssels Ave	Copper	18047	1475 7th St	Poly	6257
1140 S 6th St	Poly	6638	1401 Houssels Ave	Copper	18040	1479 7th St	Poly	6255
1144 S 6th St	Poly	6639	1400 Houssels Ave	Copper	18065	1489 7th St	Poly	6256
1301 S 6th St	Poly	146650	1404 Houssels Ave	Copper	18064	1490 7th St	Poly	6221
1301 S 6th St	Poly	146649	1408 Houssels Ave	Copper	18039	1500 7th St	Poly	5500
1317 S 6th St	Poly	10467	1508 Houssels Ave	Copper	18034	1504 7th St	Copper	5563
1325 S 6th St	Poly	10469	1510 Houssels Ave	Copper	18033	1530 7th St	Copper	5561
1401 S 6th St	??	6220	1611 Houssels Ave	Copper	18059	1308 8th St	Poly	6251
1403 S 6th St	Poly	6223	1612 Houssels Ave	Copper	18026	1312 8th St	Poly	29168
1409 S 6th St	Poly	6226	1616 Houssels Ave	Copper	18027	1316 8th St	Poly	6252
1501 S 6th St	Copper	5502	546 Griffith Ave	Copper	18058	1360 8th St	Poly	6250
1509 S 6th St	Copper	5502	548 Griffith Ave	Copper	18059	1410 8th St	Poly	6260
1601 S 6th St	Copper	5524	550 Griffith Ave	Copper	18050	1420 8th St	Poly	6258
1609 S 6th St	Copper	5520	552 Griffith Ave	??	18061	1467 8th St	Poly	6601
1611 S 6th St	Copper	5571	547 Griffith Ave	Copper	18056	1461 8th St	Poly	6600
1302 S 6th St	Poly	10471	549 Griffith Ave	Copper	18054	718 9th St	Poly	6655
1308 S 6th St	Poly	10475	555 Griffith Ave	Copper	18053	1423 9th St	Poly	6612
1312 S 6th St	Poly	82467	620 Griffith Ave	Copper	6656	1411 9th St	Copper	6613
1314 S 6th St	Copper	10473	616 Griffith Ave	Copper	6657	1415 9th St	Copper	6614
1324 S 6th St	Copper	10478	612 Griffith Ave	Copper	6636	1501 9th St	Poly	6615
1400 S 6th St	Copper	18015	808 Griffith Ave	Copper	6635	908 9th St	Copper	6611
1404 S 6th St	Copper	18016	804 Griffith Ave	Copper	6634	1607 9th St	Copper	6632
1408 S 6th St	Copper	18017	800 Griffith Ave	Copper	6633	1601 9th St	Copper	6631
1500 S 6th St	Copper	18018	718 Griffith Ave	Copper	6655	1513 9th St	Copper	6630
1504 S 6th St	Copper	18019	714 Griffith Ave	Copper	6654	1509 9th St	??	6629
1508 S 6th St	Copper	18020	710 Griffith Ave	Copper	6653	1505 9th St	Copper	6616
1600 S 6th St	Copper	18024	821 Griffith Ave	Copper	6623	811 Sweeney Ave	Copper	1812
1608 S 6th St	Copper	18025	817 Griffith Ave	Copper	6624	808 Sweeney Ave	Poly	6603
1100 S 5th Pl	??	618609	813 Griffith Ave	Copper	6625	812 Sweeney Ave	Copper	6604
1108 S 5th Pl	??	6645	809 Griffith Ave	Copper	6626	816 Sweeney Ave	Copper	6605
1110 S 5th Pl	Poly	6769	806 Griffith Ave	Copper	6627	820 Sweeney Ave	??	6606
1112 S 5th Pl	Poly	6643	801 Griffith Ave	Copper	6628	1475 Sweeney Ave	??	6602
1114 S 5th Pl	Poly	6636	719 Griffith Ave	Copper	6660			
1118 S 5th Pl	Poly	6642	715 Griffith Ave	Copper	6659			
1122 S 5th Pl	Poly	6641	711 Griffith Ave	Copper	6658			
1234 S 5th Pl	Poly	6756	705 Griffith Ave	Copper	6657			
1300 S 5th Pl	Poly	6680	701 Griffith Ave	Copper	6656			
1310 S 5th Pl	Poly	6681	700 Griffith Ave	Copper	6651			
1314 S 5th Pl	Poly	6682	548 Bracken Ave	Copper	6652			
1324 S 5th Pl	Poly	6683	550 Bracken Ave	Copper	18048			
1332 S 5th Pl	Poly	6684	552 Bracken Ave	Copper	18050			
1331 S 5th Pl	Poly	5531	551 Bracken Ave	Copper	18045			
1315 S 5th Pl	Poly	5506	700 Bracken Ave	??	6665			
1311 S 5th Pl	Poly	5559	706 Bracken Ave	Copper	6664			
1301 S 5th Pl	Poly	5508	710 Bracken Ave	Copper	6663			
1139 S 5th Pl	Poly	146666	714 Bracken Ave	Copper	6662			
1139 S 5th Pl	Poly	146667	738 Bracken Ave	Copper	6661			
1135 S 5th Pl	Poly	6634	815 Bracken Ave	Copper	6668			
1115 S 5th Pl	Poly	146635	804 Bracken Ave	Copper	6618			
1111 S 5th Pl	Poly	6632	808 Bracken Ave	Copper	6619			
1107 S 5th Pl	Poly	6631	807 Bracken Ave	Copper	6610			
1101 S 5th Pl	Poly	6622	811 Bracken Ave	Copper	6609			
1400 S 5th Pl	Copper	18042	819 Bracken Ave	Copper	6607			
559 S 5th Pl	Copper	18043	816 Bracken Ave	Copper	6621			
1506 S 5th Pl	Copper	18052	1500 Bracken Ave	Copper	6622			
1612 S 5th Pl	Copper	18063	1300 Rexford Pl	Copper	12223			
1611 S 5th Pl	Copper	18021	1302 Rexford Pl	Copper	12222			
1605 S 5th Pl	Copper	18022	1318 Rexford Pl	Copper	12218			
1601 S 5th Pl	Copper	18023	1315 Rexford Pl	Copper	12224			
1509 S 5th Pl	??	18009	1517 Rexford Pl	Copper	12236			
1503 S 5th Pl	Copper	18010	1513 Rexford Pl	Copper	12237			
1407 S 5th Pl	Copper	18012	1509 Rexford Pl	Copper	12236			
1403 S 5th Pl	Copper	18013	1506 Rexford Pl	Copper	12232			
1401 S 5th Pl	Copper	18014	1514 Rexford Pl	Copper	12235			

TAND, INC.
AS-BUILT
DATE: 2/28/13
DANIEL MEYER

APPROVED FOR CONSTRUCTION
D. J. ...
LAS VEGAS VALLEY WATER DISTRICT ENGINEERING SERVICE MANAGER
DATE: 01/27/14 PROJECT NO. 114529

REVISIONS	NO.	DATE	DESCRIPTION

DEPARTMENT OF PUBLIC WORKS
CAPITAL PROJECT MANAGEMENT
CITY ENGINEER: DAVID BOWERS, P.E.
PROGRAM MANAGER: MARK SORENSEN, P.E.
DESIGNED BY: RG
DRAWN BY: RG
CHECKED BY: CWP
DATE: APRIL 2011

HUNTRIDGE PHASE 6
STREET REHABILITATION
SHEET INDEX AND LVWD SERVICE ACCOUNTS

TITLE: SHEET INDEX AND LVWD SERVICE ACCOUNTS

PROFESSIONAL ENGINEER
CHRISTOPHER W. PLUTTE
EXP. 12/28/2010
No. 015138
6664

Sheet
SH 3
3 of 38
DRAWING NO.
107V-3027-6