
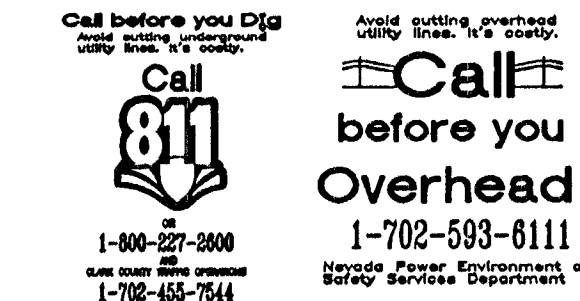
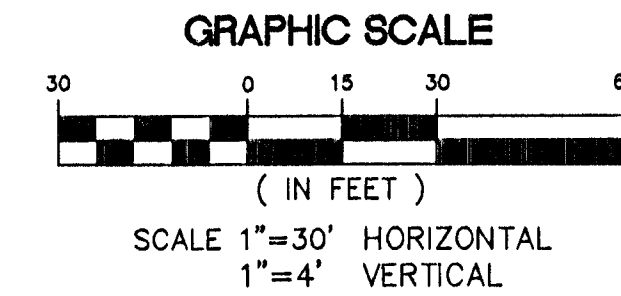


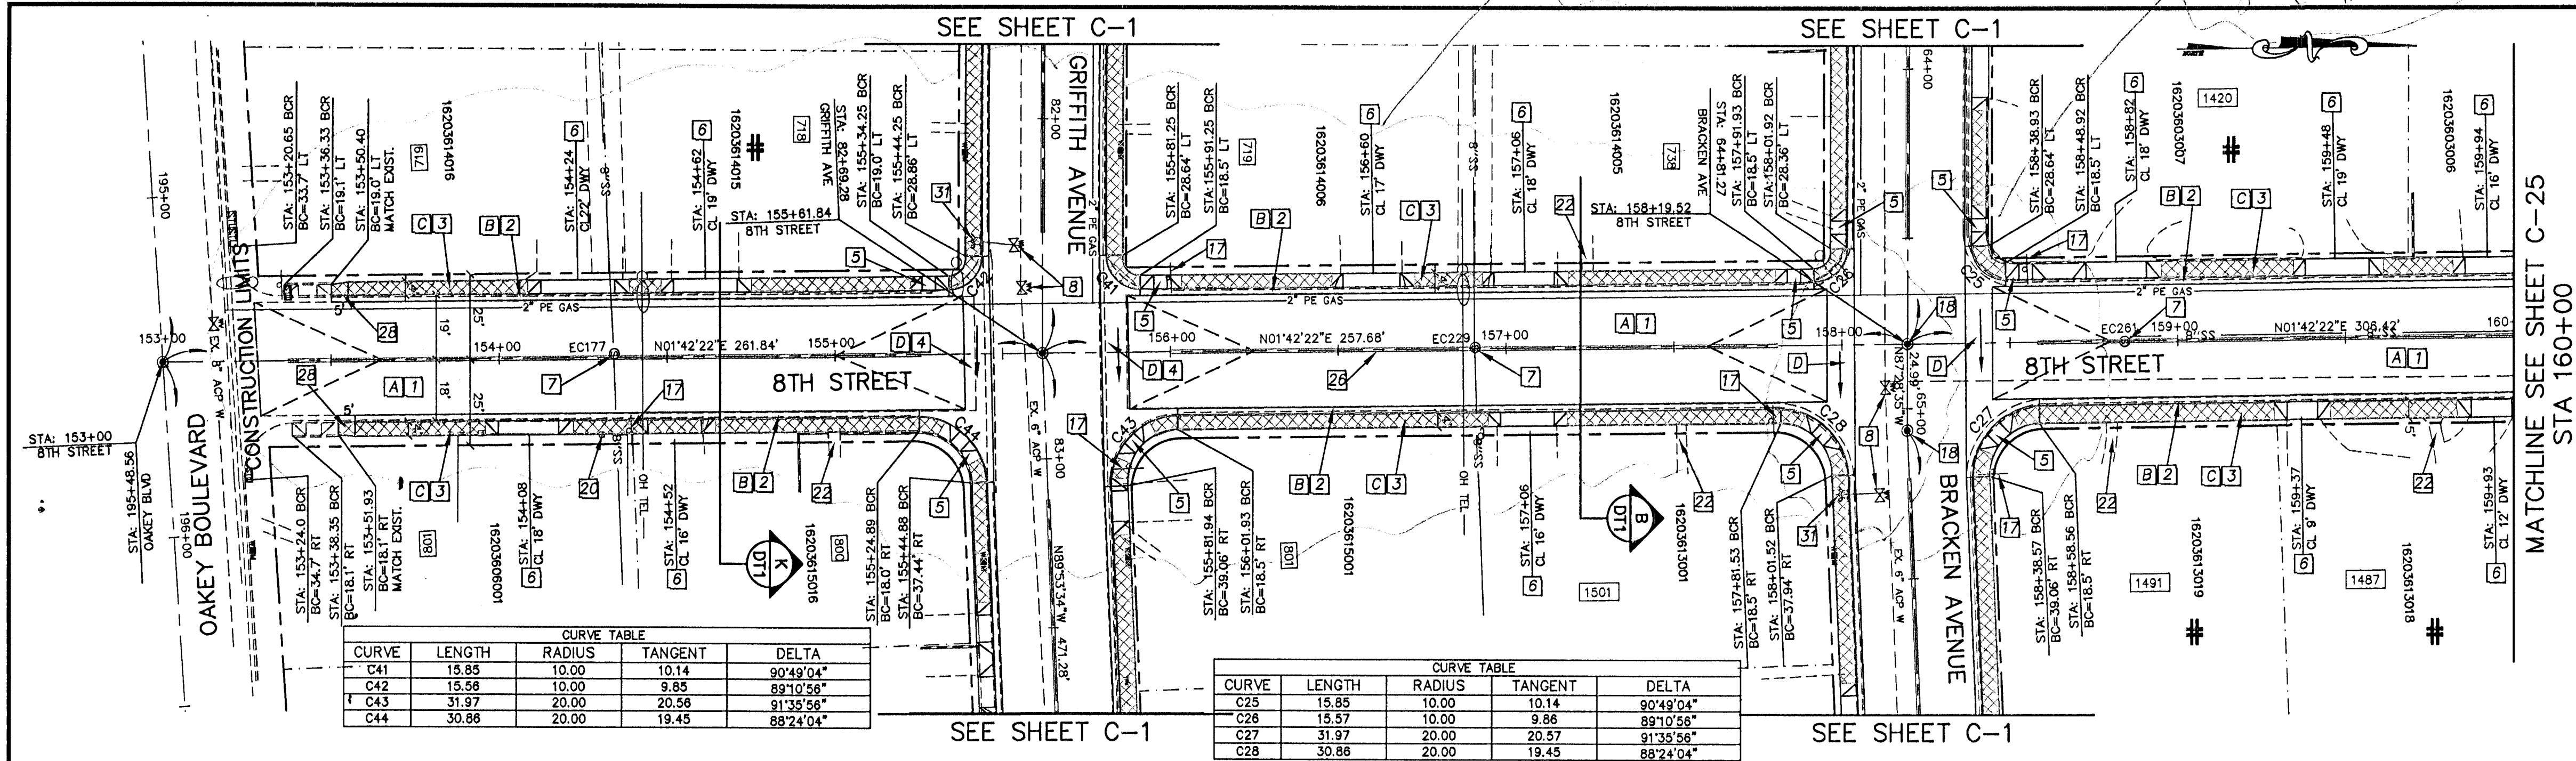

BASIS OF BEARINGS

CENTERLINE OF 8TH ST. BEARS N 01°42'22" E, BETWEEN OAKLEY BLVD AND SWEENEY AVE, AS SHOWN ON THE RECORD OF SURVEY FOR THE CITY OF LAS VEGAS, RECORDED IN FILE 80 OF SURVEYS, PAGE 46, CLARK COUNTY, NEVADA, RECORDS.

BENCHMARK

CLV BM OAKLEY 5 J: RIVET & PLATE IN TOP OF CURB, NE CORNER OF OAKLEY BLVD & LAS VEGAS BLVD ELEV. 2030.80' (NAVD88)

CAUTION


EXISTING UTILITIES ARE LOCATED ON THE PLANS FROM A SEARCH OF AVAILABLE RECORDS. CONTRACTOR TO VERIFY LOCATIONS AND DEPTHS PRIOR TO CONSTRUCTION.

REMOVAL ITEMS

- A REMOVE EXISTING AC SIDEWALK/DRIVEWAY.
- B REMOVE EXISTING CURB & GUTTER.
- C REMOVE EXISTING CONC. SIDEWALK/DRIVEWAY.
- D REMOVE EXISTING CROSS GUTTER.
- E REMOVE EXISTING TREE.
- F REMOVE EXISTING DROP INLET.
- G REMOVE BLOCK WALL.

CONSTRUCTION ITEMS

- 1 CONSTRUCT STRUCTURAL SECTION PER TYPICAL SECTION ON SHEET DT 1.
- 2 CONSTRUCT 'L' TYPE CURB & GUTTER PER STD. DWG. #216.
- 3 CONSTRUCT SIDEWALK PER STD. DWG. #234.
- 4 CONSTRUCT 8" CROSS GUTTER PER STD. DWG. #228.
- 5 CONSTRUCT SIDEWALK RAMP, CASE III PER STD. DWG. #235 (A AND B=5').
- 6 CONSTRUCT RESIDENTIAL DRIVEWAY PER STD. DWG. #222 AND #223.
- 7 REMOVE EXISTING BRICK SANITARY SEWER MANHOLE AND REPLACE PER DCSWCS DWG # SD-1A & SD-7 & SD-7 (TYP) (48"Ø). SALVAGE MANHOLE COVER AND RING.
- 8 ADJUST WATER VALVE BOX TO FINISH GRADE PER UDACS PLATE NO. 39. VALVE SHALL BE ACCESSIBLE AT ALL TIMES.
- 9 REMOVE & REPLACE WATER METER BOX PER UDACS PLATE 2. RELOCATE PULLBOX, INTERCEPT SERVICE CONNECTION AS NEEDED.
- 10 RELOCATE FIRE HYDRANT PER UDACS PLATE #40.
- 11 CONSTRUCT COMMERCIAL DRIVEWAY PER STD. DWG. #224.
- 12 CONSTRUCT ALLEY DRIVEWAY PER STD. DWG. #227. RETROFIT WATER SERVICE PER LVWD DETAIL ON SHEET DT 2.
- 13 NOT USED.
- 14 CONSTRUCT CONCRETE DRIVEWAY TRANSITION. MATCH EXISTING THICKNESS (4" MIN.) AND EXISTING WIDTH. SEE DETAIL "S" ON SHEET DT 2.
- 15 RELOCATE STREET SIGN AND POST PER STD. DWG. #249 AND #249A.
- 16 REPLACE MONUMENT PER STD. DWG. #239, #241 AND #242.
- 17 REMOVE AND REPLACE STREETLIGHT ASSEMBLY PER STD. DWG. #314 AND #320.
- 18 REMOVE & RELOCATE EXISTING WROUGHT IRON FENCE TO BACK OF WALK. MATCH EXISTING.
- 19 CONSTRUCT BLOCK WALL AT BACK OF WALK PER CLV BUILDING AND SAFETY STANDARDS, MATCH EXISTING FINISH AND HEIGHT.
- 20 CONSTRUCT CONCRETE WALKWAY TRANSITION, 4" MINIMUM THICKNESS AND MATCH WIDTH. MAXIMUM 8.0% SLOPE.
- 21 REMOVE AND REPLACE SPEED HUMP PER DETAIL "R" ON SHEET DT 2.
- 22 CONSTRUCT SIDEWALK AROUND OBSTRUCTION PER STD. DWG #234. SEE DETAIL "T" ON SHEET DT 2.
- 23 INSTALL TYPE II WHITE COLD POLYMER CROSSWALK PER STD. DWG. #254A.
- 24 INSTALL TYPE II YELLOW COLD POLYMER CENTERLINE PER MUTCD FIGURE 3B-1A.
- 25 REMOVE AND RESET NEWSPAPER RACK. MATCH EXISTING.
- 26 SIDEWALK/GUTTER TRANSITION PER STD DWG #216 AND #214.
- 27 ADJUST GAS VALVE BOX PER STD DWG #517. CONTRACTOR TO COORDINATE WITH SOUTHWEST GAS.
- 28 ADJUST TO GRADE IRRIGATION PULLBOX & WATER METER BOX.
- 29 ADJUST TO GRADE FIRE HYDRANT PER UDACS PLATE #40.

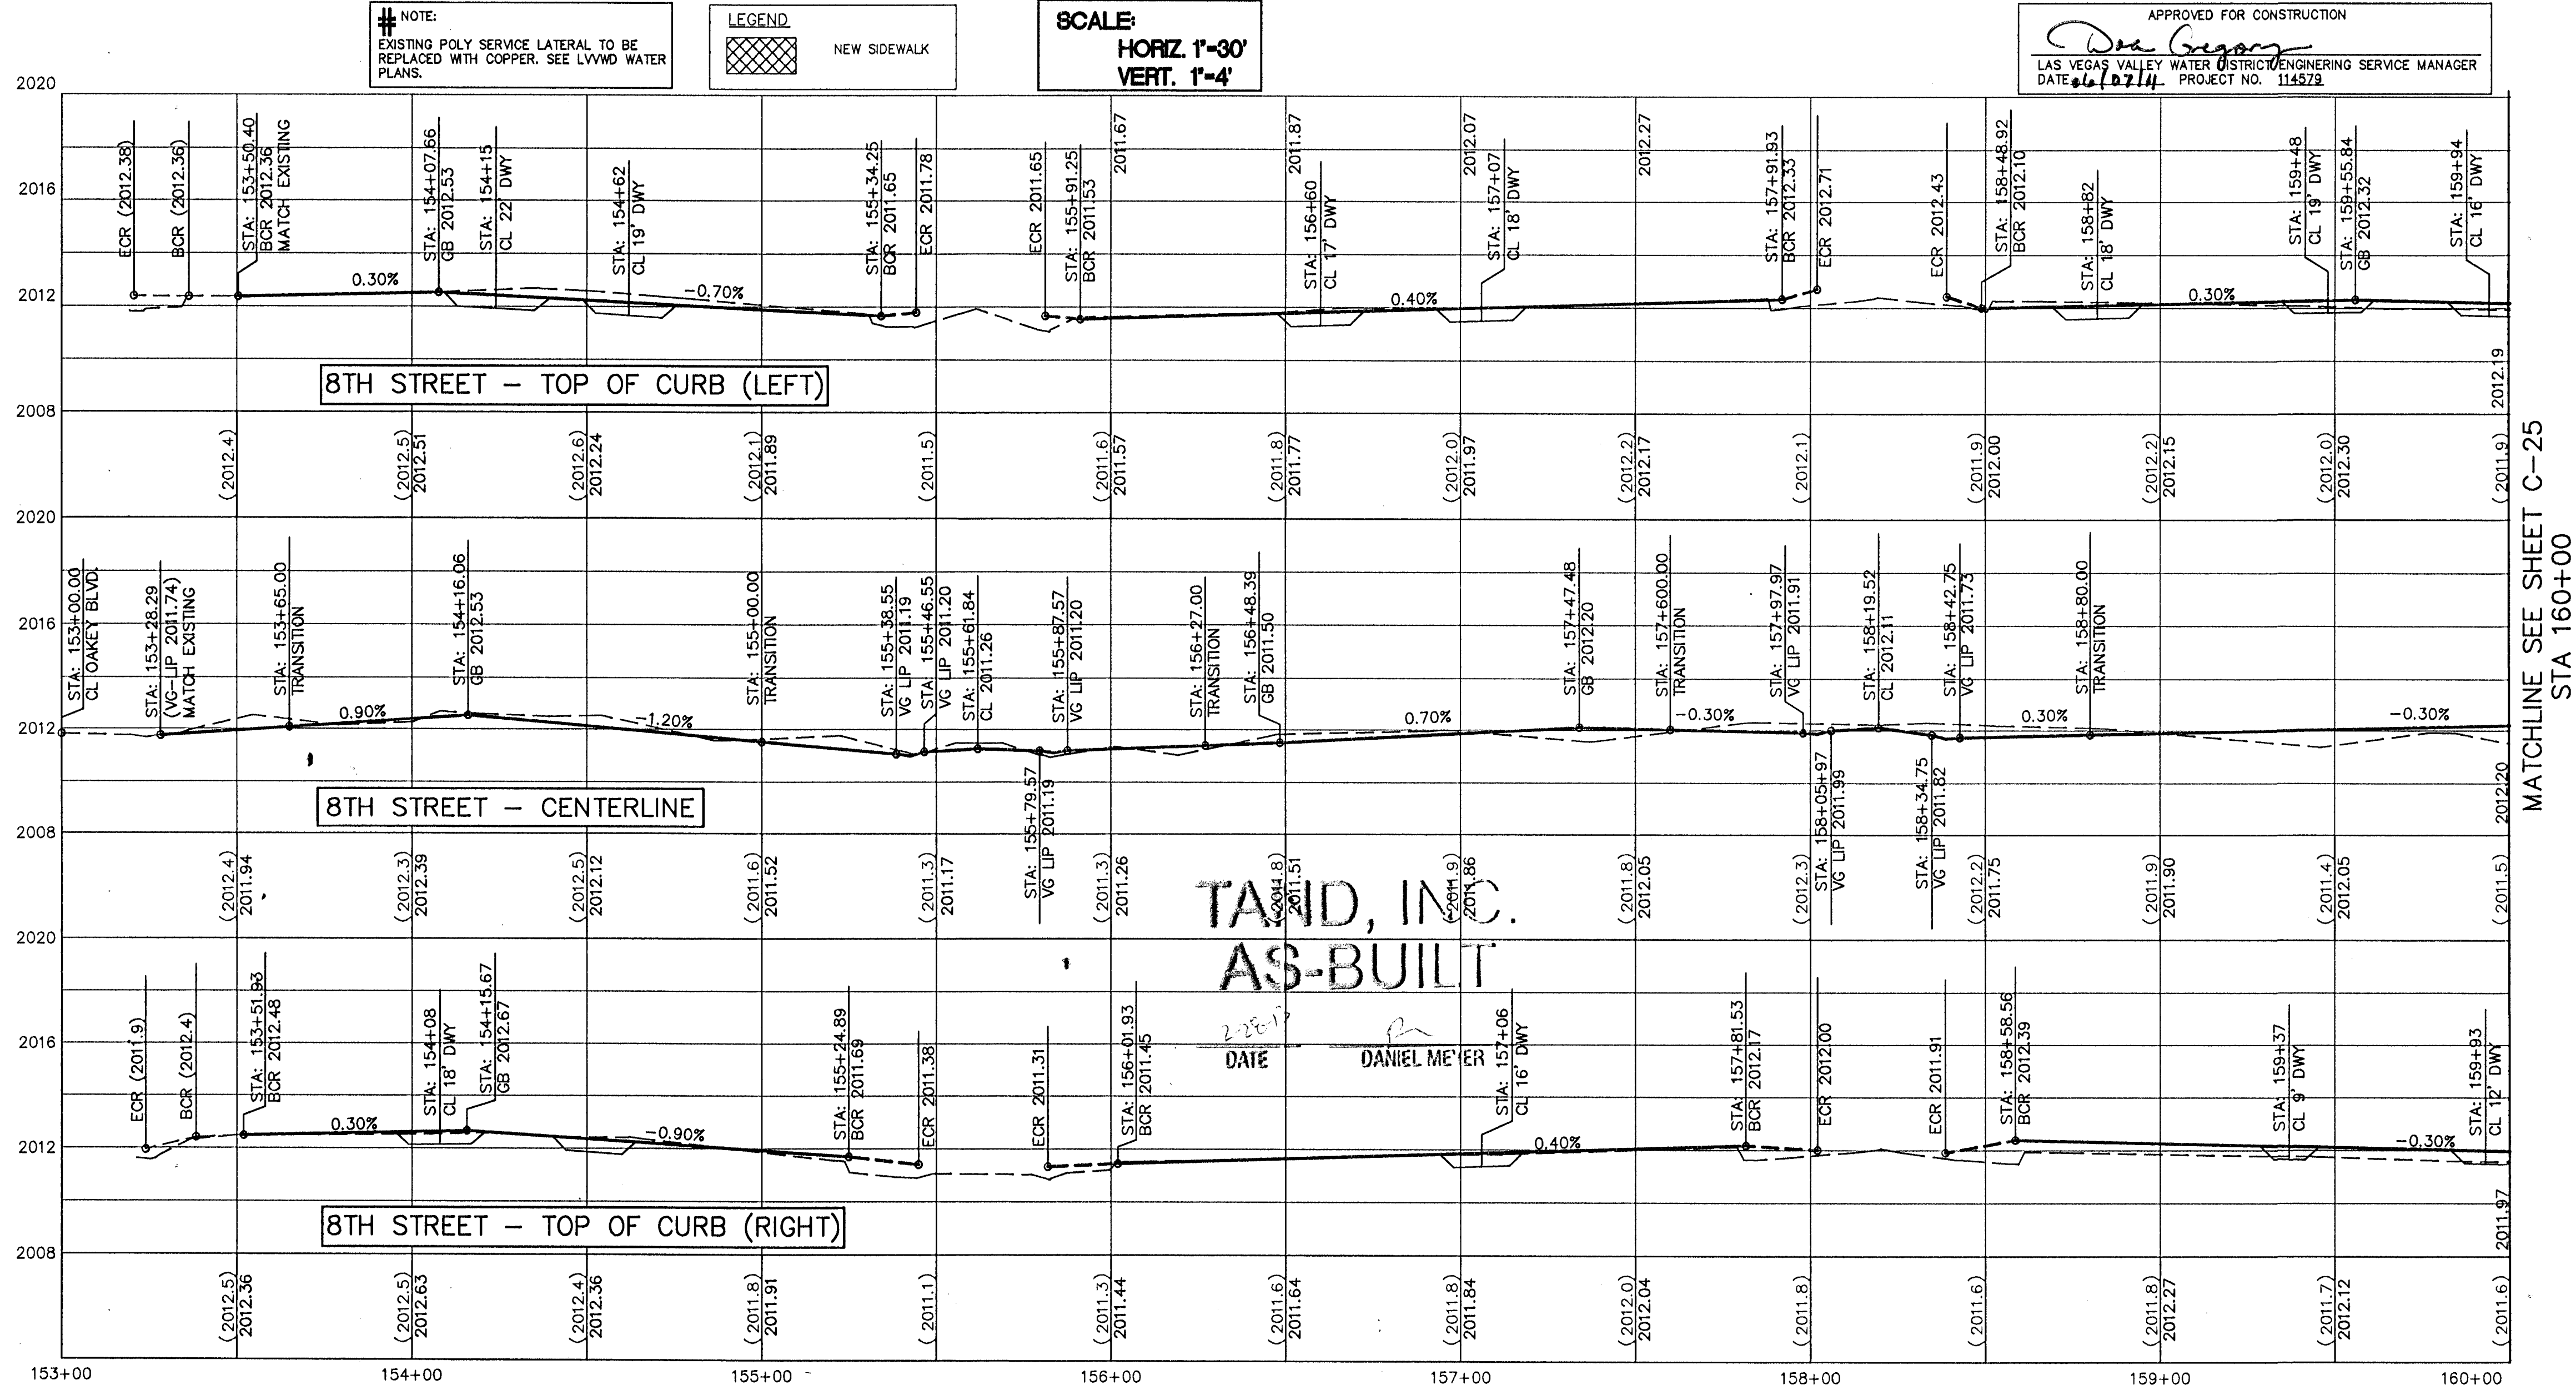

TAND, INC.
AS-BUILT

DATE DANIEL MEYER

NO.	DATE	DESCRIPTION	APP'D

DEPARTMENT OF PUBLIC WORKS
CAPITAL PROJECT MANAGEMENT
CITY ENGINEER: DAVID BOWERS, P.E.
PROGRAM MANAGER: MARK SORENSEN, P.E.
DESIGNED BY: RG
DRAWN BY: RG
CHECKED BY: CWP
DATE: APRIL 2011

HUNTRIDGE PHASE 6
STREET REHABILITATION
8TH STREET PLAN AND PROFILE
STA 153+00 TO 160+00

TITLE: SHEET: **C 24**
30 of 38
DRAWING NO. 107V-3027-6