


MATCH RIGHT

MATCH EXISTING PLANS

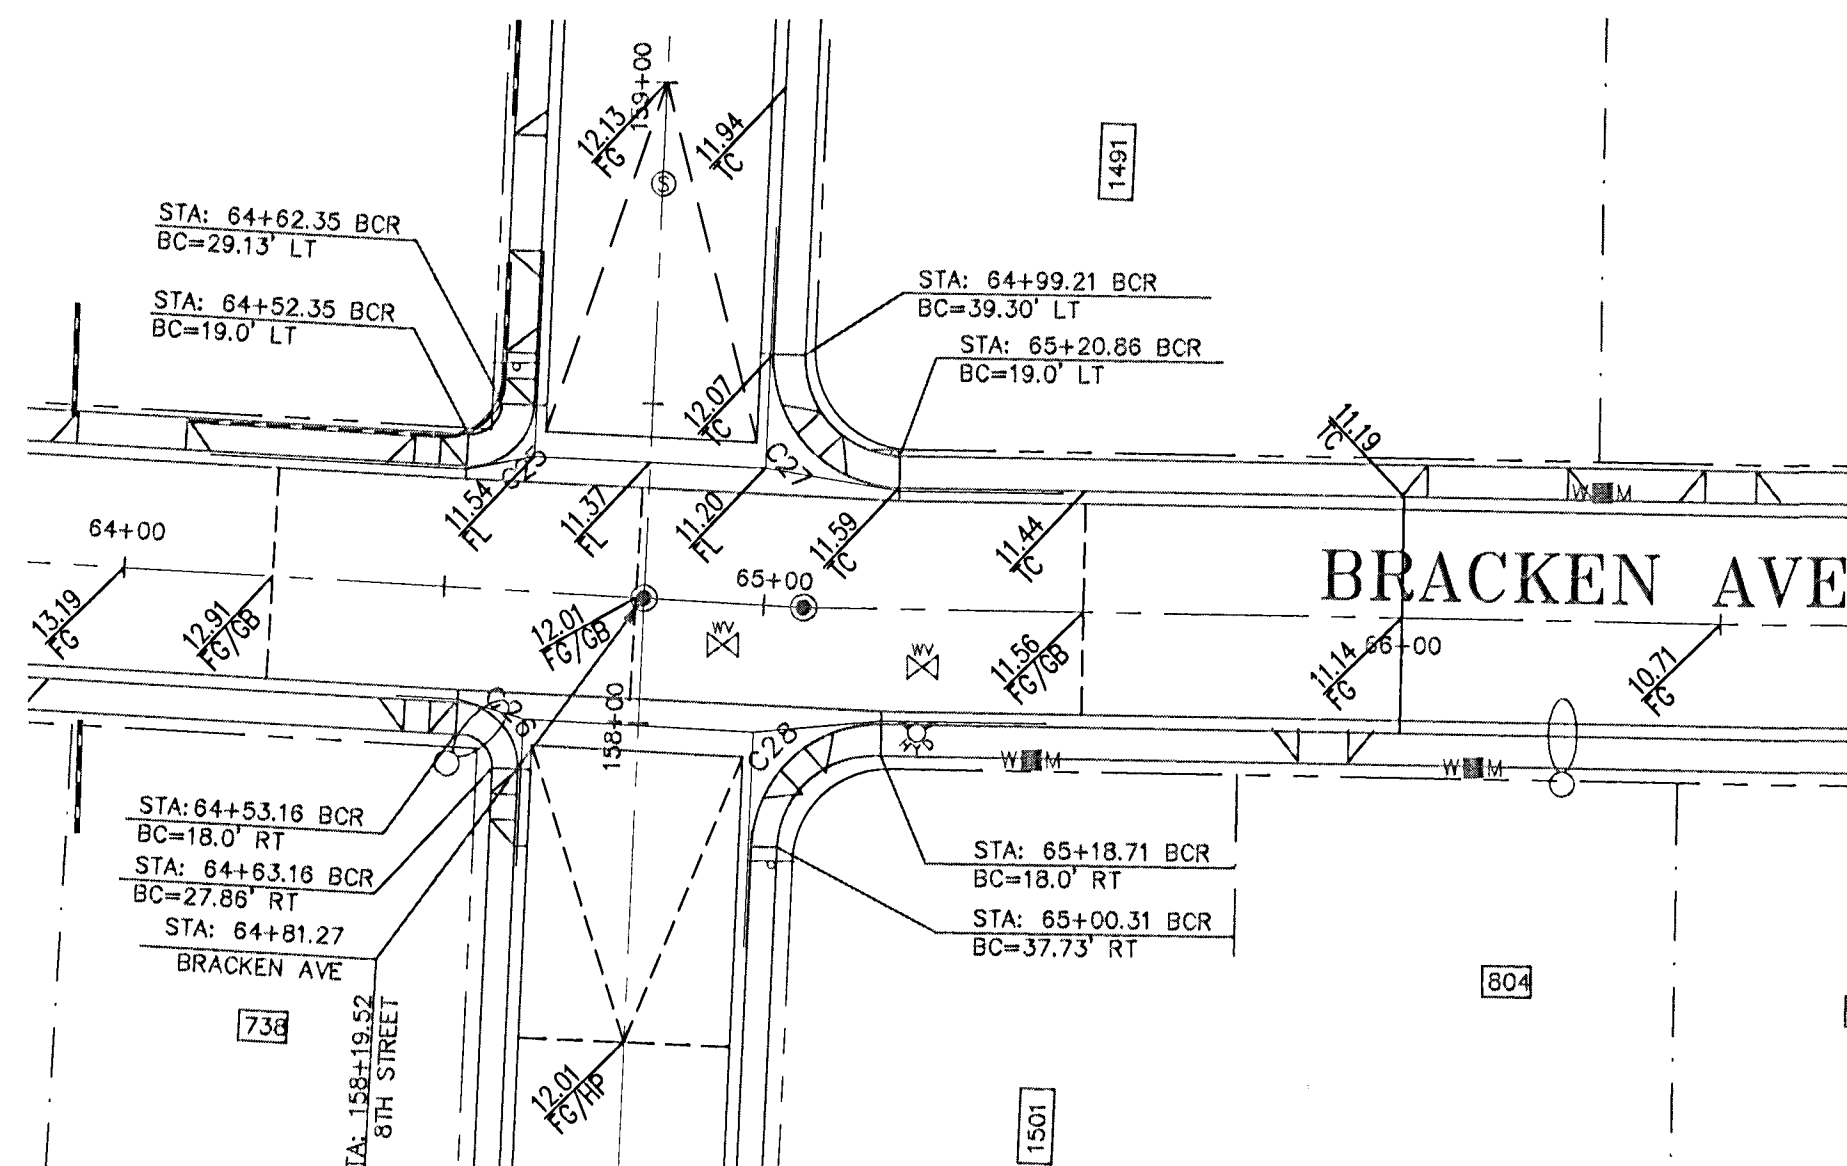

MATCH EXISTING PLANS


MATCH EXISTING PLANS
BRACKEN AVE. E (CL) 05/16/12



DRIVEWAYS SHOWN FOR REFERENCE ONLY

MATCH EXISTING PLANS

MATCH EXISTING PLANS

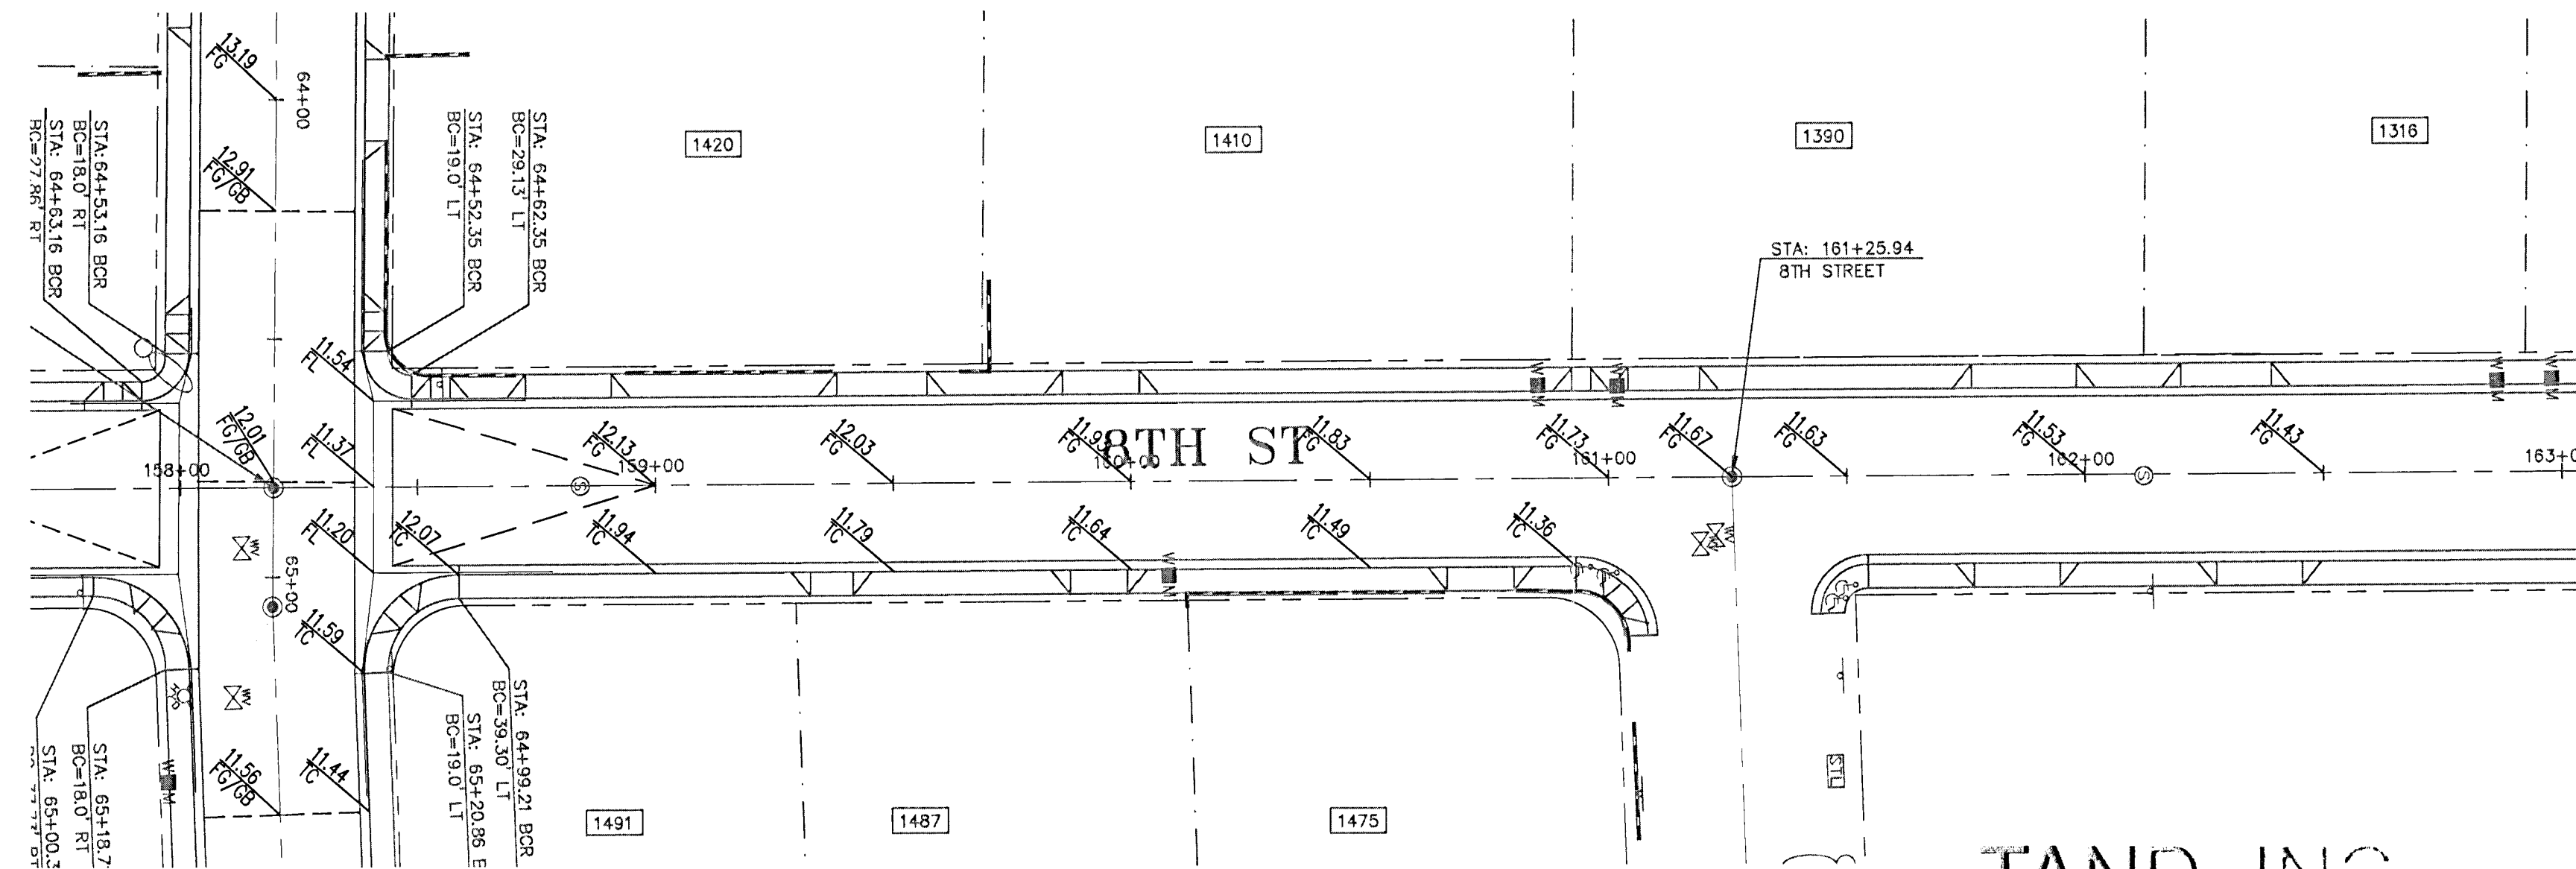

MATCH EXISTING PLANS

MATCH LEFT

8TH STREET (TC E/CL) 05/17/12

DRIVEWAYS SHOWN FOR REFERENCE ONLY




TAND, INC.
AS-BUILT

2-28-13
DATE


DANIEL MEYER

MATCH EXISTING PLANS

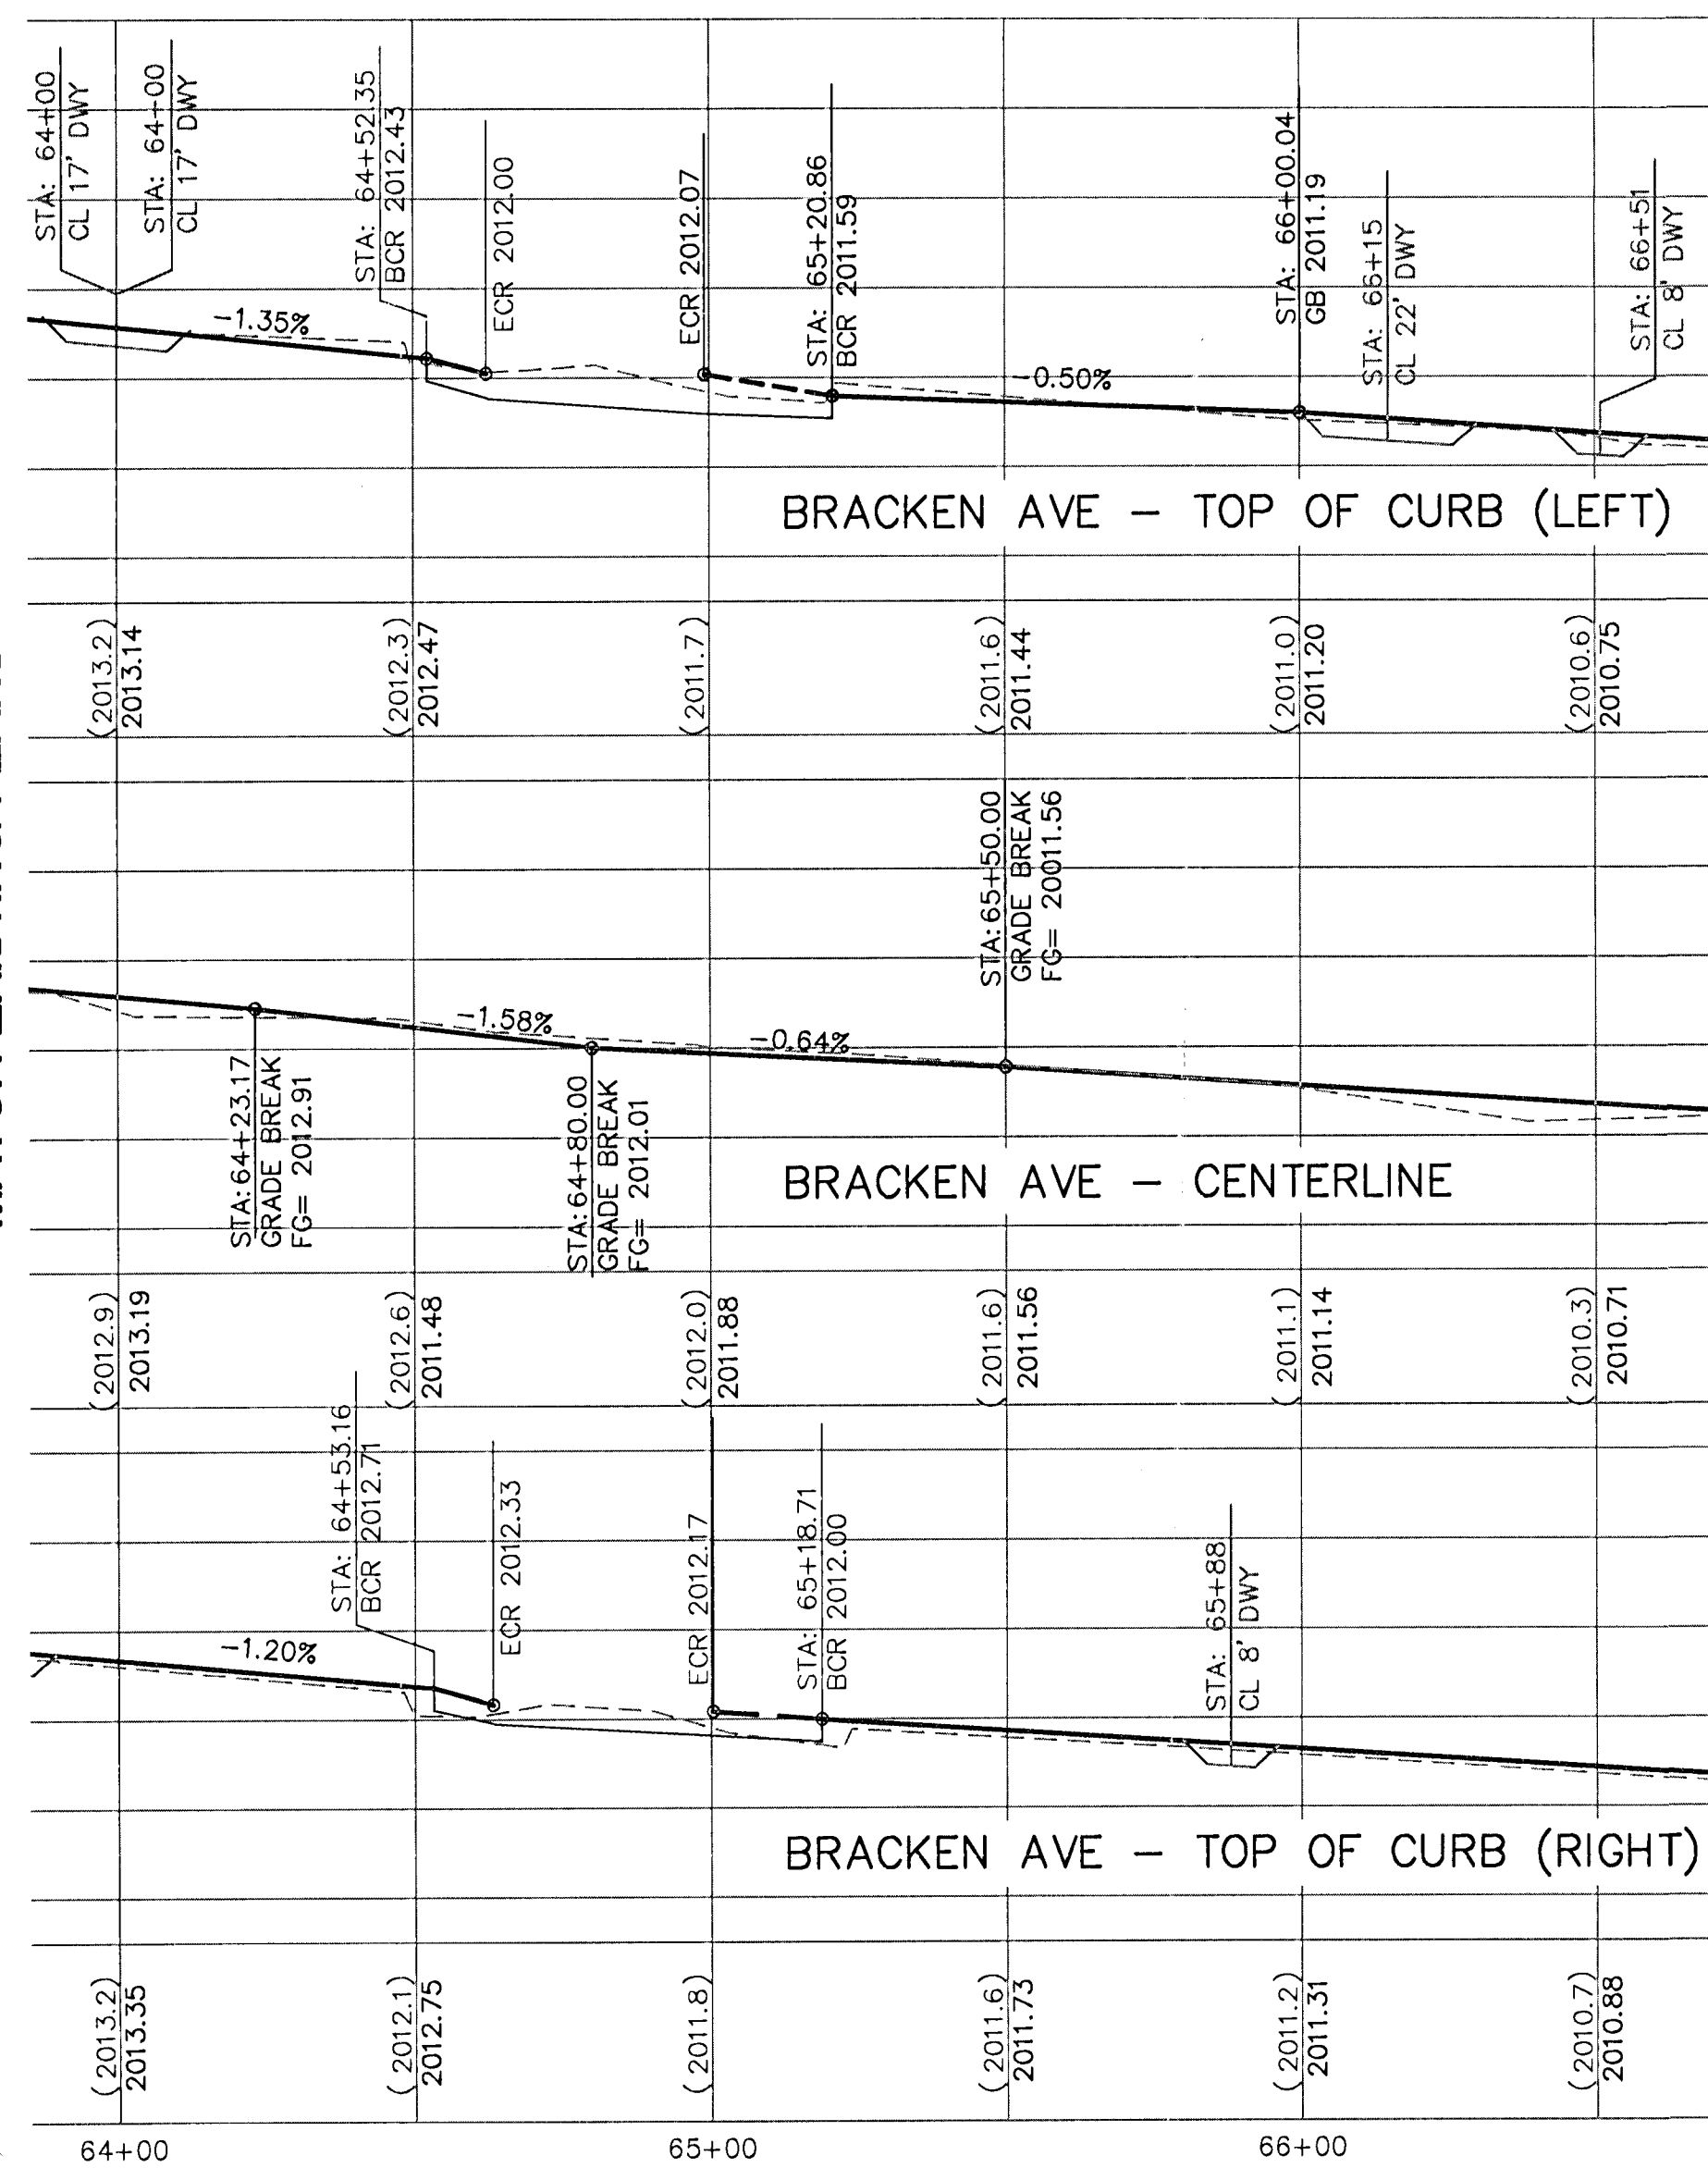

MATCH EXISTING PLANS

MATCH EXISTING PLANS

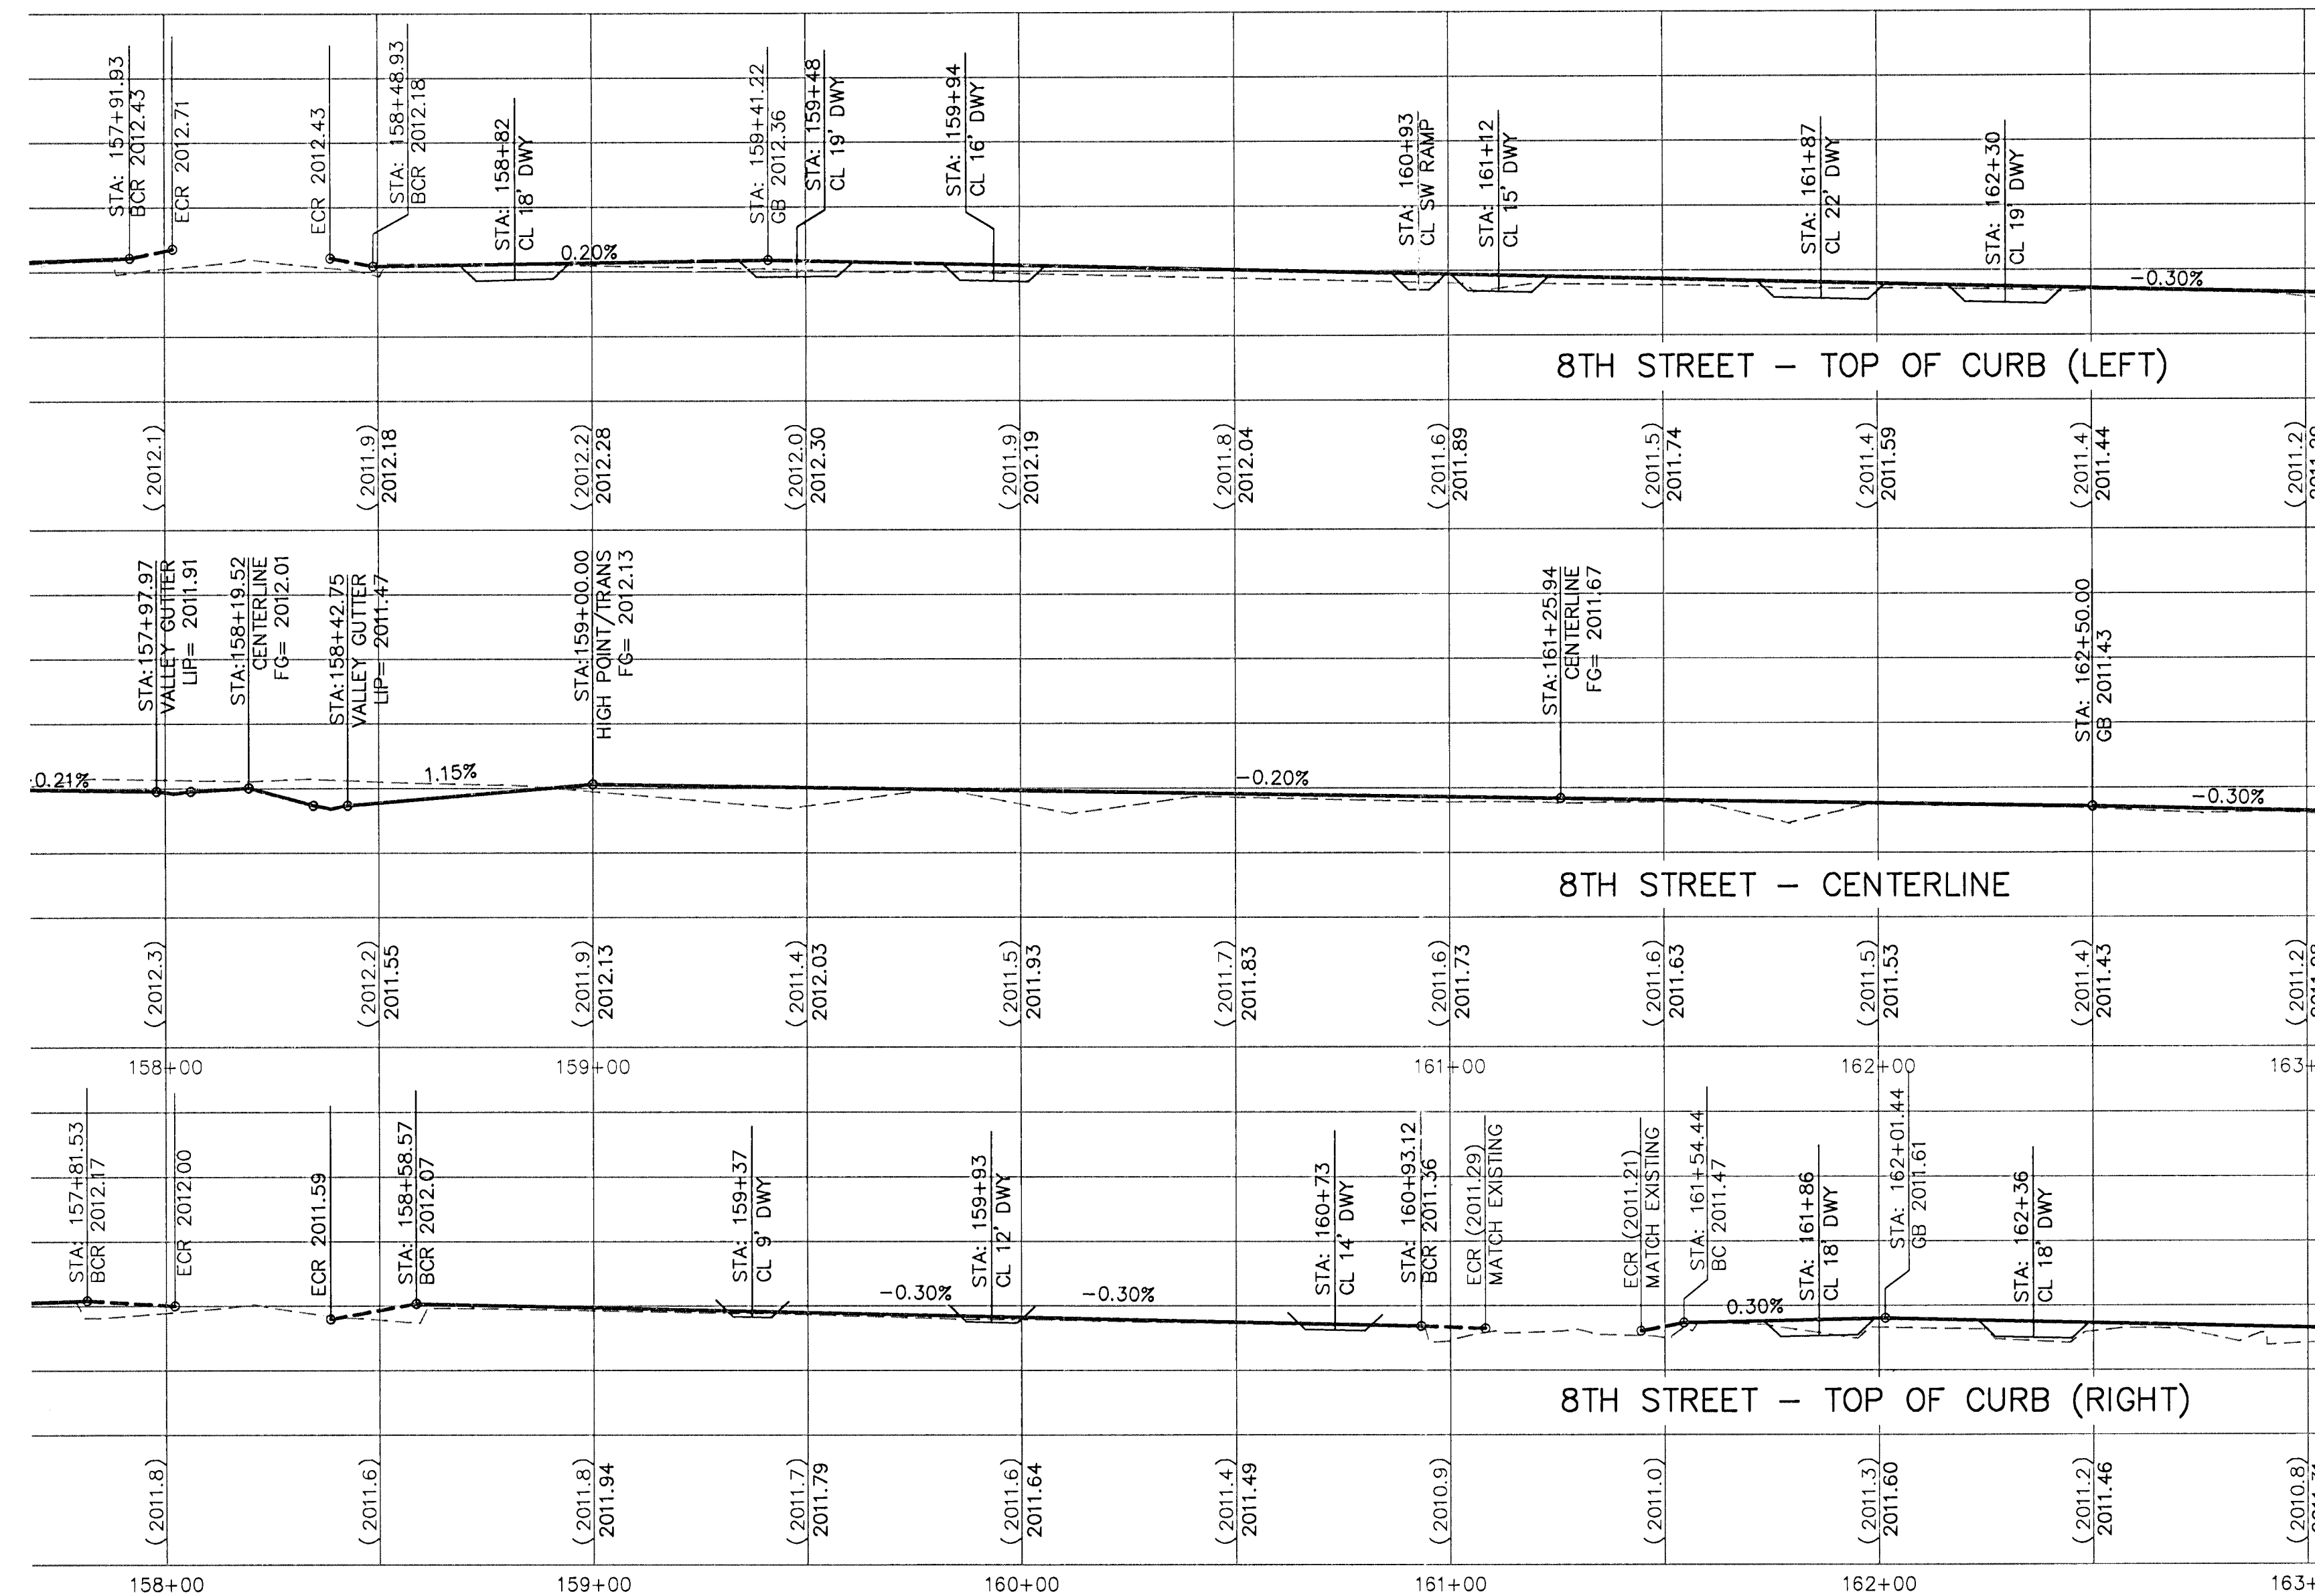

MATCH EXISTING PLANS