
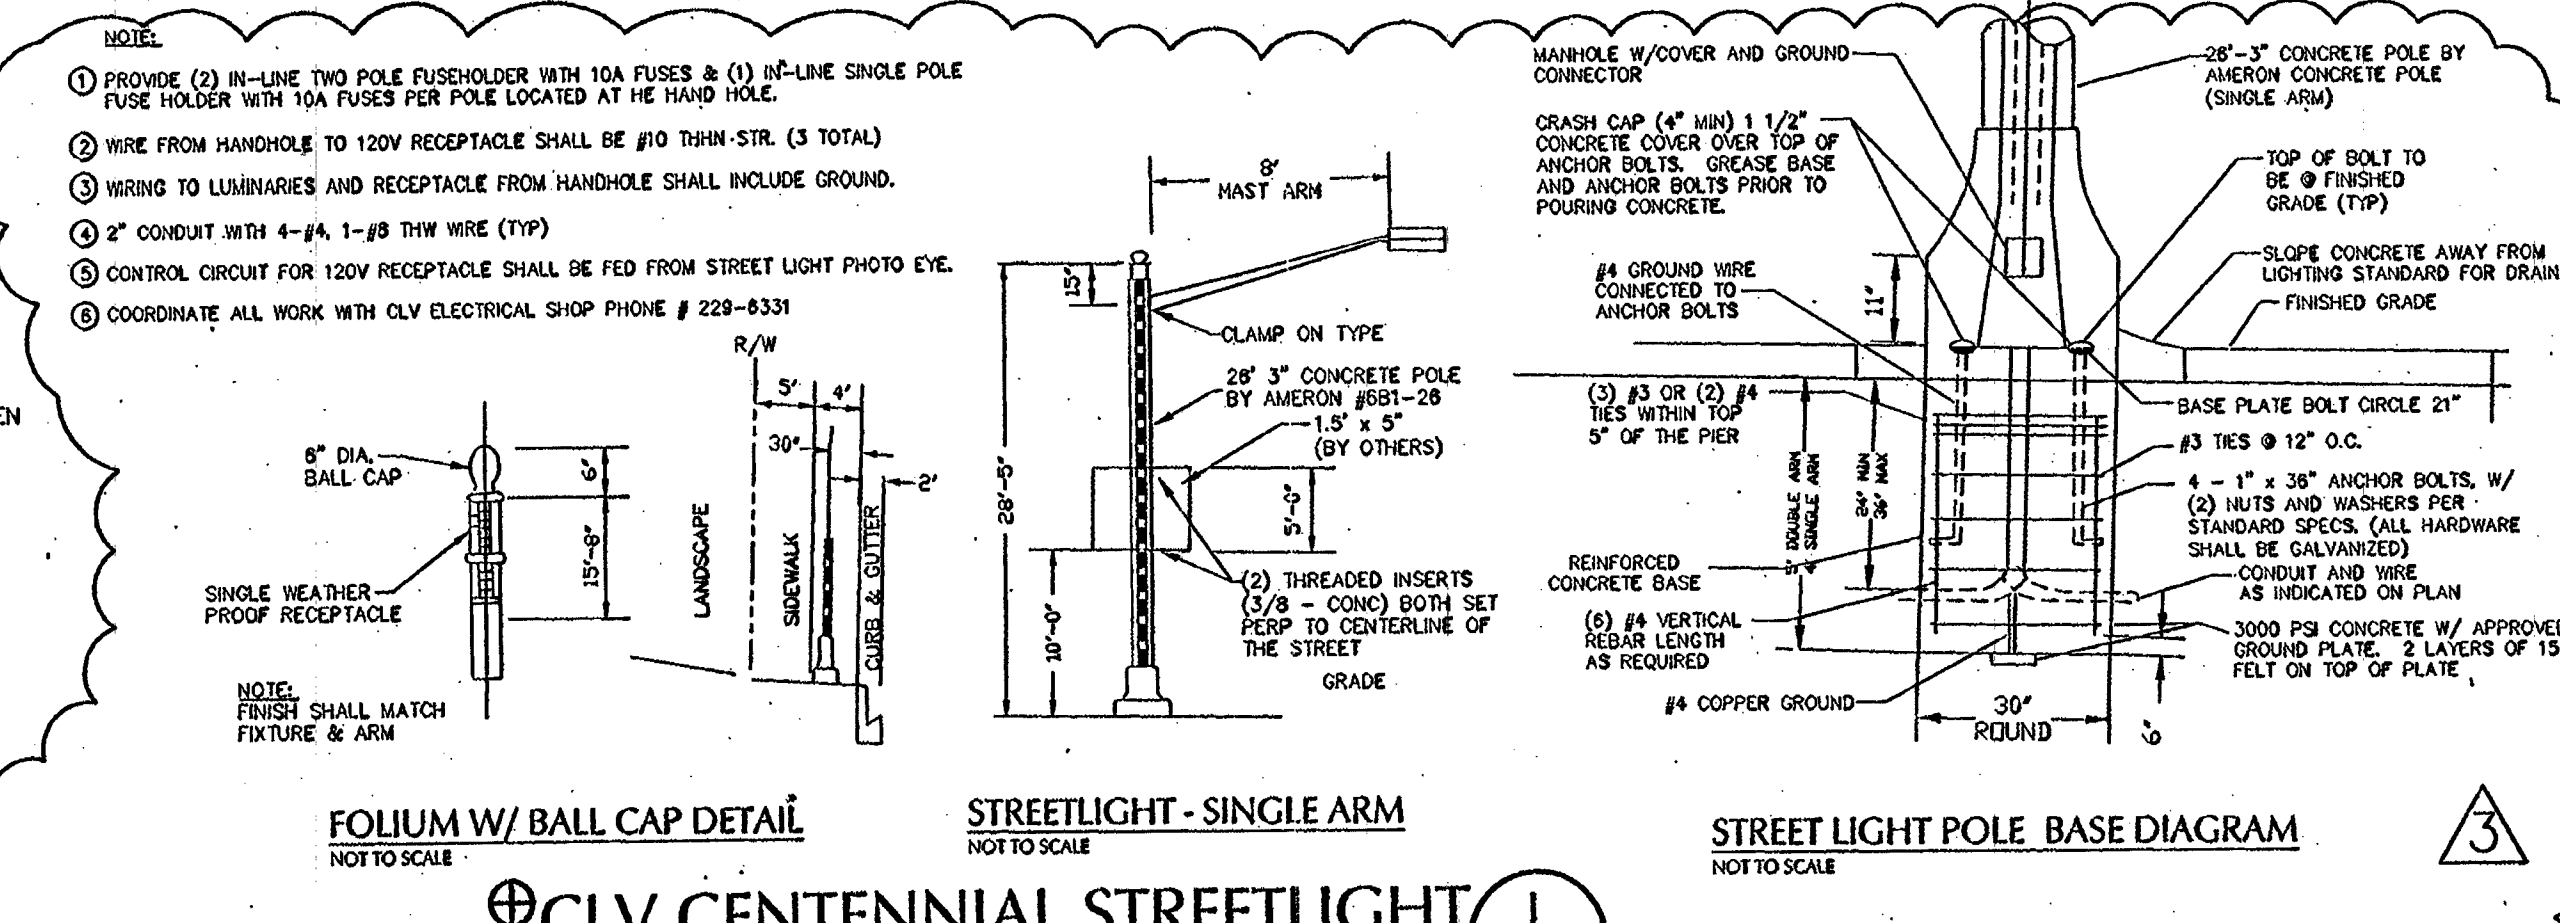


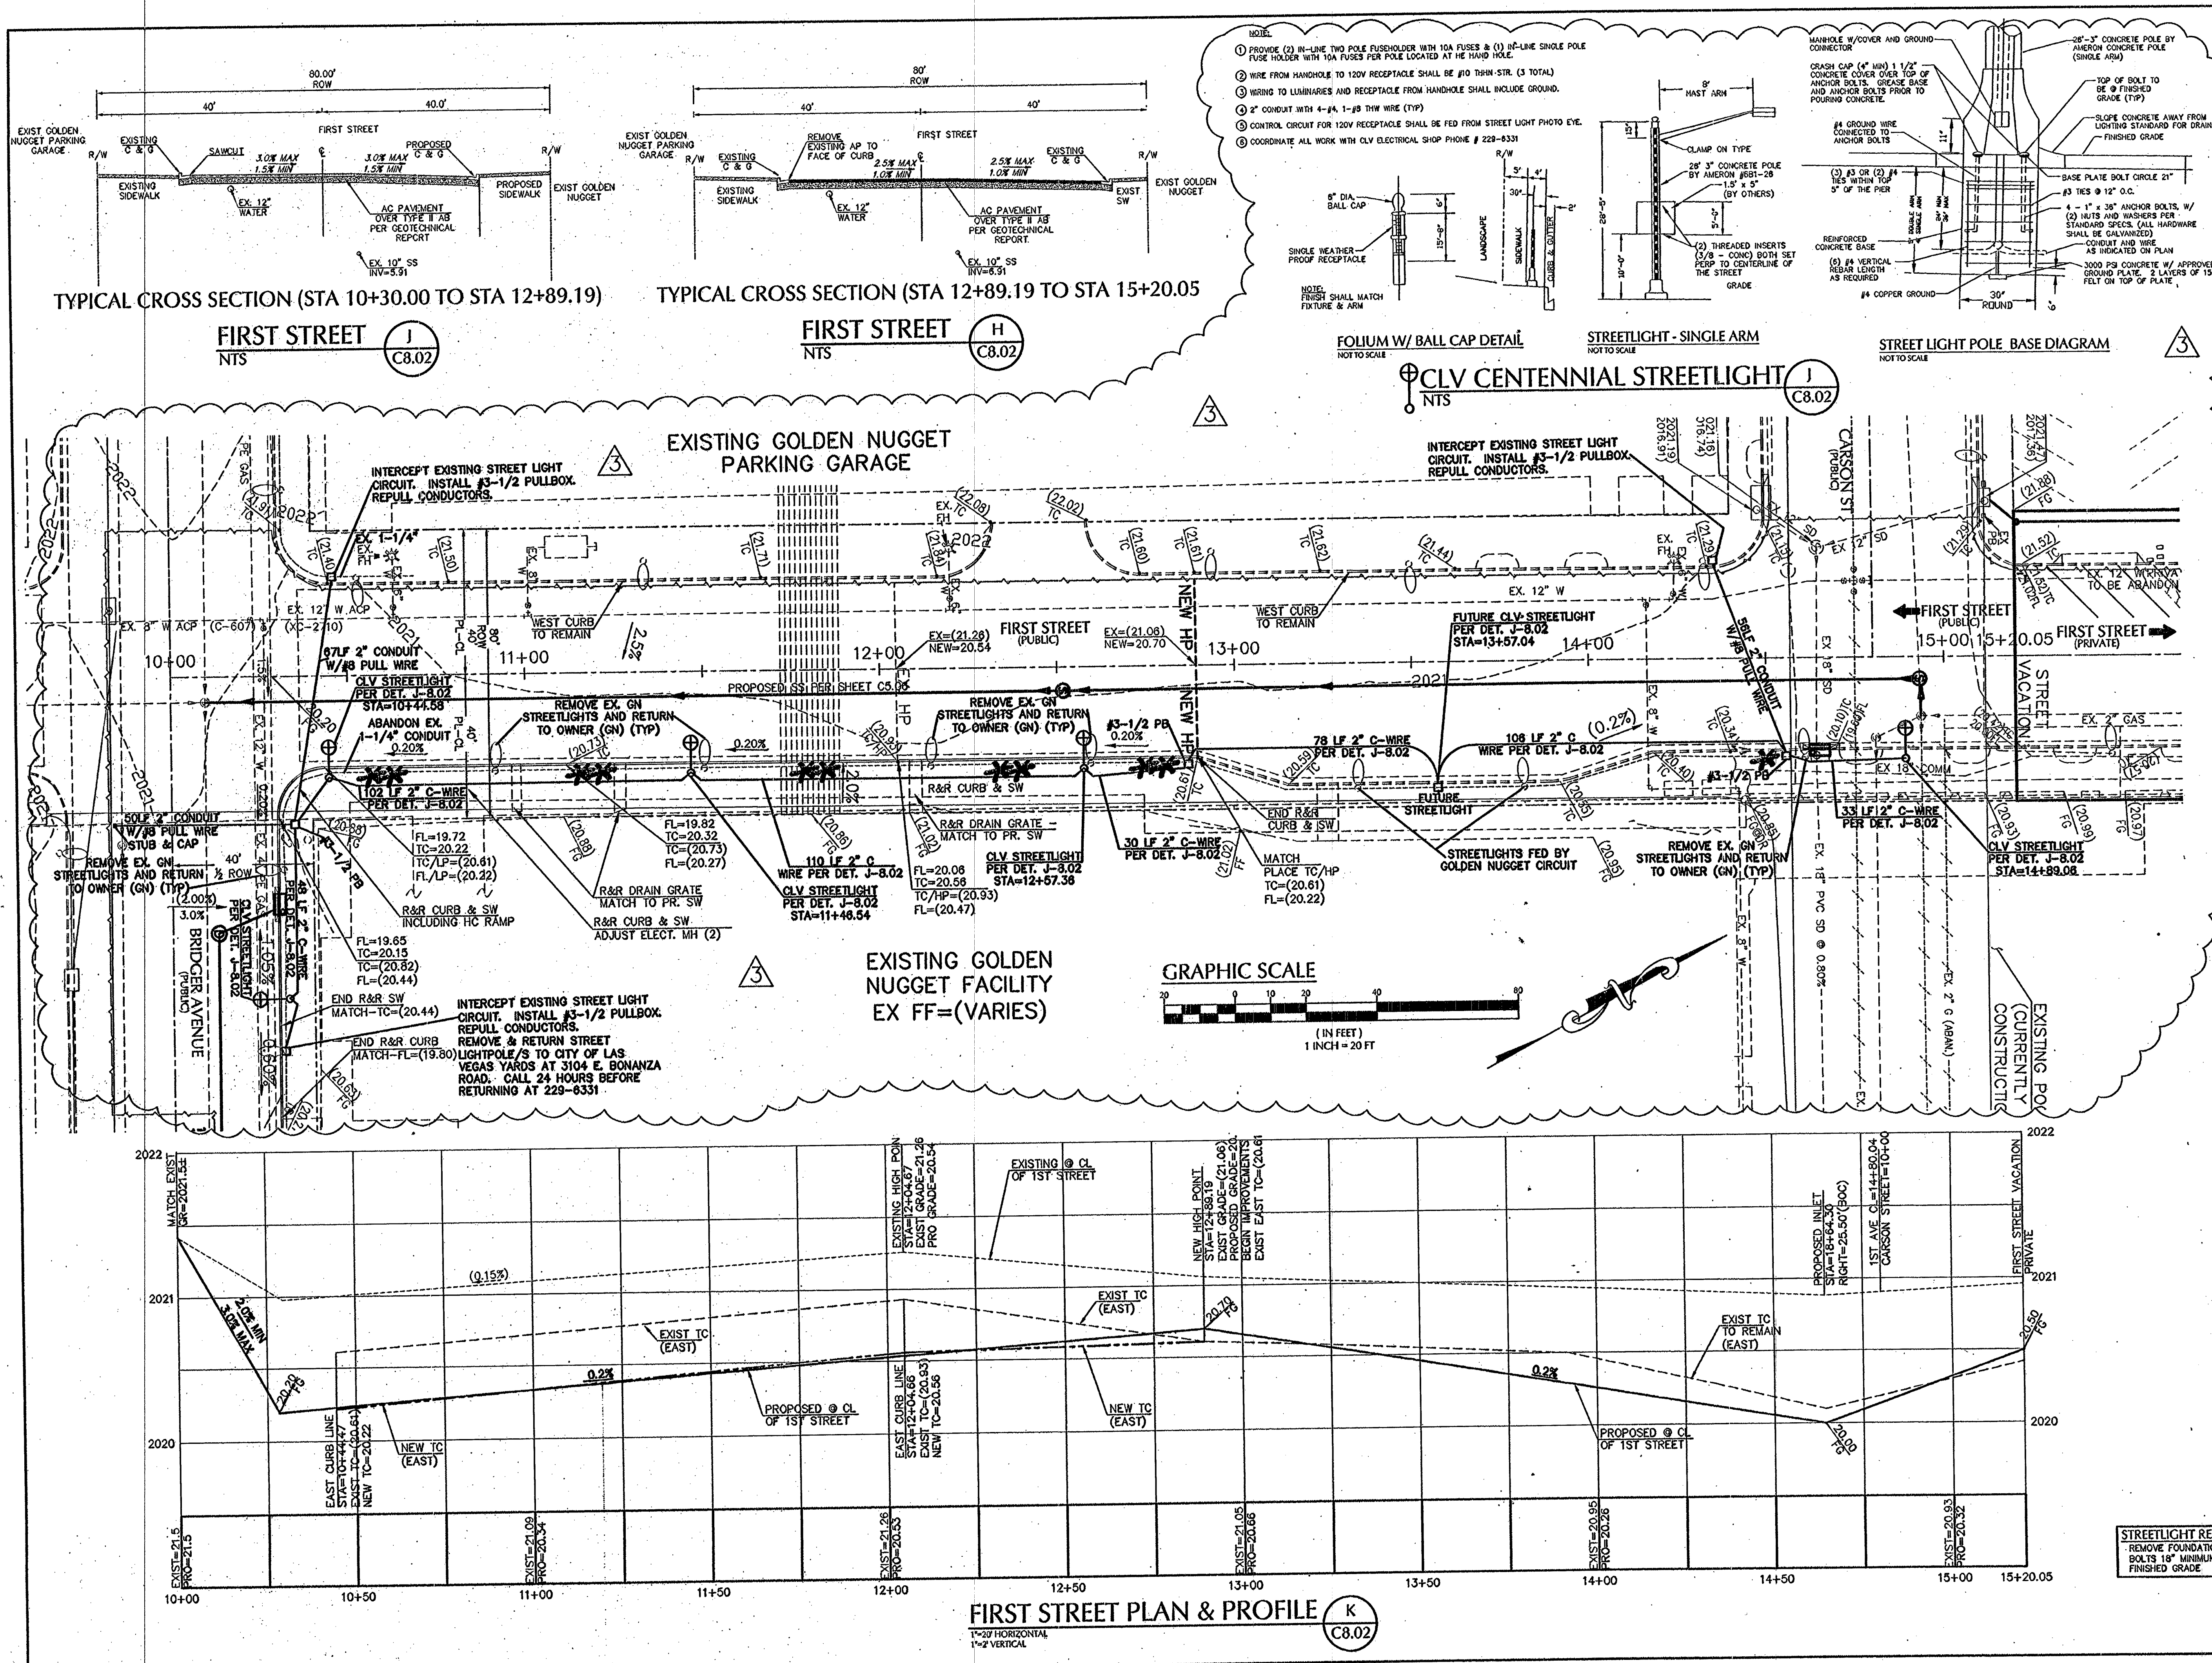

AS BUILTS

DETAIL SHEET & STREETLIGHTING

DATE 10/12/06
JOB NUMBER 2107.02
DESIGN BY J. PATCHETT, E.I.
DRAWN BY B. FUNK
CHECKED BY R. STRECKEL, P.E.

SEAL
C8.02
SHEET 14A OF 14
DRAWING NUMBER 107V4611-2

GNLV CORPORATION
P.O. BOX 610
LAS VEGAS, NEVADA 89125

MARTIN & MARTIN
CIVIL ENGINEERS
2100 LAS VEGAS BOULEVARD, SUITE 120
LAS VEGAS, NEVADA 89159
PHONE (702) 248-8000
FAX (702) 248-8070

NO. DESCRIPTION OF REVISIONS DATE INITIALS
1 REVISE FIRST STREET GRADING 12/27/06
2 REVISE STREETLIGHTS 1/25/07