



- RTC STD DWG 503



AB	ABANDONED
AC	ASPHALTIC CONCRETE
ACP	ASBESTOS CEMENT PIPE
AIM	AREA ISOLATION MODULE
BLVD	BOULEVARD
BM	BENCHMARK
BMI	BLACK MOUNTAIN INDUSTRIAL
BO	BLOW OFF
BTU	BRITISH THERMAL UNIT
BWC	BASIC WATER COMPANY
COBC	CITY OF BOULDER CITY
CC	CLARK COUNTY
CCAUSD	CLARK COUNTY AREA UNIFORM STANDARD DRAWING
CCRFGD	CLARK COUNTY REGIONAL FLOOD CONTROL DISTRICT
CCWRD	CLARK COUNTY WATER RECLAMATION DISTRICT
CIP	CAST IRON PIPE
CL	CENTERLINE
CLV	CITY OF LAS VEGAS
CNLV	CITY OF NORTH LAS VEGAS
COH	CITY OF HENDERSON
CP	CATHODIC PROTECTION
DET	DETAIL
DI	DUCTILE IRON
DIA	DIAMETER
DIMP	DISTRIBUTION INTEGRITY MANAGEMENT PROGRAM
DNR	DOES NOT REGISTER
DWG	DRAWING
EFV	EXCESS FLOW VALVE
EG	EXISTING GROUND
EHDD	EFFECTIVE HEATING DEGREE DAY
ELEC	ELECTRICAL
ELEV	ELEVATION
EMRS	ELECTRONIC MAPPING RECORDS SYSTEM
EPR	ELECTRONIC PRESSURE RECORDERS
ESMT	EASEMENT
EX	EXISTING
FERC	FEDERAL ENERGY REGULATORY COMMISSION
FOS	FACILITY OUT OF SERVICE
FH	FIRE HYDRANT
GIR	GAS INFRASTRUCTURE REPLACEMENT
GPR	GAS PRESSURE REGULATOR
HCA	HIGH CONSEQUENCE AREA
HDD	HEATING DEGREE DAY
HDP	HIGH DENSITY POLYETHYLENE PIPE
HP	HIGH PRESSURE
HRS	HOME ENERGY RATING SYSTEM
HOP	HISTORIC OPERATING PROCEDURE
HVTT	HIGH VOLUME TAPPING TEE
ID	INSIDE DIAMETER
IN	INCH(ES)
IPS	IRON PIPE SIZE
IS	IDENTIFIED SITE
JT	JOINT TRENCH
KRG	KERN RIVER GAS COMPANY
LDCPE	LARGE DIAMETER COILED POLYETHYLENE PIPE
LVVWD	LAS VEGAS VALLEY WATER DISTRICT
MAOP	MAXIMUM ALLOWABLE OPERATING PRESSURE
MCFH	THOUSAND CUBIC FEET PER HOUR
MH	MANHOLE
MOP	MAXIMUM OPERATING PRESSURE
MSA	METER SET ASSEMBLY
MVP	MAPPING VERIFICATION PROCEDURE
NAP	NOT A PART
NDOT	NEVADA DEPARTMENT OF TRANSPORTATION
NTSB	NATIONAL TRANSPORTATION SAFETY BOARD
NTS	NOT TO SCALE

- | | |
|-------|--|
| OC | ON CENTER |
| OD | OUTSIDE DIAMETER |
| OH | OVERHEAD |
| OHF | OVERHEAD POWER |
| P | POWER |
| PAOP | POTENTIAL ALLOWABLE OPERATING PRESSURE |
| PCC | PORTLAND CEMENT CONCRETE |
| PE | POLYETHYLENE PIPE |
| PH | POT HOLE |
| PHMSA | PIPELINE & HAZARDOUS MATERIALS SAFETY ADMINISTRATION |
| PL | PROPERTY LINE |
| PIC | POTENTIAL IMPACT CIRCLE |
| PLS | PRESSURE LIMITING STATION |
| PP | POWER POLE |
| PQF | PREQUALIFIED FITTING |
| PVC | POLYVINYL CHLORIDE |
| RAM | RISK ASSESSMENT MODEL |
| RC | REINFORCED CONCRETE |
| RCF | REINFORCED CONCRETE PIPE |
| SD | STORM DRAIN |
| SDMH | STORM DRAIN MANHOLE |
| SDR | STANDARD DIMENSION RATIO |
| SF | SQUARE FOOT |
| SHT | SHEET |
| SHF | STEEL HIGH PRESSURE PIPE |
| SMYS | SPECIFIED MAXIMUM YIELD STRENGTH |
| SNWA | SOUTHERN NEVADA WATER AUTHORITY |
| SS | SANITARY SEWER |
| SST | STAINLESS STEEL |
| ST | STREET |
| STA | STATION |
| STD | STRENGTH TEST DRAWING |
| STL | STEEL |
| SWG | SOUTHWEST GAS |
| TEL | TELEPHONE |
| TB | THRUST BLOCK |
| TOP | TOP OF PIPE |
| TP | TEST POINT |
| TRIMP | TRANSMISSION INTEGRITY MANAGEMENT PROGRAM |
| UDACS | UNIFORM DESIGN AND CONSTRUCTION STANDARDS |
| UOC | UNUSUAL OPERATING CONDITIONS |
| UOP | UNIT OF PROPERTY |
| UPRR | UNION PACIFIC RAILROAD |
| USD | UNIFORM STANDARD DRAWING |
| VCP | VITRIFIED CLAY PIPE |
| VERT | VERTICAL |
| VG | VALLEY GUTTER |
| VSP | VINTAGE STEEL PIPE |
| W | WATER |
| WMS | WORK MANAGEMENT SYSTEM |
| WR | WORK REQUEST |
| WT | WALL THICKNESS |
| WV | WATER VALVE |
| YD | YARD(S) |

1. SUGGESTED GAS LOCATIONS ARE TO CLEAR SUBSTRUCTURES LOCATE IN FIELD.
2. ALL PIPELINE CONSTRUCTION SHALL CONFORM TO APPLICABLE JURISDICTION SPECIFICATIONS.
3. GAS MAINS SHALL BE PURGED PER OPERATIONS MANUAL.
4. DO NOT SCALE THIS DRAWING.
5. ANY CHANGES IN MAIN LOCATION MUST BE AUTHORIZED BY SWG INSPECTOR AND/OR ENGINEER.
6. TRENCHING AND BACKFILL TO CONFORM WITH UNIFORM STANDARD SPECS, SECTION 208, AND RTC STANDARDS 503.
7. ALL STREETS ARE PUBLIC.
8. CLV PERMIT REQUIRED.
9. STREET IMPROVEMENTS ON EAST SIDE OF UPRR ARE THE CITY'S. CONSTRUCTION TO BE BY NDOT'S PROJECT NEON DESIGN-BUILD CONTRACTOR.
10. REQUEST FOR SURVEYING AND/OR STAKING SHALL BE SUBMITTED TO ENGINEERING A MINIMUM OF 72 HOURS IN ADVANCE OF NEED.
11. SWG WORK IS CONCURRENT WITH NDOT'S PROJECT NEON DESIGN-BUILD CONTRACTOR. COORDINATION WILL BE REQUIRED BY BOTH PARTIES.
12. SWG PAVEMENT REQUIREMENTS IS COLD PATCH. NDOT'S CONTRACTOR TO CONSTRUCT/OVERLAY STREETS.
13. SWG RELOCATION PLAN BASED ON CLV 'GRAND CENTRAL INDUSTRIAL CONNECTOR, WYOMING AVE TO WESTERN AVE' 30% IMPROVEMENT PLANS RECEIVED BY SWG 10-14-14. FINAL IMPROVEMENT PLANS MAY AFFECT SWG WORK AS DESIGN AND MUST BE REVIEWED PRIOR TO COMMENCING ANY SWG WORK.
14. CAUTION HP GAS IN AREA OF ALIGNMENT.

TRENCHING & BACKFILL TO CONFORM
WITH UNIFORM STD SPECS, SECTION 208
AND RTC STD 503. PAVEMENT REPAIR
SHALL CONFORM TO RTC STDs:

A1 503



A2 500.5

[illegible]

2

2


SYSTEM	D_VALLEY_WIDE
DR. NO.	21DR10008938
SEGMENT M.A.O.P.	N/A
SYSTEM M.A.O.P.	43_PSIG
SYSTEM M.O.P.	43_PSIG

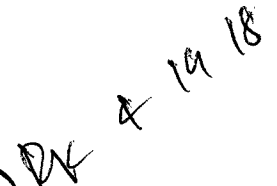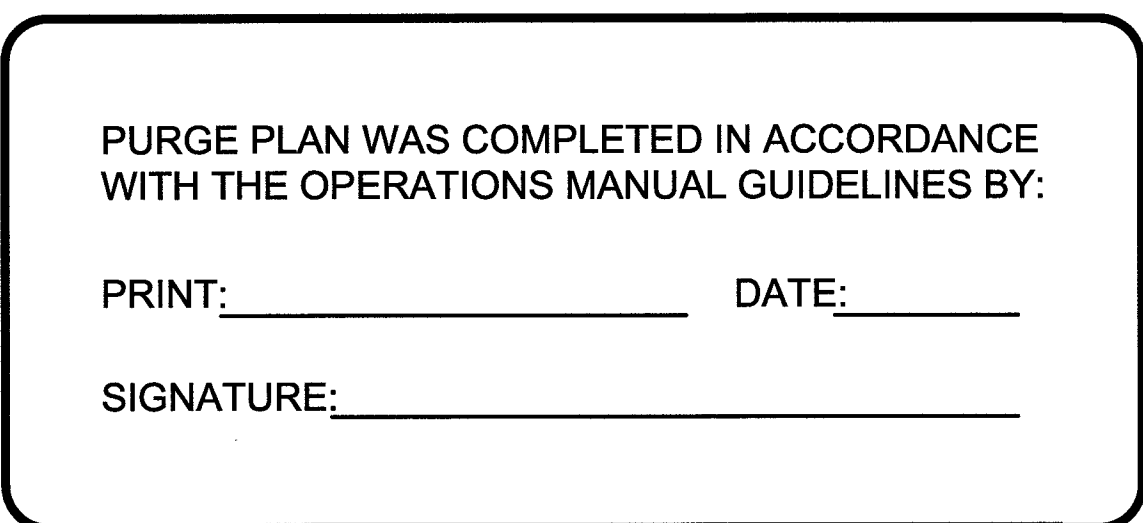

REPLOT



MATCHLINE STA "GCI" 14.39 SEE SHEET 5

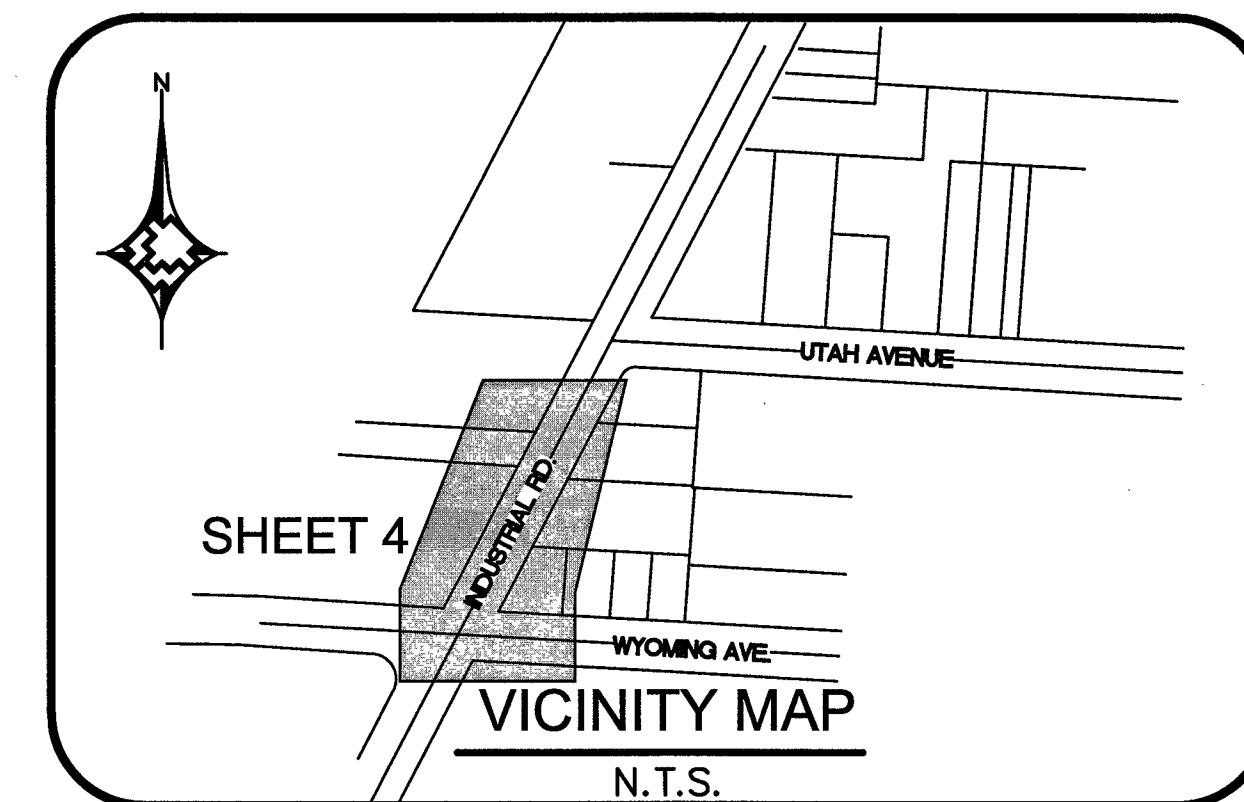

MATERIAL LIST FOR PROPOSED DISTRIBUTION FACILITIES		
ITEM#	STOCK ID#	DESCRIPTION
1	100-5101	PROPOSED 2" PE
2	140-3067	PROPOSED 2" PE 90° ELBOW
3	140-3504	PROPOSED 2" PE TIE-IN COUPLING
4	140-2882	PROPOSED 2" PE END CAP

MATERIAL LIST FOR ABANDONED FACILITIES		
ITEM#	STOCK ID#	DESCRIPTION
1	3460102	ABANDON EX 2" PE INS IN 3" PLS SLV '05 MOP 43#
2	3800101	ABANDON EX 1-1/4" PE INS IN 3" PLS SLV '05 MOP 43#
3	3800101	ABANDON EX 1/2" PE '02 SVC
4	3800101	ABANDON EX 1/2" PE '05 SVC

RTC NOTES:

TRENCHING & BACKFILL TO CONFORM WITH UNIFORM STD SPECS, SECTION 208 AND RTC STD 503. PAVEMENT REPAIR SHALL CONFORM TO RTC STDs:

A1	503
A2	500.5

CLV NOTE: PROTECT EX. STORM DRAIN FACILITIES
IN PLACE; PROVIDE MIN. SIX FEET
HOR. CLEARANCE AND MIN. 12" VERT.
CLEARANCE AT SD CROSSINGS.



2	UPDATED ALIGNMENT WR 3344147	BS	03/26/2018	
2	ABANDON STUB 6' NORTH OF TEE ON UTAH	BS	04/06/2018	
3.				
4.				
NO	DESCRIPTION	BY	DATE	APPROVED

TAX CODES	UNIT NO.	UNIT TYPE	INSTL. PROPOSED	RETIRED	INSTL. COMPLETED	RETIRED
PROPERTY UNITS						

AS-BUILT DRAWING-PRESSURE TEST DATA

	TEST METHOD	TEST METHOD
PIPE DIA _____	☐ AIR	☐ GAUGE
PIPE LENGTH _____	☐ NITROGEN	☐ CHART
PIPE TYPE _____	☐ WATER	☐ GAUGE/
MIN. DURATION _____	☐ SOAP	PRESS REC SN# _____
TEST PRES. (PSIG): (MAX) _____ (MIN) _____		
TIME: (START) _____ (STOP) _____		
DATE: (START) _____ (STOP) _____		
PERFORMED BY: _____		
SWG VERIFIED BY: _____		

**INDIVIDUAL PERFORMING VISUAL INSPECTION
VISUAL INSPECTION CERTIFICATION**

I HAVE VISUALLY INSPECTED ALL HEATED FUSING SOLVENT CEMENT
MECHANICAL JOINTS, AND WELDS THAT I HAVE PERFORMED

NAME _____ DATE _____

SEE 8 & 9

AS-BUILTS ACCEPTED BY _____ DATE _____

POSTED BY _____ DATE _____



POSTING QC'D BY _____ DATE _____

CONSTRUCTION INSPECTOR _____ FOREMAN _____ REVIEWED BY _____	
PERMIT INFORMATION CITY OF LAS VEGAS TAX CODE 02-0203	

ISOLATION AREA
ISO_21 DIST_096
LOCATION
SEC 4 T21S R61E M.D.M.

	W.R. NO.
	3113007
	ATLAS #/TILE #
	x624y510

ENGINEER/TECH: BOBBIE SKROVE		PHONE: 702-365-2237
ACCOUNT REP:		PHONE:
PROJECT CONTACT: BOBBIE SKROVE		PHONE: 702-365-2237
SHEET NO: 4 OF 7	SCALE: 1"= 30'	DATE: 04/20/2017
DWN. BY: SEI	CHKD. BY:	APPVD. BY:
TITLE		
F-CLV-INDUSTRIAL RD		
WYOMING AVE TO UTAH AVE		
2" PE RELOCATION		
DESIGN PLAN		

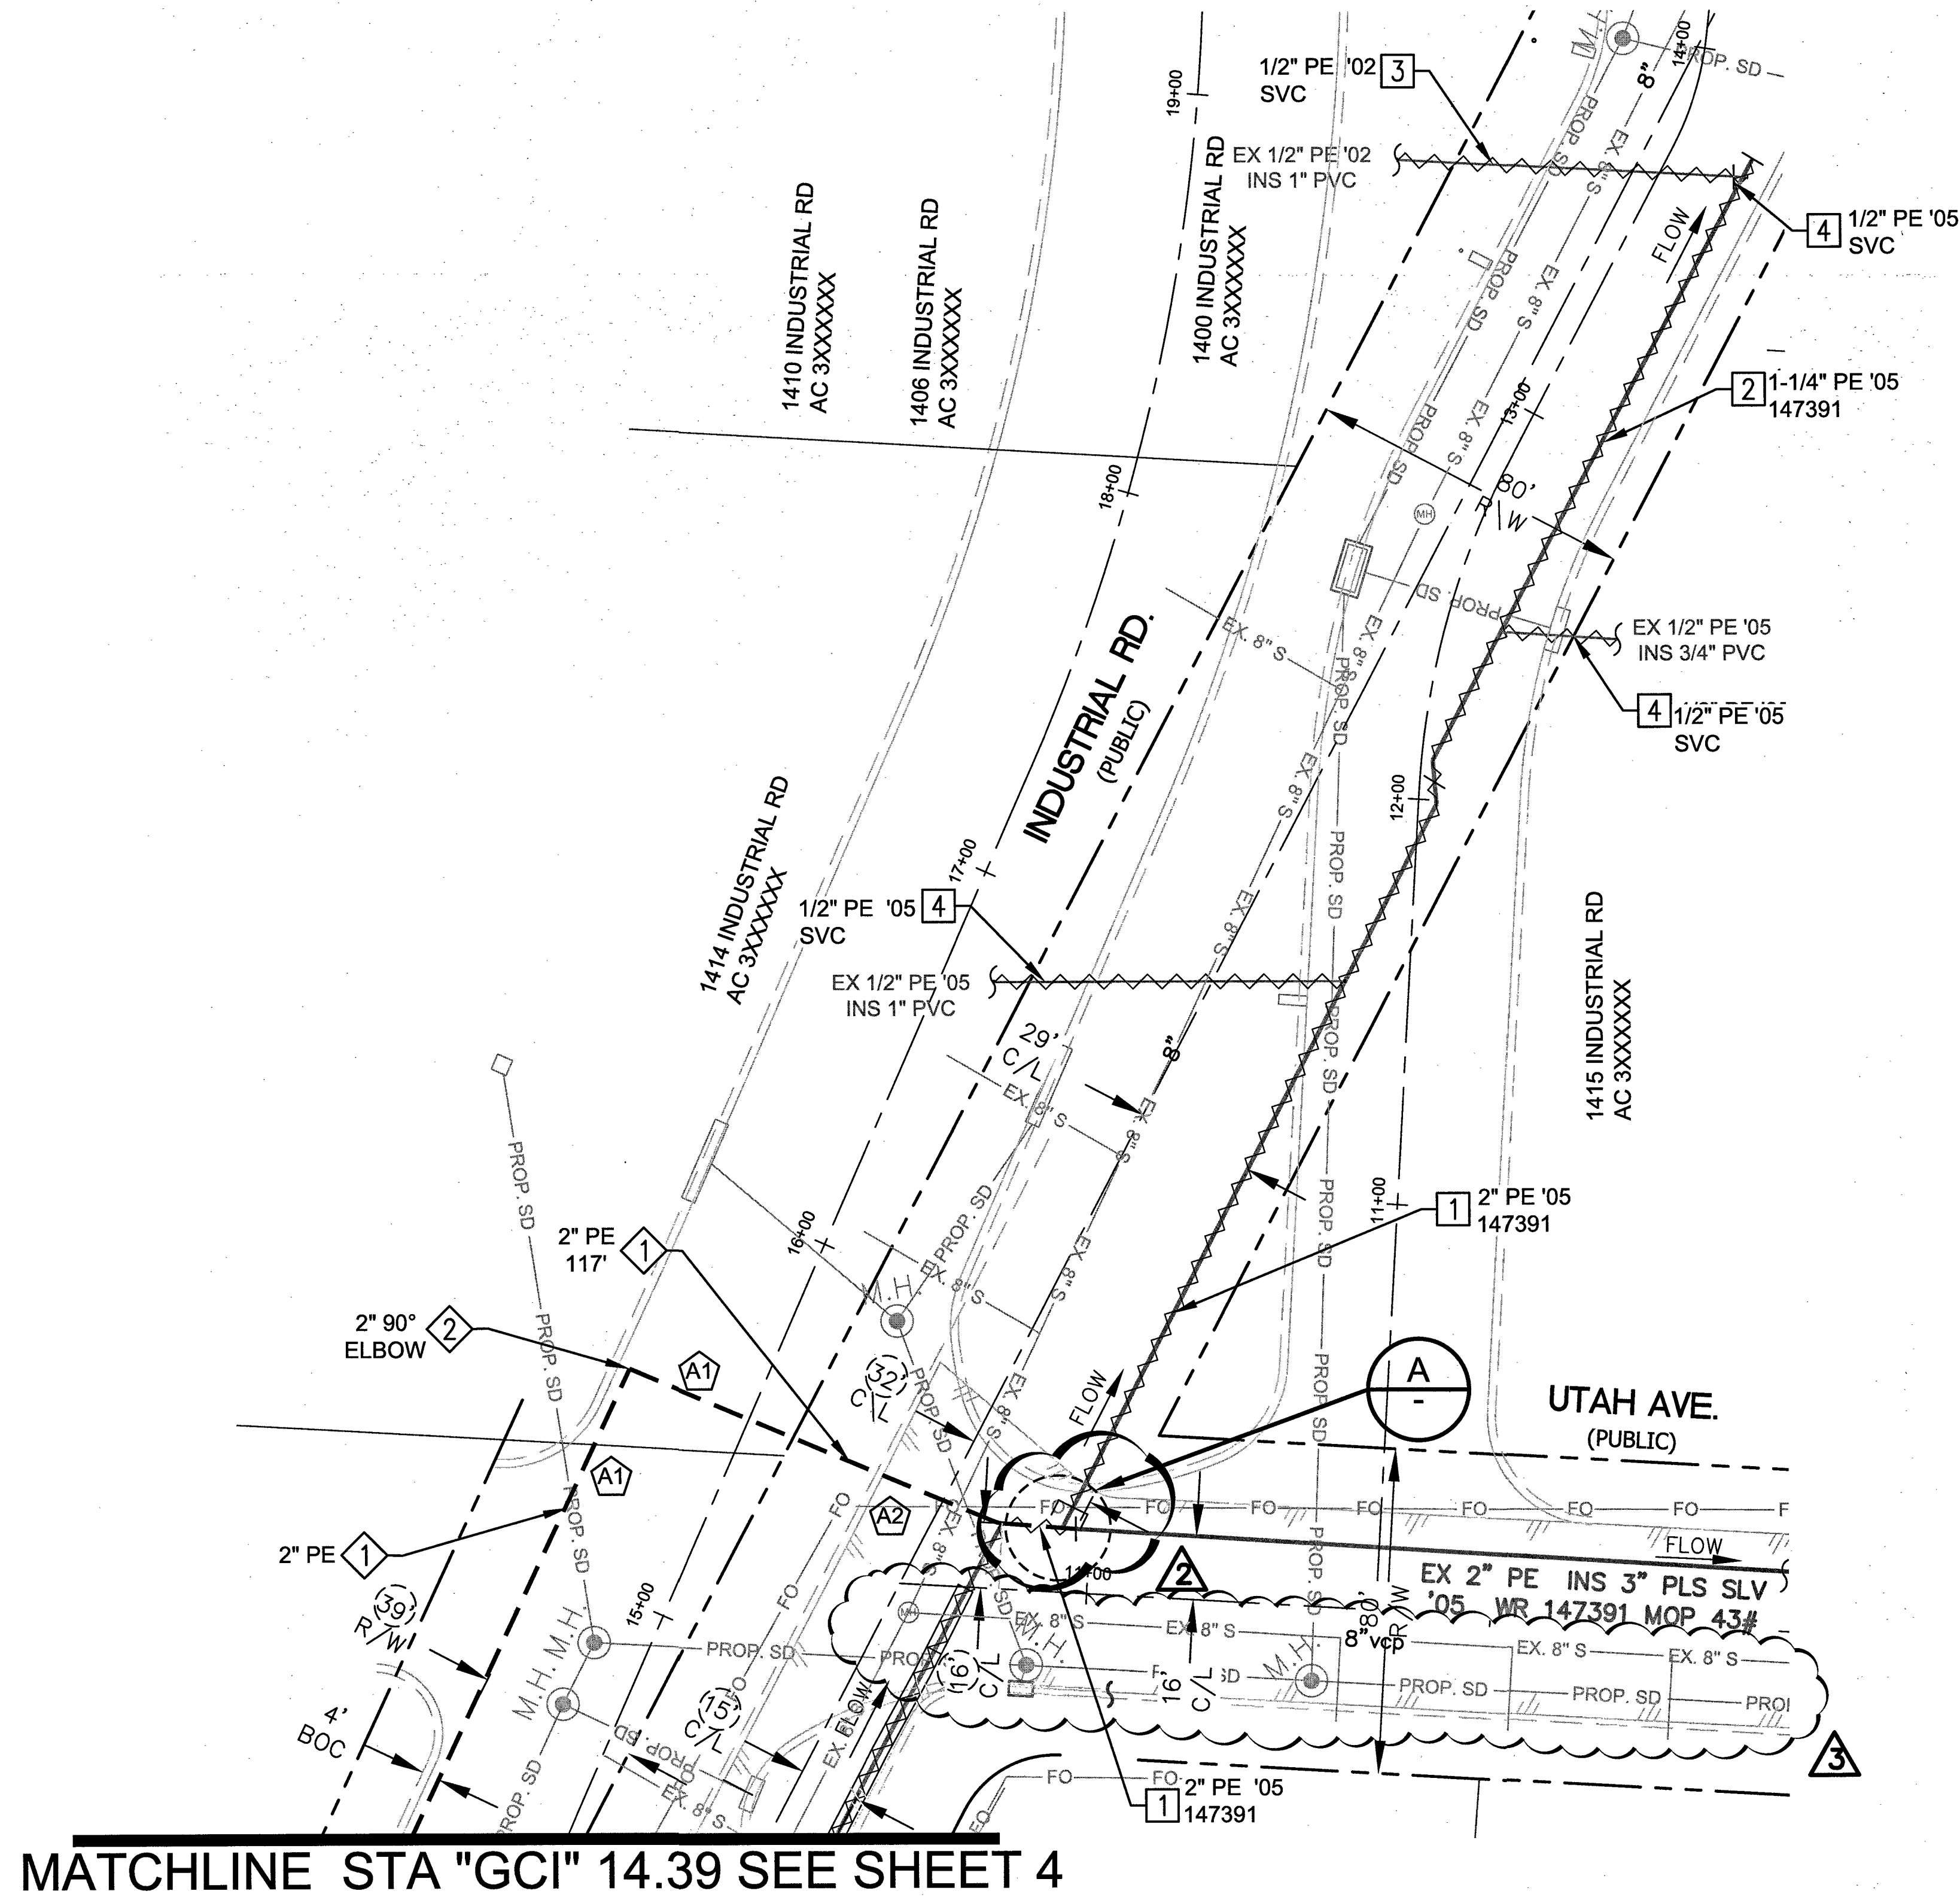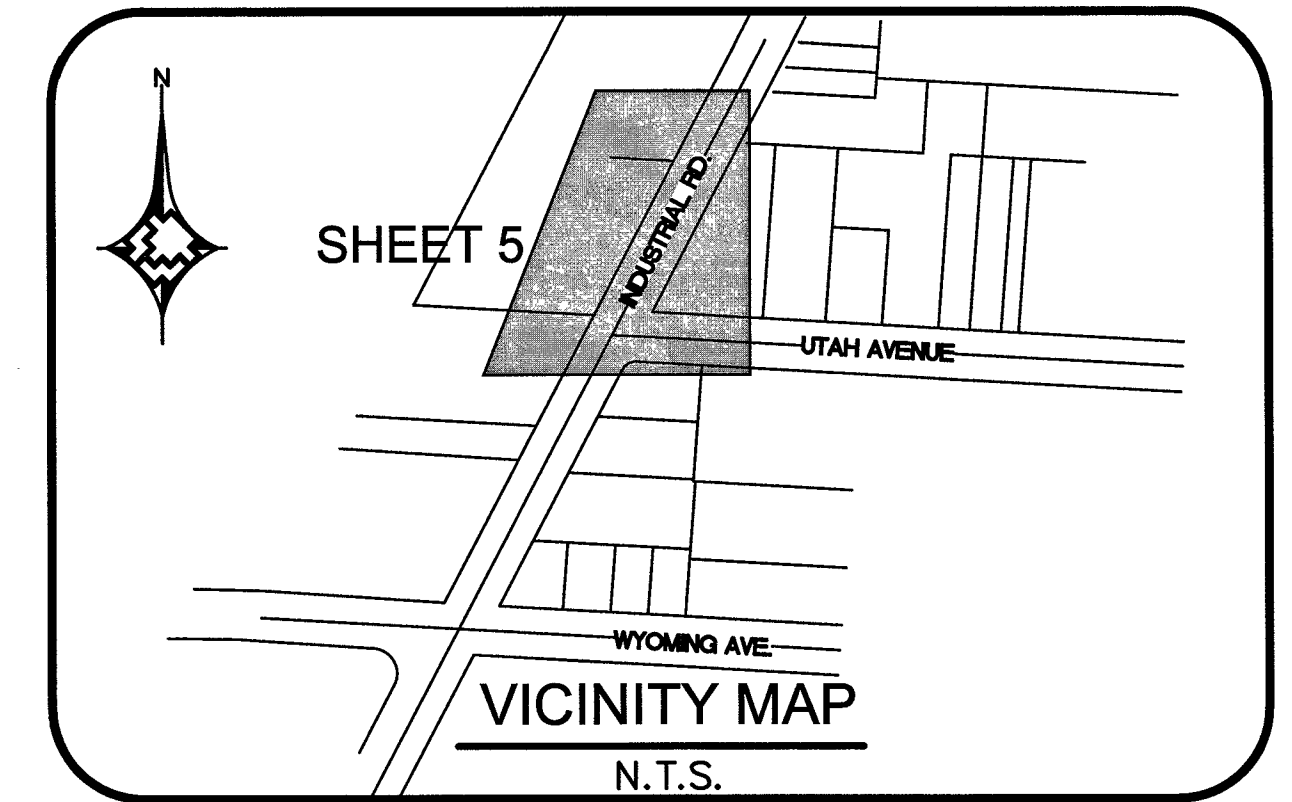

MATERIAL LIST FOR PROPOSED DISTRIBUTION FACILITIES		
ITEM#	STOCK ID#	DESCRIPTION
1	100-5101	PROPOSED 2" PE
2	140-3067	PROPOSED 2" PE 90° ELBOW
3	140-3504	PROPOSED 2" PE TIE-IN COUPLING
4	140-2882	PROPOSED 2" PE END CAP

MATERIAL LIST FOR ABANDONED FACILITIES		
ITEM#	STOCK ID#	DESCRIPTION
1	3460102	ABANDON EX 2" PE INS IN 3" PLS SLV '05 MOP 43#
2	3800101	ABANDON EX 1-1/4" PE INS IN 3" PLS SLV '05 MOP 43#
3	3800101	ABANDON EX 1/2" PE '02 SVC
4	3800101	ABANDON EX 1/2" PE '05 SVC

RTC NOTES:
TRENCHING & BACKFILL TO CONFORM WITH UNIFORM STD SPECS, SECTION 208 AND RTC STD 503. PAVEMENT REPAIR SHALL CONFORM TO RTC STDs:

A1 503
A2 500.5



A A A	UPDATED ALIGNMENT WR 3344147	BS	03/26/2018	
	ABANDON STUB 6" NORTH OF TEE ON UTAH	BS	05/30/2018	
	UPDATED EXISTING SEWER ON UTAH AVE	BS	06/01/2018	
4.				
NO.	DESCRIPTION	BY	DATE	APPVD.
REVISIONS				
 SOUTHWEST GAS CORPORATION				

TAX CODES	UNIT NO.	UNIT TYPE	INSTL. PROPOSED	RETIRED	INSTL. COMPLETED	RETIRED
PROPERTY UNITS						



AS-BUILT DRAWING-PRESSURE TEST DATA		
PIPE DIA.	TEST MEDIUM	TEST METHOD
PIPE LENGTH	☐ AIR	☐ GAUGE
PIPE TYPE	☐ NITROGEN	☐ CHART
MIN. DURATION	☐ WATER	☐ GAUGE/ PRESS REC SN#
TEST PRES. (PSIG): (MAX)		
TIME: (START)		
DATE: (START)		
PERFORMED BY:		
VERIFIED BY:		

INDIVIDUAL PERFORMING VISUAL INSPECTION VISUAL INSPECTION CERTIFICATION	
I HAVE VISUALLY INSPECTED ALL HEATED FUSIONS, SOLVENT CEMENT, MECHANICAL JOINTS, AND WELDS THAT HAVE PERFORMED	
NAME	DATE
AS-BUILTS ACCEPTED BY	DATE
POSTED BY	DATE
POSTING QCD BY	DATE

CONSTRUCTION	
INSPECTOR	FOREMAN
REVIEWED BY	
PERMIT INFORMATION	
CITY OF LAS VEGAS	
TAX CODE 02-0203	

ISOLATION AREA	
ISO_21	DIST_096
W.R. NO.	
3113007	
LOCATION	
SEC 4	
T21S R61E	
M.D.M.	

ENGINEER/TECH: BOBBIE SKROVE	PHONE: 702-365-2237
ACCOUNT REP:	PHONE:
PROJECT CONTACT: BOBBIE SKROVE	PHONE: 702-365-2237
SHEET NO: 5 OF 7	SCALE: 1"= 30'
DWN. BY: SEI	CHKD. BY:
DATE: 04/25/2017	APPVD. BY:
TITLE	
F-CLV-INDUSTRIAL RD	
WYOMING AVE TO UTAH AVE	
2" PE RELOCATION	
DESIGN PLAN	

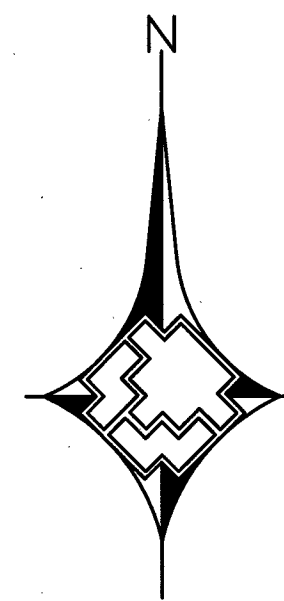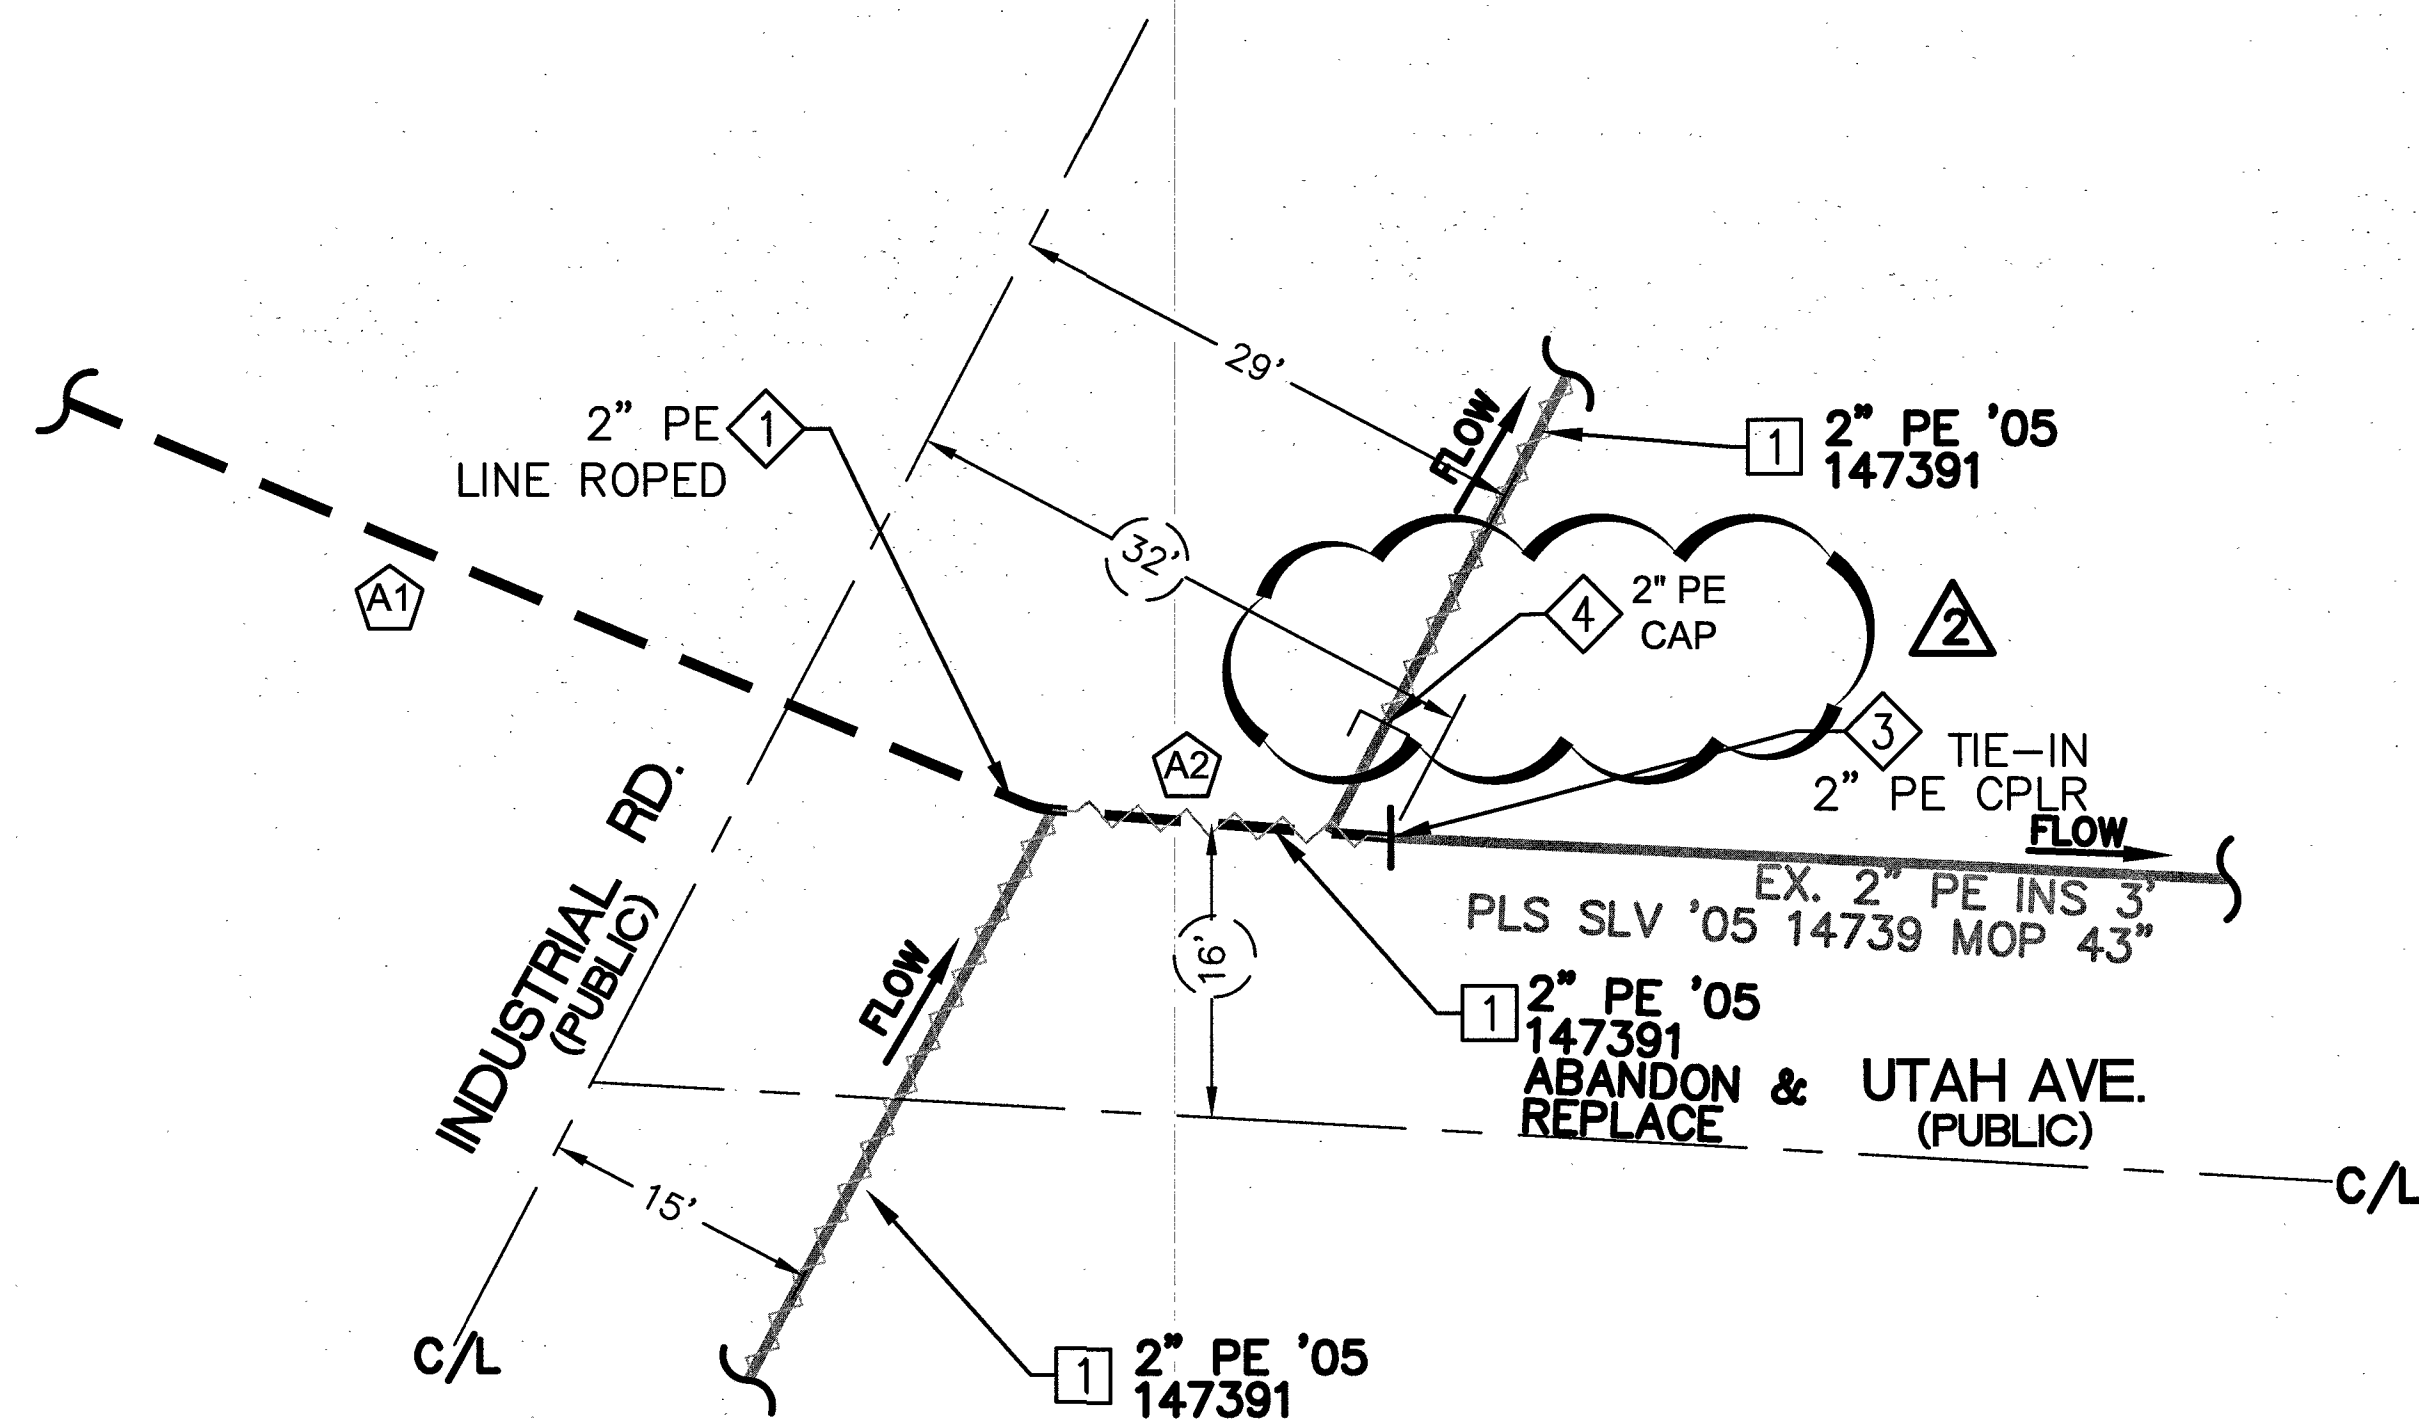

A
-

DETAIL VIEW
(SEE SHEET 5)

NTS

MATERIAL LIST FOR PROPOSED DISTRIBUTION FACILITIES		
ITEM#	STOCK ID#	DESCRIPTION
1	100-5101	PROPOSED 2" PE
2	140-3067	PROPOSED 2" PE 90° ELBOW
3	140-3504	PROPOSED 2" PE TIE-IN COUPLING
4	140-2882	PROPOSED 2" PE END CAP

MATERIAL LIST FOR ABANDONED FACILITIES		
ITEM#	STOCK ID#	DESCRIPTION
1	3460102	ABANDON EX 2" PE INS IN 3" PLS SLV '05 MOP 43#
2	3800101	ABANDON EX 1-1/4" PE INS IN 3" PLS SLV '05 MOP 43#
3	3800101	ABANDON EX 1/2" PE '02 SVC
4	3800101	ABANDON EX 1/2" PE '05 SVC

RTC NOTES:

TRENCHING & BACKFILL TO CONFORM
WITH UNIFORM STD SPECS, SECTION 208
AND RTC STD 503. PAVEMENT REPAIR
SHALL CONFORM TO RTC STDs:

A1 503

A2 500.5



3.	UPDATED ALIGNMENT WR 3344147	BS	03/26/2018	
4.	ABANDON STUB 6' NORTH OF TEE ON UTAH	BS	04/06/2018	
NO.	DESCRIPTION	BY	DATE	APPVD.

REVISIONS				
NO.	DESCRIPTION	BY	DATE	APPVD.



SOUTHWEST GAS CORPORATION

TAX CODES	UNIT NO.	UNIT TYPE	INSTL. PROPOSED	RETIRED	INSTL. COMPLETED	RETIRED
PROPERTY UNITS						

AS-BUILT DRAWING-PRESSURE TEST DATA

PIPE DIA. _____

PIPE LENGTH _____

PIPE TYPE _____

MIN. DURATION _____

TEST PRES. (PSIG): (MAX) _____ (MIN) _____

TIME: (START) _____ (STOP) _____

DATE: (START) _____ (STOP) _____

PERFORMED BY: _____

SWG VERIFIED BY: _____

TEST MEDIUM: ☐ AIR ☐ NITROGEN ☐ WATER

TEST METHOD: ☐ GAUGE ☐ CHART ☐ GAUGE/ PRESS REC SN#

INDIVIDUAL PERFORMING VISUAL INSPECTION
VISUAL INSPECTION CERTIFICATION

I HAVE VISUALLY INSPECTED ALL HEATED FUSIONS, SOLVENT CEMENT, MECHANICAL JOINTS, AND WELDS THAT HAVE PERFORMED

NAME _____ DATE _____

INSPECTOR _____

FOREMAN _____

REVIEWED BY _____

AS-BUILTS ACCEPTED BY _____ DATE _____

POSTED BY _____ DATE _____

POSTING QC'D BY _____ DATE _____

CONSTRUCTION

INSPECTOR _____

FOREMAN _____

REVIEWED BY _____

PERMIT INFORMATION

CITY OF LAS VEGAS

TAX CODE 02-0203

ISOLATION AREA

ISO_21
DIST_096

LOCATION

SEC 4
T21S R61E
M.D.M.

W.R. NO.

3113007

ATLAS #/TILE #

x624y510

ENGINEER/TECH: BOBBIE SKROVE

PHONE: 702-365-2237

ACCOUNT REP:

PHONE:

PROJECT CONTACT: BOBBIE SKROVE

PHONE: 702-365-2237

SHEET NO: 6 OF 7

SCALE: NTS

DATE: 04/20/2017

DWN. BY: SEI


CHKD. BY:

APPVD. BY:


TITLE

F-CLV-INDUSTRIAL RD
WYOMING AVE TO UTAH AVE
2" PE RELOCATION
DETAIL SHEET


TYPICAL SWPPP BMP DETAILS

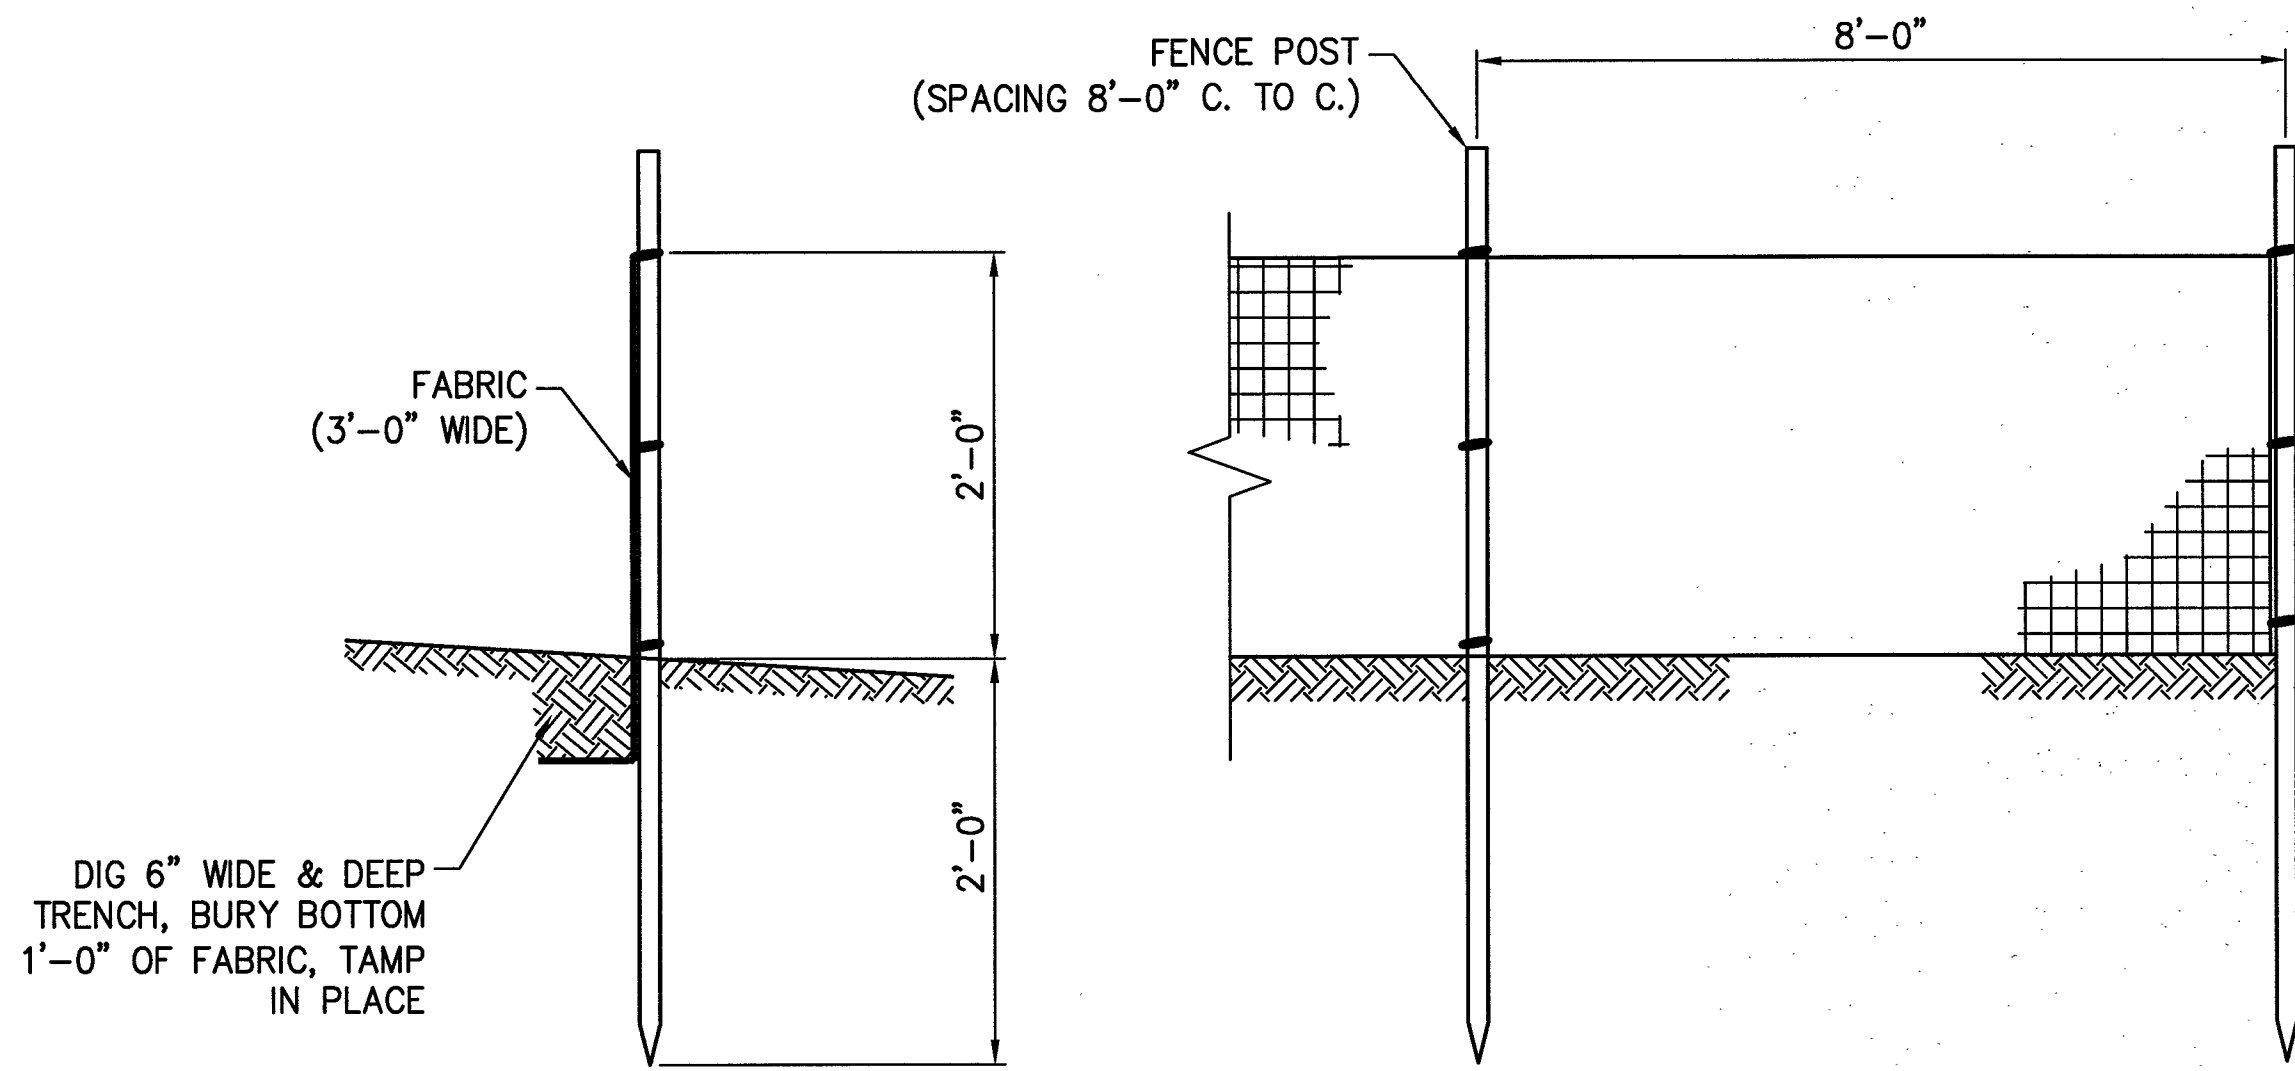


1 SILT FENCE
NT.S.

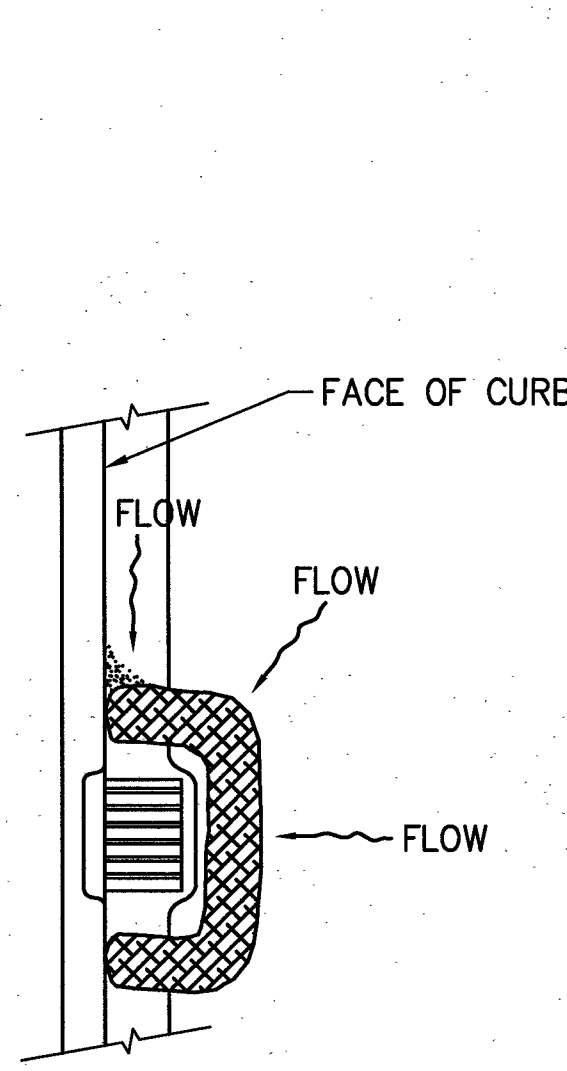


2 FIBER ROLL
NT.S.

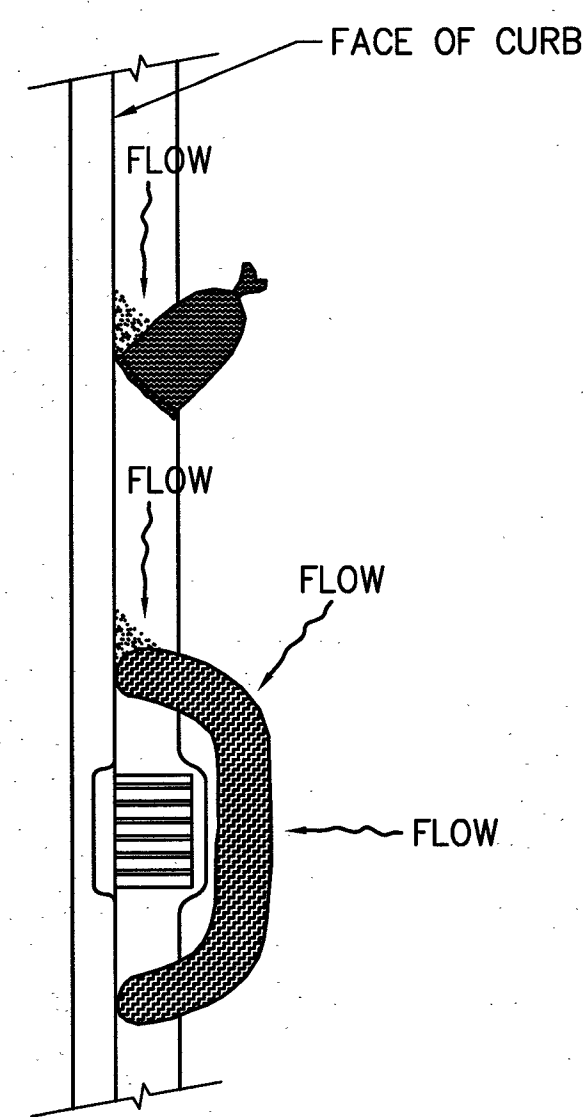


3 SAND BAG/ ROLL
NT.S.

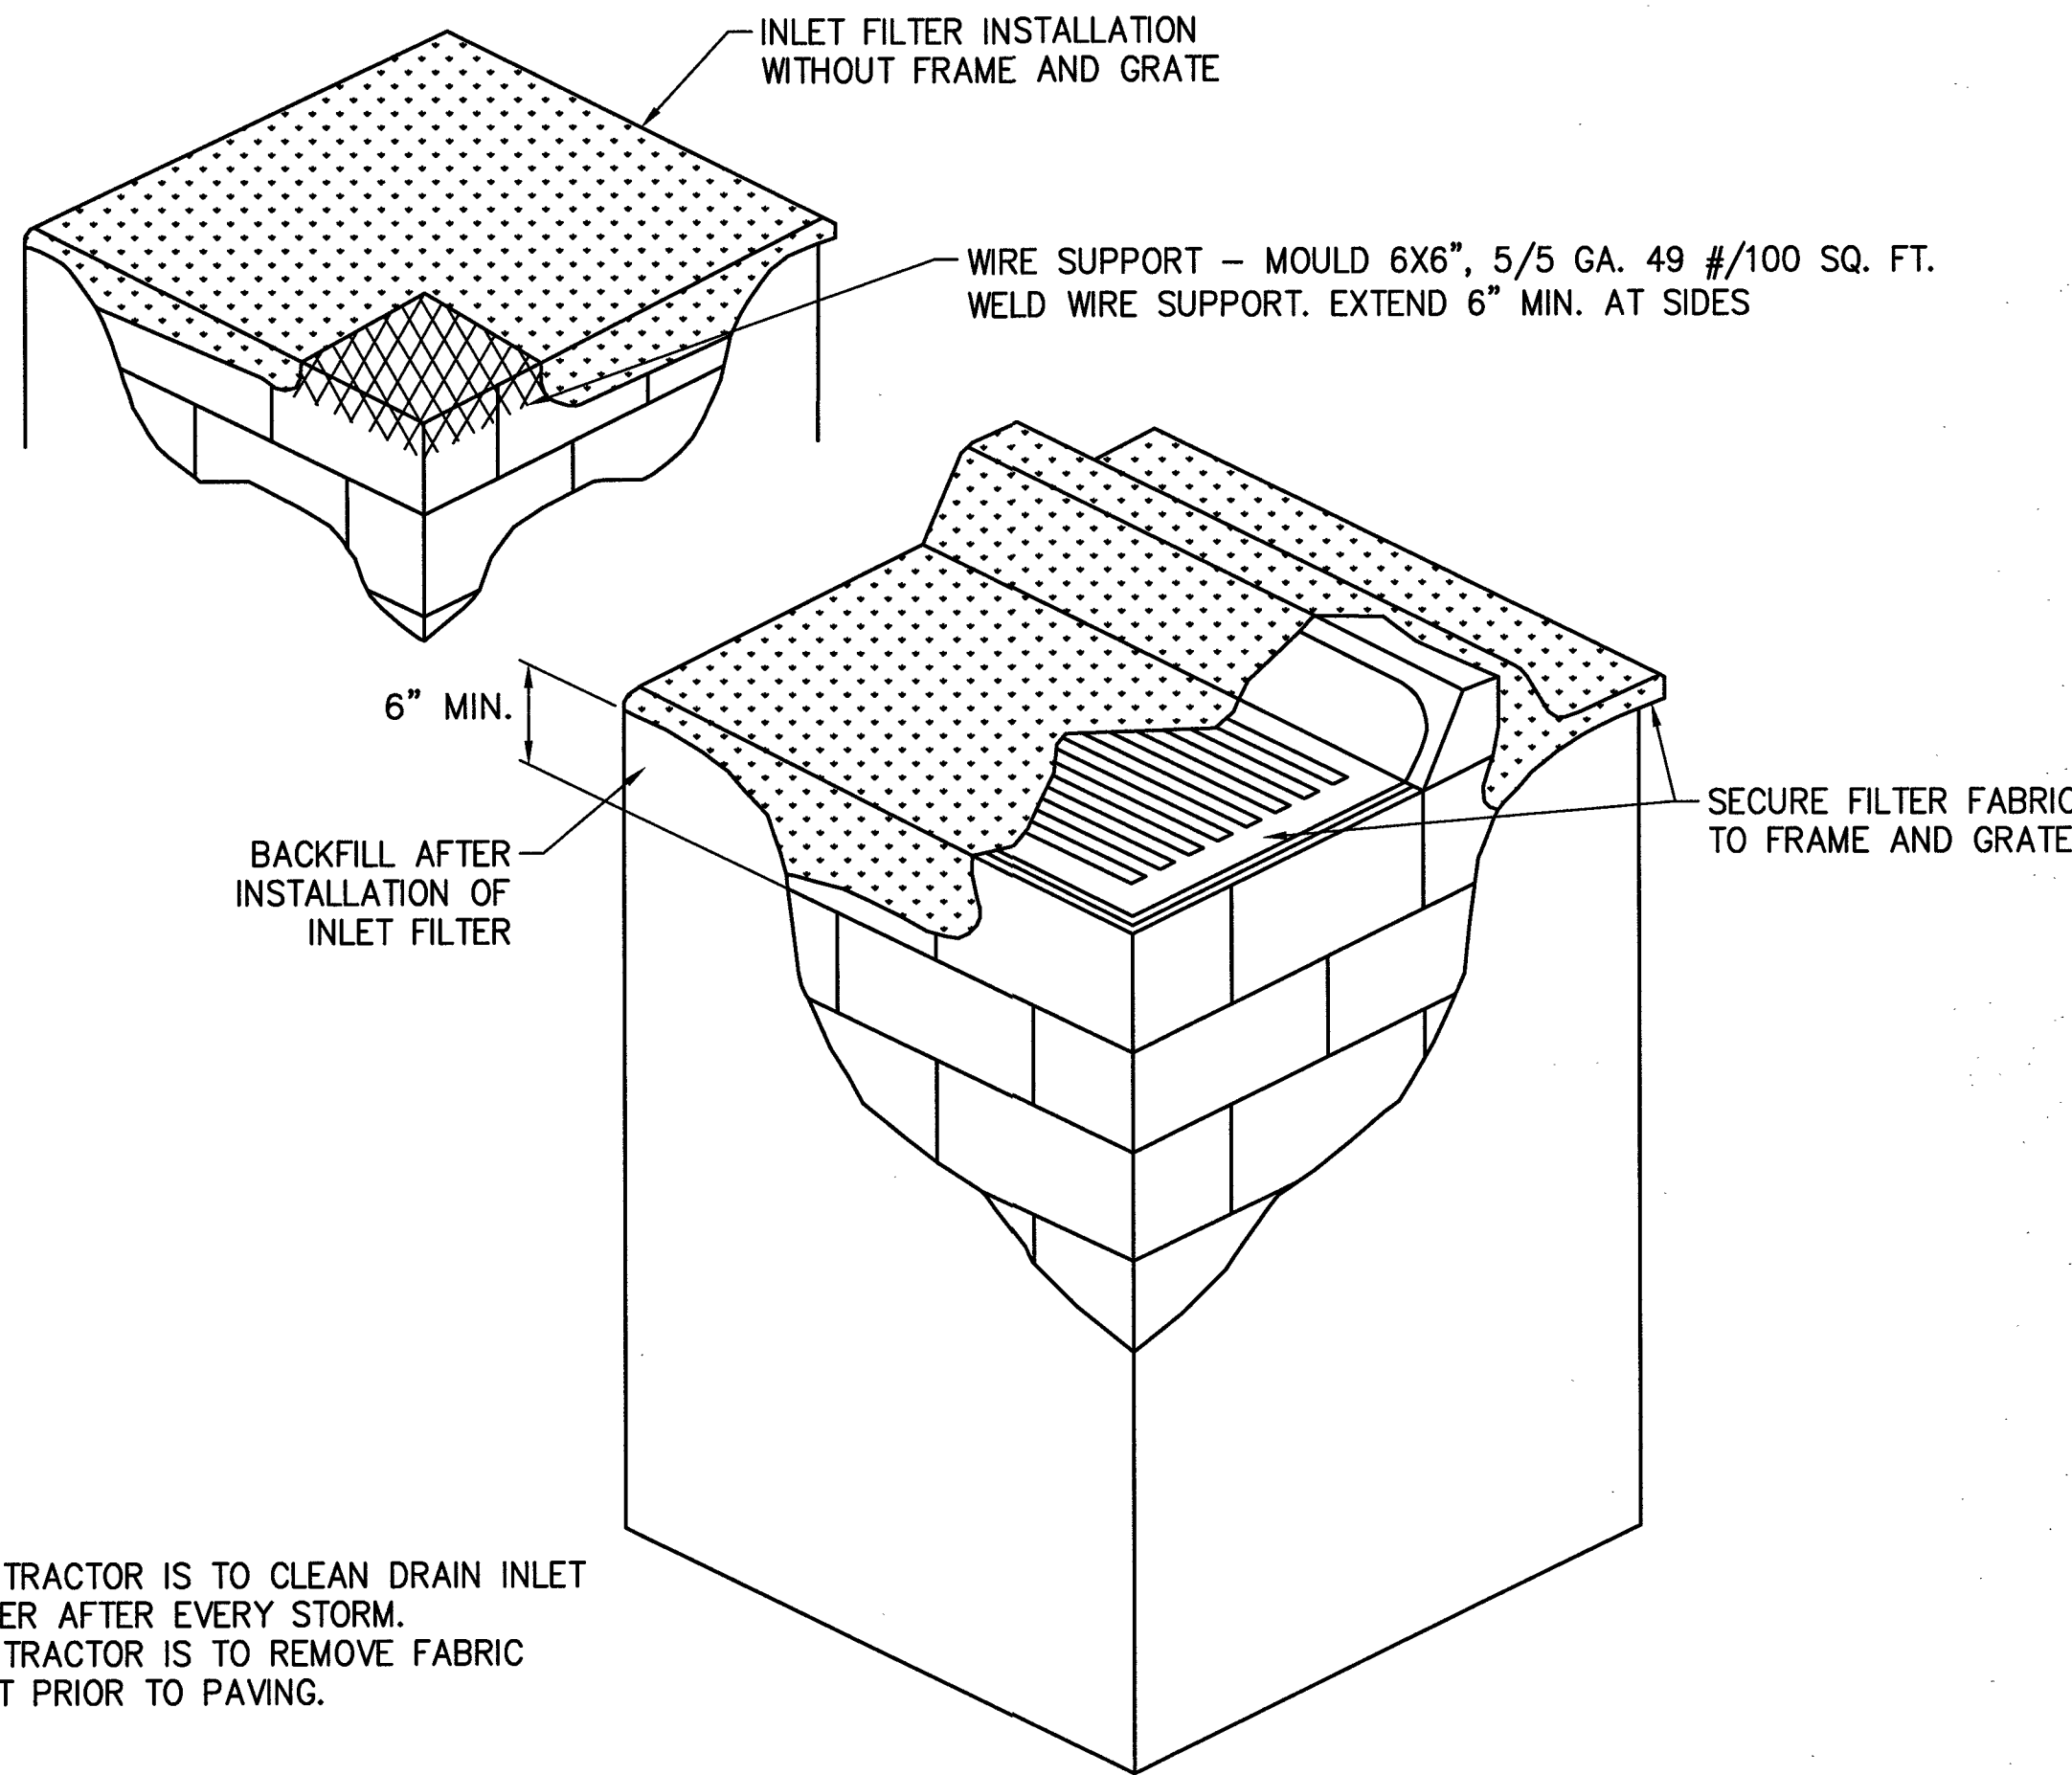


4 DRAIN INLET FILTER
NT.S.

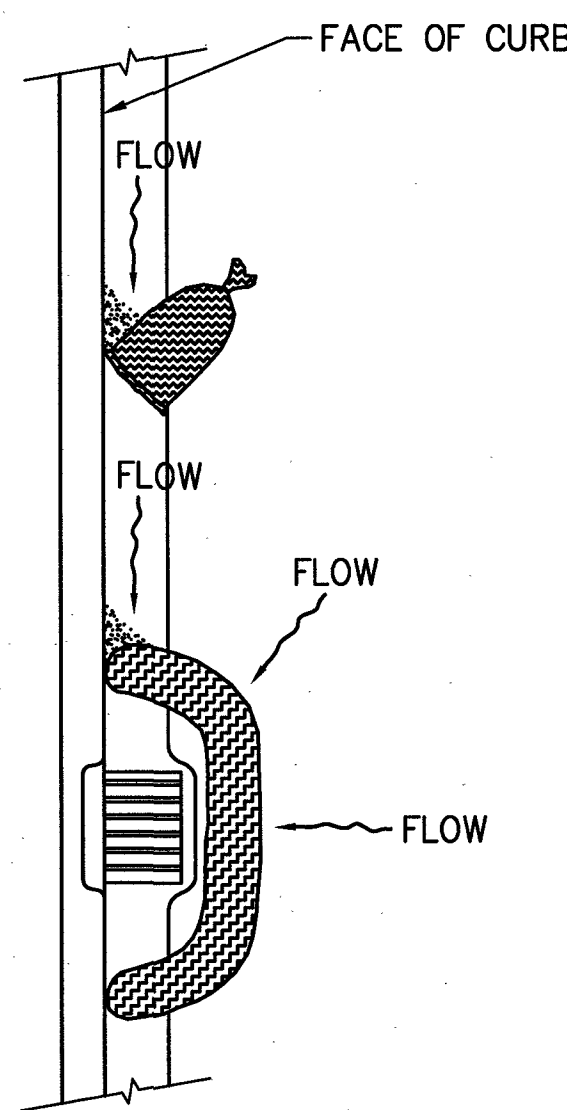

5 GRAVEL BAG/ ROLL
NT.S.

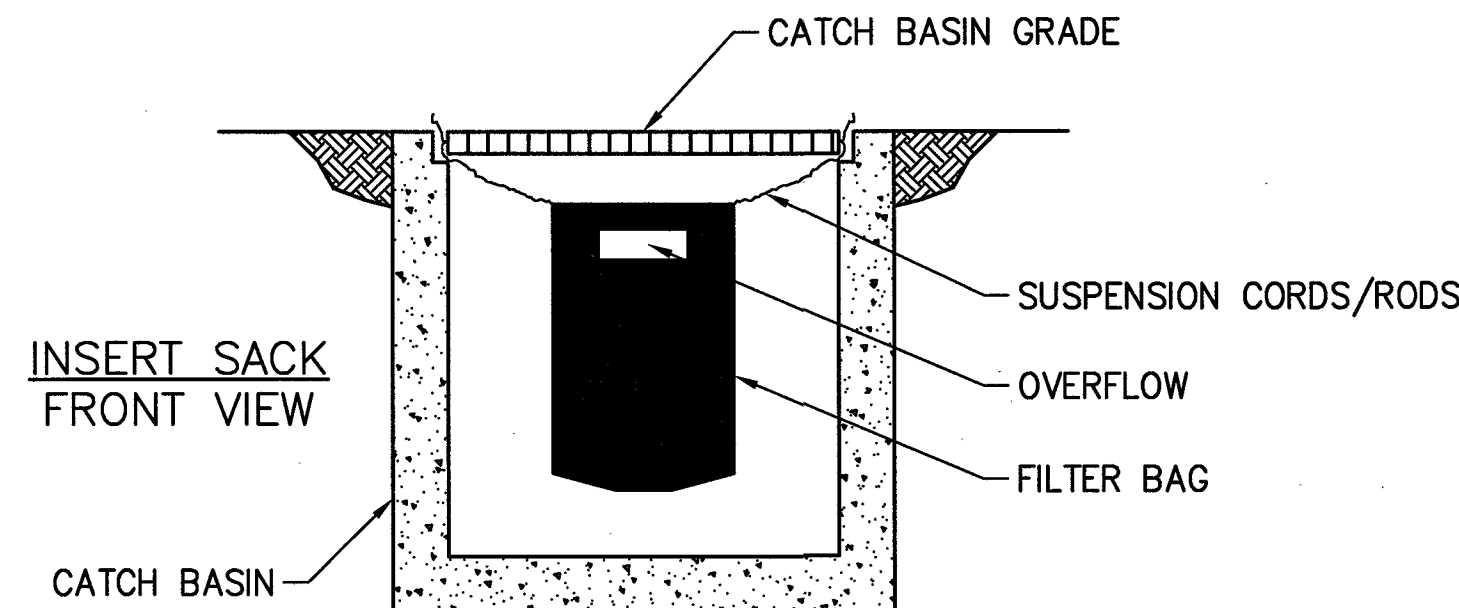


6 SEDIMENT FILTER BAG
NT.S.

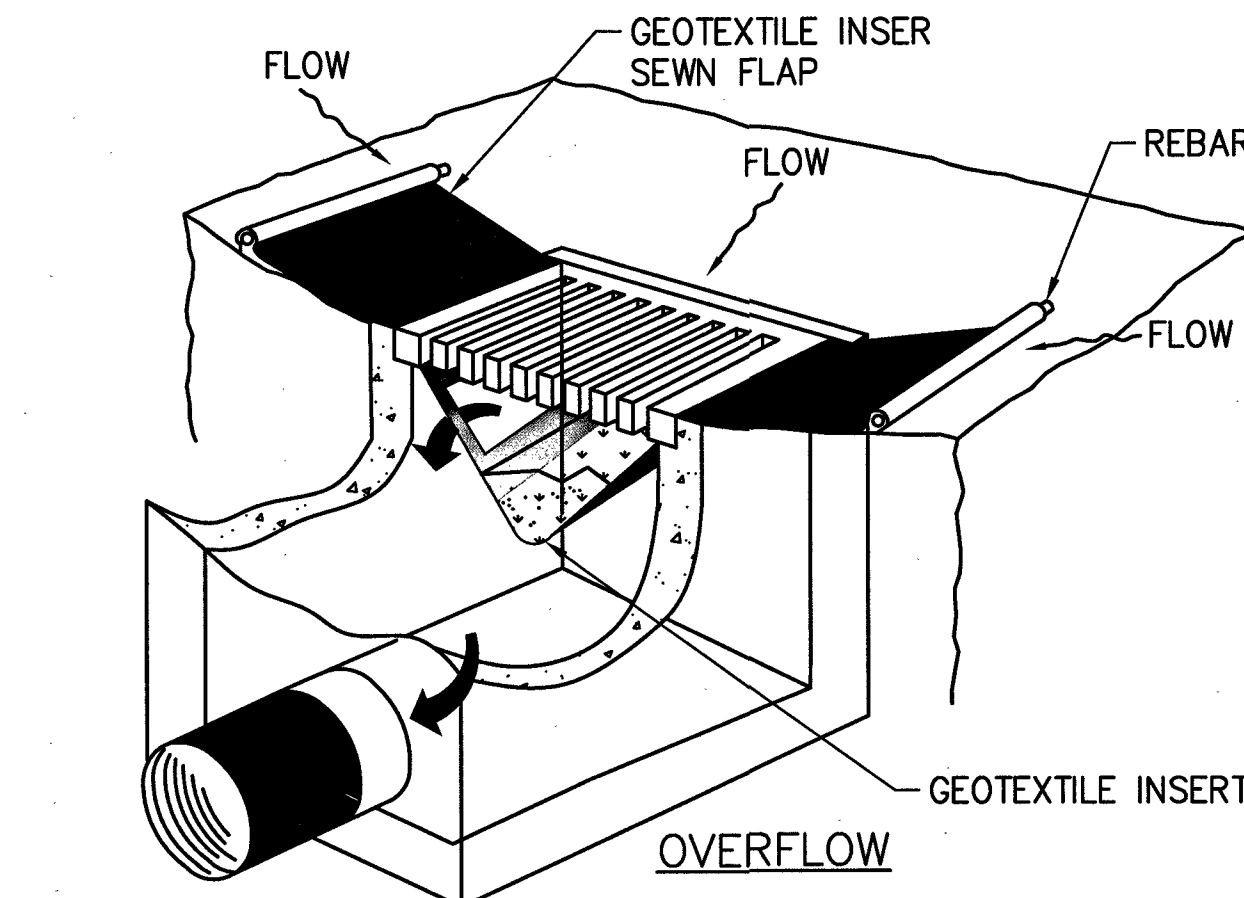

NOTE: RECESSED CURB INLET MUST BE BLOCKED WHEN USING FILTER FABRIC INLET SACKS. SIZE OF FILTER FABRIC INLET SACK TO BE DETERMINED BY MANUFACTURER.

- SWPPP NOTES
1. SOUTHWEST GAS CORPORATION. IT'S CONTRACTOR, AND/OR THEIR AUTHORIZED AGENTS SHALL INSTALL ONE OF THE APPROPRIATE BMP'S FOR THE PROTECTION OF EXISTING STORM DRAIN INLETS, WITHIN OR SIGNIFICANTLY NEAR ANY IMPROVED RIGHT-OF-WAY, FROM DEBRIS AND SEDIMENT RESULTING FROM CONSTRUCTION OF NATURAL GAS FACILITIES.
 2. SOUTHWEST GAS CORPORATION, ITS CONTRACTOR, AND/OR THEIR AUTHORIZED AGENTS SHALL EACH DAY REMOVE ALL SEDIMENT, MUD CONSTRUCTION DEBRIS, OR OTHER POTENTIAL POLLUTANTS THAT MAY HAVE BEEN DISCHARGED TO, OR ACCUMULATED IN, THE PUBLIC RIGHTS OF WAY OF CLARK COUNTY AS A RESULT OF CONSTRUCTION ACTIVITIES ASSOCIATED WITH THIS SITE DEVELOPMENT OR CONSTRUCTION PROJECT. SUCH MATERIALS SHALL BE PREVENTED FROM ENTERING THE STORM SEWER SYSTEM, USING BEST MANAGEMENT PRACTICES DETAIL ON THIS SHEET.
 3. ADDITIONAL CONSTRUCTION SITE DISCHARGE BEST MANAGEMENT PRACTICES MAY BE REQUIRED OF SOUTHWEST GAS CORPORATION, IT'S CONTRACTOR, AND/OR THEIR AUTHORIZED AGENTS DUE TO UNFORESEEN EROSION PROBLEMS OR IF THE LISTED BMP'S ON THIS SHEET DO NOT MEET THE PERFORMANCE STANDARDS SPECIFIED IN THE CLARK COUNTY CODE - CHAPTER 24.0/STORM SEWER SYSTEM DISCHARGE AND THE LAS VEGAS VALLEY CONSTRUCTION SITE BMP GUIDANCE MANUAL.
 4. ACCUMULATED SEDIMENT IN BMP'S SHALL BE REMOVED WITH SEVEN DAYS AFTER A STORM WATER RUNOFF EVENT OR PRIOR TO THE NEXT ANTICIPATED STORM EVENT, WHICHEVER IS EARLIER. SEDIMENT MUST BE REMOVED WHEN BMP DESIGN CAPACITY HAS BEEN REDUCED BY 50 PERCENT OR MORE.

- NOTE:
1. CONTRACTOR IS TO CLEAN DRAIN INLET FILTER AFTER EVERY STORM.
 2. CONTRACTOR IS TO REMOVE FABRIC JUST PRIOR TO PAVING.

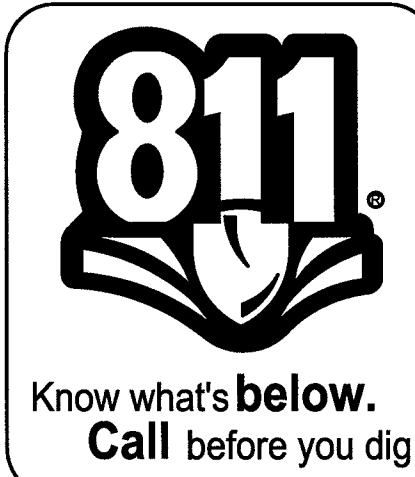

1	UPDATED ALIGNMENT WR 3344147	BS	03/26/2018	
2	ABANDON STUB 6' NORTH OF TEE ON UTAH	BS	04/06/2018	
3				
4				
NO.	DESCRIPTION	BY	DATE	APPVD.

REVISIONS				
SOUTHWEST GAS CORPORATION				

TAX CODES	UNIT NO.	UNIT TYPE	INSTL. PROPOSED	RETIRED	INSTL. COMPLETED	RETIRED
PROPERTY UNITS						

AS-BUILT DRAWING-PRESSURE TEST DATA			
PIPE DIA.	TEST MEDIUM	TEST METHOD	
PIPE LENGTH	☐ AIR	☐ GAUGE	
PIPE TYPE	☐ NITROGEN	☐ CHART	
MIN. DURATION	☐ WATER	☐ GAUGE/ PRESS REC SN#	
TEST PRES. (PSIG): (MAX)	(MIN)		
TIME: (START)	(STOP)		
DATE: (START)	(STOP)		
PERFORMED BY:			
SWG VERIFIED BY:			

INDIVIDUAL PERFORMING VISUAL INSPECTION	
VISUAL INSPECTION CERTIFICATION	
I HAVE VISUALLY INSPECTED ALL HEATED FUSIONS, JOINT CEMENT, MECHANICAL JOINTS, AND WELDS. THAT I HAVE PERFORMED	
NAME	DATE
INSPECTOR	
FOREMAN	
REVIEWED BY	
PERMIT INFORMATION	
CITY OF LAS VEGAS	
TAX CODE 02-0203	
AS-BUILTS ACCEPTED BY	DATE
POSTED BY	DATE
POSTING QCD BY	DATE

CONSTRUCTION	
INSPECTOR	
FOREMAN	
REVIEWED BY	
PERMIT INFORMATION	
CITY OF LAS VEGAS	
TAX CODE 02-0203	

ISOLATION AREA	W.R. NO.
ISO_21	3113007
DIST_096	
LOCATION	ATLAS #/TILE #
SEC 4	x624y510
T21S R61E	
M.D.M.	

ENGINEER/TECH: BOBBIE SKROVE	PHONE: 702-365-2237
ACCOUNT REP:	PHONE:
PROJECT CONTACT: BOBBIE SKROVE	PHONE: 702-365-2237
SHEET NO: 7 OF 7	SCALE: NTS
DWN. BY: SEI	CHKD. BY:
DATE: 04/25/2017	APPVD. BY:
TITLE	
F-CLV-INDUSTRIAL RD	
WYOMING AVE TO UTAH AVE	
2" PE RELOCATION	
DETAIL SHEET	