


1

SYSTEM	D_VALLEY_WIDE
DR. NO.	21DR10008938
SEGMENT M.A.O.P.	60_PSIG
SYSTEM M.A.O.P.	43_PSIG
SYSTEM M.O.P.	43_PSIG

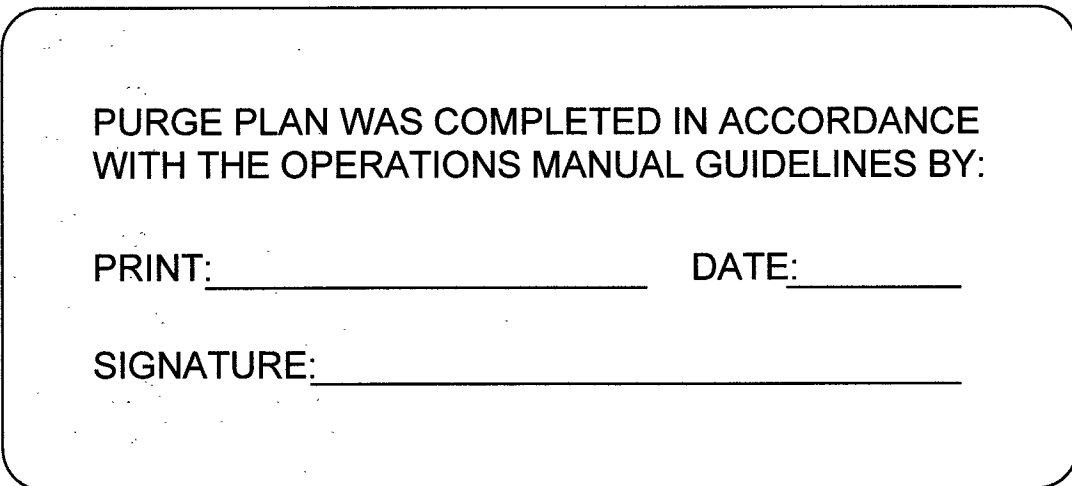

pk

3760102	2" PE	640'	526'
---------	-------	------	------



SOUTHWEST GAS CORPORATION

PROPERTY UNITS




SWG VERIFIED BY:

AS-BUILTS ACCEPTED BY

PERMIT INFORMATION
CITY OF LAS VEGAS
TAX CODE 02-0203

LOCATION
SEC 4
T21S R61E
M.D.M.


F-CLV-2" PE RELO - INDUSTRIAL
NEW YORK AVE. TO WYOMING
MATERIALS & NOTES

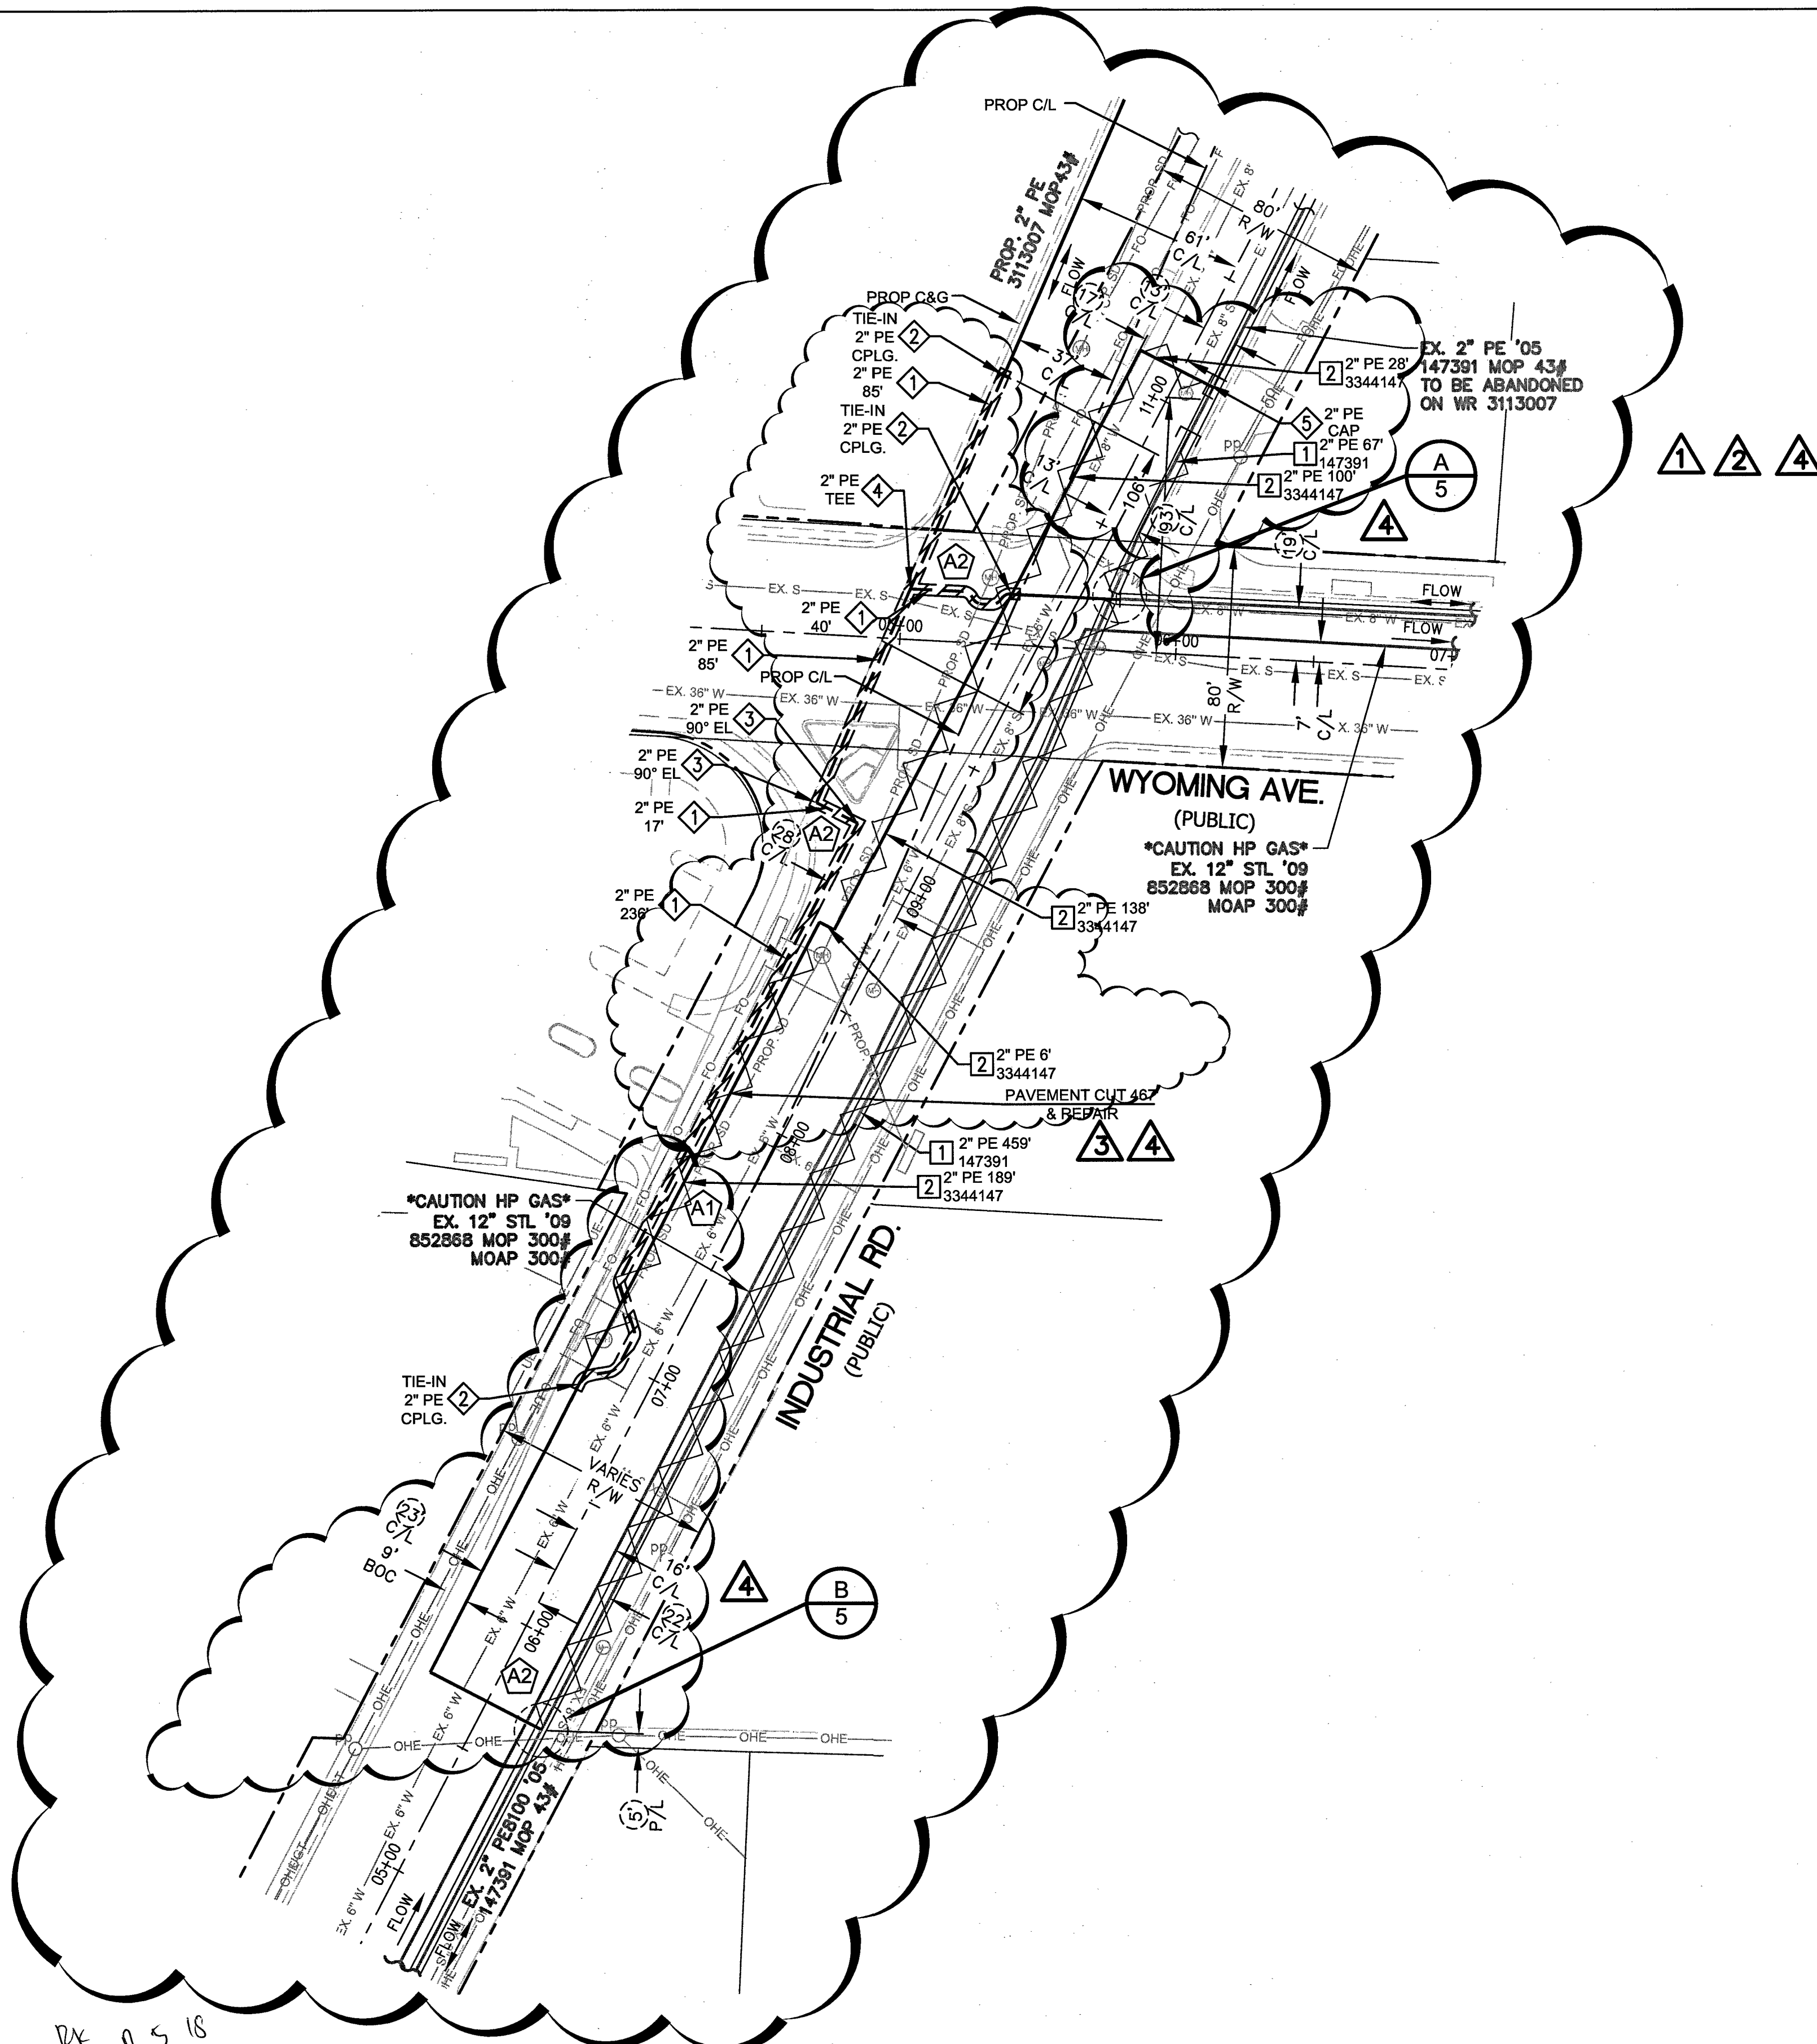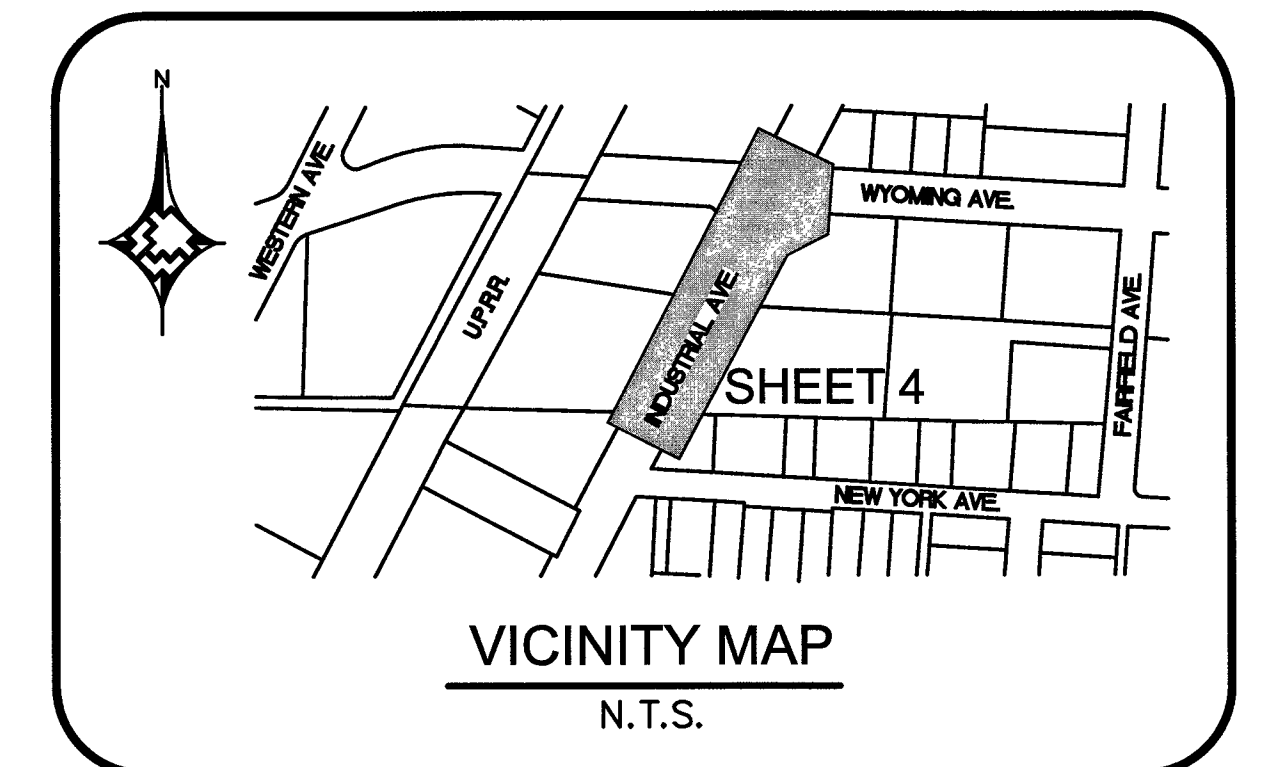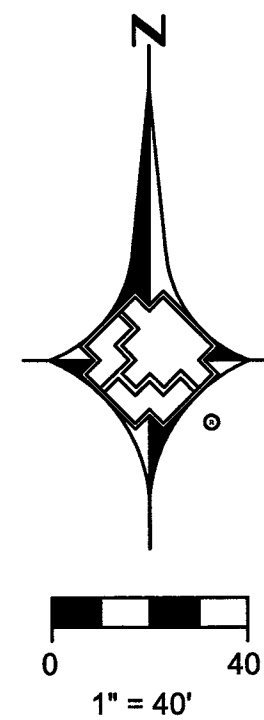

MATERIAL LIST FOR PROPOSED DISTRIBUTION FACILITIES		
ITEM#	STOCK ID#	DESCRIPTION
1	100-5101	2" PE MAIN
2	140-3532	2" PE COUPLING
3	140-3067	2" PE 90 DEGREE ELBOW
4	140-3074	2" PE TEE
5	140-3060	2" PE CAP

MATERIAL LIST FOR ABANDONED FACILITIES		
ITEM#	STOCK ID#	DESCRIPTION
1	3760102	ABANDON EX. 2" PE '05 (INSERTED IN 3" SLV) MOP 43#
2	3760102	ABANDON EX. 2" PE '18

RTC NOTES:
PAVEMENT REPAIR SHALL CONFORM TO RTC:
A1 500.3
A2 500.5
A3 503

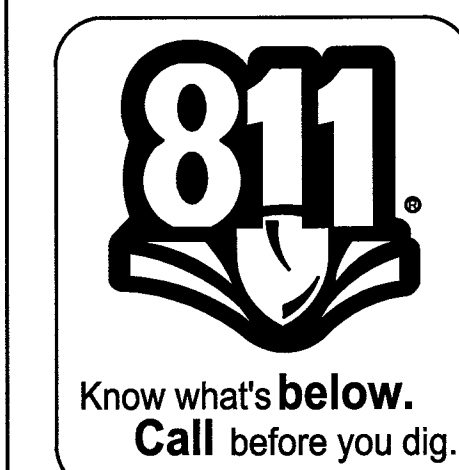

REVISIONS		PROPERTY UNITS	
NO.	DESCRIPTION	BY	DATE
1.	ALIGNMENT CHANGE ALONG INDUSTRIAL	KD	02/16/18
2.	ALIGNMENT CHANGE ALONG INDUSTRIAL	BS	02/26/18
3.	ALIGNMENT CHANGE ALONG INDUSTRIAL	BS	02/27/18
4.	ALIGNMENT CHANGE ALONG INDUSTRIAL	BS	07/02/18
TAX CODES		UNIT NO.	UNIT TYPE
		INSTL.	RETIRED
		PROPOSED	COMPLETED

AS-BUILT DRAWING-PRESSURE TEST DATA		INDIVIDUAL PERFORMING VISUAL INSPECTION	
PIPE DIA.	TEST MEDIUM	VISUAL INSPECTION CERTIFICATION	
PIPE LENGTH	TEST METHOD	I HAVE VISUALLY INSPECTED ALL HEATED FUSIONS, SOLVENT CEMENT, MECHANICAL JOINTS, AND WELDS THAT HAVE PERFORMED	
PIPE TYPE	GAUGE	NAME _____ DATE _____	
MIN. DURATION	CHART		
TEST PRES. (PSIG) (MAX)	WATER GAUGE/ PRESS REC SN#		
TIME: (START) (STOP)			
DATE: (START) (STOP)			
PERFORMED BY:			
SWG VERIFIED BY:			





CONSTRUCTION		PERMIT INFORMATION	
INSPECTOR		CITY OF LAS VEGAS	
FOREMAN		TAX CODE 02-0203	
REVIEWED BY			

ISOLATION AREA	W.R. NO.
ISO_21	3344147
DIST_096	
LOCATION	ATLAS #/TILE #
SEC 4	x624y510
T21S R61E	
M.D.M.	

ENGINEER/TECH: BOBBIE SKROVE		PHONE: 702-365-2237			
ACCOUNT REP:		PHONE:			
PROJECT CONTACT: BOBBIE SKROVE		PHONE: 702-365-2237			
SHEET NO: 4 OF 5	SCALE: 1" = 40'	DATE: 03/13/2017			
DWN. BY: SEI	CHKD. BY:	APPVD. BY:			
TITLE					
F-CLV-2" PE RELO - INDUSTRIAL					
NEW YORK AVE. TO WYOMING					
DESIGN PLAN					

ITEM#	STOCK ID#	DESCRIPTION
1	100-5101	2" PE MAIN
2	140-3532	2" PE COUPLING
3	140-3067	2" PE 90° ELBOW

ITEM#	STOCK ID#	DESCRIPTION
1	3760102	ABANDON EX. 2" PE '05 (INSERTED IN 3" SLV) MOP 43#

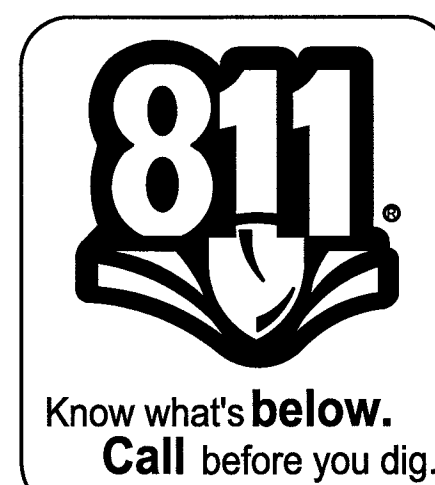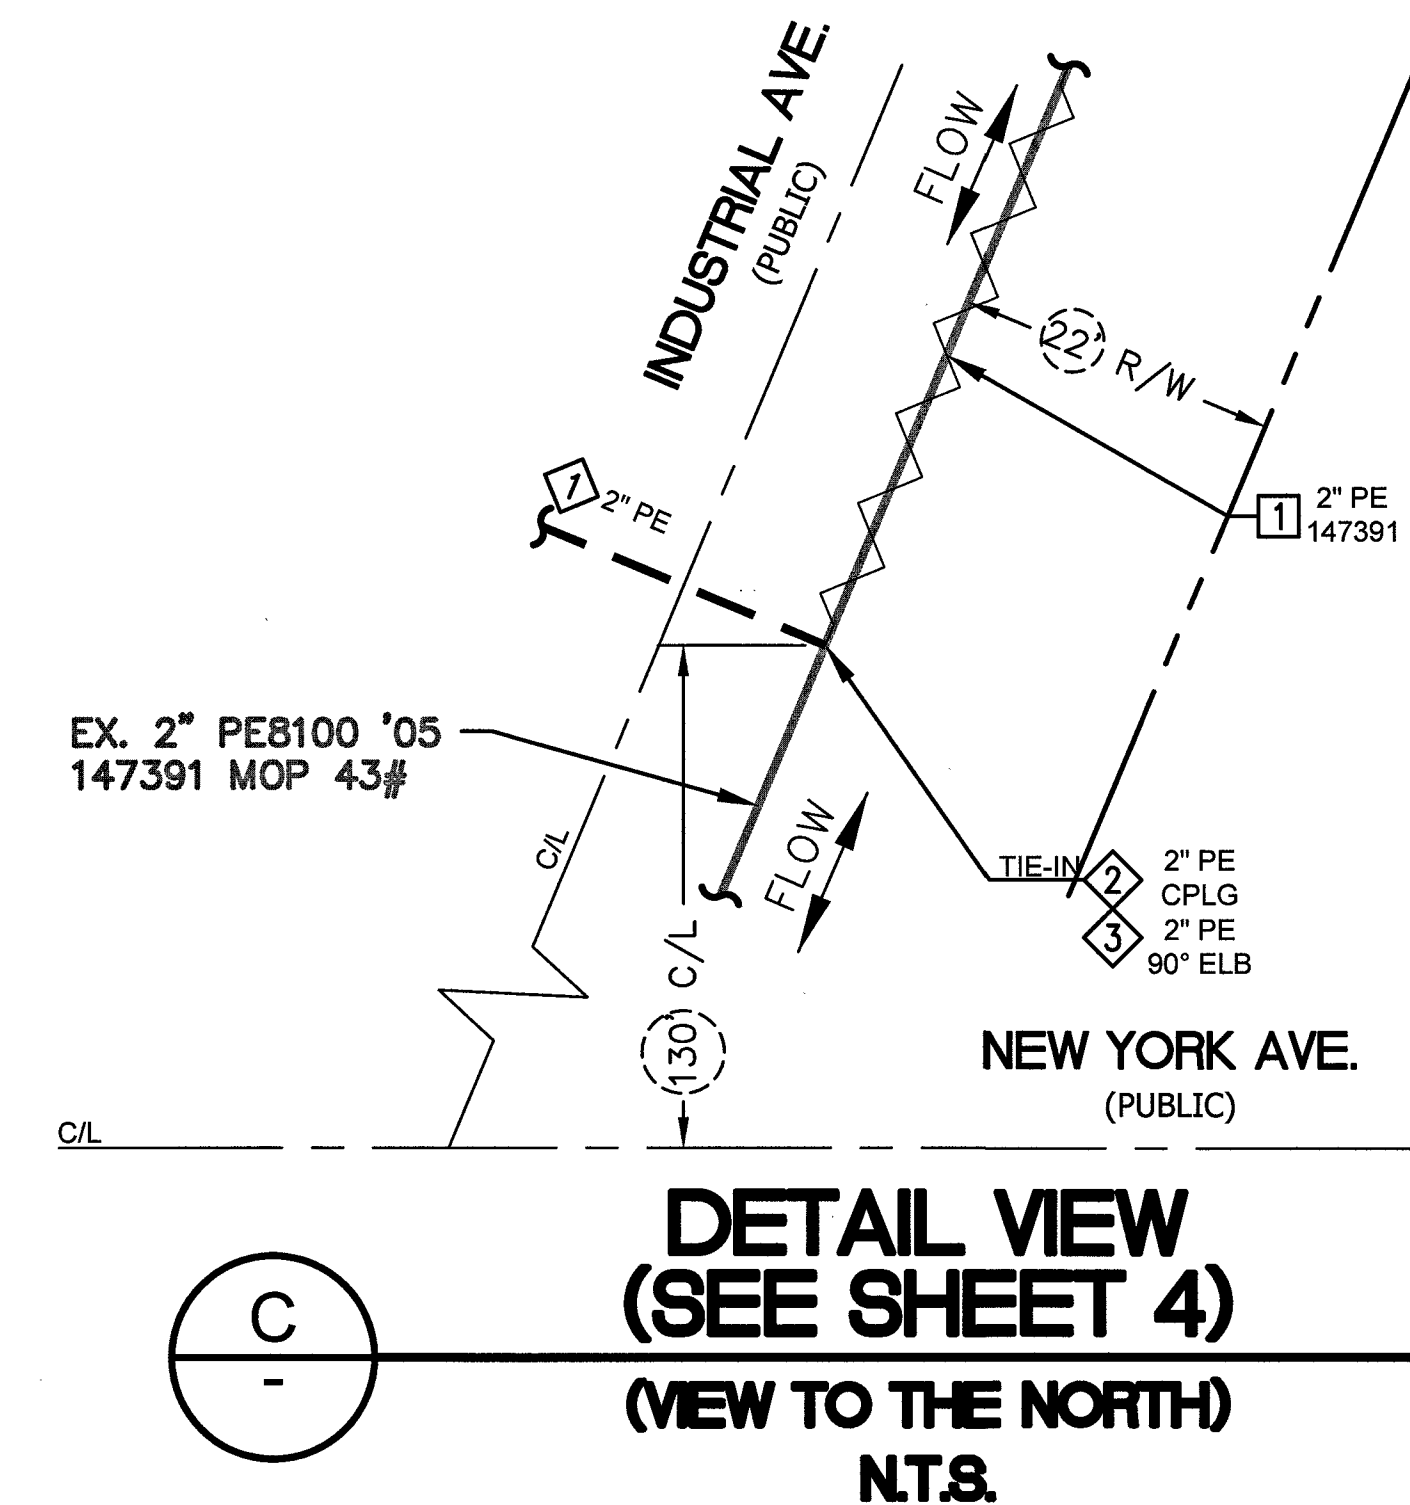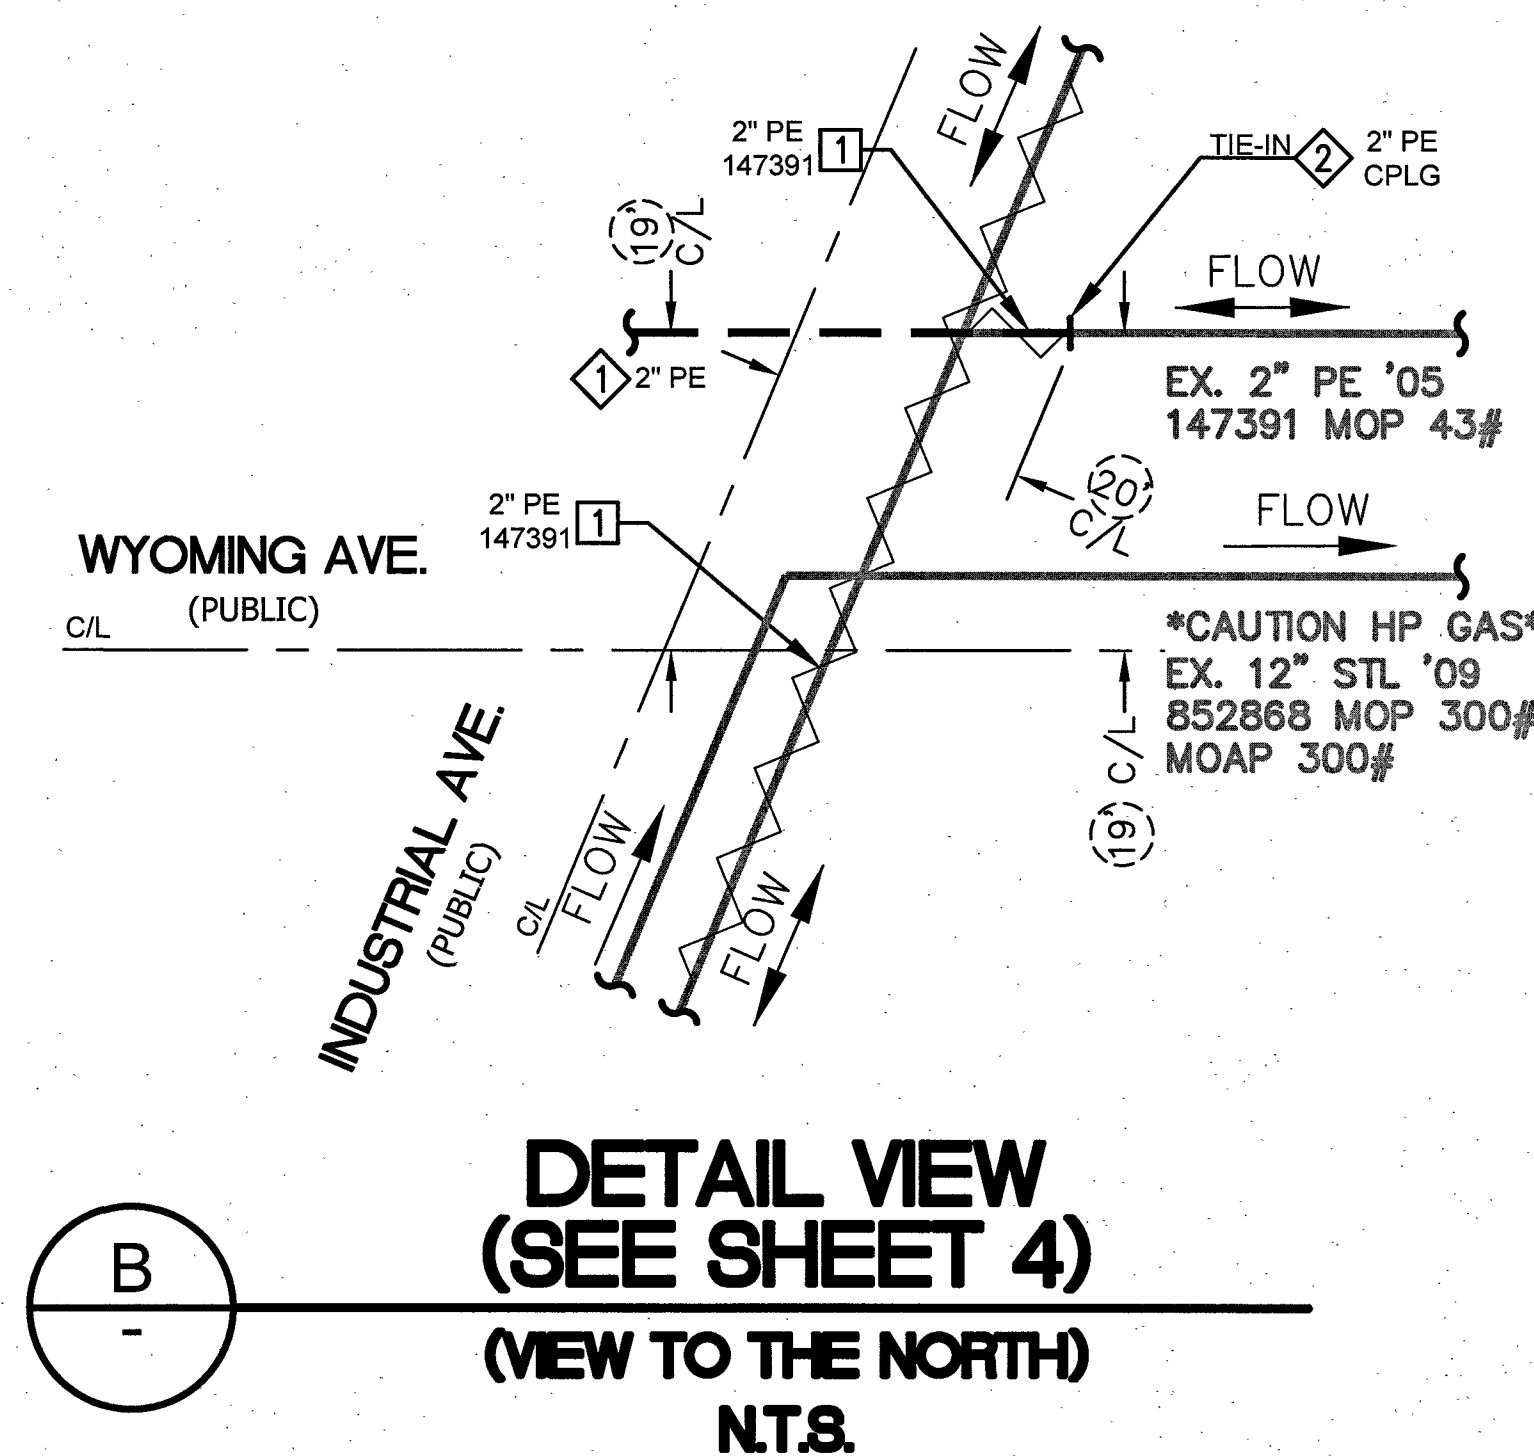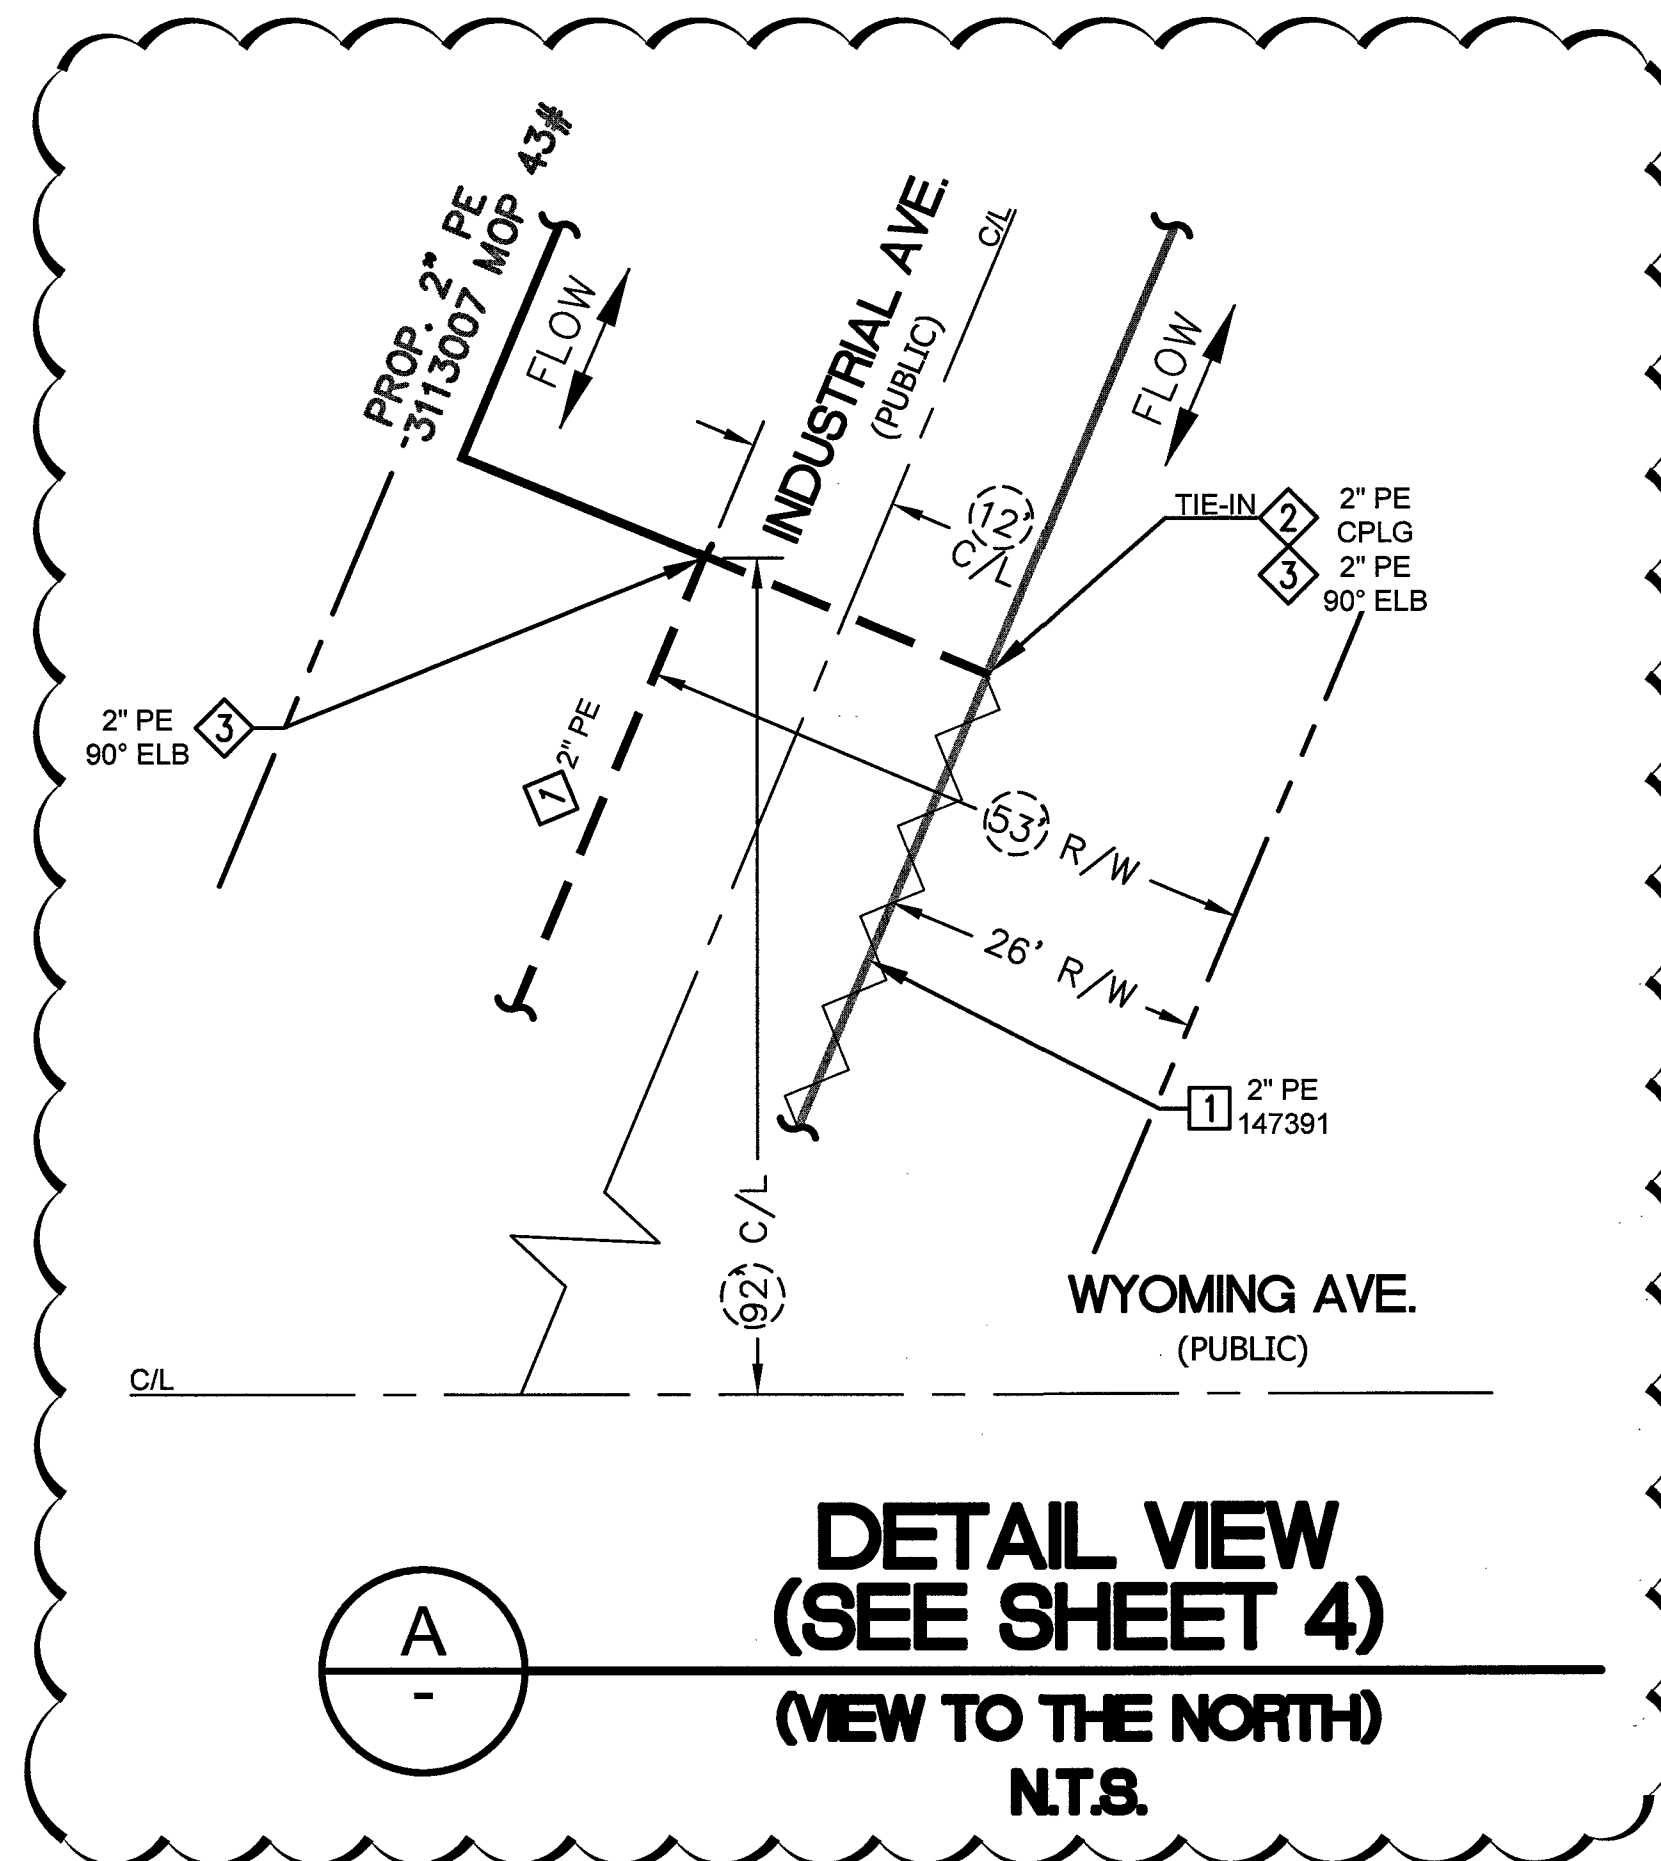

1. ALIGNMENT CHANGE ALONG INDUSTRIAL						KD	02/07/18
2.							
3.							
4.							
NO.	DESCRIPTION					BY	DATE APPVD
REVISIONS							
TAX CODES	UNIT NO.	UNIT TYPE	INSTL. PROPOSED	RETIRED PROPOSED	INSTL. COMPLETED	RETIRED COMPLETED	
PROPERTY UNITS							

AS-BUILT DRAWING-PRESSURE TEST DATA			
PIPE DIA. _____	TEST MEDIUM ☐ AIR ☐ NITROGEN ☐ WATER ☐ SOAP	TEST METHOD ☐ GAUGE ☐ CHART GAUGE/ PRESS REC SN# _____	
PIPE LENGTH _____			
PIPE TYPE _____			
MIN. DURATION _____			
TEST PRES. (PSIG) (MAX) _____	(MIN) _____		
TIME (START) _____	(STOP) _____		
DATE (START) _____	(STOP) _____		
PERFORMED BY: _____	SNG VERIFIED BY: _____		

INDIVIDUAL PERFORMING VISUAL INSPECTION	
VISUAL INSPECTION CERTIFICATION	
I HAVE VISUALLY INSPECTED ALL HEATED FUSIONS, SOLVENT CEMENT, MECHANICAL JOINTS, AND WELDS THAT HAVE BEEN PERFORMED	
NAME _____	DATE _____
FOREMAN _____	
REVIEWED BY _____	
AS-BUILTS ACCEPTED BY _____	DATE _____
POSTED BY _____	DATE _____
POSTING Q'C'D BY _____	DATE _____

CONSTRUCTION	
INSPECTOR _____	
FOREMAN _____	
REVIEWED BY _____	
PERMIT INFORMATION	
CITY OF LAS VEGAS	
TAX CODE 02-0203	

ISOLATION AREA	W.R. NO.
ISO_21 DIST_096	3344147
LOCATION	ATLAS #/TITLE #
SEC 4 T21S R61E M.D.M.	x624y510

ENGINEER/TECH: BOBBIE SKROVE	PHONE: 702-365-2237
ACCOUNT REP:	PHONE:
PROJECT CONTACT: BOBBIE SKROVE	PHONE: 702-365-2237
SHEET NO: 5 OF 5	SCALE: NTS DATE: 03/13/2017
DWN. BY: SEI	CHKD. BY: APPVD. BY:
TITLE	
F-CLV-2" PE RELO - INDUSTRIAL NEW YORK AVE. TO WYOMING DETAIL SHEET	

RTC NOTES:

PAVEMENT REPAIR SHALL CONFORM TO RTC:

	500.3
	500.5

DOC_3344147