


GIR 2018-CLV-HIGHLAND SQUARE
CITY OF LAS VEGAS, NV
WR#3431281

City of
Las Vegas


Total footage located in Public ROW 4,781'

APPROVED FOR CONSTRUCTION
THIS APPROVAL IS FOR WORK IN CLV R/W OR CLV
EASEMENTS ONLY. OBTAINING PERMISSION OR
EASEMENTS FOR WORK SHOWN ON PRIVATE PROPERTY
IS THE RESPONSIBILITY OF THE UTILITY.


 Approval _____ Date 6 13 18
 C 17-01710-R001 107V7190-GAS

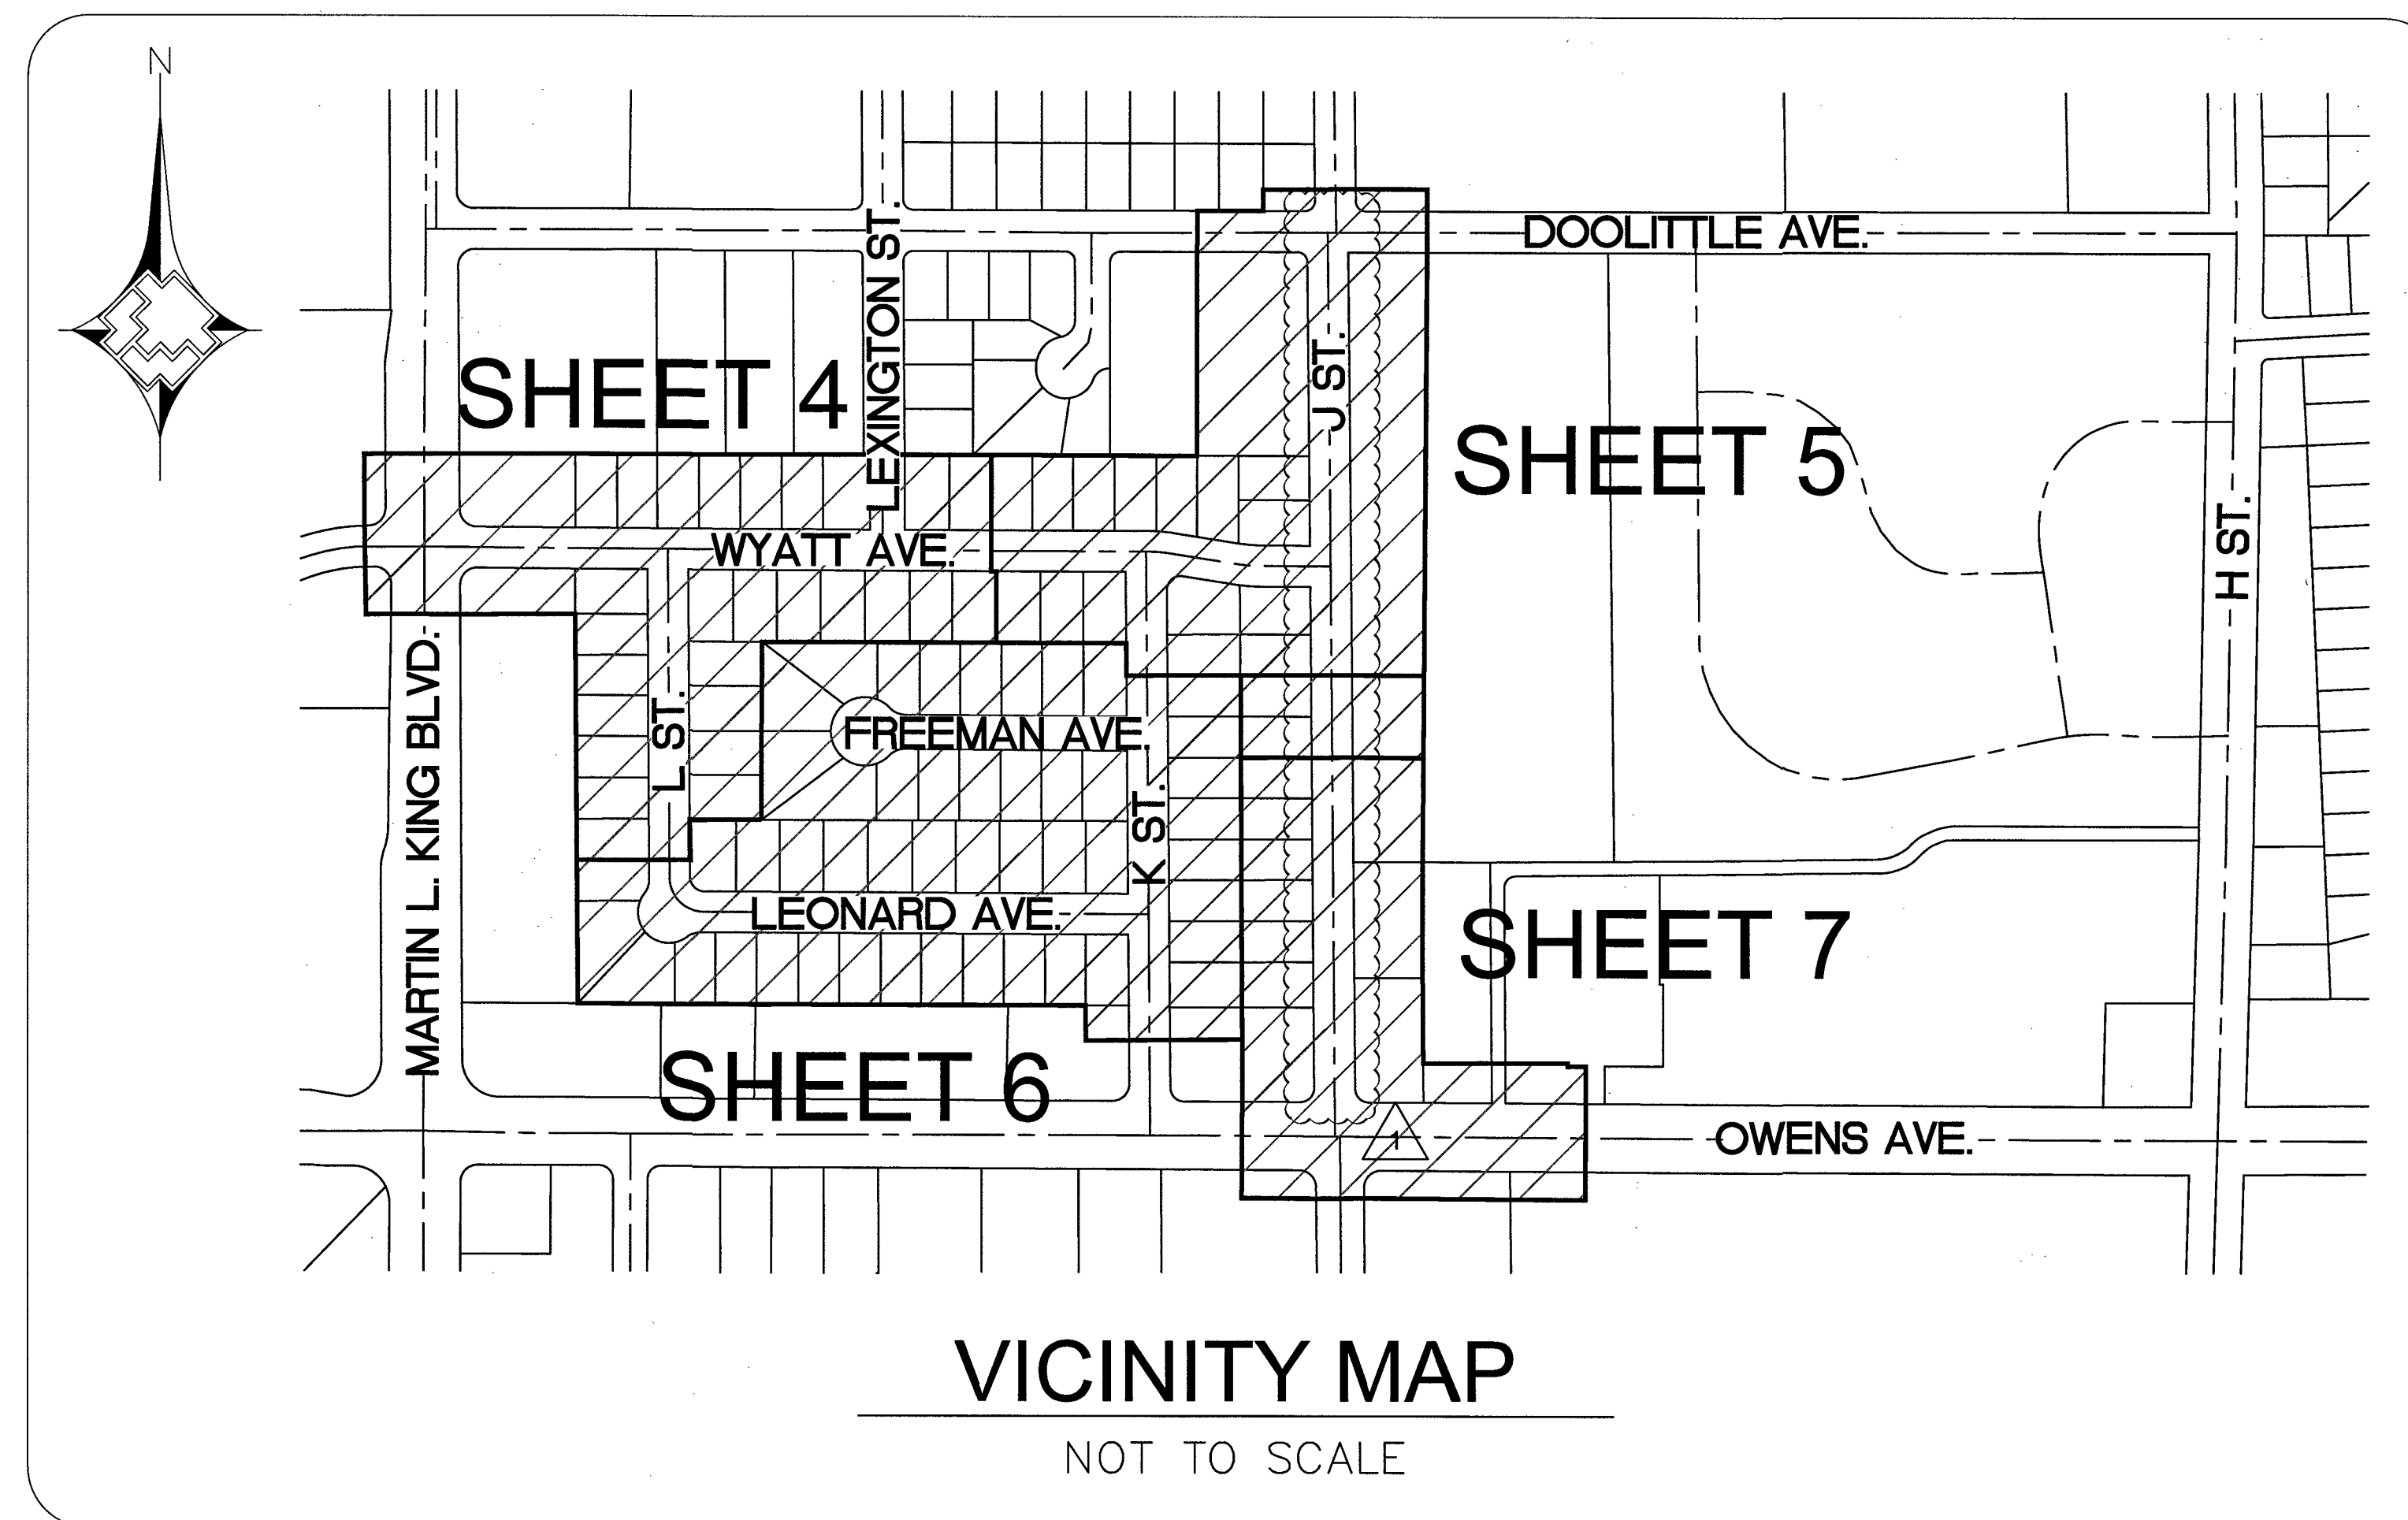


LEGEND

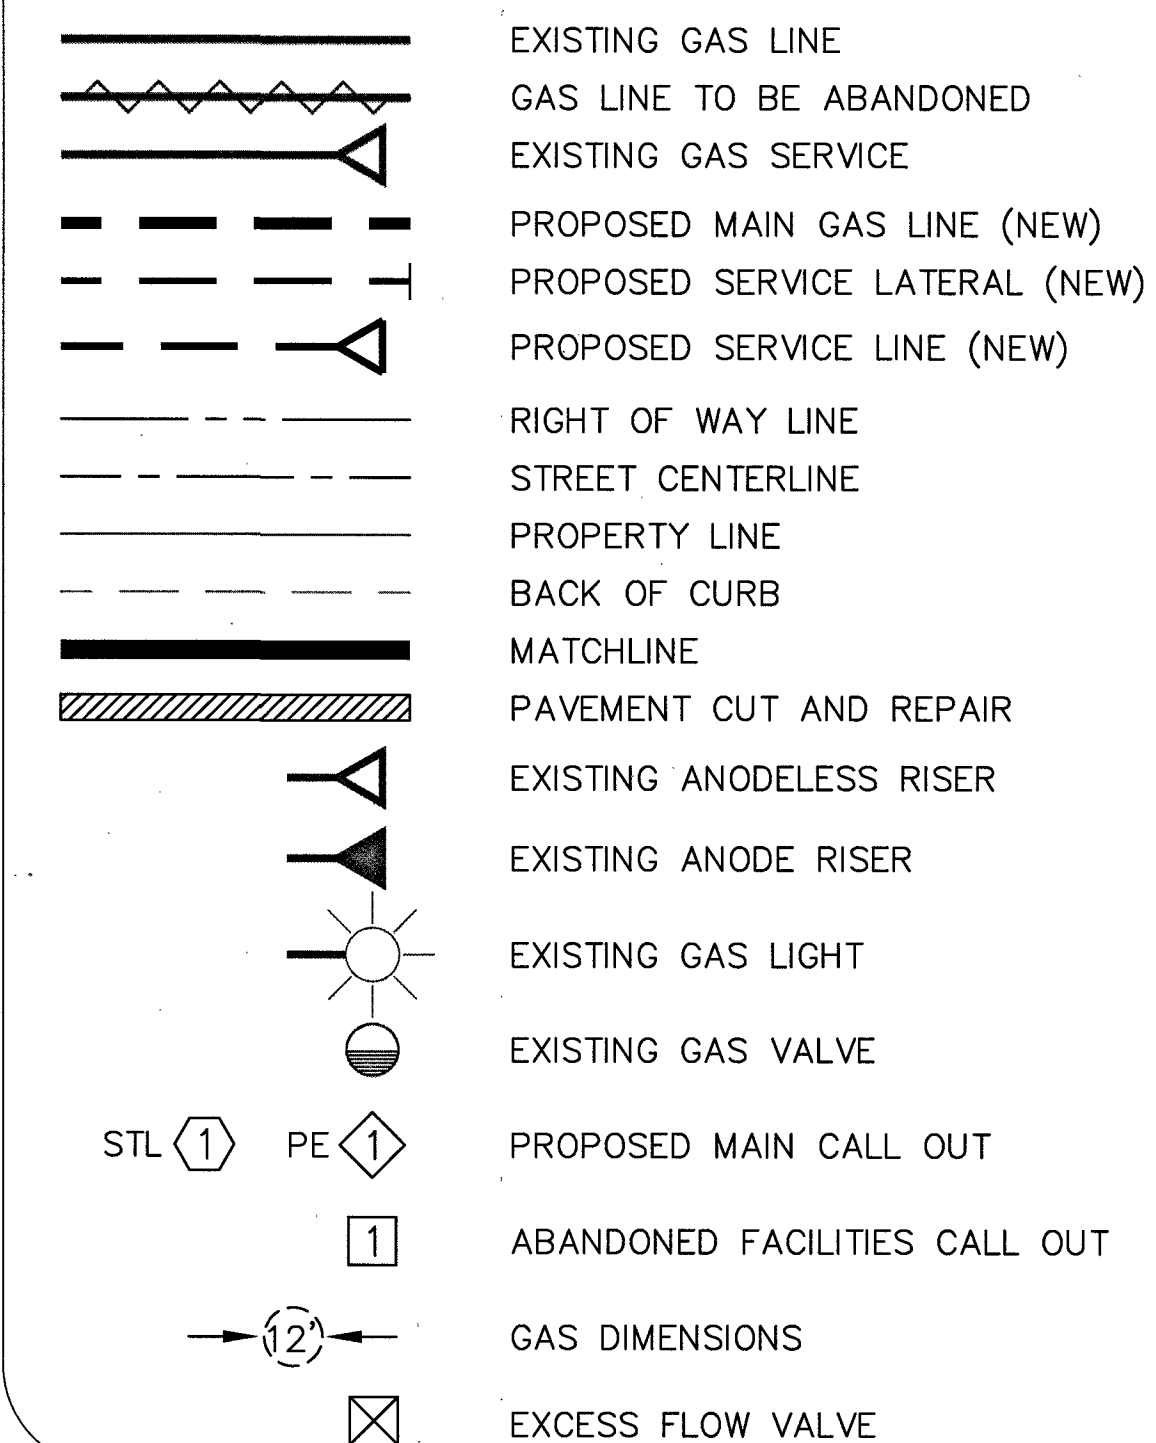

SHEET INDEX

1. COVER SHEET
2. ABBREVIATIONS & NOTES
3. MATERIALS & SIGNATURES
4. DESIGN PLAN
5. DESIGN PLAN
6. DESIGN PLAN
7. DESIGN PLAN
8. DESIGN PLAN
9. DETAIL SHEET A, B, C, D
10. DETAIL SHEET E, F

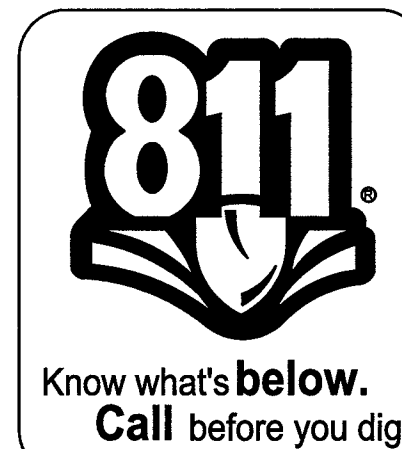


CUSTOMERS 0

A	NEW ALIGNMENT FOR PROP. GAS MAIN ON J ST. RCM 05/23/2018													AS-BUILT DRAWING-PRESSURE TEST DATA TEST MEDIUM TEST METHOD ☐ AIR ☐ GAUGE ☐ NITROGEN ☐ CHART ☐ WATER ☐ SOAP / PRESS REC SN# PIPE DIA _____ PIPE LENGTH _____ PIPE TYPE _____ MIN. DURATION _____ TEST PRES. (PSIG); (MAX) _____ (MIN) _____ TIME; (HOUR) _____ (STOP) _____ DATE; (MONTH) _____ DATE; (YEAR) _____ PERFORMED BY: _____ GWS VERIFIED BY: _____									INDIVIDUAL PERFORMING VISUAL INSPECTION VISUAL INSPECTION CERTIFICATION I HAVE VISUALLY INSPECTED ALL HEATED FUSION, SOLVENT CEMENT, MECHANICAL JOINTS, AND WELDS THAT I HAVE PERFORMED. NAME _____ DATE _____ INSPECTOR _____ FOREMAN _____ REVIEWED BY _____ SEE SHEET 3									CONSTRUCTION PERMIT INFORMATION CITY OF LAS VEGAS TAX CODE 02-0200 AS-BUILTS ACCEPTED BY _____ DATE _____ POSTED BY _____ DATE _____ POSTING QCD'BY _____ DATE _____									ISOLATION AREA ISO_21_DIST_092				W.R. NO. 3431281				ENGINEER/TECH: RAMIRO MENDOZA PHONE: 702-365-2189 ACCOUNT REP: PHONE: PROJECT CONTACT: PHONE:				SHEET NO: 1 OF 9 DWN. BY: SEI				SCALE: NTS CHKD. BY:				DATE: 12/05/2017 APPVD. BY:			
B	NO. DESCRIPTION BY DATE APPVD.						REVOLUTIONS						PROPERTY UNITS UNIT UNIT INSTL RETIRE INSTL RETIRE PROPOSED COMPLETED TAX CODES NOS						SEE SHEET 3						SEE SHEET 3						SEE SHEET 3						LOCATION SEC 21 T20S R61E M.D.M.						ATLAS #TITLE # x624y522 x624y524						GIR 2018-CLV-HIGHLAND SQUARE COVER SHEET															

DOC 3431281




5/31/18

617-01710-2001

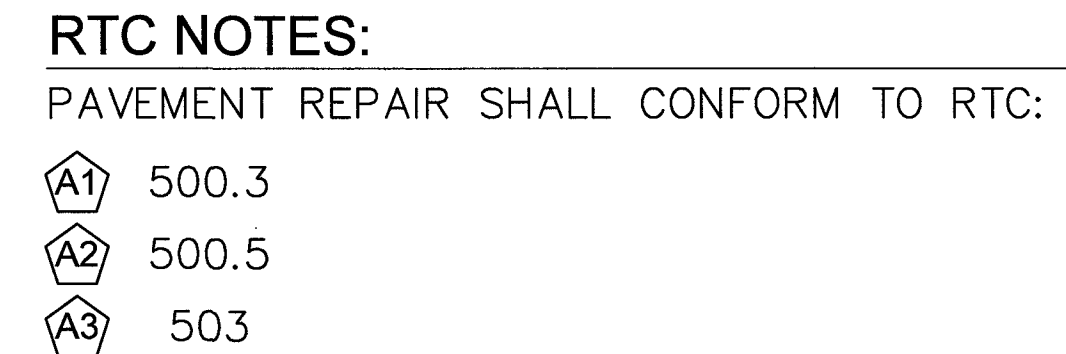

MATERIAL LIST FOR PROPOSED ABANDONMENT FACILITIES		
ITEM#	PROPERTY UNITS #	DESCRIPTION
1	3760202	ABANDON 2" STL MAIN '56
8	3800601	ABANDON 3/4" PVC SVC '56

DOC_3431281

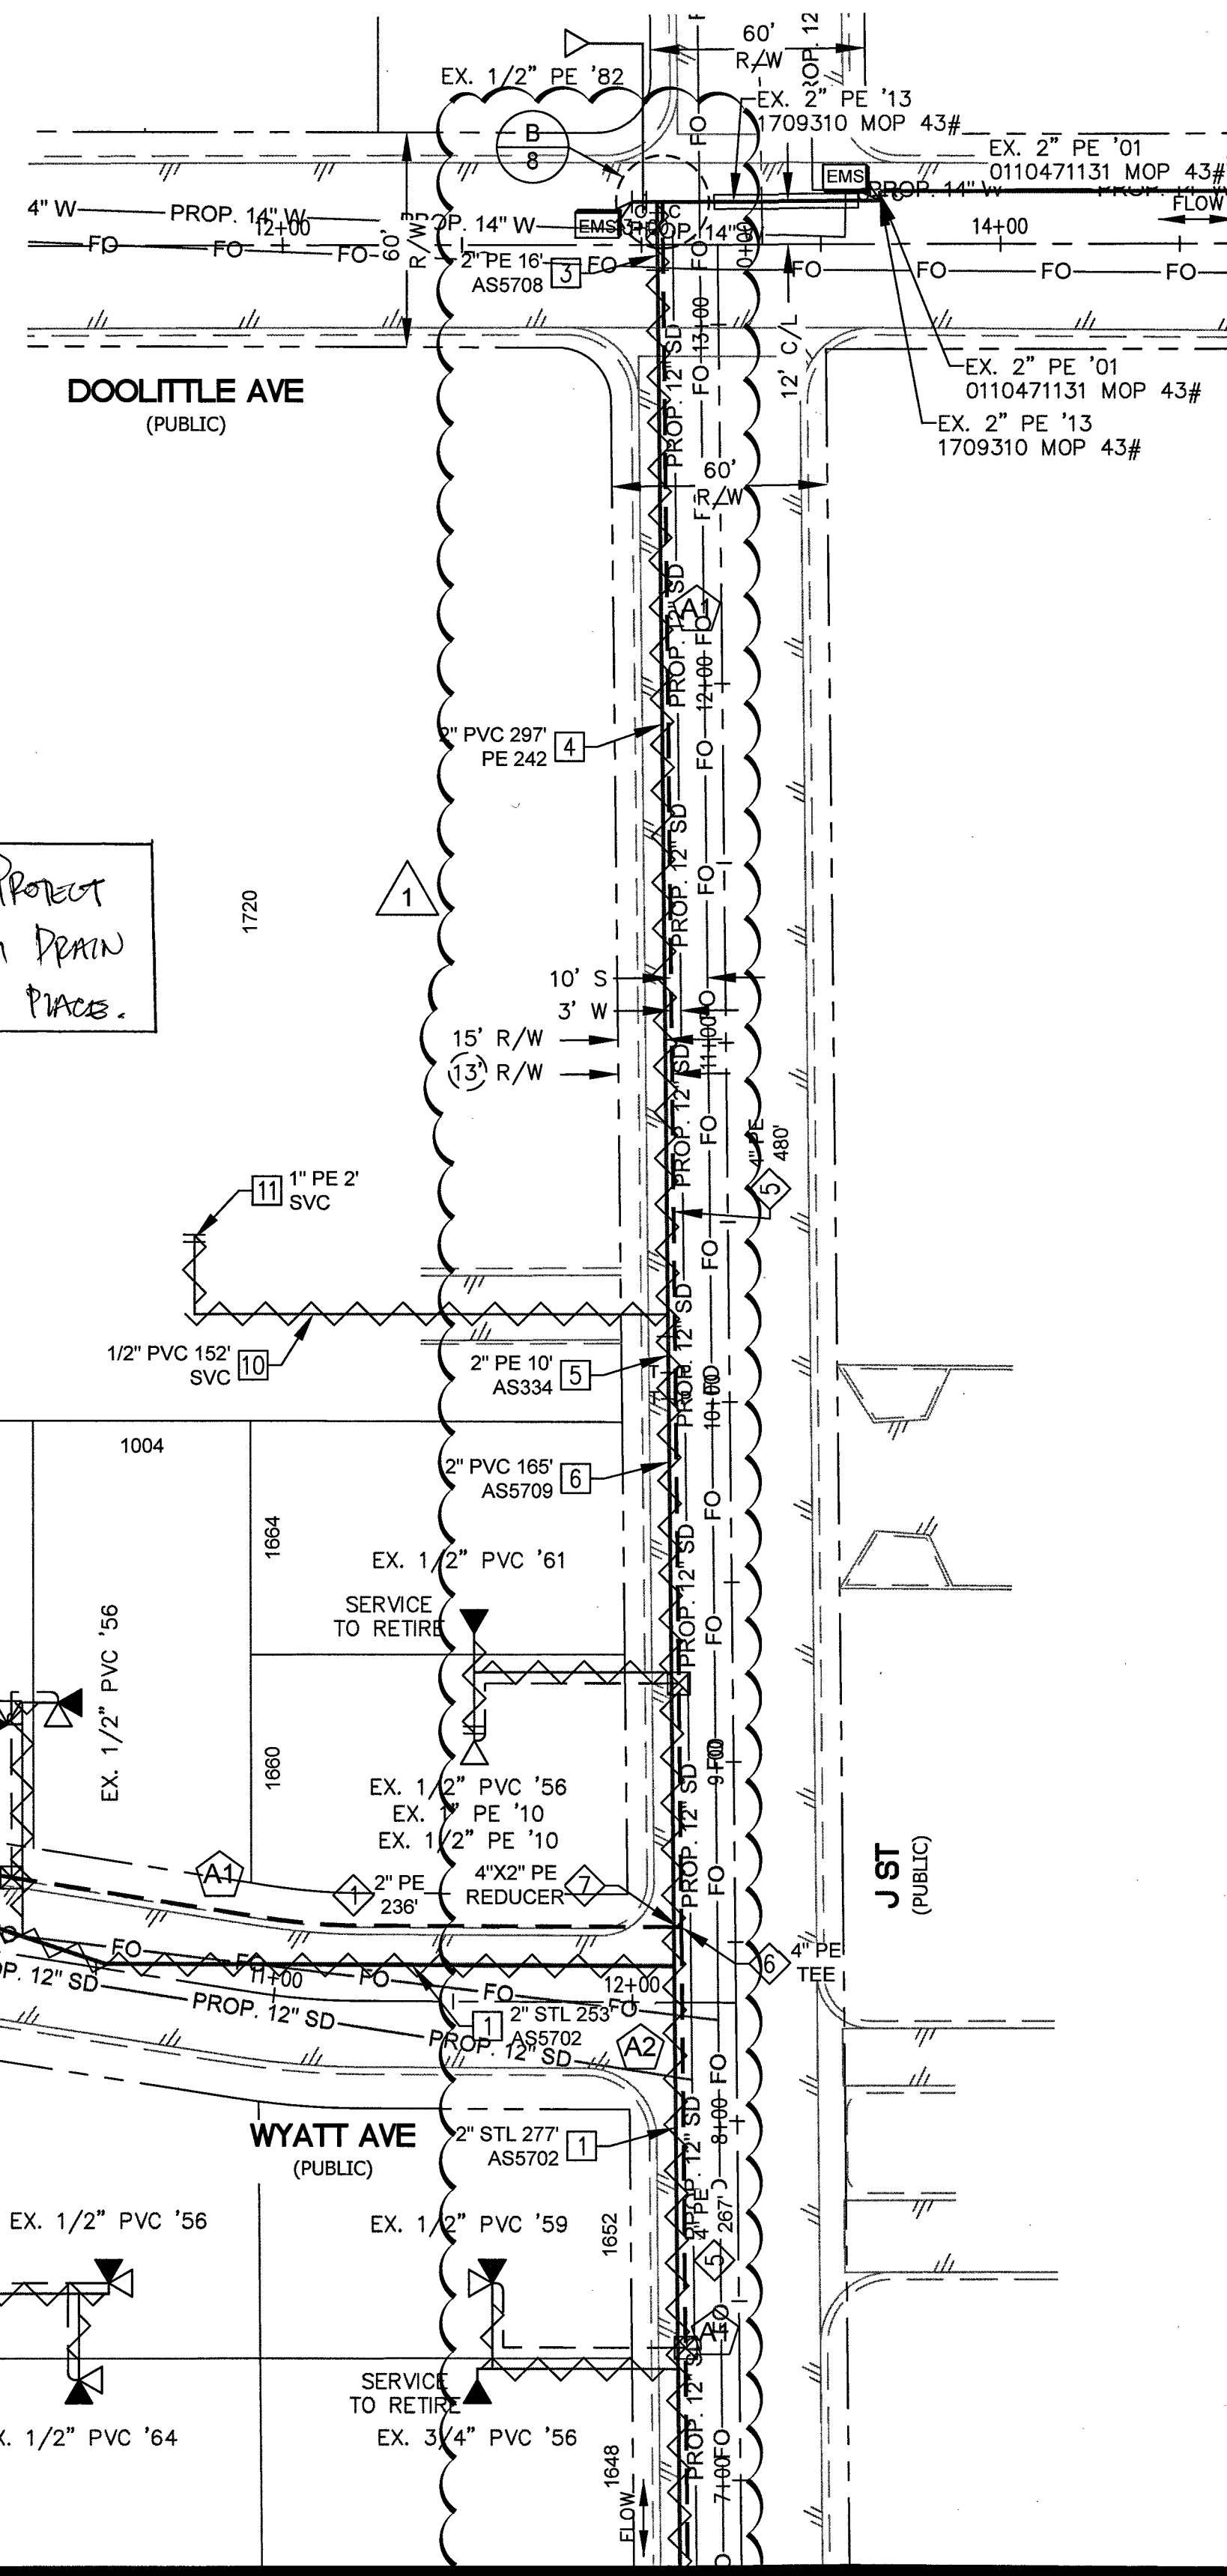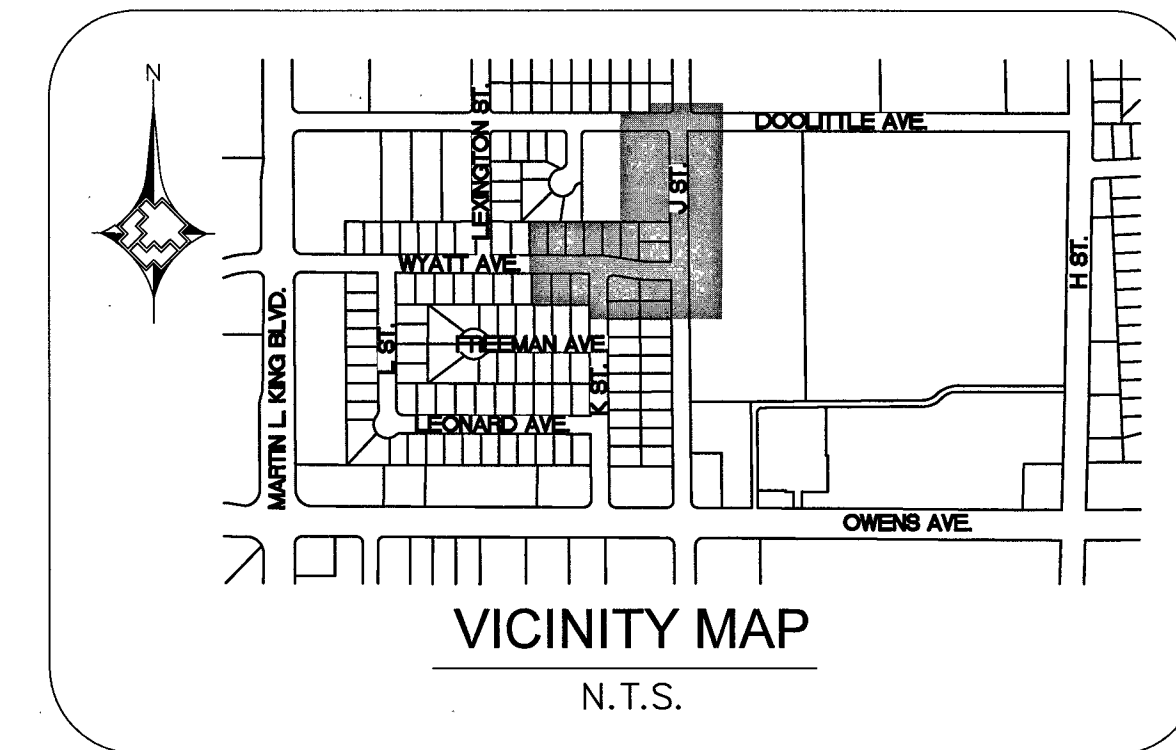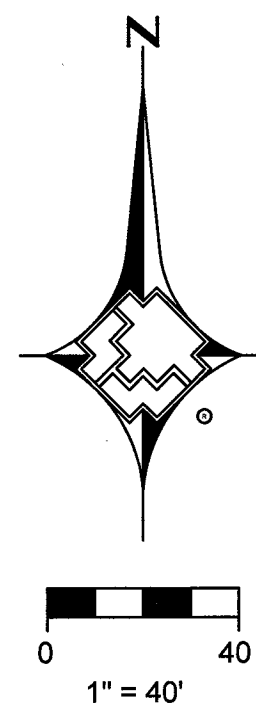

MATERIAL LIST FOR PROPOSED DISTRIBUTION FACILITIES

ITEM#	STOCK ID#	DESCRIPTION
1	100-5101	PROPOSED 2" PE MAIN
2	140-3074	PROPOSED 2" PE TEE
5	100-5201	PROPOSED 4" PE MAIN
6	140-3076	PROPOSED 4" PE TEE
7	140-5118	PROPOSED 4"x2" PE REDUCER

MATERIAL LIST FOR PROPOSED ABANDONMENT FACILITIES

ITEM#	PROPERTY UNITS #	DESCRIPTION
1	3760202	ABANDON 2" STL MAIN '56
3	3760102	ABANDON 2" PE MAIN '82
4	3760602	ABANDON 2" PVC MAIN '61
5	3760102	ABANDON 2" PE MAIN '83
6	3760202	ABANDON 2" STL MAIN '56
10	3800601	ABANDON 1/2" PVC SVC '68
11	3800101	ABANDON 1" PE SVC '09

RTC NOTES:

PAVEMENT REPAIR SHALL CONFORM TO RTC:

- A1 500.3
- A2 500.5
- A3 503



MATCHLINE - SEE SHEET 6 OF 10

MATCHLINE - SEE SHEET 4 OF 10

NEW ALIGNMENT FOR PROP. GAS MAIN ON J ST. RCM 05/23/2018

NO.	DESCRIPTION	BY	DATE	APPVD.
3.				
4.				

REVISIONS



TAX CODES	UNIT NO.	UNIT TYPE	INSTL. PROPOSED	RETIRED	INSTL. COMPLETED	RETIRED

SEE SHEET 3

AS-BUILT DRAWING-PRESSURE TEST DATA

PIPE DIA.	PIPE LENGTH	PIPE TYPE	MIN. DURATION	TEST PRES. (PSIG) (MAX)	TEST MEDIUM	TEST METHOD

INDIVIDUAL PERFORMING VISUAL INSPECTION VISUAL INSPECTION CERTIFICATION

NAME	DATE	AS-BUILTS ACCEPTED BY	DATE	POSTED BY	DATE	POSTING QC'D BY	DATE

CONSTRUCTION

INSPECTOR FOREMAN REVIEWED BY

PERMIT INFORMATION

CITY OF LAS VEGAS TAX CODE 02-0200

ISOLATION AREA

ISO_21_DIST_092

W.R. NO.

3431281

LOCATION

SEC 21 T20S R61E

M.D.M.


ATLAS #/TITLE #

x624y522 x624y524

ENGINEER/TECH: RAMILO MENDOZA	PHONE: 702-365-2189
ACCOUNT REP:	PHONE:
PROJECT CONTACT:	PHONE:
SHEET NO. 5 OF 9	SCALE: 1"=40'
DWN. BY: SEI	CHKD. BY:
DATE: 12/05/2017	APPVD. BY:



GIR 2018-CLV-HIGHLAND SQUARE DESIGN PLAN

DOC_3431281

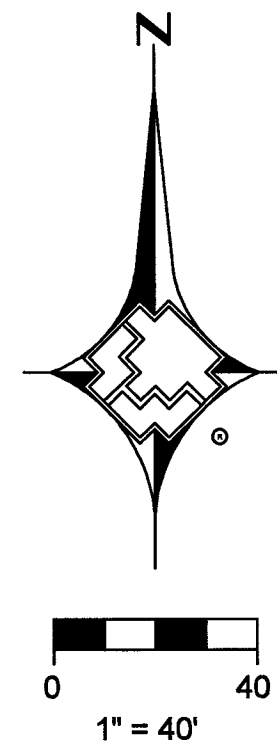

MATCHLINE - SEE SHEET 4 OF 10

MATCHLINE - SEE SHEET 5 OF 10

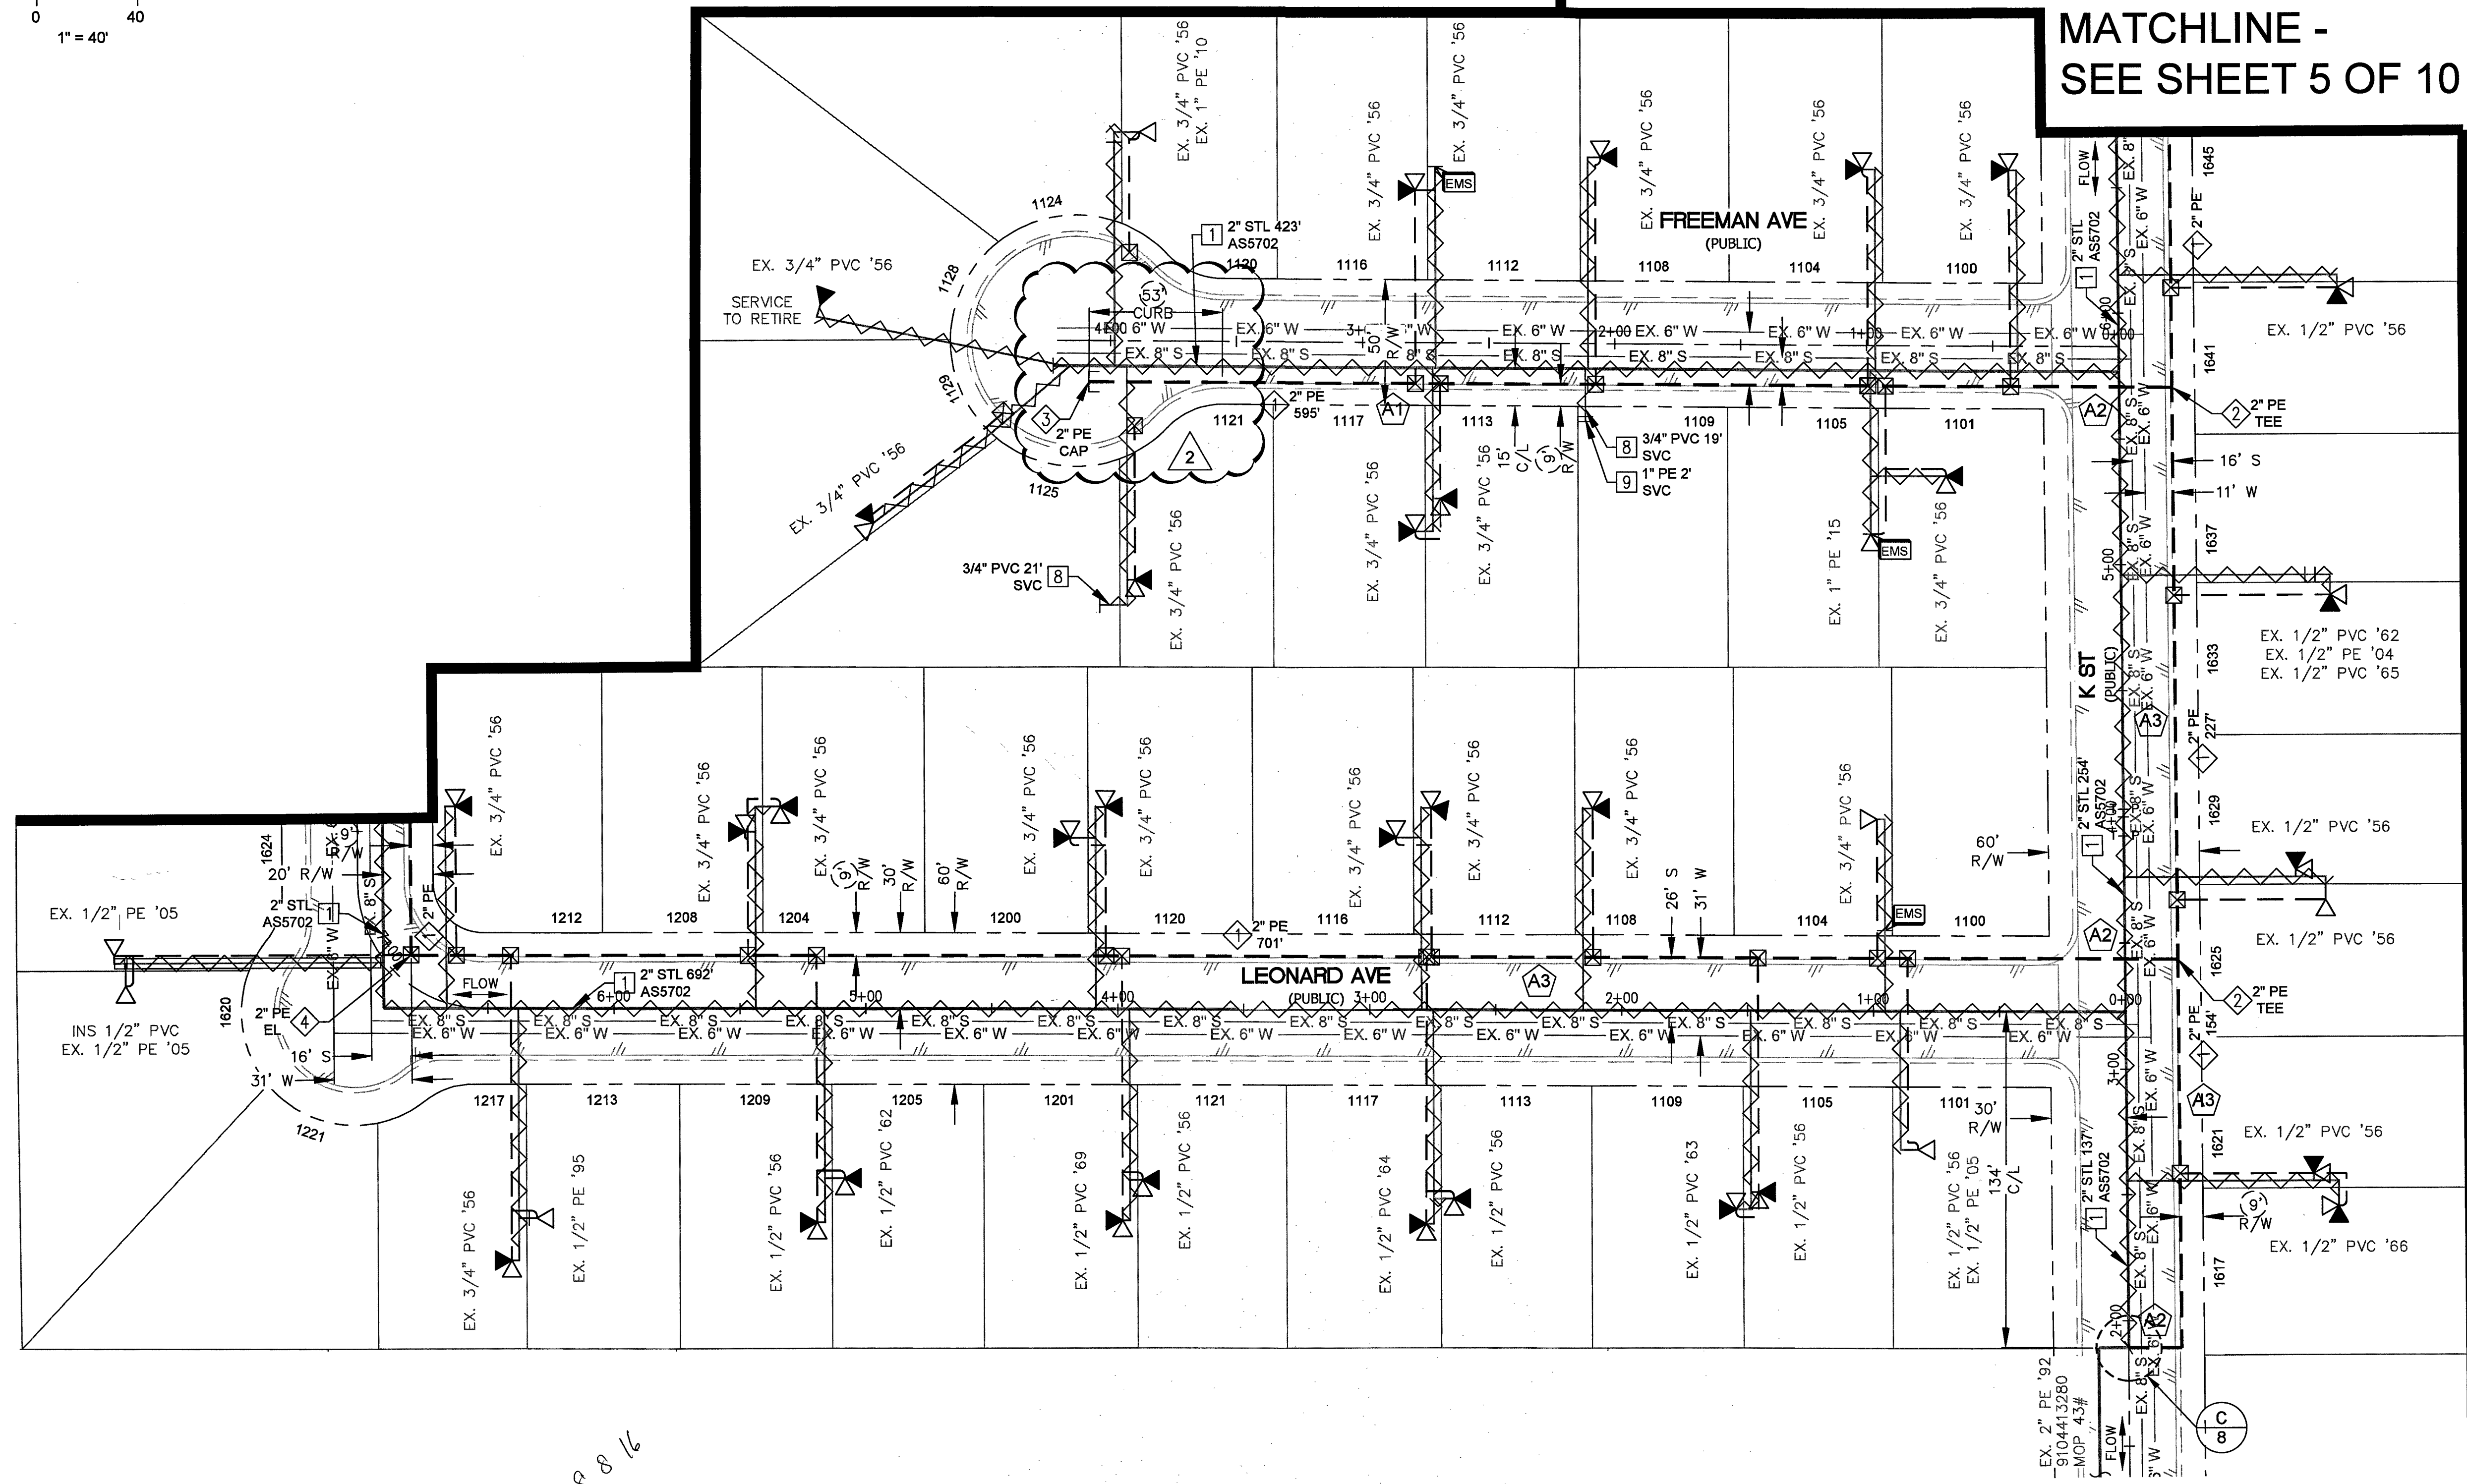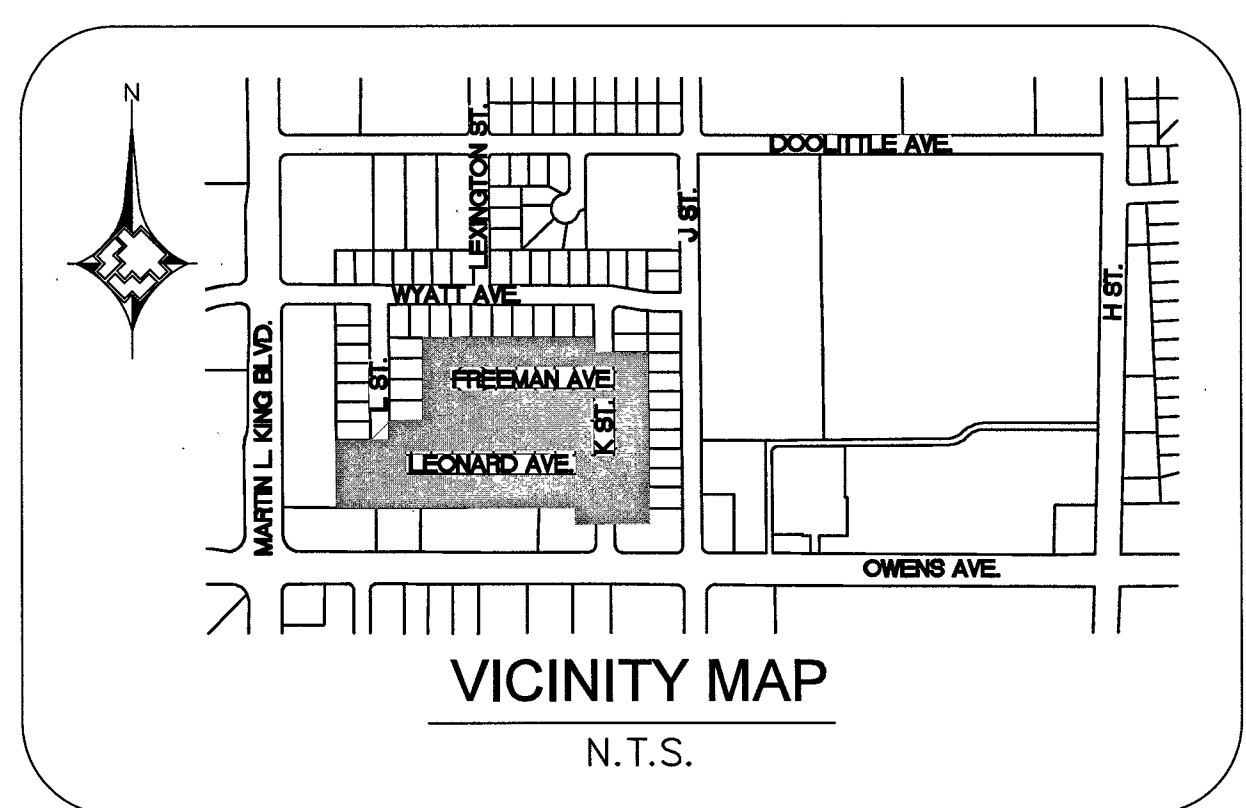

MATERIAL LIST FOR PROPOSED DISTRIBUTION FACILITIES		
ITEM#	STOCK ID#	DESCRIPTION
1	100-5101	PROPOSED 2" PE MAIN
2	140-3074	PROPOSED 2" PE TEE
3	140-3060	PROPOSED 2" PE CAP
4	140-3067	PROPOSED 2" PE 90° ELBOW

MATERIAL LIST FOR PROPOSED ABANDONMENT FACILITIES		
ITEM#	PROPERTY UNITS #	DESCRIPTION
1	3760202	ABANDON 2" STL MAIN '56
8	3800601	ABANDON 3/4" PVC SVC '56
9	3800101	ABANDON 1" PE SVC '10

RTC NOTES:
PAVEMENT REPAIR SHALL CONFORM TO RTC:
A1 500.3
A2 500.5
A3 503

CLV Note:
Protect Existing Storm Drain Facilities In Place.

MATCHLINE - SEE SHEET 7 OF 7

NEW ALIGNMENT FOR PROP. GAS MAIN ON J ST. RCM 05/23/2018

FREEMAN AVE CUL-DE-SAC ALIGNMENT CHANGE RCM 09/25/2018

4.

NO.

DESCRIPTION

BY

DATE

APPVD.

REVISIONS

SOUTHWEST GAS CORPORATION

TAX CODES	UNIT NO.	UNIT TYPE	INSTL. PROPOSED	RETIRED	INSTL. COMPLETED	RETIRED
PROPERTY UNITS						

AS-BUILT DRAWING-PRESSURE TEST DATA

PIPE DIA.	TEST MEDIUM	TEST METHOD
PIPE LENGTH	☐ AIR	☐ GAUGE
PIPE TYPE	☐ NITROGEN	☐ CHART
MIN. DURATION	☐ WATER	☐ GAUGE/ PRESS REC SN#
TEST PRES. (PSIG): (MAX)	(MIN)	
TIME (START)	(STOP)	
DATE: (START)	(STOP)	
PERFORMED BY:		
SWG VERIFIED BY:		

INDIVIDUAL PERFORMING VISUAL INSPECTION VISUAL INSPECTION CERTIFICATION

I HAVE VISUALLY INSPECTED ALL HEATED FUSIONS, SOLVENT CEMENT, MECHANICAL JOINTS, AND WELDS THAT HAVE PERFORMED

NAME _____ DATE _____

AS-BUILTS ACCEPTED BY _____ DATE _____

POSTED BY _____ DATE _____

POSTING QC'D BY _____ DATE _____

CONSTRUCTION

INSPECTOR _____

FOREMAN _____

REVIEWED BY _____

PERMIT INFORMATION

CITY OF LAS VEGAS

TAX CODE 02-0200


ISOLATION AREA	W.R. NO.
ISO_21_DIST_092	3431281
LOCATION	ATLAS #/TILE #
SEC 21	x624y522
T20S R61E	x624y524
M.D.M.	

ENGINEER/TECH: RAMILO MENDOZA	PHONE: 702-365-2189	
ACCOUNT REP:	PHONE:	
PROJECT CONTACT:	PHONE:	
SHEET NO: 6 OF 9	SCALE: 1"=40'	DATE: 12/05/2017
DWN. BY: SEI	CHKD. BY:	APPVD. BY:
TITLE		
GIR 2018-CLV-HIGHLAND SQUARE		
DESIGN PLAN		




L1A-01710-R002
107V7100-GAS
Report

7/17/18
L1A-01710-R002
DOC 3431281


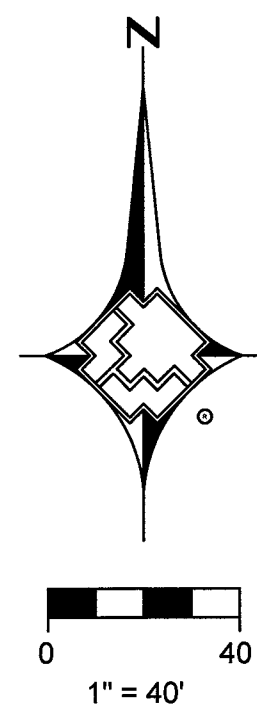


MATCHLINE - SEE SHEET 5 OF 10

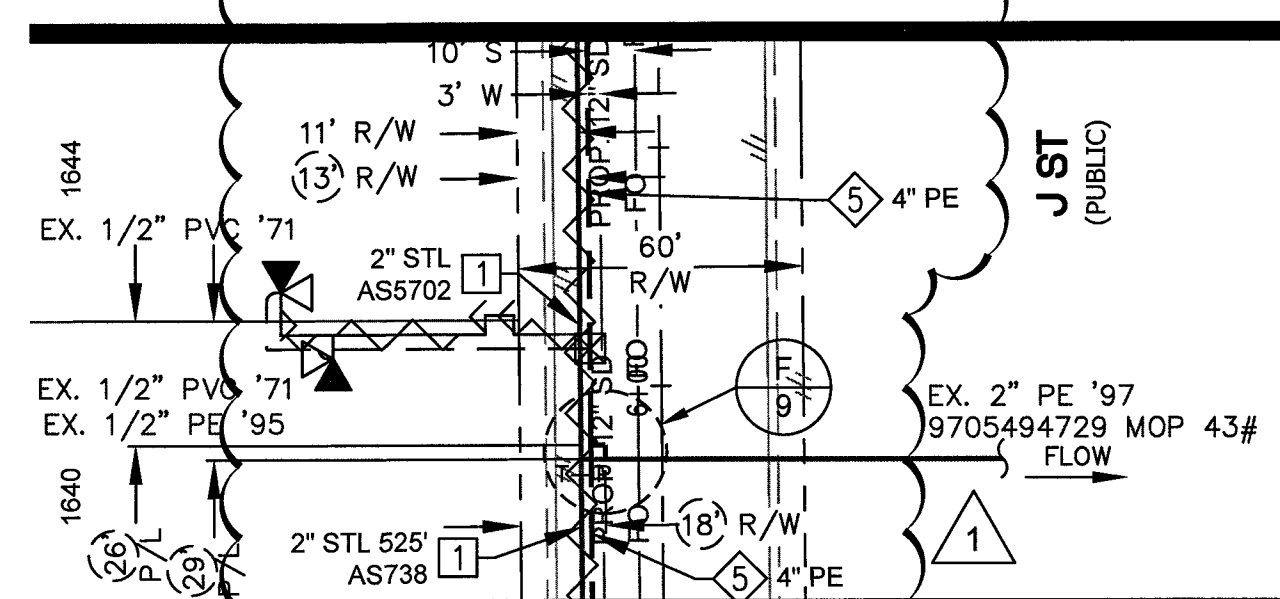

MATCHLINE "A" ON THIS SHEET

MATCHLINE "A" ON THIS SHEET

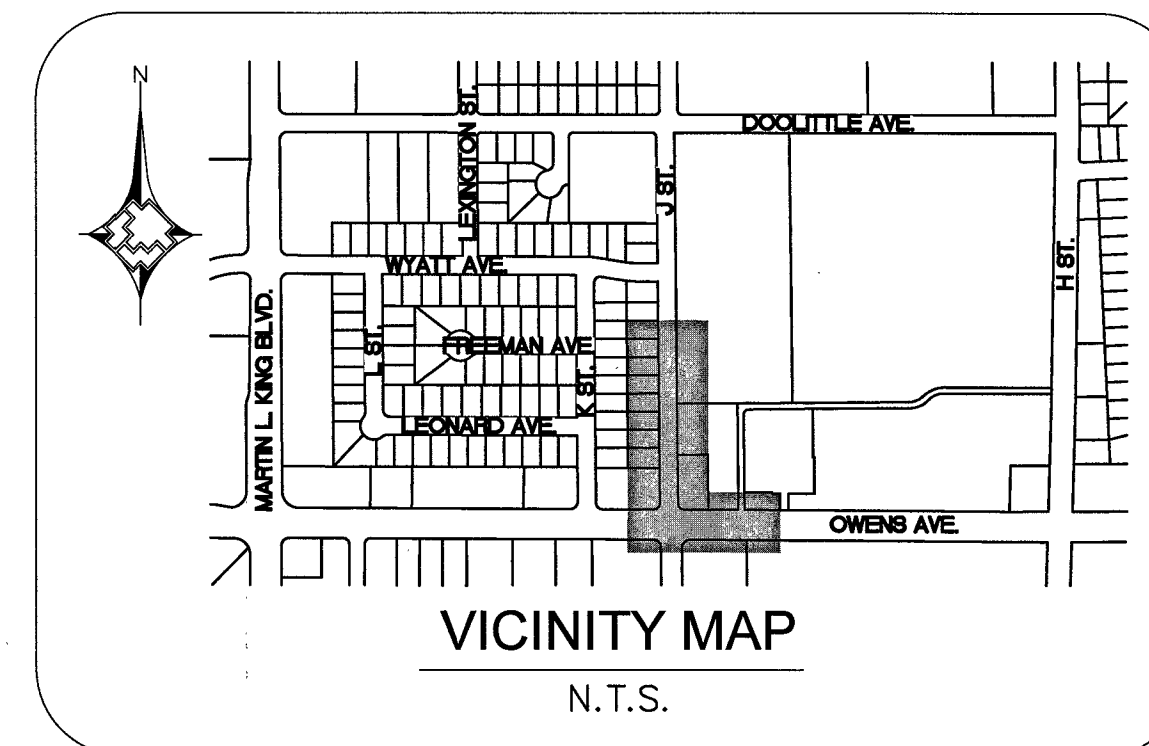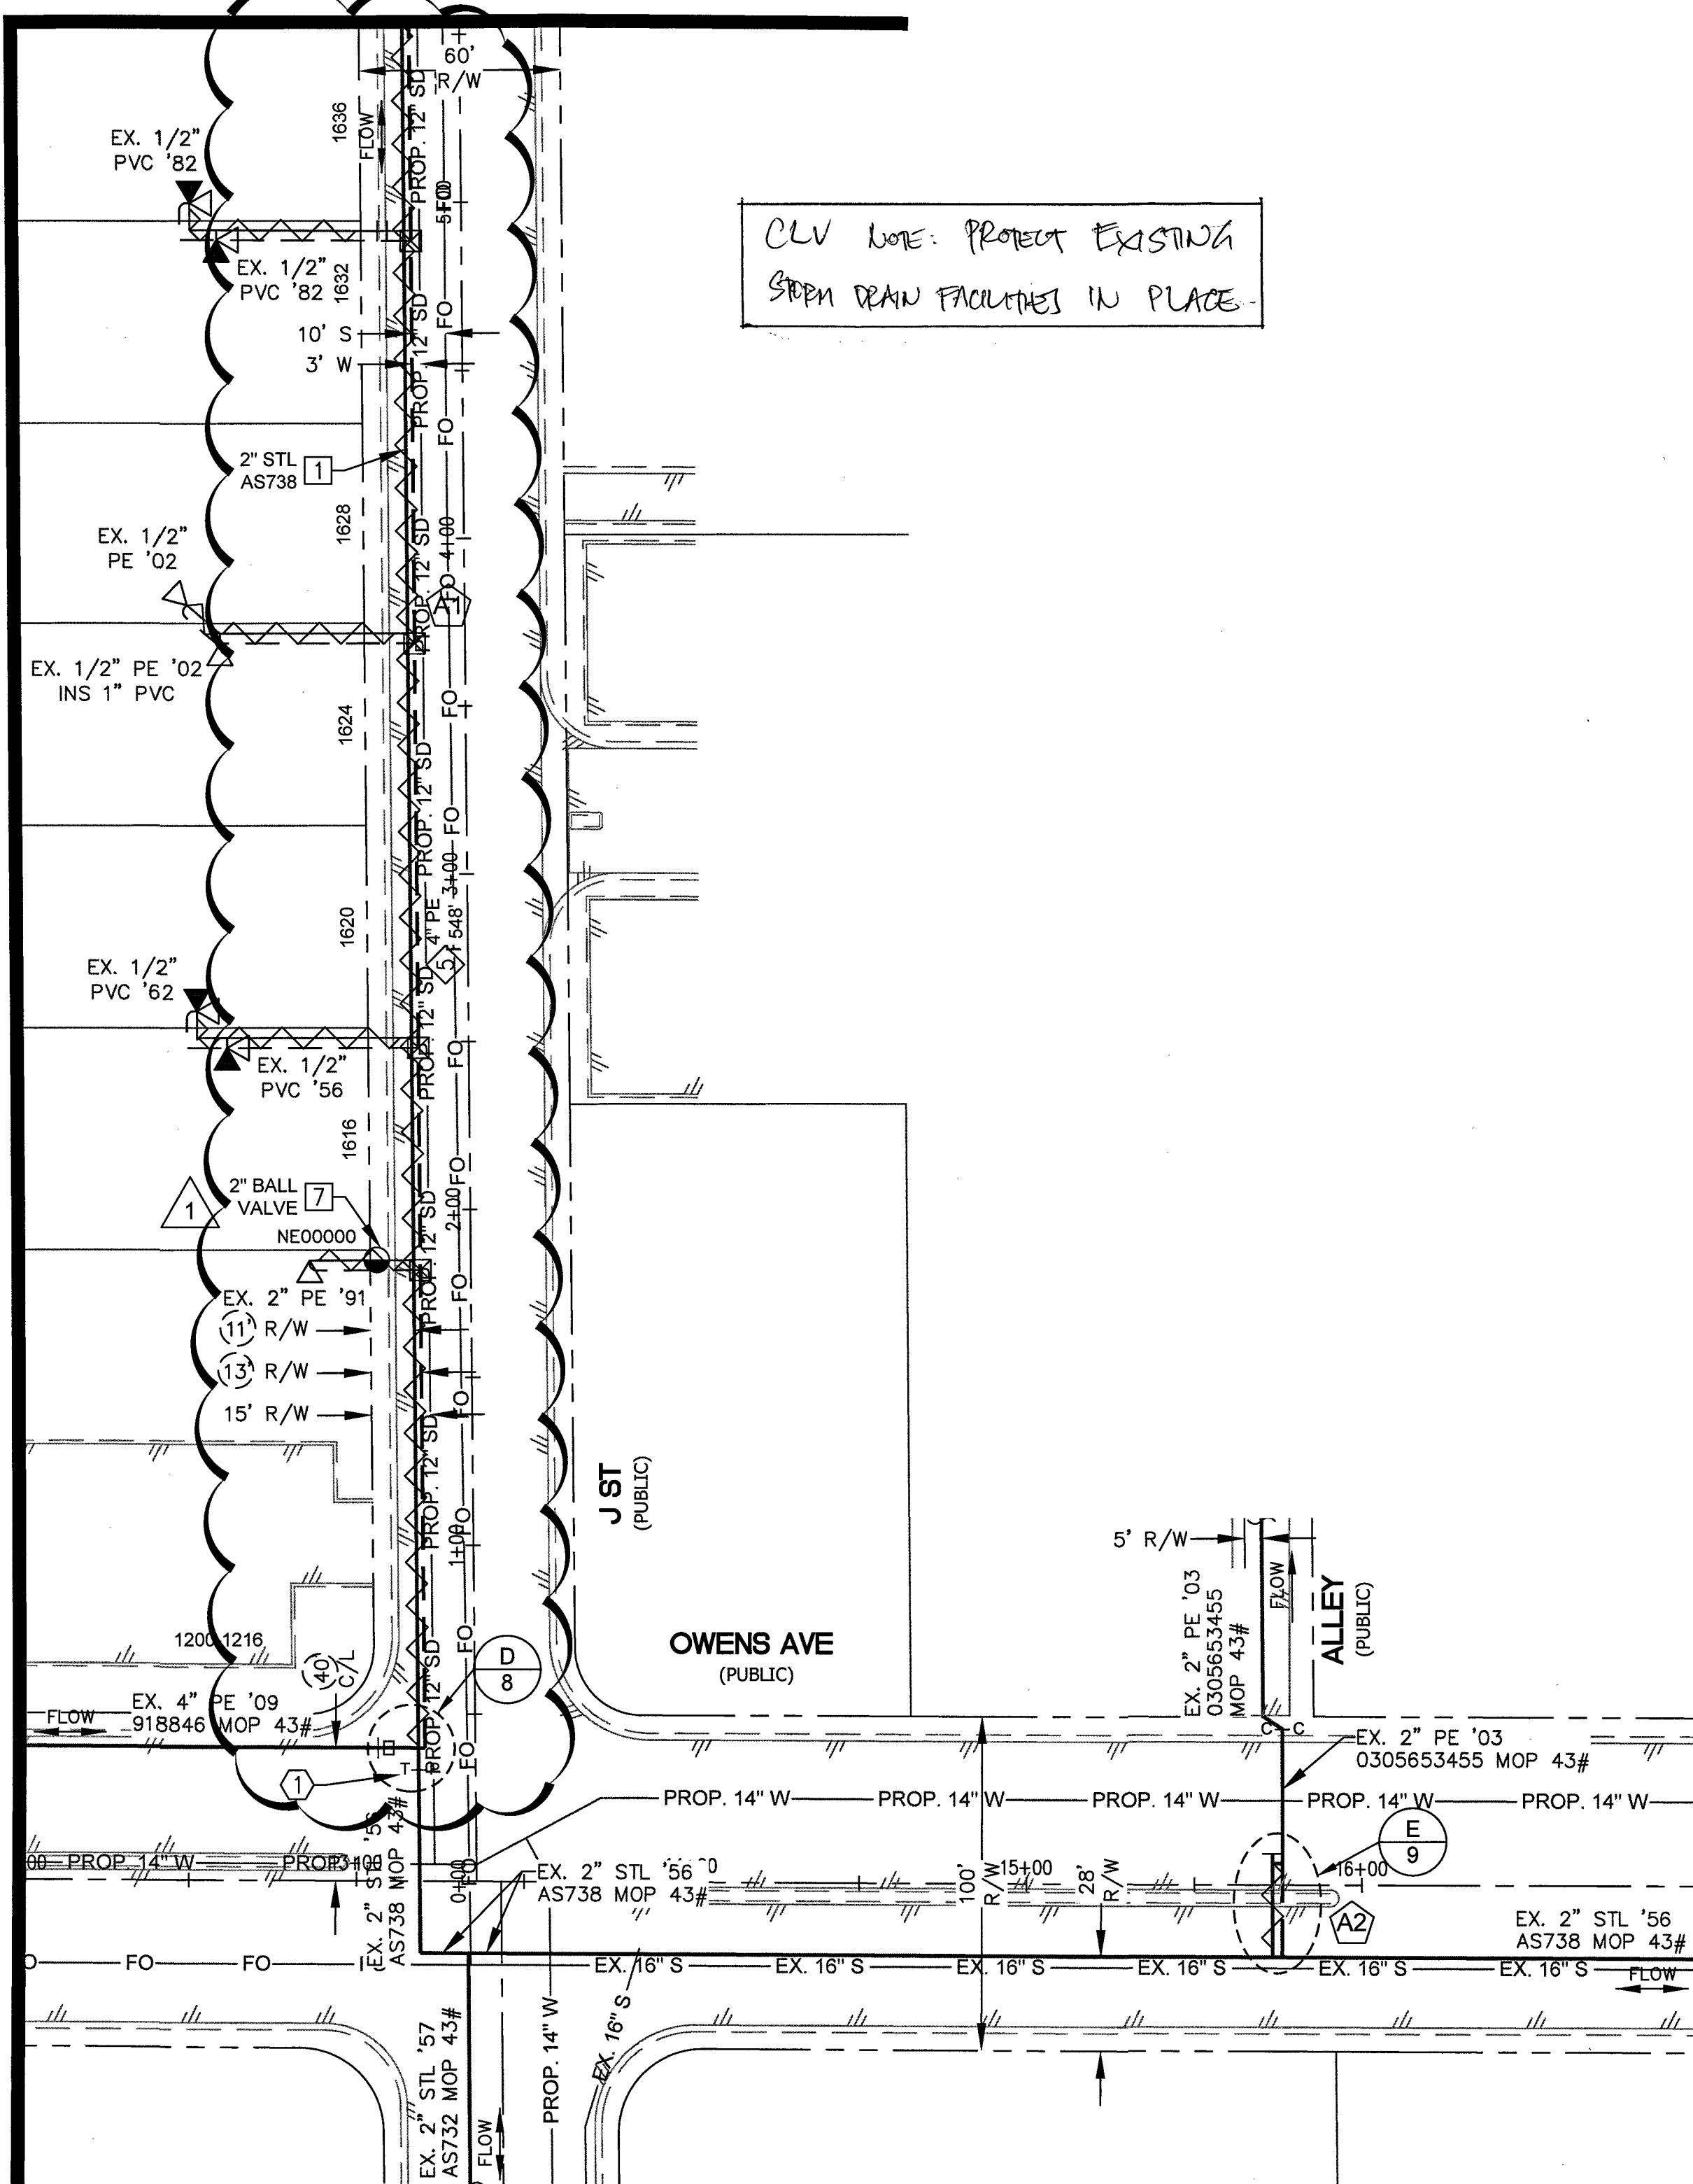

MATERIAL LIST FOR PROPOSED DISTRIBUTION FACILITIES

ITEM#	STOCK ID#	DESCRIPTION
1	100-5201	PROPOSED 2" PE MAIN
4	100-5201	PROPOSED 2" PE 90° ELBOW
5	100-5201	PROPOSED 4" PE MAIN
8	160-8174	PROPOSED 4"x2" PE TAPPING TEE
11	100-5201	PROPOSED 2" PE TAP TEE

MATERIAL LIST FOR PROPOSED ABANDONMENT FACILITIES

ITEM#	PROPERTY UNITS #	DESCRIPTION
1	3760202	ABANDON 2" STL MAIN '56
7		ABANDON 2" BALL VALVE '91

MATERIAL LIST FOR STEEL FACILITIES

ITEM#	STOCK ID#	DESCRIPTION
1	251-2406	CATHODIC TERMINAL TEST STATION 4"x18" LONG HNDY

RTC NOTES:

PAVEMENT REPAIR SHALL CONFORM TO RTC:


- A1 500.3
- A2 500.5
- A3 503



NEW ALIGNMENT FOR PROP. GAS MAIN ON J ST. RCM 05/23/2018

NO.	DESCRIPTION	BY	DATE	APPVD.
1				

REVISIONS

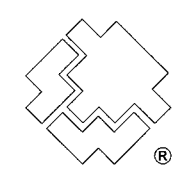

SOUTHWEST GAS CORPORATION

TAX CODES	UNIT NO.	UNIT TYPE	INSTL. PROPOSED	RETIRED	INSTL. COMPLETED	RETIRED

SEE SHEET 3

AS-BUILT DRAWING-PRESSURE TEST DATA

PIPE DIA.	TEST MEDIUM	TEST METHOD
PIPE LENGTH	☐ AIR	☐ GAUGE
PIPE TYPE	☐ NITROGEN	☐ CHART
MIN DURATION	☐ WATER	☐ GAUGE/ PRESS REC SN#
TEST PRES. (PSIG): (MAX)		(MIN)
TIME (HOUR): (START)		(STOP)
PERFORMED BY:		
DATE:		
DATE:		
DATE:		

INDIVIDUAL PERFORMING VISUAL INSPECTION
VISUAL INSPECTION CERTIFICATION
I HAVE VISUALLY INSPECTED ALL HEATED FUSION, SOLVENT CEMENT, MECHANICAL JOINTS, AND WELDS THAT HAVE PERFORMED

NAME	DATE
AS-BUILTS ACCEPTED BY	DATE
POSTED BY	DATE
POSTING QC'D BY	DATE

CONSTRUCTION

INSPECTOR
FOREMAN
REVIEWED BY

PERMIT INFORMATION
CITY OF LAS VEGAS
TAX CODE 02-0200

ISOLATION AREA
ISO_21_DIST_092









W.R. NO.
3431281

LOCATION
SEC 21
T20S R61E
M.D.M.

ATLAS #/TITLE #
x624y522
x624y524

ENGINEER/TECH: RAMILO MENDOZA
ACCOUNT REP:
PROJECT CONTACT:
SHEET NO: 7 OF 9
DWN. BY: SEI
SCALE: 1"=40'
CHKD. BY:
DATE: 12/05/2017
APPVD. BY:

GIR 2018-CLV-HIGHLAND SQUARE
DESIGN PLAN

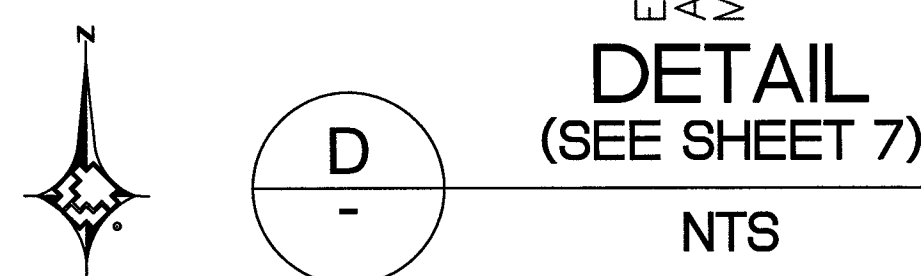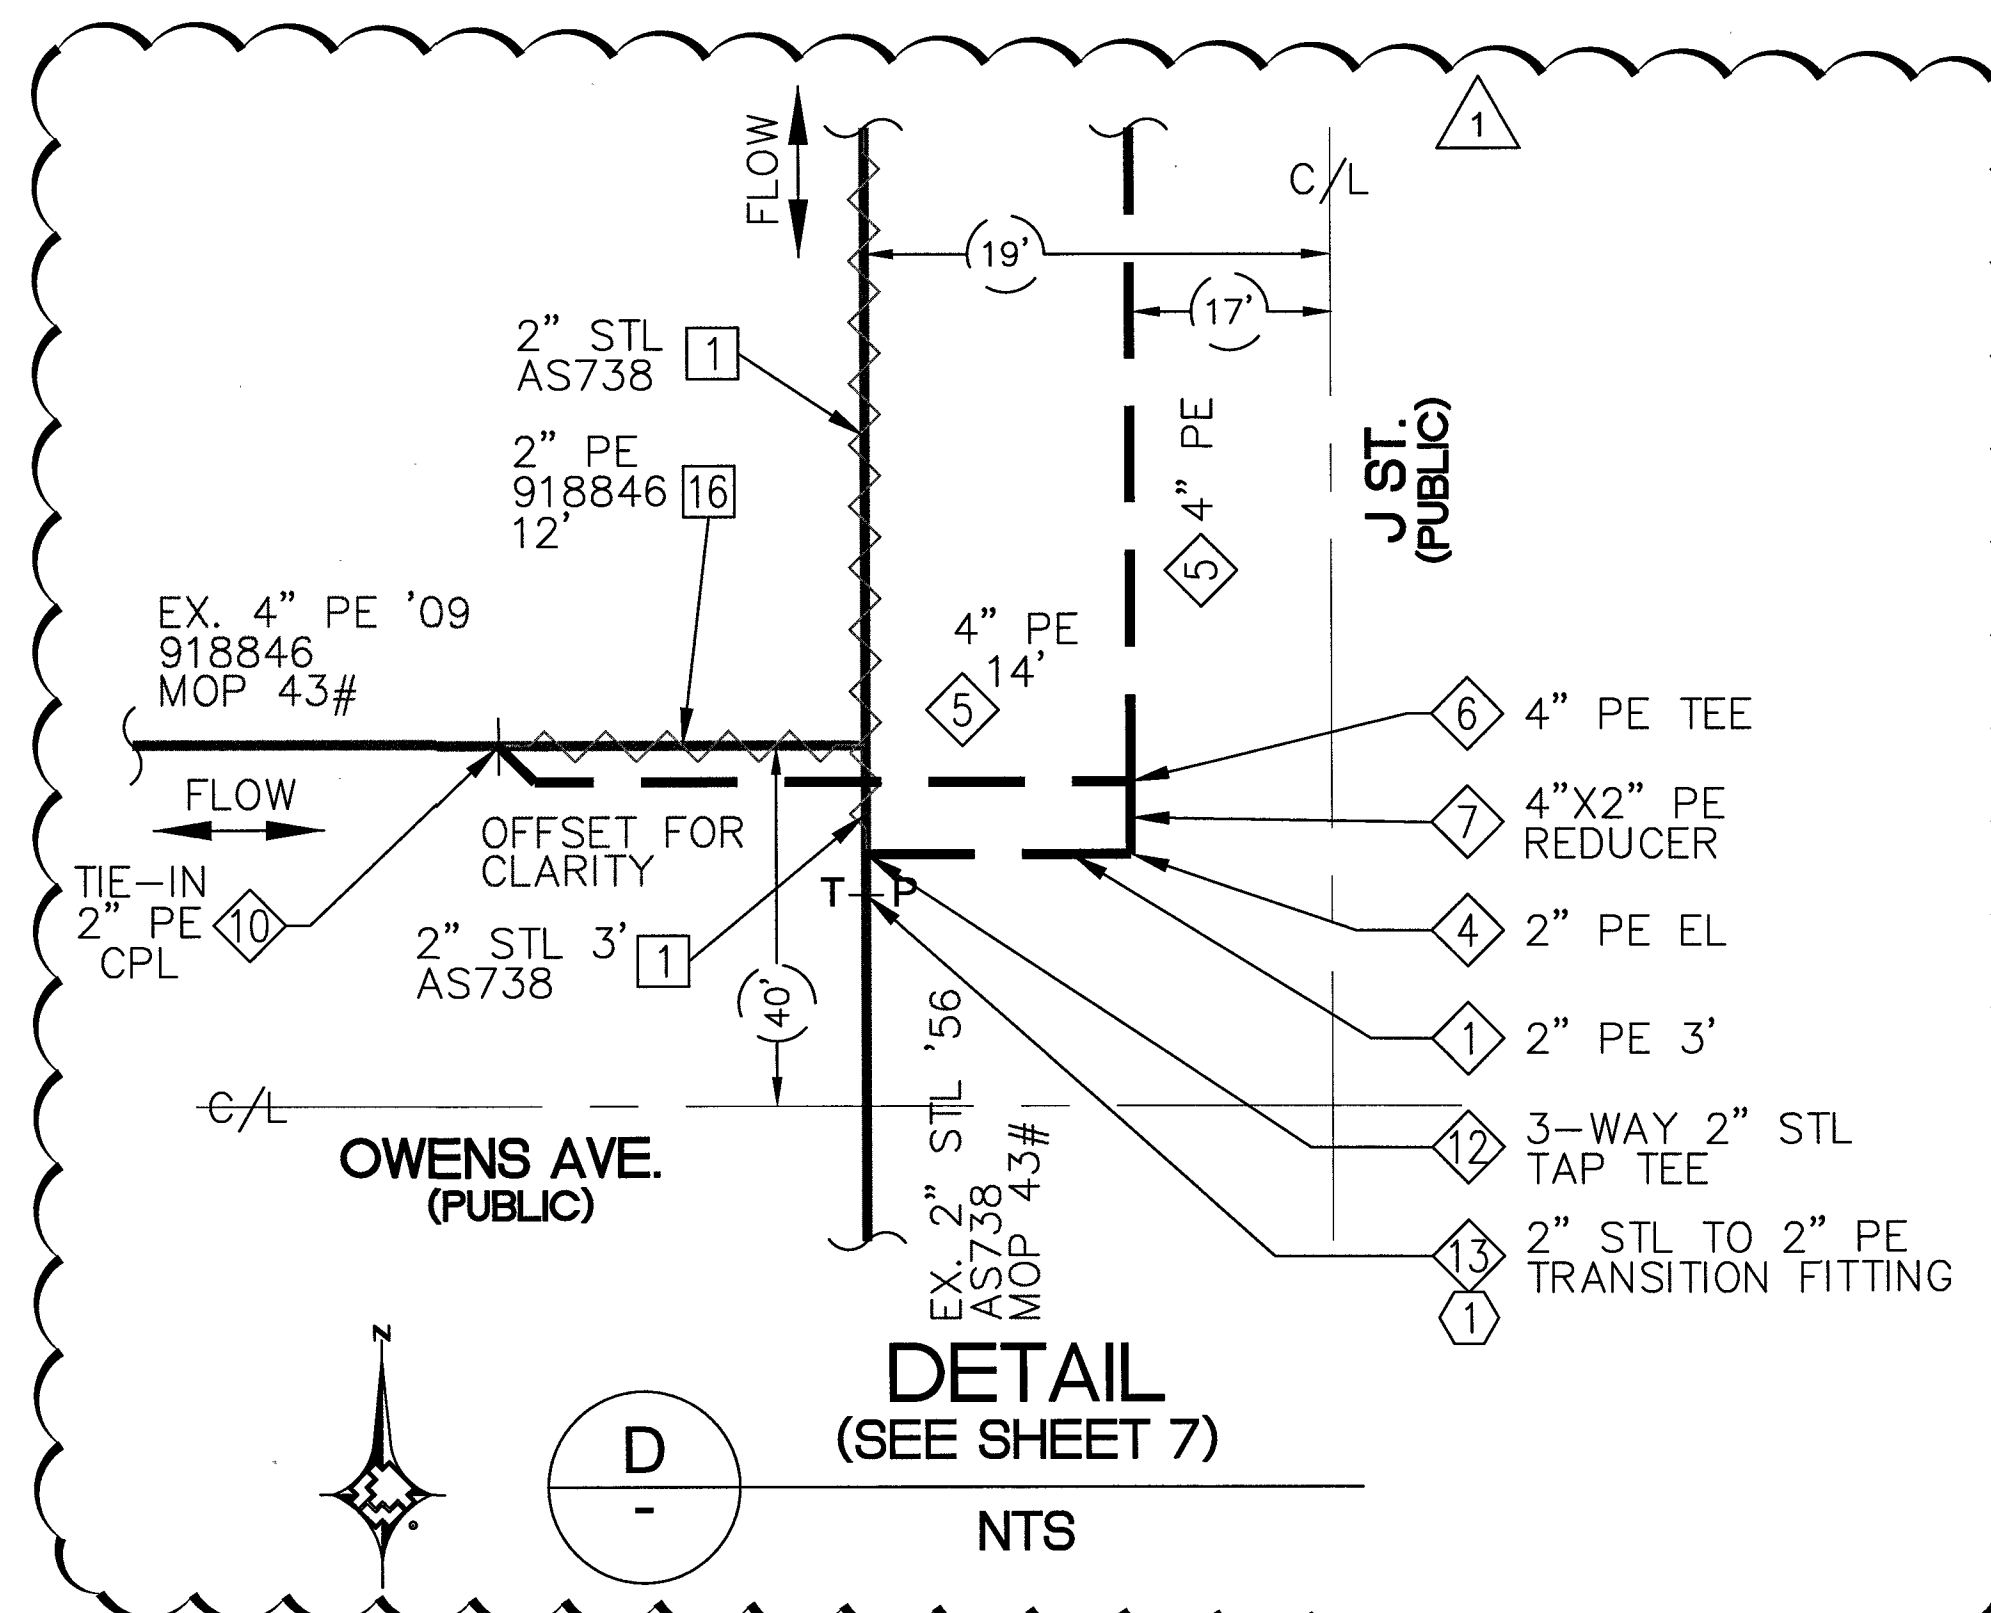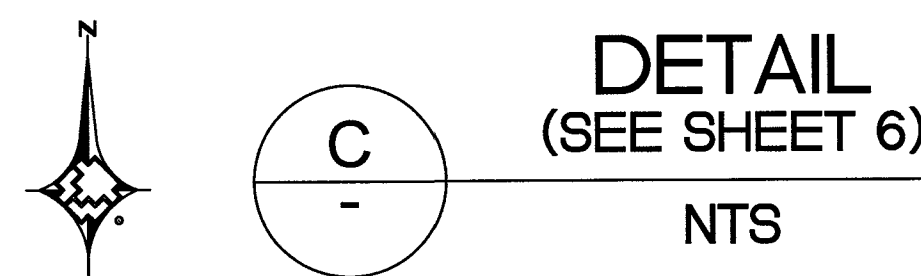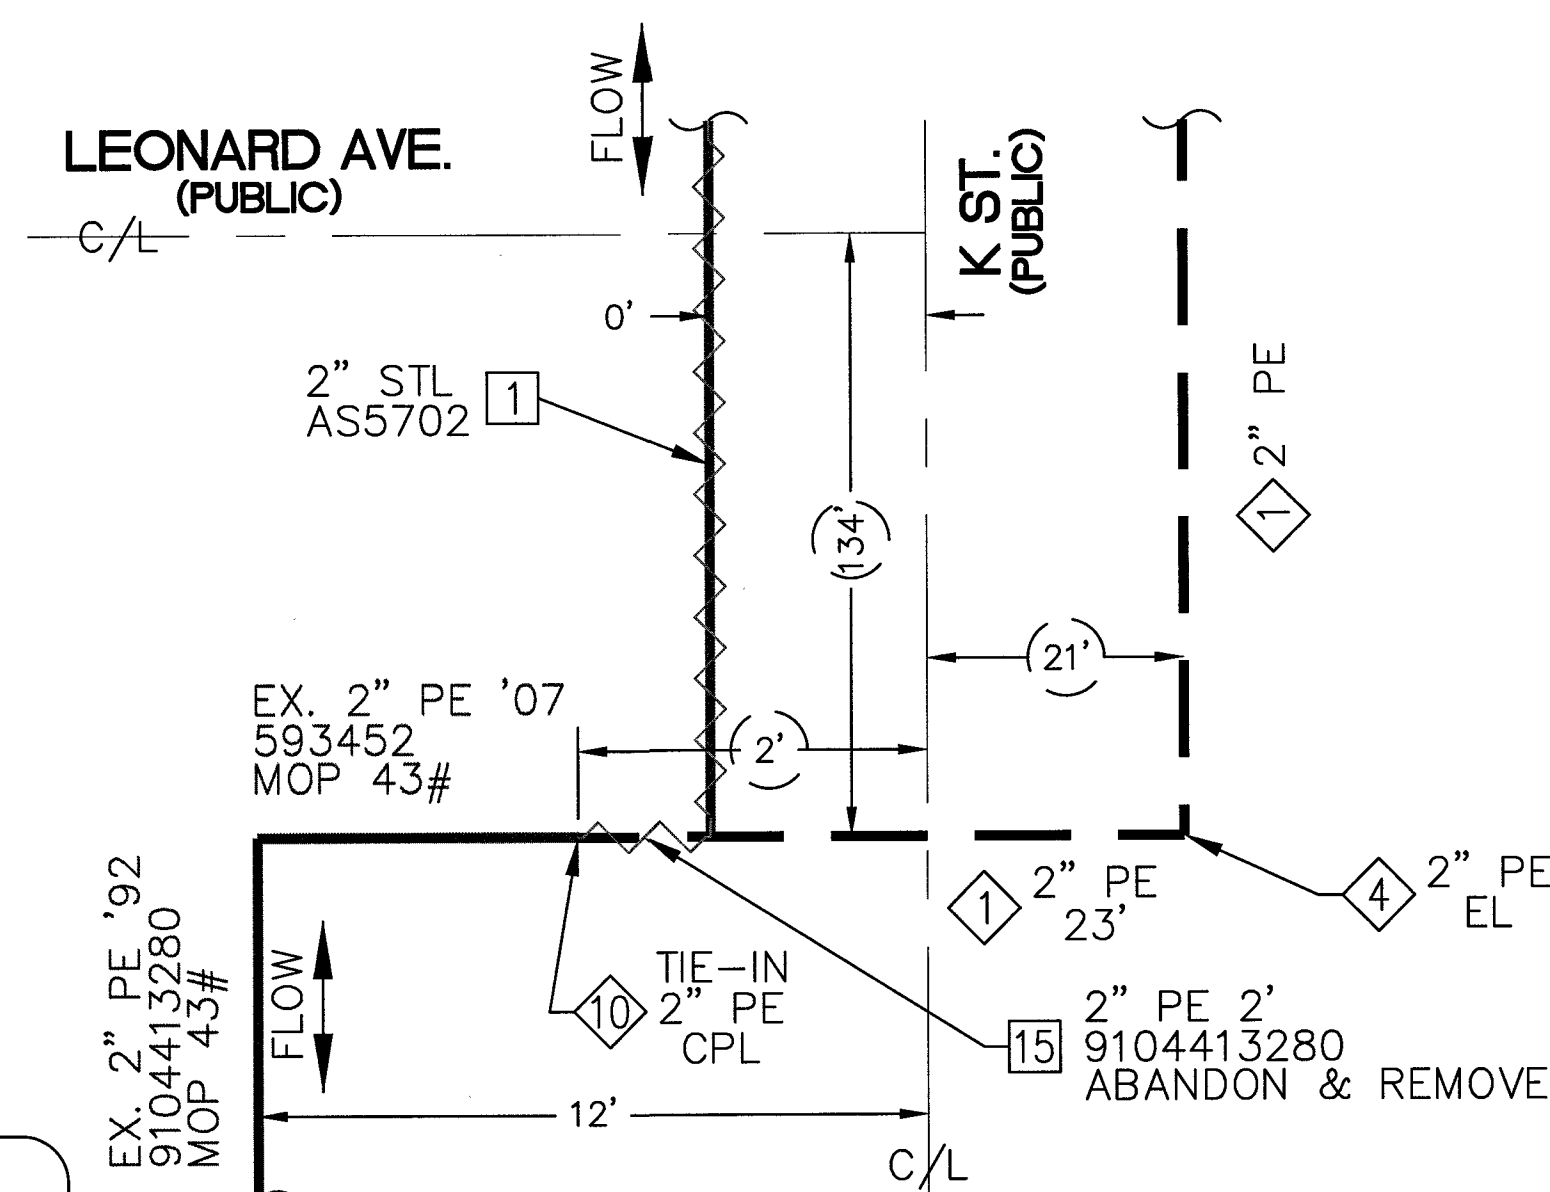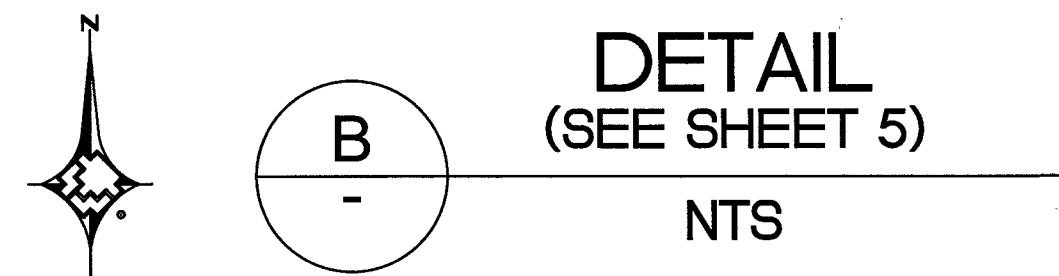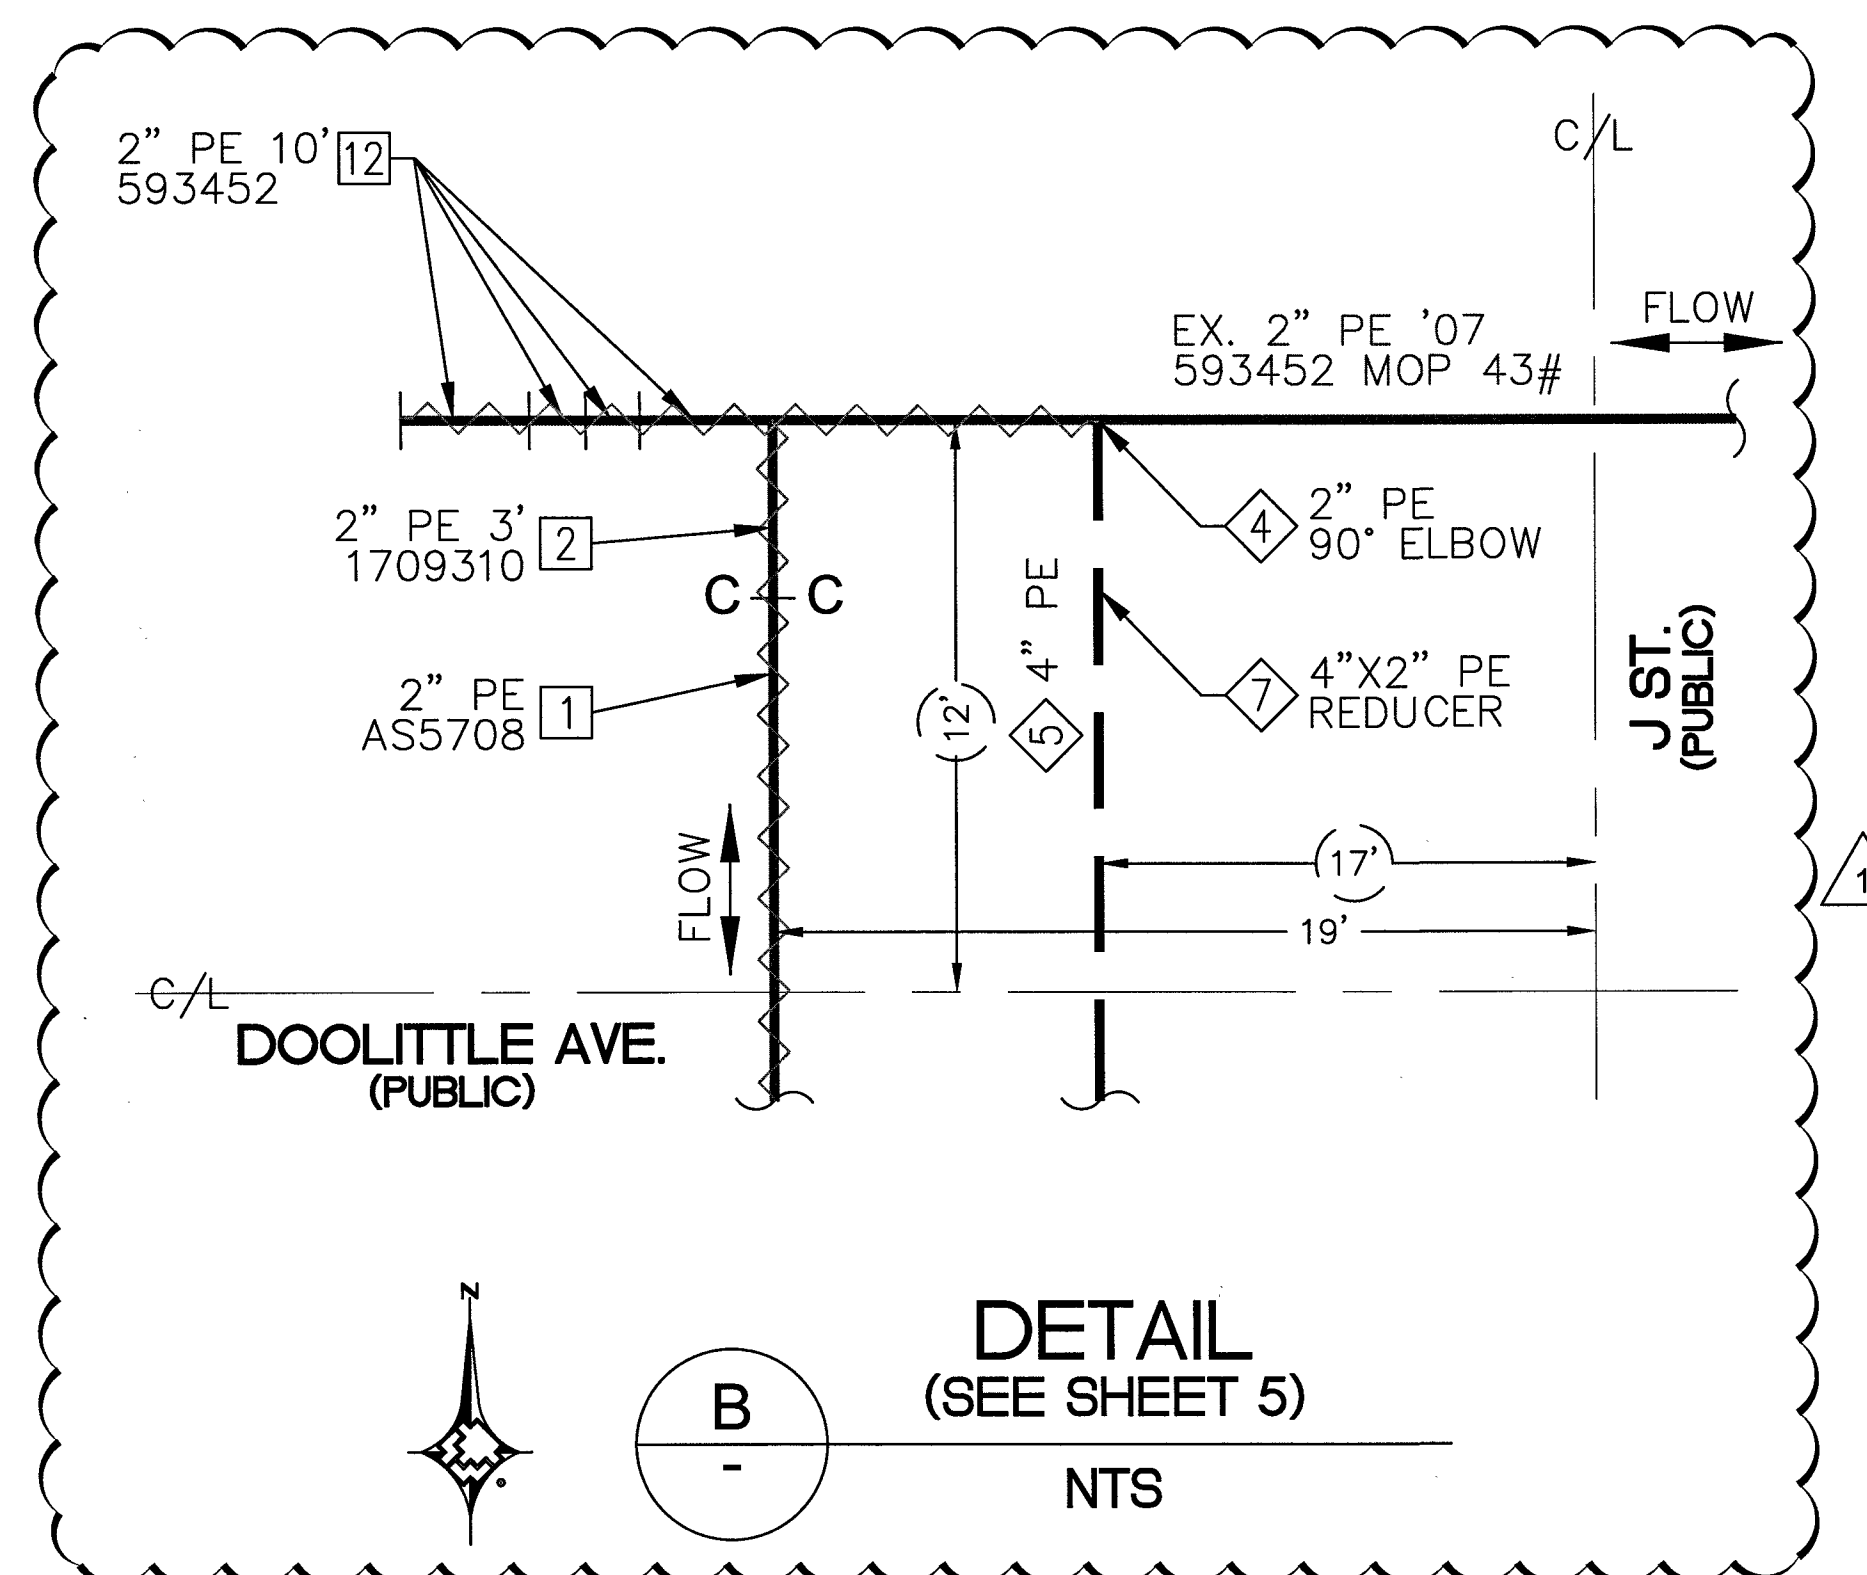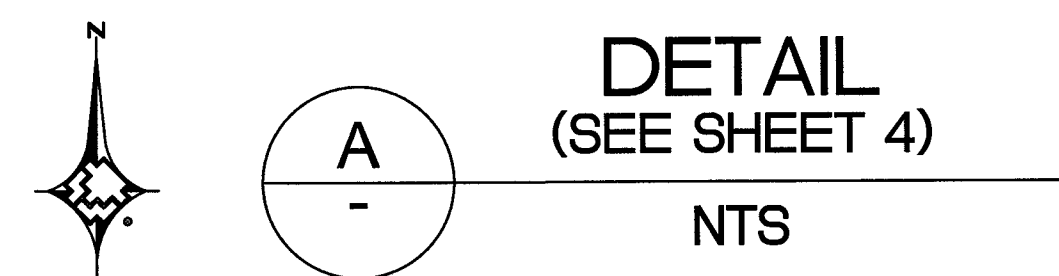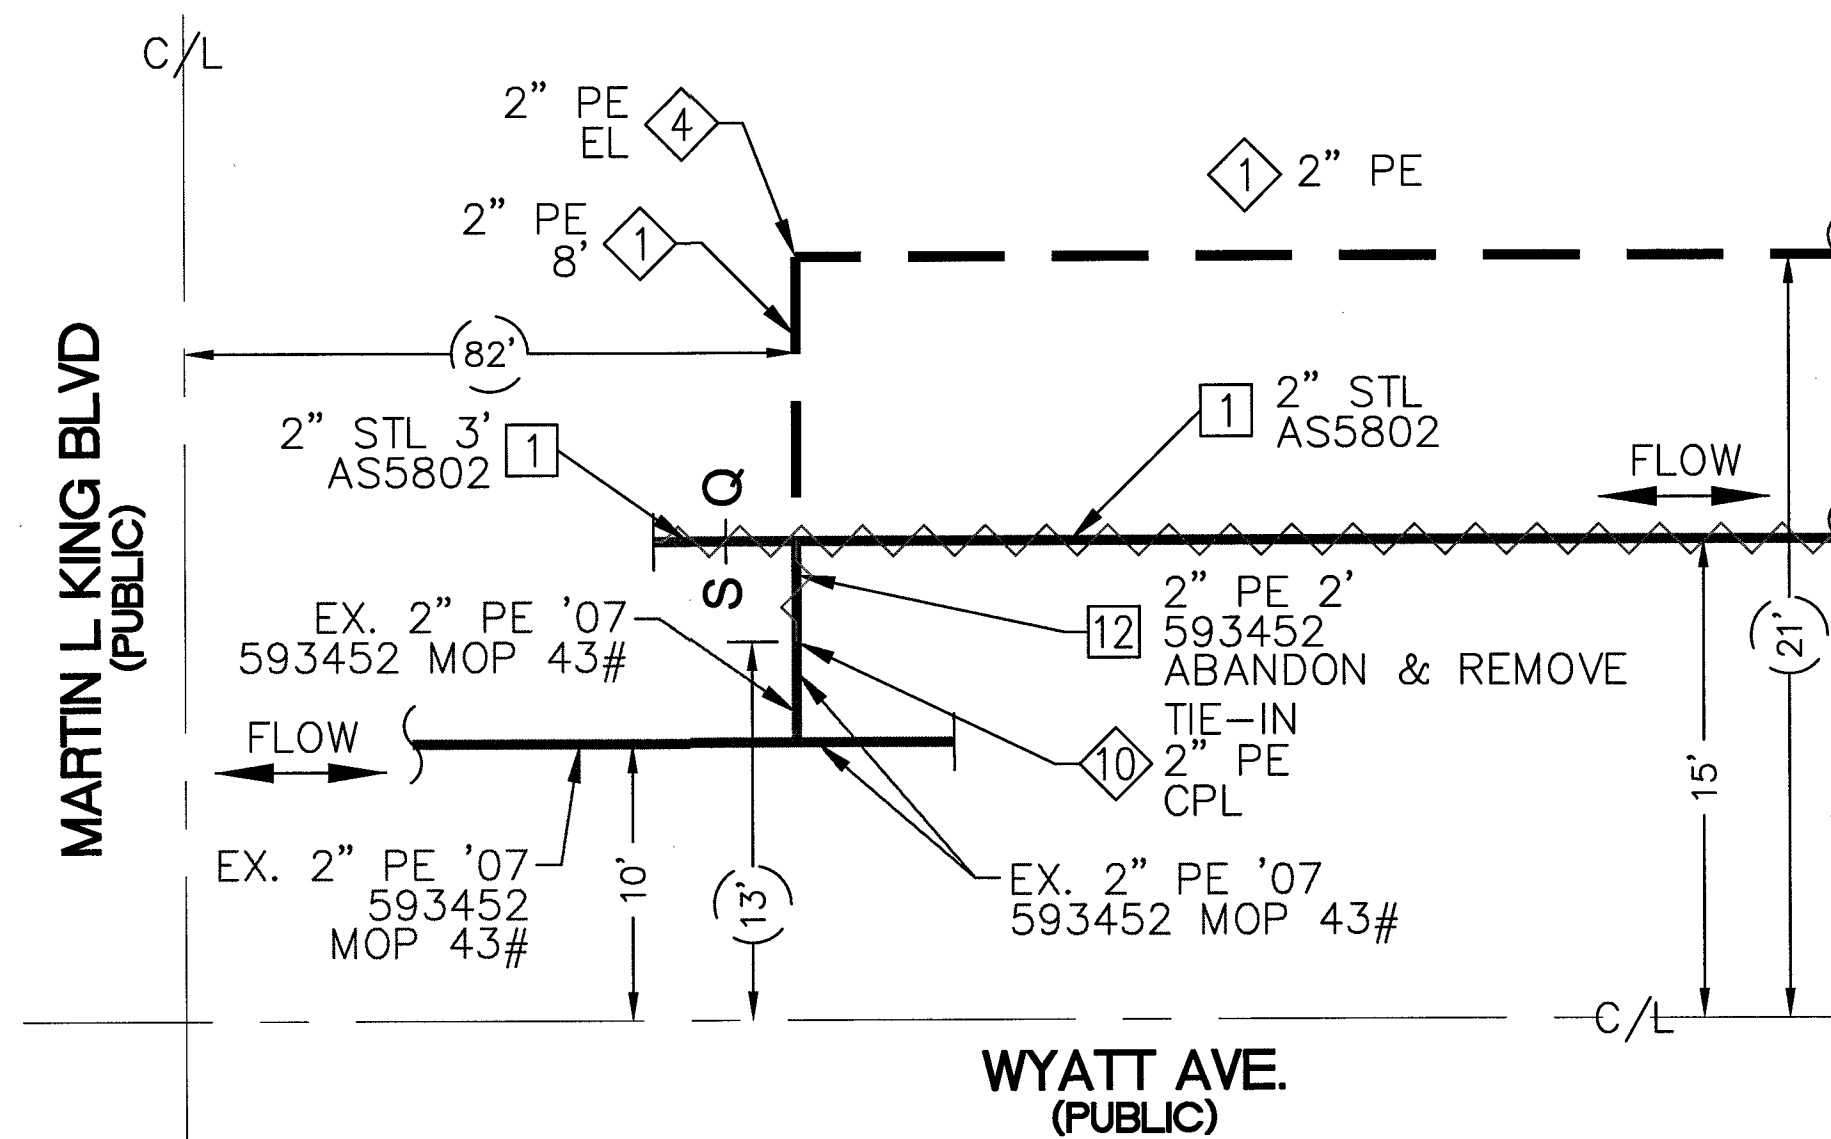

FOR STEEL ONLY
STEEL TIE IN #1

PIPE TO SOIL _____
ANODE INSTALLED?
YES ☐ NO ☐
IF YES, PIPE TO SOIL _____

TYPE OF PIPE COATING

2 ☐ TAR WRAP
3 ☐ ASPHALT
4 ☐ PRITEC
6 ☐ FUSION BONDED EPOXY
8 ☐ PLASTIC TAPE WRAP
9 ☐ EXTRUDED POLY COATING
10 ☐ OTHER

CONDITION OF PIPE COATING

E ☐ EXCELLENT
G ☐ GOOD
F ☐ FAIR
P ☐ POOR
N ☐ NO COATING

CONDITION OF PIPE


IF EXPOSED, EXTERNAL ☐ IF CUT OR COUPON, INTERNAL ☐

EG ☐ GOOD ☐ IG
ESC ☐ SLIGHT CORROSION ☐ ISC
EHC ☐ HEAVY CORROSION ☐ IHC

MATERIAL LIST FOR PROPOSED DISTRIBUTION FACILITIES		
ITEM#	STOCK ID#	DESCRIPTION
1	100-5101	PROPOSED 2" PE MAIN
2	140-3074	PROPOSED 2" PE TEE
3	140-3060	PROPOSED 2" PE CAP
4	140-3067	PROPOSED 2" PE 90° ELBOW
5	100-5201	PROPOSED 4" PE MAIN
6	140-3076	PROPOSED 4" PE TEE
7	140-5118	PROPOSED 4"X2" PE REDUCER
10	140-3532	PROPOSED 2" PE COUPLER
12	160-8018	PROPOSED 3-WAY 2" PE STEEL TAP TEE
13	160-8162	PROPOSED 2" STL TO 2" PE TRANSITION FITTING

MATERIAL LIST FOR PROPOSED ABANDONMENT FACILITIES		
ITEM#	PROPERTY UNITS #	DESCRIPTION
1	3760202	ABANDON 2" STL MAIN '56
2	3760102	ABANDON 2" PE MAIN '13
12	3760202	ABANDON 2" PE MAIN '07
15	3760202	ABANDON 2" PE MAIN '92
16	3760202	ABANDON 2" PE MAIN '09

MATERIAL LIST FOR STEEL FACILITIES		
ITEM#	STOCK ID#	DESCRIPTION
1	251-2406	CATHODIC TERMINAL TEST STATION 4"X18" LONG HNDY

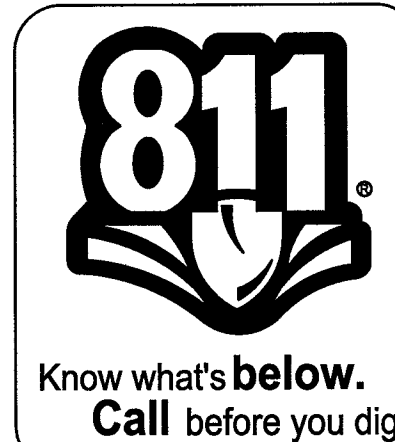

NEW ALIGNMENT FOR PROP. GAS MAIN ON J ST. RCM 05/23/2018

NO.	DESCRIPTION	BY	DATE	APPVD.
1				
2				
3				
4				

REVISIONS

SOUTHWEST GAS CORPORATION

PROPERTY UNITS

TAX CODES	UNIT NO.	UNIT TYPE	INSTL. PROPOSED	RETIRED COMPLETED

AS-BUILT DRAWING-PRESSURE TEST DATA

TEST MEDIUM TEST METHOD

PIPE DIA. _____ GAUGE

PIPE LENGTH _____ CHART

PIPE TYPE _____ GAUGE/ PRESS REC SNR

MIN. DURATION _____

TEST PRES. (PSIG) (MAX) _____ (MIN) _____

TIME (HOUR) (STOP) _____ (STOP) _____

DATE (START) _____ (STOP) _____

PERFORMED BY: _____

DATE VERIFIED BY: _____

INDIVIDUAL PERFORMING VISUAL INSPECTION VISUAL INSPECTION CERTIFICATION

I HAVE VISUALLY INSPECTED ALL HEATED FUSION, SOLVENT CEMENT, MECHANICAL JOINTS, AND WELDS THAT HAVE PERFORMED

NAME _____ DATE _____

SEE SHEET 3

AS-BUILTS ACCEPTED BY _____ DATE _____

POSTED BY _____ DATE _____

POSTING QC'D BY _____ DATE _____

CONSTRUCTION

INSPECTOR _____

FOREMAN _____

REVIEWED BY _____

PERMIT INFORMATION

CITY OF LAS VEGAS

TAX CODE 02-0200

ISOLATION AREA

ISO_21_DIST_092

W.R. NO.

3431281

LOCATION

SEC 21

T20S R61E

M.D.M.

ATLAS #/TITLE #

x624y522

x624y524

ENGINEER/TECH: RAMILO MENDOZA

ACCOUNT REP. _____

PROJECT CONTACT: _____

SHEET NO: 8 OF 9

DWN. BY: SEI

SCALE: NTS

CHKD. BY: _____

DATE: 12/05/2017

APPVD. BY: _____

TITLE

GIR 2018-CLV-HIGHLAND SQUARE DESIGN PLAN

J ST. (PUBLIC)

C/L

NOTE:
ABANDON ALL PVC
AT THIS LOCATION

EX. 2" PE '03
0305653455 MOP 43#

2" PE 3'
0305653455 [13]

2" PVC 3'
PE 1013 [14]

2" PVC 28'
PE 1013 [14]

6'

(8')

2" PE
[1] 30'

TIE-IN
2" PE
CPLR [10]

2" PE 2'
0305653455
ABANDON & REMOVE [13]

**OWENS AVE.
(PUBLIC)**

C/L

2" STL TO 2" PE
TRANSITION FITTING [13]

TIE-IN 2" PE
TAP TEE [12]

EX. 2" STL '56
AS738 MOP 43#

237'

(240')

(22')

FLOW

FLOW


**DETAIL
(SEE SHEET 7)
NTS**

N

E

-

NOTE: ENGINEERING RECOMMENDS 1" TEMPORARY BYPASS

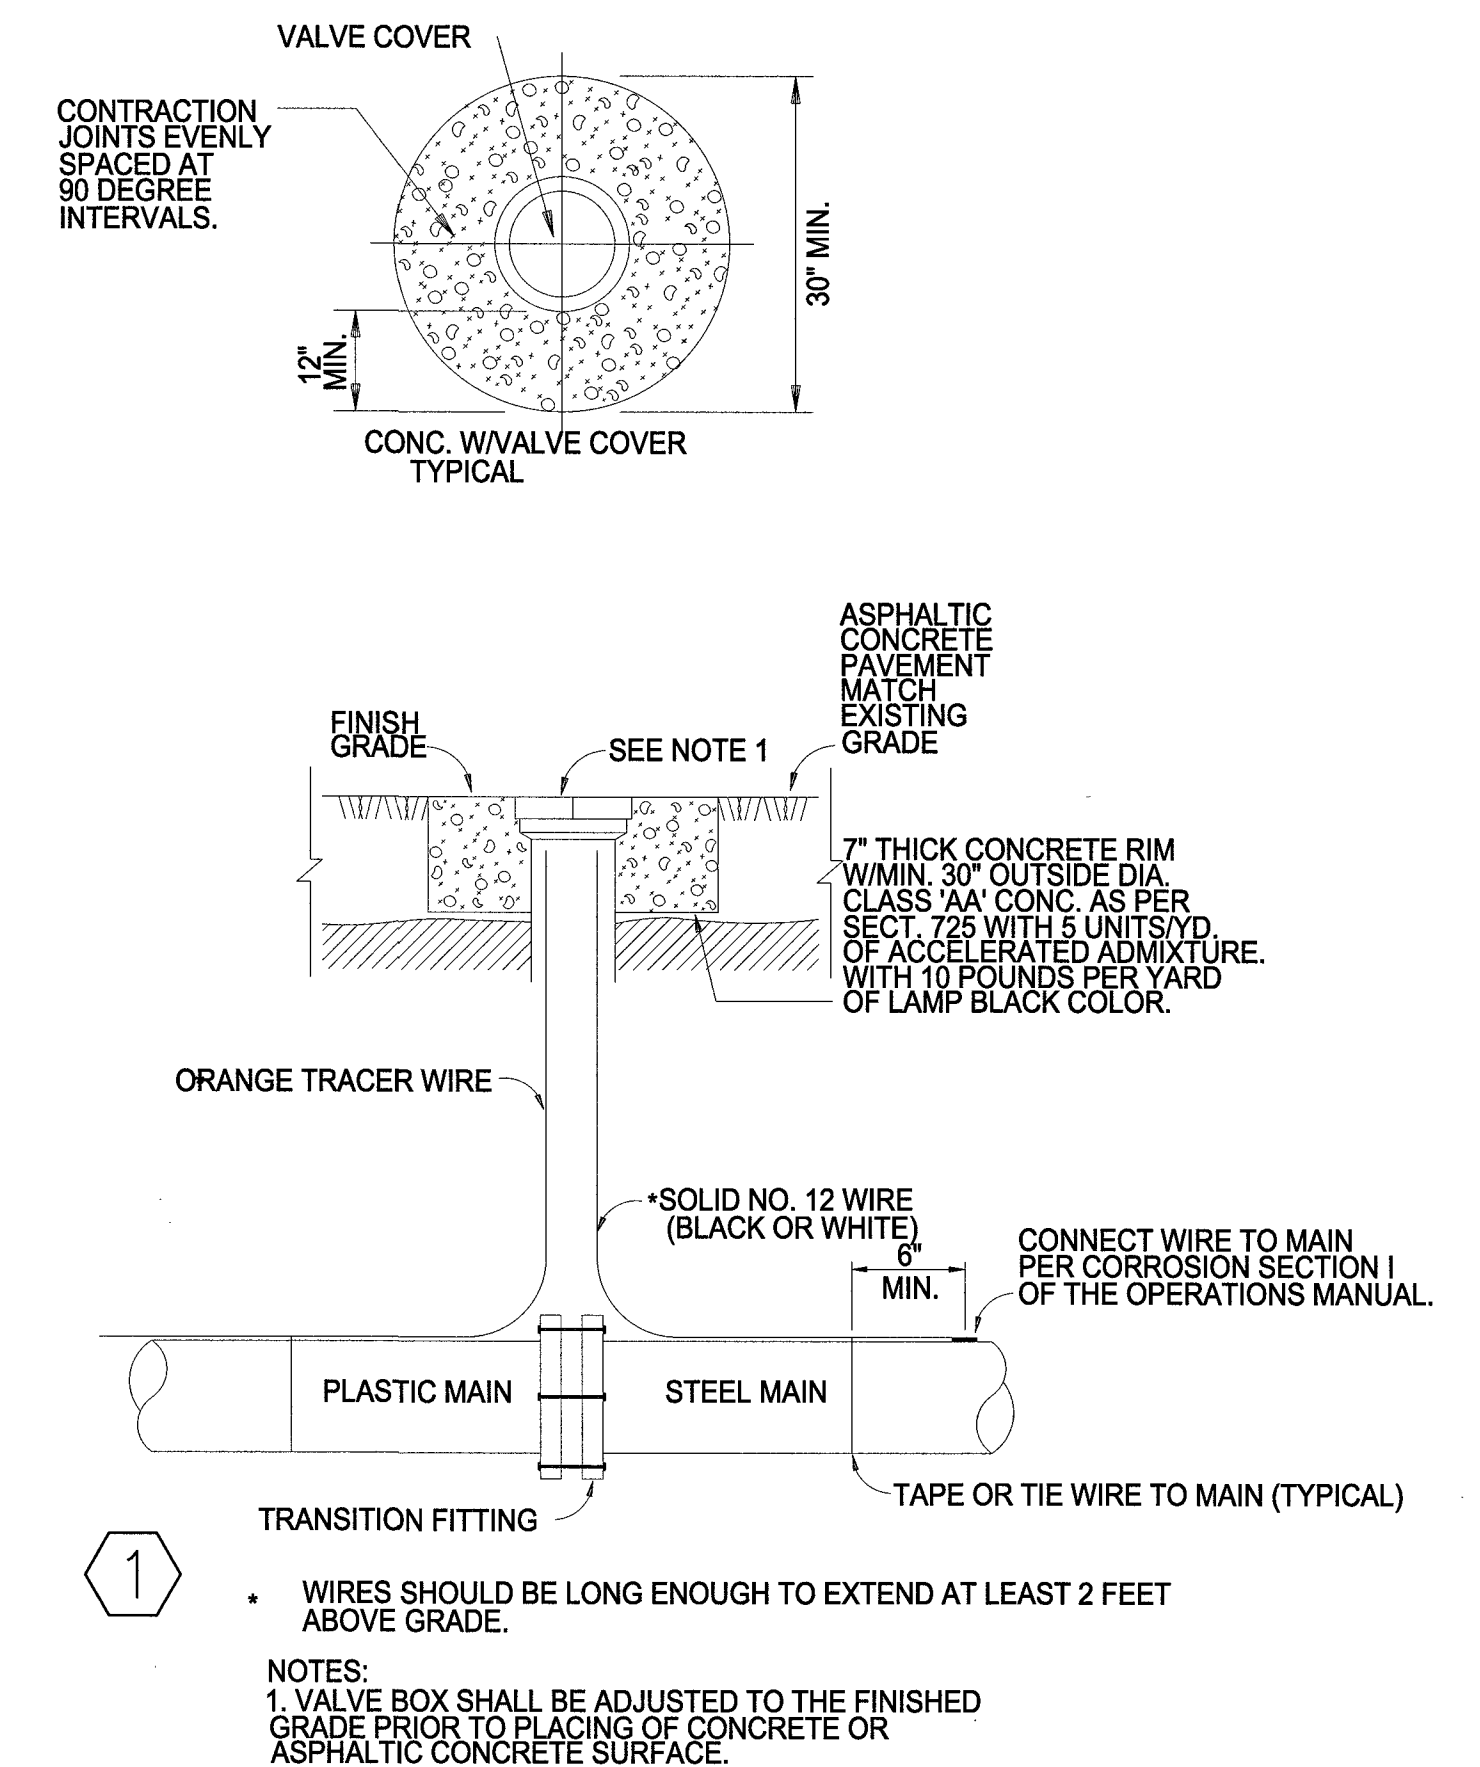

CATHODIC PROTECTION NOTES:

1. CONTACT CP DEPARTMENT AT (702) 528-7873 AT LEAST 48 HOURS PRIOR TO WORK TO COORDINATE INSTALLATION
2. THIS WR AFFECTS THE FOLLOWING CP AREAS:

CPID#: R6 1ST A
WMIS#: 21DCP0021136
3. INSTALL TEST STATION ON SHEET 7. SEE DETAIL "245" ON THIS SHEET 9.

MATERIAL LIST FOR PROPOSED DISTRIBUTION FACILITIES		
ITEM#	STOCK ID#	DESCRIPTION
①	100-5101	PROPOSED 2" PE MAIN
③	140-3060	PROPOSED 2" PE CAP
④	140-3067	PROPOSED 2" PE 90° ELBOW
⑤	140-3067	PROPOSED 4" PE MAIN
⑧	160-8174	PROPOSED 4"X2" PE TAPPNG TEE
⑩	140-3532	PROPOSED 2" PE COUPLER
⑪	160-8171	PROPOSED 2" PE TAPPING TEE
⑫	160-8018	PROPOSED 3-WAY 2" PE STEEL TAP TEE
⑬	160-8171	PROPOSED 2" STL TO 2" PE TRANSITION FITTING



Know what's **below**.
Call before you dig

1