

NOTES CONTINUED/CONTACT SHEET

GROUNDING NOTES

11.4 HANDHOLE/MANHOLE GROUNDING

All splice handholes/manholes will be grounded to conform with the MCI typical engineering drawing shown in Appendix A.

MCI-furnished materials:

- One 5/8-inch x 8-foot copper-clad steel ground rod equipped with a 15-foot #6 AWG pigtail.
- One surge arrester handhole/One isolator/protector system with 30 foot harness for use on a straight splice, or
- One isolator/protector system with 30-foot harness system for use at splices with a spur cable.

11.5 AERIAL CABLE GROUNDING

Cable sheath to strand bonds and grounding as required by National Electrical Code and Power Company Codes are required at all riser locations of an aerial segment.

Bond cable sheath and suspension strand to multi-ground neutral (MGN) vertical grounding conductor if one exists; if not, use a driven ground rod or a non-insulated guy.

A guy may also require grounding. This is determined by establishing the exposure status (exposed or unexposed) of the guy.

All exposed guys must be either grounded or insulated. A guy is exposed if:

- It is attached to the same pole as open power conductors or spacer cable of any voltage.
- It crosses such power conductors.
- It is within ten feet horizontally (and any distance vertically) of such power conductors.

Grounding is the preferred treatment for exposed guys, except for the following cases in which they must be insulated:

- The MCI guy fastened to the pole in power company working space and a grounded guy would offer an additional hazard to power company linemen.
- Within 1/2-mile of a power station.
- Where electrolytic corrosion of anchors has occurred (unexposed guys, in this case must be separated from the cable strand at the pole, and electrical connection through hardware must be avoided).

Adequate grounding for MCI guys may be obtained through connection to any of the following:

- Vertical grounding conductor of power system multi-ground neutral (with permission of the power company).
- Suspension strand of grounded MCI cable.
- Common anchor rod with a power guy that is connected to the multi-grounded neutral.

Unexposed guys need not be grounded for protection reasons; however, connecting anchor guys to a grounded MCI strand is recommended, as it will lower the cable-to-ground impedance. This helps to reduce cable damage caused by lightning.

MCImetro Access Transmission Services Corp
d/b/a Verizon Access Transmission Service (Verizon)

OUTSIDE PLANT ENGINEERING:

PROJECT ENGINEER: CORY VANDENBOS
SUPERVISOR: N/A
MANAGER: N/A

OUTSIDE PLANT CONSTRUCTION:

PROJECT SUPERVISOR:
FIELD CONST. SUPERINTENDENT:
MANAGER: N/A

RIGHT-OF-WAY:

AGENT:
MANAGER:

CONTRACTS:

COORDINATOR: N/A
MANAGER: N/A

OTHERS:

PROGRAM MANAGER: N/A
LIGHTWAVE ENGINEER: N/A
CIVIL ENGINEER: N/A
TERMINAL CONST. REP.: N/A
SPLICING MANAGER: N/A
TSD MANAGER: N/A

ENGINEERING CONTRACTOR

NAME OF FIRM: BPG DESIGNS 1-602-954-2223
PROJECT MANAGER: LEE STAUBER 1-602-739-8813
ENG. PROJECT SUPERVISOR:

CONSTRUCTION CONTRACTOR

NAME OF FIRM: TEAM FISHEL 1-702-644-4565
PROJECT COORDINATOR:

CITY GOVERNMENT

BUREAU OF ENGINEERING:

CITY ENGINEER:

UTILITIES

WORLD COM UTILITY LOCATE 1-800-624-9675
USA NORTH BLUESTAKE 811

PROJECT TOTALS SUMMARY

MATERIALS

2" HDPE CONDUIT(S): 5,852'
4" HDPE CONDUIT(S): -
2' x 3' x 2' HANDHOLE(S): -
2.5' x 5' x 2.5' HANDHOLE(S): 4
4' x 4' x 4' HANDHOLE(S): 1
MANHOLES: -

WORK TYPE

AERIAL: -
VZW CONDUIT: -
3RD PARTY CONDUIT: 994'
TRENCH: 2,947'
ASPHALT CUT: -
BORE: -
BORE/TRENCH: -
TOTAL NEW UG FOOTAGE: 2,947'
TOTAL FOOTAGE: 3,941'

Per LOT
U18-01339-P002
10117484-FIB

0 10 20 30 40 50
DRAWING SCALE IS IN FEET:
(1"=60' AT 11"x17" print)
(1"=30' AT 24"x36" print)



CELL SITE: LSV CASHMAN FIELD REV.
01-10-18

CITY OF LAS VEGAS, NEVADA

CLARIFICATION NO. QUANTITY

MCI COMMUNICATIONS SERVICES, INC.

OUTSIDE PLANT CONSTRUCTION

TITLE: CELL SITE: LSV CASHMAN FIELD
REV. 01-10-18
PROJECT TITLE

DATE: 01/10/18

DRAWN BY: JJAMES

REVISIONS

DATE	DESCRIPTION	INITIAL
12-12-18	UPDATE HH LOCATION SHT. 14 & RELOCATE R/L SHTS. 13 AND 14	EJR
01-10-18	MOVED R/L SHTS 10-13, ADJUSTED FOOTAGE SHTS 3, 13, 14	JJ
01-10-18	PK 1 22 19	

EXCEPT AS MAY BE OTHERWISE PROVIDED BY CONTRACT, THESE DRAWINGS AND SPECIFICATIONS SHALL REMAIN THE PROPERTY OF MCI COMMUNICATIONS SERVICES, INC. BOTH BEING ISSUED IN STRICT CONFIDENCE AND SHALL NOT BE REPRODUCED, COPIED, OR USED FOR ANY PURPOSE WITHOUT SPECIFIC WRITTEN PERMISSION.

SCALE

HORIZONTAL: 1"=30'

VERTICAL: NA

MP TO MP

SHEET 3 OF 15

FILE: LSV CASHMAN FIELD REV. 01-10-18

NOTES CONTINUED/CONTACT SHEET

GROUNDING NOTES

11.4 HANDHOLE/MANHOLE GROUNDING

All splice handholes/manholes will be grounded to conform with the MCI typical engineering drawing shown in Appendix A.

MCI-furnished materials:

- One 5/8-inch x 8-foot copper-clad steel ground rod equipped with a 15-foot #6 AWG pigtail
- One surge arrester handholeOne isolator/protector system with 30 foot harness for use on a straight splice, or
- One isolator/protector system with 30-foot harness system for use at splices with a spur cable.

11.5 AERIAL CABLE GROUNDING

Cable sheath to strand bonds and grounding as required by National Electrical Code and Power Company Codes are required at all riser locations of an aerial segment.

Bond cable sheath and suspension strand to multi-ground neutral (MGN) vertical grounding conductor if one exists; if not, use a driven ground rod or a non-insulated guy.

A guy may also require grounding. This is determined by establishing the exposure status (exposed or unexposed) of the guy.

All exposed guys must be either grounded or insulated. A guy is exposed if:

- It is attached to the same pole as open power conductors or spacer cable of any voltage.
- It crosses such power conductors.
- It is within ten feet horizontally (and any distance vertically) of such power conductors.

Grounding is the preferred treatment for exposed guys, except for the following cases in which they must be insulated:

- The MCI guy fastened to the pole in power company working space and a grounded guy would offer an additional hazard to power company linemen.
- Within 1/2-mile of a power station.
- Where electrolytic corrosion of anchors has occurred (unexposed guys, in this case must be separated from the cable strand at the pole, and electrical connection through hardware must be avoided).

Adequate grounding for MCI guys may be obtained through connection to any of the following:

- Vertical grounding conductor of power system multi-ground neutral (with permission of the power company).
- Suspension strand of grounded MCI cable.
- Common anchor rod with a power guy that is connected to the multi-grounded neutral.

Unexposed guys need not be grounded for protection reasons; however, connecting anchor guys to a grounded MCI strand is recommended, as it will lower the cable-to-ground impedance. This helps to reduce cable damage caused by lightning.

MCI metro Access Transmission Services Corp
d/b/a Verizon Access Transmission Service (Verizon)

OUTSIDE PLANT ENGINEERING:

PROJECT ENGINEER: CORY VANDENBOS
SUPERVISOR: N/A
MANAGER: N/A

OUTSIDE PLANT CONSTRUCTION:

PROJECT SUPERVISOR:
FIELD CONST. SUPERINTENDENT:
MANAGER: N/A

RIGHT-OF-WAY:

AGENT:
MANAGER:

CONTRACTS:

COORDINATOR: N/A
MANAGER: N/A

OTHERS:

PROGRAM MANAGER: N/A
LIGHTWAVE ENGINEER: N/A
CIVIL ENGINEER: N/A
TERMINAL CONST. REP: N/A
SPLICING MANAGER: N/A
TSD MANAGER: N/A

ENGINEERING CONTRACTOR

NAME OF FIRM: BPG DESIGNS 1-602-954-2223
PROJECT MANAGER: LEE STAUBER 1-602-739-8813
ENG. PROJECT SUPERVISOR:

CONSTRUCTION CONTRACTOR

NAME OF FIRM: TEAM FISHEL 1-702-644-4565
PROJECT COORDINATOR:

CITY GOVERNMENT

BUREAU OF ENGINEERING:

CITY ENGINEER:

UTILITIES

WORLD COM UTILITY LOCATE 1-800-624-9675
USA NORTH BLUESTAKE 811

PROJECT TOTALS SUMMARY

MATERIALS

2" HDPE CONDUIT(S): 5,781'
4" HDPE CONDUIT(S): -
2' x 3' x 2' HANDHOLE(S): -
2.5' x 5' x 2.5' HANDHOLE(S): 5
4' x 4' x 4' HANDHOLE(S): 1
MANHOLES: -

WORK TYPE

AERIAL: -
VZW CONDUIT: -
3RD PARTY CONDUIT: 994'
TRENCH: 2,961'
ASPHALT CUT: -
BORE: -
BORE/TRENCH: -
TOTAL NEW UG FOOTAGE: 2,984'
TOTAL FOOTAGE: 3,978'



PROJECT: 916055, 916056, 916117

CELL SITE: LSV CASHMAN FIELD

CITY OF LAS VEGAS, NEVADA

CLARIFICATION NO. QUANTITY

MCI COMMUNICATIONS SERVICES, INC.

OUTSIDE PLANT CONSTRUCTION

TITLE: CELL SITE: LSV CASHMAN FIELD

PROJECT TITLE

DATE: 7/18/2018

DRAWN BY: ERAMSEY

REVISIONS

DATE	INITIAL

EXCEPT AS MAY BE OTHERWISE PROVIDED BY CONTRACT, THESE DRAWINGS AND SPECIFICATIONS SHALL REMAIN THE PROPERTY OF MCI COMMUNICATIONS SERVICES, INC., BOTH BEING ISSUED IN STRICT CONFIDENCE AND SHALL NOT BE REPRODUCED, COPIED, OR USED FOR ANY PURPOSE WITHOUT SPECIFIC WRITTEN PERMISSION.

SCALE

HORIZONTAL: 1"=30'

VERTICAL: NA

MP TO MP

SHEET 3 OF 15

FILE: LSV CASHMAN FIELD

0 10 20 30 40 50
DRAWING SCALE IS IN FEET:
(1"=60' AT 11"x17" print)
(1"=30' AT 24"x36" print)

SYMBOLS KEY

BURIED CABLE	
AERIAL CABLE	
SUBMARINE CABLE	
FOGWIRE CABLE	
DIRECT BURIED HDPE	
PVC OR SPLIT PVC CONDUIT	
BSP/GSP OR SPLIT BSP/GSP CONDUIT	
STEEL CASING	
REMOVE AND RESTORE ASPHALT OR CONCRETE (WIDTH AS INDICATED)	
CORE BORE	
JACK AND BORE	
DIRECTIONAL BORE	
OPEN TRENCH	
FUTURE CABLE	
REMOVE CABLE	
TO BE REMOVED OR ABANDONED (SHOWN FOR HDPE)	
AERIAL UTILITY (ELECTRIC)	
UNDERGROUND UTILITY (TELEPHONE)	
MAIN TRACKS	
AUXILLARY TRACKS	
CENTERLINE	
RIGHT-OF-WAY	
DITCH LINE	
CITY, COUNTY OR STATE BOUNDARY LINE	
PROPERTY LINE	
BLOCKWALL	
FENCE LINE	
GUARDRAIL	
TOP OF SLOPE	
TOE OF SLOPE	

STEEL MARKER AND SIGN-(A)
ALUMINUM "HUB"-STYLE MARKER-(B)
FLAT MARKER-(C)
TUBULAR MARKER-(D)
TUBULAR MARKER, & ISOLATOR PROTECTOR-(E)

MILE POST MARKER
 NOTE:
 DASHED = NOT FOUND IN FIELD

PERMIT TRACKING FORM IDENTIFIER

UTILITY COVER DEPTH

HANDHOLE, VAULT OR PULLBOX

STREET LIGHT

WOOD POLE & STEEL POLE

ANCHOR ONLY

GUY ONLY

OVERHEAD GUY (ARROW IN DIRECTION OF PULL)

ANCHOR AND GUY

SIDEWALK ANCHOR AND GUY

FOREIGN ANCHOR AND GUY

PUSH BRACE (EXISTING POLE)

ACCOUNT CODE CHANGE (BURIED TO AERIAL)

RISER POLE

BOND AND GROUND

CULVERT (SIZE AS INDICATED)

BRIDGE

METER


VALVE

FIRE HYDRANT

RAILROAD SIGNAL CONTROL BOX

MANHOLE

POTHOLE

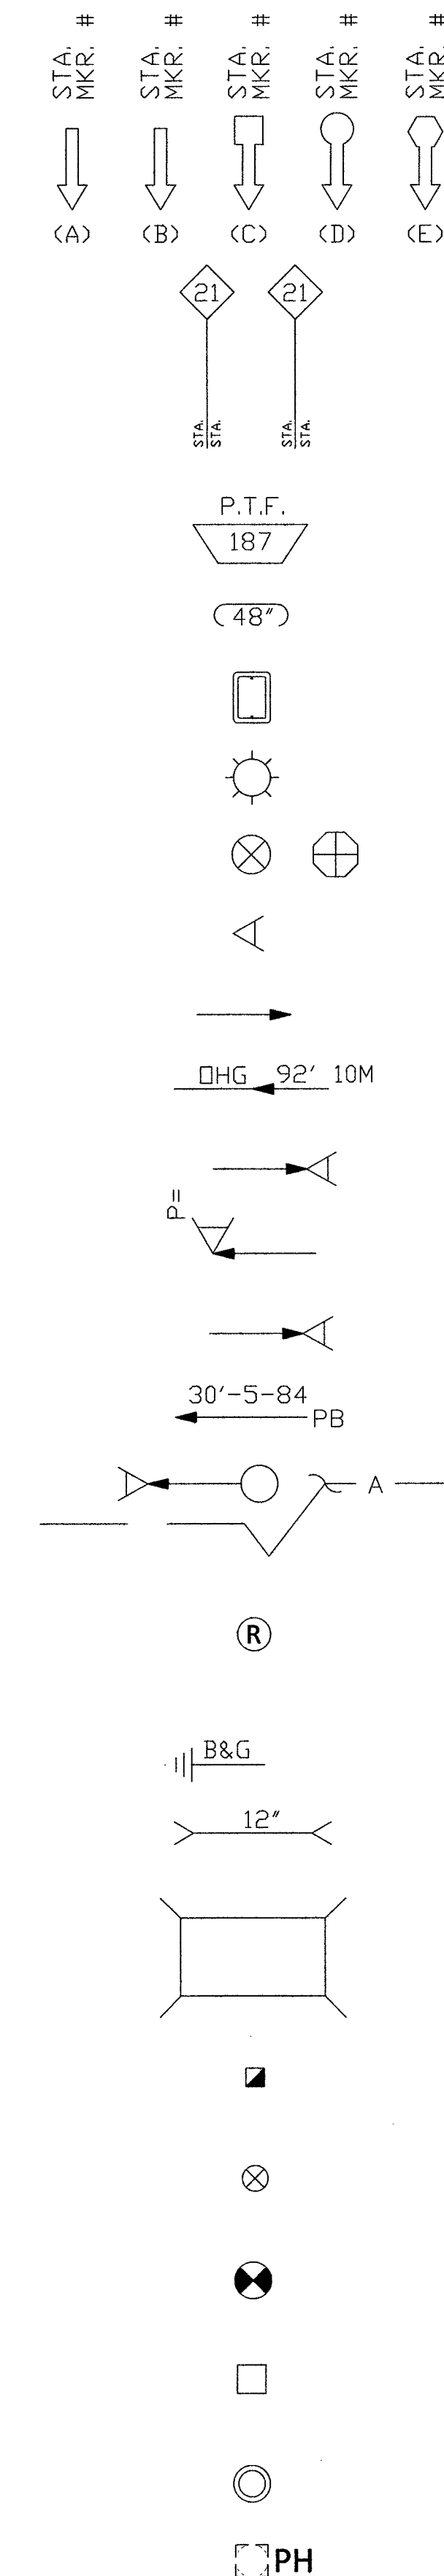

PROJECT: 916055, 916056,
916117

CELL SITE: LSV CASHMAN FIELD

CITY OF LAS VEGAS, NEVADA

CLARIFICATION NO.	QUANTITY
-------------------	----------

[illegible]

MCI
COMMUNICATIONS SERVICES, INC.

OUTSIDE PLANT CONSTRUCTION

TITLE: CELL SITE: LSV CASHMAN FIELD

PROJECT TITLE

DATE: 7/18/2018

DRAWN BY: ERAMSEY

[illegible]

EXCEPT AS MAY BE OTHERWISE PROVIDED BY CONTRACT, THESE DRAWINGS AND SPECIFICATIONS SHALL REMAIN THE PROPERTY OF MCI COMMUNICATIONS SERVICES, INC., BOTH BEING ISSUED IN STRICT CONFIDENCE AND SHALL NOT BE REPRODUCED, COPIED, OR USED FOR ANY PURPOSE WITHOUT SPECIFIC WRITTEN PERMISSION.

SCALE

HORIZONTAL: 1"=30'



VERTICAL:	NA
-----------	----

MP	TO MP
----	-------

SHEET 4 OF 15

FILE: LSV CASHMAN FIELD

1. CONCRETE: 28 DAY COMPRESSIVE STRENGTH F'C = 5,000 PSI
2. STEEL REINFORCEMENT: ASTM A-615, GRADE 60
3. COVER TO STEEL - 1" MINIMUM
4. DESIGNED TO MEET ACI 318 FOR:
HS20 LIVE LOAD
45 PCF SOIL EFP
0'-0" SOIL COVER
WATER TABLE 3'-0" BELOW GRADE
5. JOINT SEALANT: CONSEAL BUTYL SEALANT ASTM C-990-91
6. WEIGHT:
TOP - 3,100 LBS
BOTTOM - 3,650 LBS

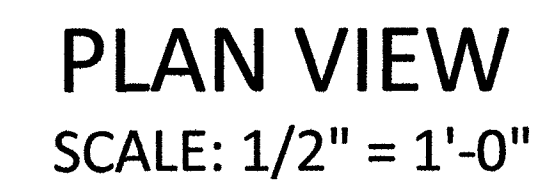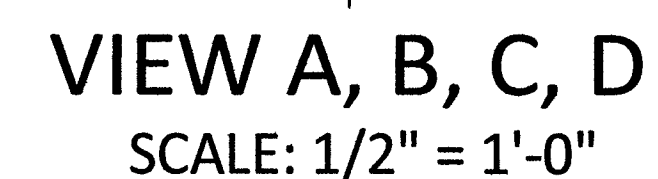

4'x4'x4' TYPE "S" KNOCKOUT


4'x4'x4' TYPE "S" KNOCKOUT

FILE: LSV CASHMAN FIELD


W:\VERIZON ONEFIBER\LAS VEGAS\LSV FOREMASTER\LSV CASHMAN FIELD\CONSTRUCTION DRAWINGS

2.5' x 5' x 2.5' HANDHOLE DETAILS


DETAIL "A"
EXPLODED ISOMETRIC DETAIL

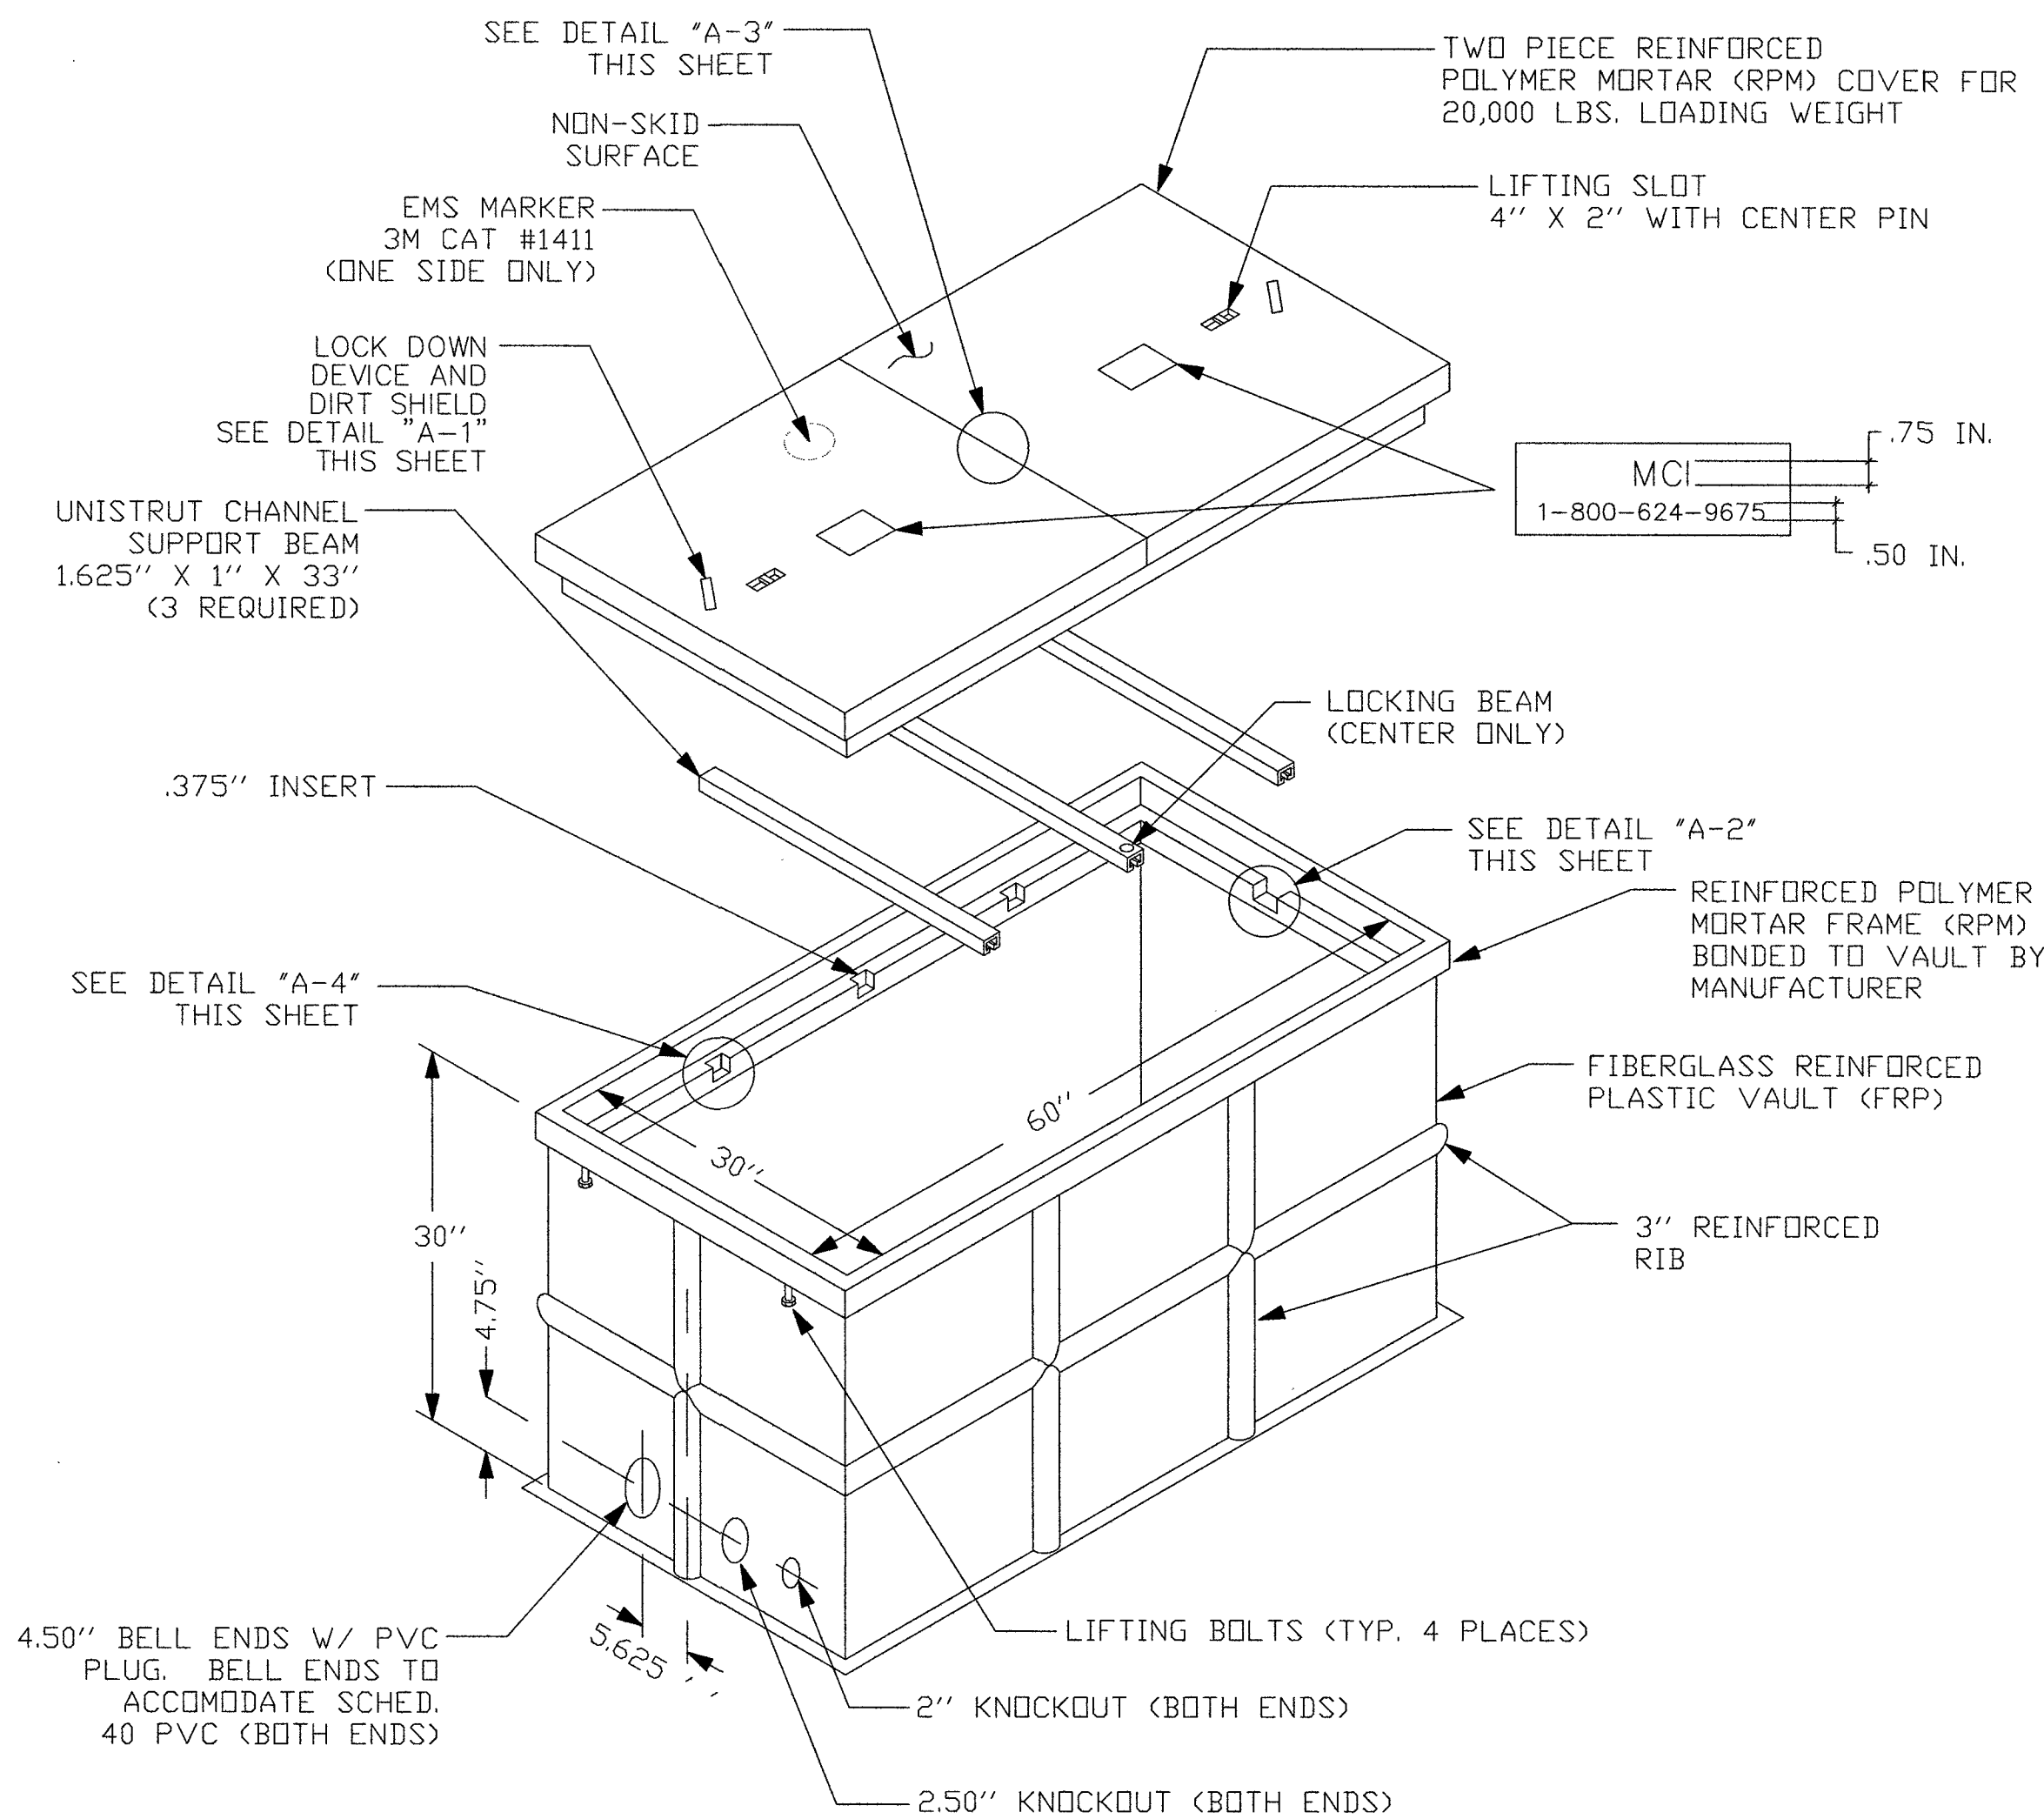


DETAIL "C"
EXCAVATION PIT

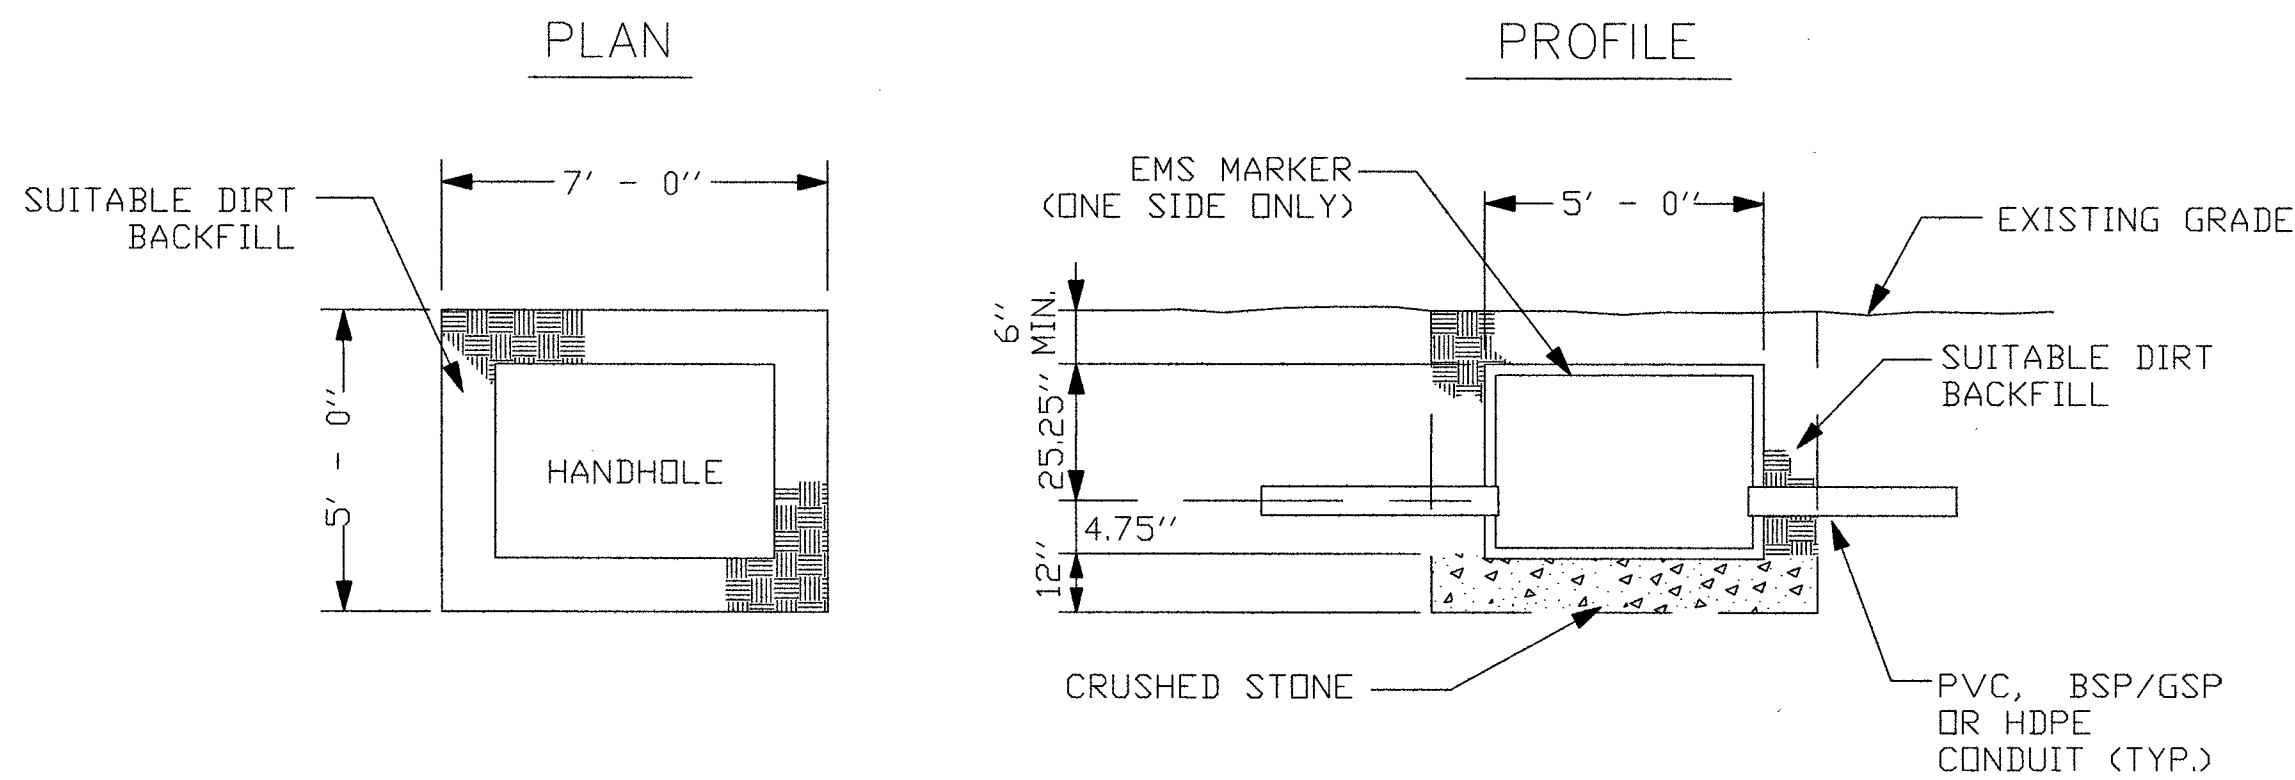


DETAIL "A-1"
LOCK DOWN DEVICE

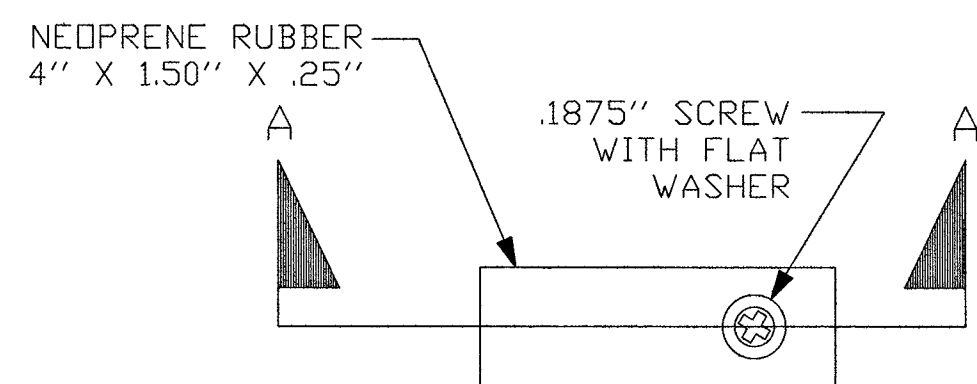


SECTION A-A
LOCKING DEVICE
CROSS SECTION

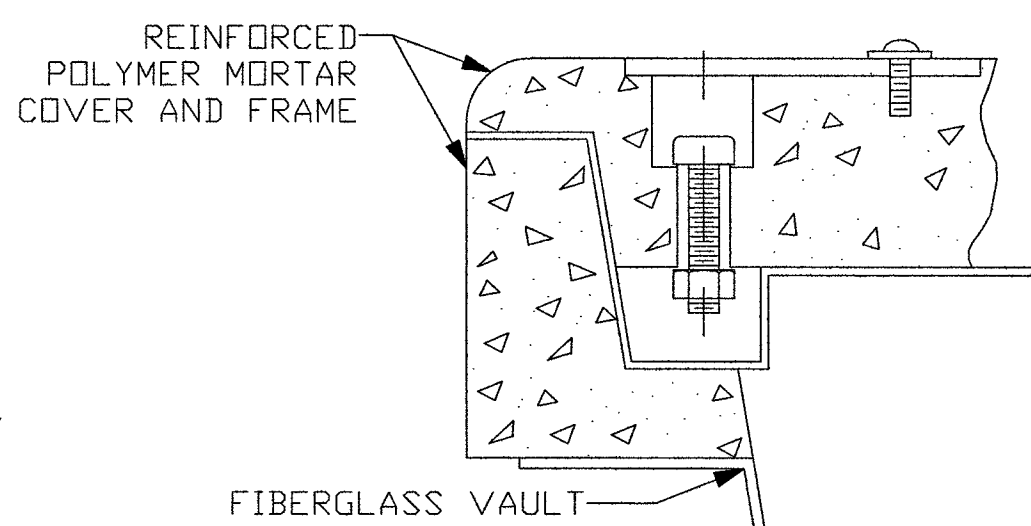

DETAIL "B"

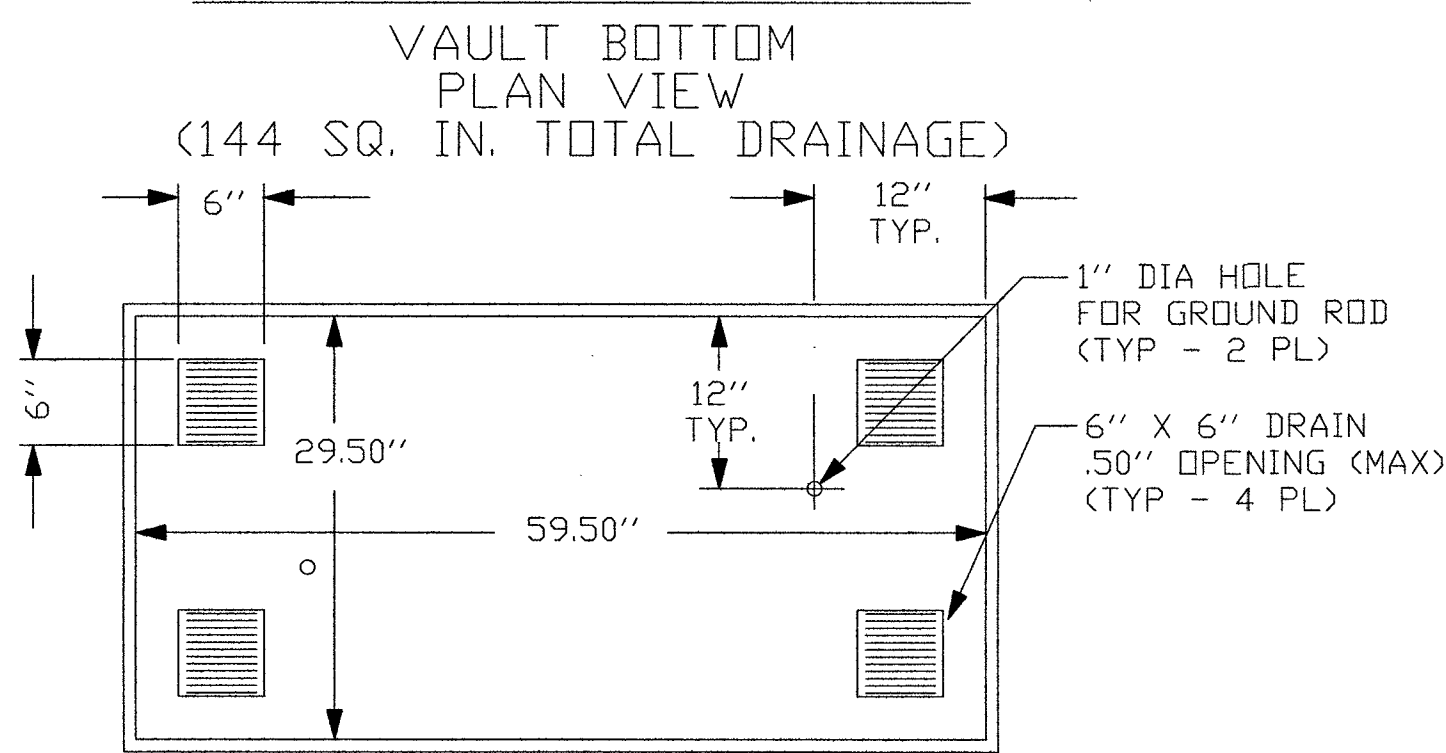


DETAIL "D"

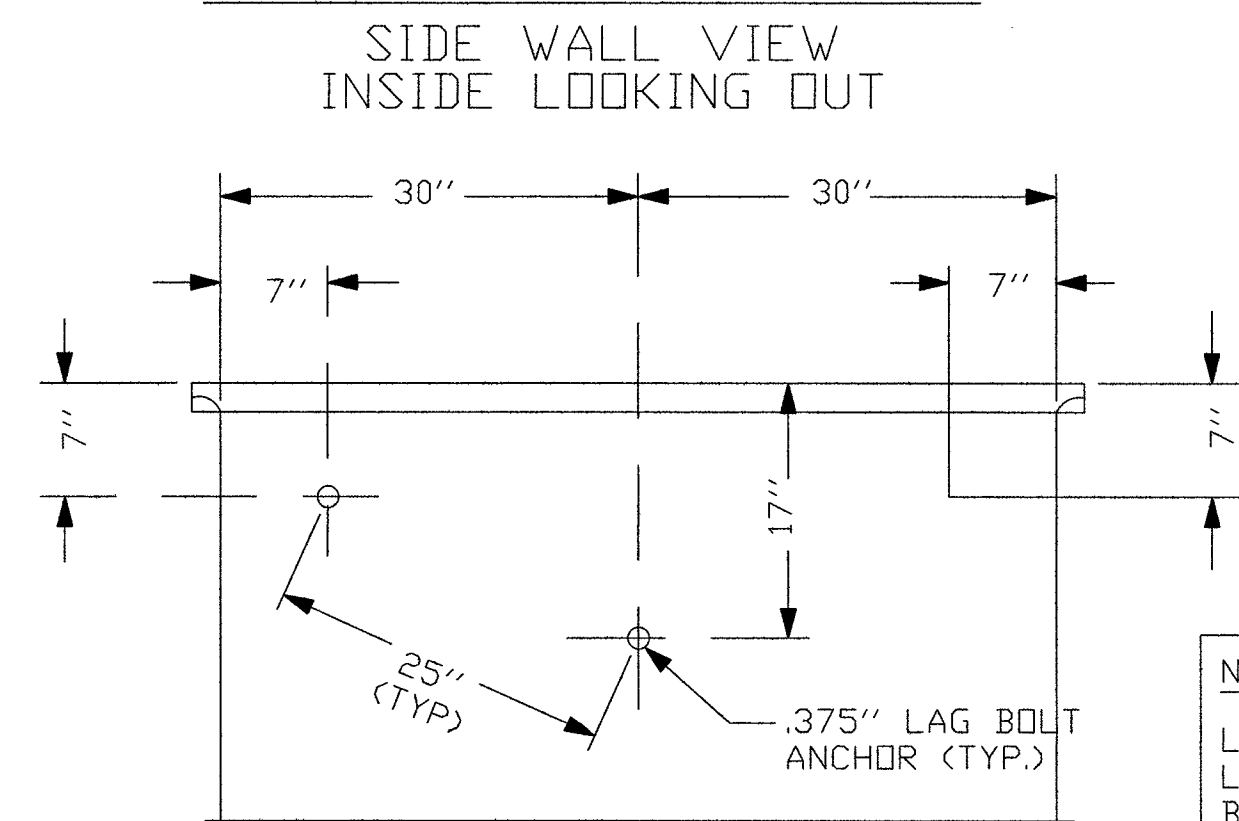


NOTE:
LINEAR DISTANCE BETWEEN LAG BOLT ANCHORS MUST BE 25".

DETAIL "A-2"
ENGAGED LOCK
DOWN DEVICE

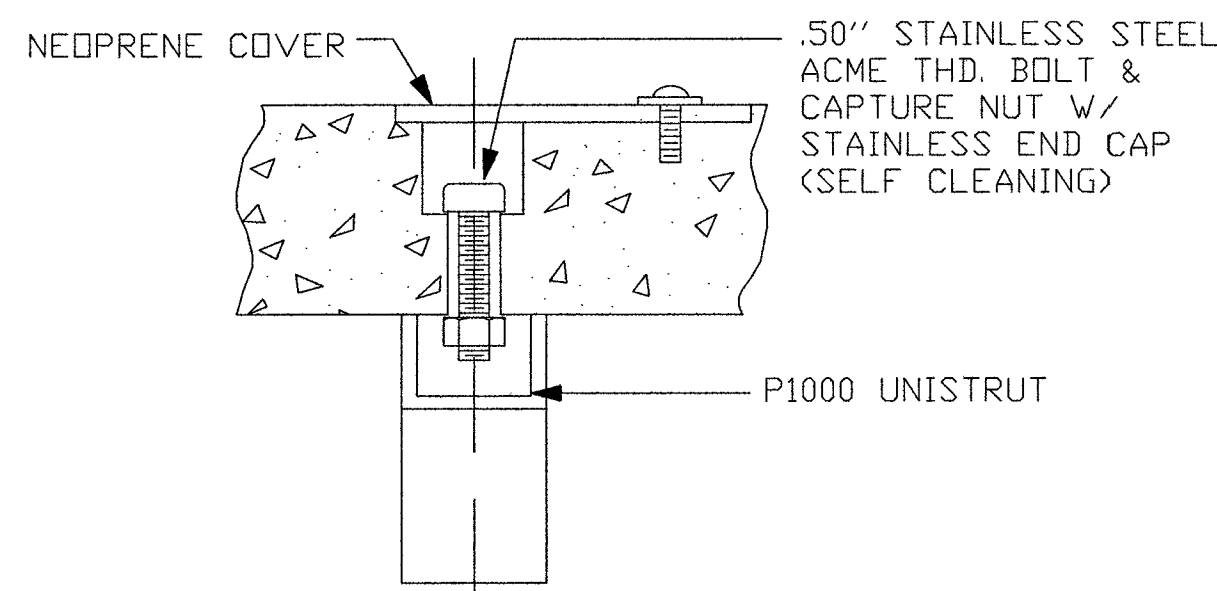


DETAIL "A-3"

COVER HOLD DOWN BRACKET
OF 2-PIECE RPM COVER

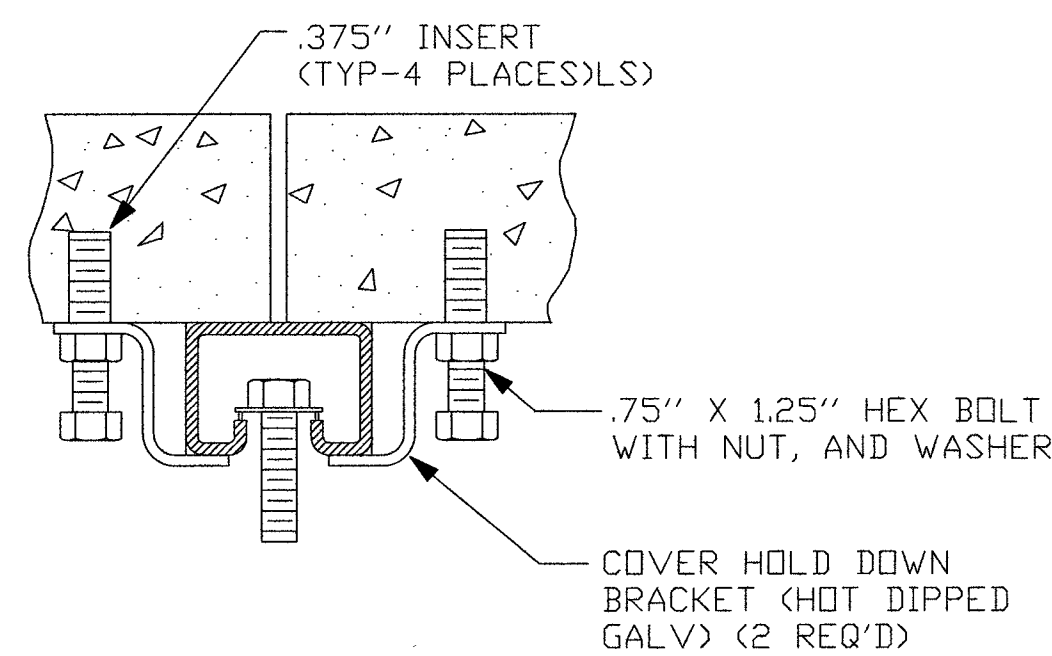

DETAIL "A-4"

SUPPORT BEAM
INSTALLATION
(TYP. AT 6 PLACES)

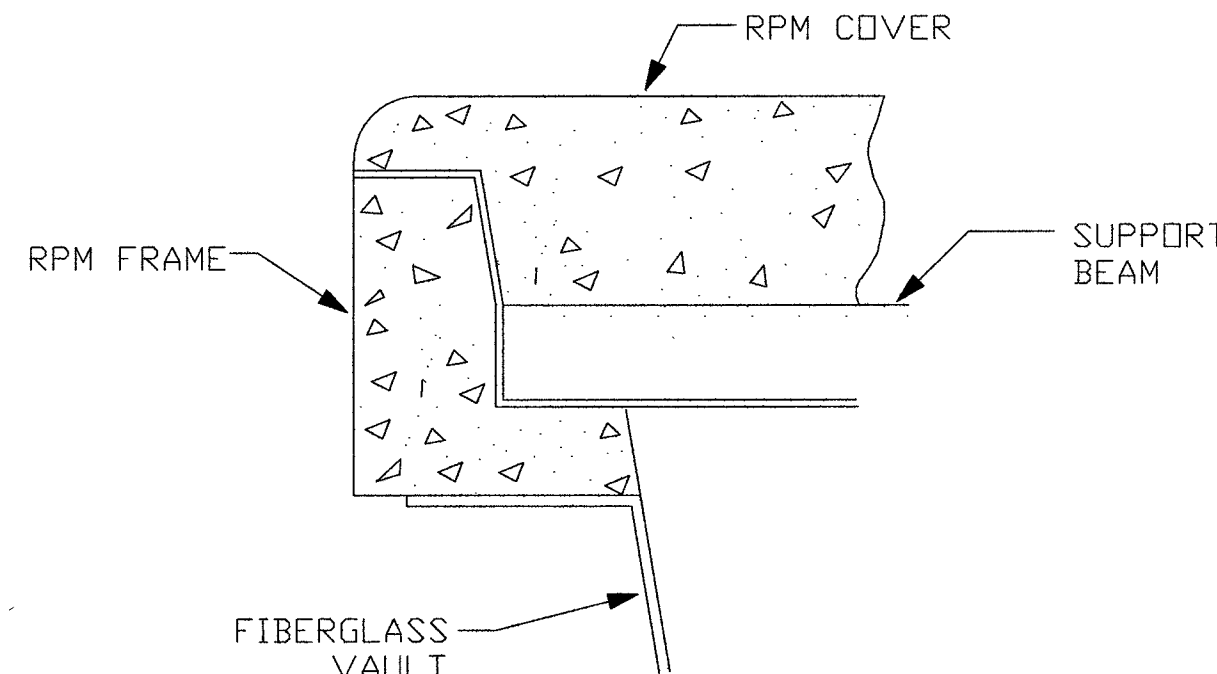

NOTES:

- VOID IN EXCAVATED AREAS TO BE BACKFILLED WITH SELECT MATERIAL.
- BOTTOM OF EXCAVATED PIT TO BE BACKFILLED WITH 12" OF CRUSHED STONE (.75" GRADE).
- SHORING WILL BE REQUIRED.
- ALL HANDHOLES SHALL BE PLACED BELOW EXISTING GRADE.
- THIS HANDHOLE IS OF FIBERGLASS MATERIAL, APPROXIMATELY POUNDS IN WEIGHT. THE LIDS ARE POLYMER CONCRETE MATERIAL, EACH APPROXIMATELY POUNDS.



PROJECT: 916055, 916056, 916117

CELL SITE: LSV CASHMAN FIELD

CITY OF LAS VEGAS, NEVADA

CLARIFICATION NO. QUANTITY

COMMUNICATIONS SERVICES, INC.

OUTSIDE PLANT CONSTRUCTION

TITLE: CELL SITE: LSV CASHMAN FIELD

PROJECT TITLE

DATE: 7/18/2018

DRAWN BY: ERAMSEY

REVISIONS

DATE INITIAL

SCALE

HORIZONTAL: 1"=30'

VERTICAL: NA

MP TO MP

SHEET 6 OF 15

FILE: LSV CASHMAN FIELD



TRENCH DETAIL

EXISTING GRADE

36" MIN

18" MIN

2" MIN

2" MIN

WARP TAPE


SACK SLURRY

BACKFILL


12" MIN

1-2" CONC

Detailed description: This is a cross-sectional diagram of a trench. The top line is labeled 'EXISTING GRADE'. The trench has a width of '12" MIN'. The depth is indicated by two vertical dimension lines on the left: '36" MIN' for the total depth and '18" MIN' for the depth of the backfill. The trench walls are '2" MIN' thick. The bottom of the trench is '1-2" CONC'. The backfill material is labeled 'SACK SLURRY' and 'BACKFILL'. A 'WARP TAPE' is shown at the bottom of the trench walls.

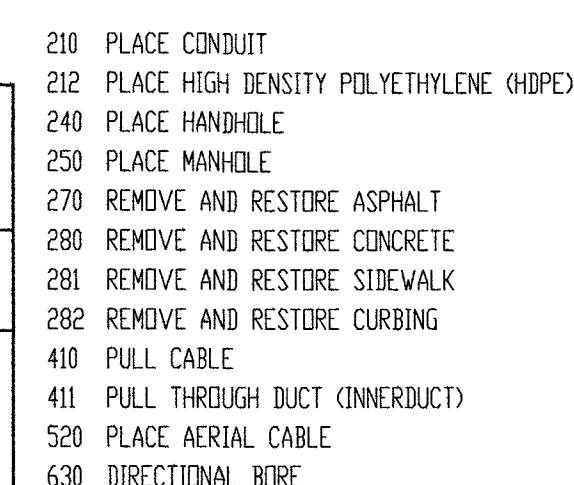


CONSTRUCTION DRAWING
CITY OF LAS VEGAS, NEVADA

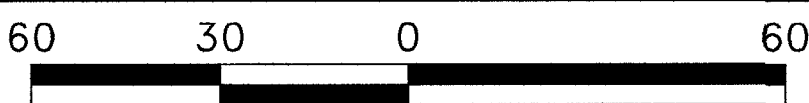

Call at least two full working days
before you begin excavation.



Know what's below.
Call 811 before you dig.

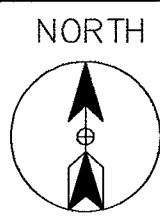

CELL SITE: LSV CASHMAN FIELD REV.
01-10-18

CITY OF LAS VEGAS, NEVADA

CLARIFICATION NO. QUANTITY

SHEET TOTAL

2" HDPE CONDUIT: 804'

4" HDPE CONDUIT: -

2' x 3' x 2' HANDHOLE(S): -

2.5' x 5' x 2.5' HANDHOLE(S): -

4' x 5' x 4' HANDHOLE(S): -

MANHOLE(S): -

AERIAL: -

VZW CONDUIT: -

3RD PARTY CONDUIT: -

ASPHALT CUT: -

TRENCH: 402'

BORE: -

BORE/OPEN TRENCH: -

TOTAL NEW UG FOOTAGE: 402'

TOTAL FOOTAGE: 402'

COMMUNICATIONS SERVICES, INC.

OUTSIDE PLANT CONSTRUCTION

TITLE: CELL SITE: LSV CASHMAN FIELD
REV. 01-10-18

DATE: 01/10/18

DRAWN BY: JJAMES

REVISIONS

DATE	DESCRIPTION	INITIAL
12-12-18	UPDATE HH LOCATION SHT. 14 & RELOCATE R/L SHTS. 13 AND 14	EJR
01-10-18	MOVED R/L SHTS 10-13, ADJUSTED FOOTAGE SHTS 3, 13, 14	JJ
	PK 1 22 19	

EXCEPT AS MAY BE OTHERWISE PROVIDED BY
CONTRACT, THESE DRAWINGS AND SPECIFICATIONS
SHALL REMAIN THE PROPERTY OF MCI
COMMUNICATIONS SERVICES, INC. BOTH BEING
ISSUED IN STRICT CONFIDENCE AND SHALL NOT BE
REPRODUCED, COPIED, OR USED FOR ANY PURPOSE
WITHOUT SPECIFIC WRITTEN PERMISSION.

SCALE


HORIZONTAL: 1"=30'

VERTICAL: NA

MP TO MP

SHEET 10 OF 15


LSV CASHMAN FIELD REV.
FILE: 01-10-18

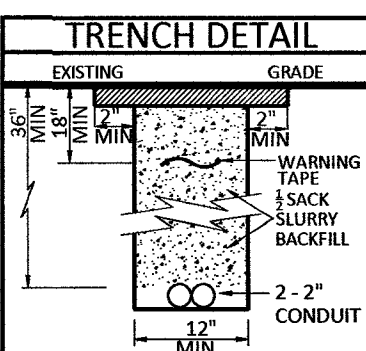



Replot

RTC NOTES:	
BACKFILL AND RIGHT OF WAY RESTORATION SHALL CONFORM TO CLARK COUNTY UNIFORM STANDARD DRAWINGS	
(1) 500.1	0 TO 5 YEARS PAVEMENT RESTORATION LONGITUDINAL CUT
(2) 500.2	0 TO 5 YEARS PAVEMENT RESTORATION TRAVERSE CUT
(3) 500.3	OVER 5 YEARS PAVEMENT RESTORATION LONGITUDINAL CUT. GREATER THAN 60' R.O.W
(4) 500.4	OVER 5 YEARS PAVEMENT RESTORATION LONGITUDINAL CUT. 60' R.O.W OR LESS
(5) 500.5	OVER 5 YEARS PAVEMENT RESTORATION TRAVERSE ALL R.O.W WIDTHS
(6) 501	TYPICAL UNDERGROUND UTILITY LOCATIONS IN RESIDENTIAL STREETS 60' OR LESS R.O.W
(7) 501.1	TYPICAL UTILITY UNDERGROUND LOCATIONS IN STREETS WITH GREATER THAN 60' R.O.W
(8) 503	METHOD B FOR RIGID AND FLEXIBLE PIPE TRENCH BACKFILL - PAVED AREAS
(9) 503.1	METHOD A FOR FLEXIBLE PIPE TRENCH BACKFILL - PAVED AREAS
(10) 503.2	METHOD A FOR RIGID PIPE TRENCH BACKFILL - PAVED AREAS
(11) 234	SIDEWALK
(12) BACKFILL IN UNPAVED AREA AS REQUIRED BY LOCAL CODE OR AS APPROVED BY AGENCY.	

210	PLACE CONDUIT
212	PLACE HIGH DENSITY POLYETHYLENE (HDPE)
240	PLACE HANDHOLE
250	PLACE MANHOLE
270	REMOVE AND RESTORE ASPHALT
280	REMOVE AND RESTORE CONCRETE
281	REMOVE AND RESTORE SIDEWALK
282	REMOVE AND RESTORE CURBING
410	PULL CABLE
411	PULL THROUGH DUCT (INNERDUCT)
520	PLACE AERIAL CABLE
630	DIRECTIONAL BORE

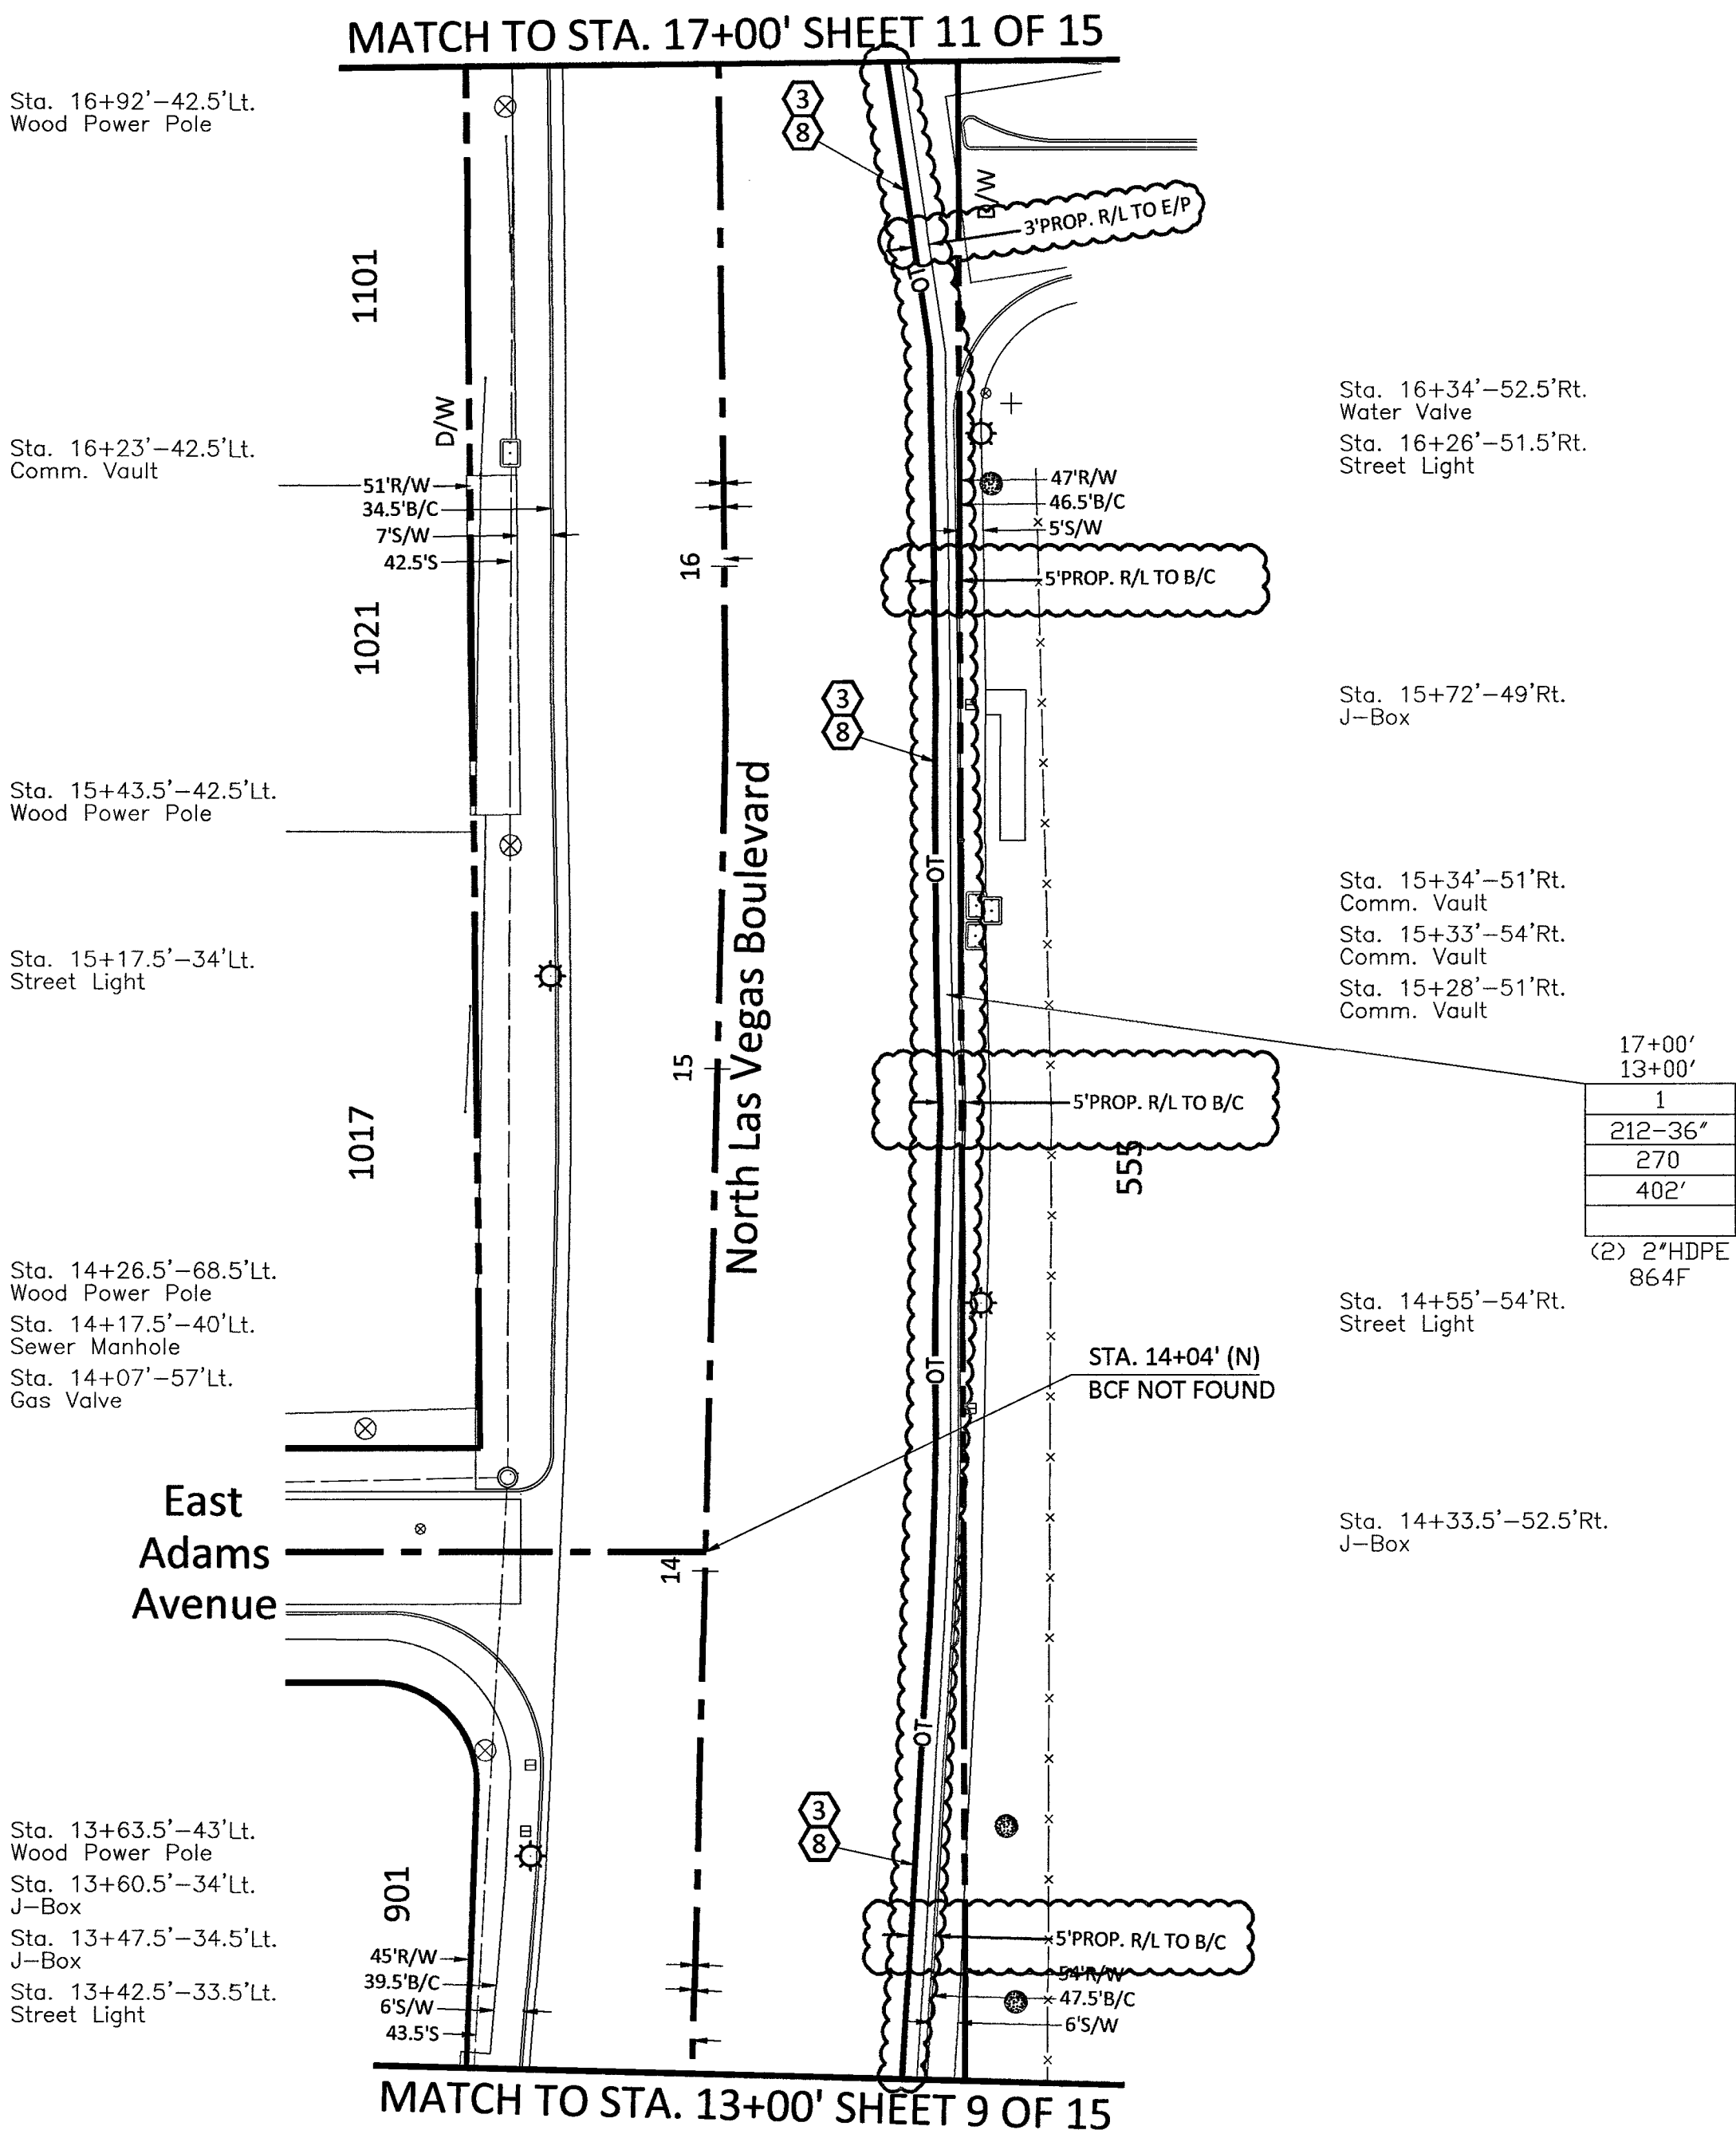

CONSTRUCTION DRAWING
CITY OF LAS VEGAS, NEVADA

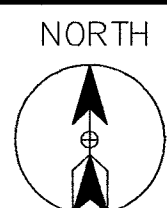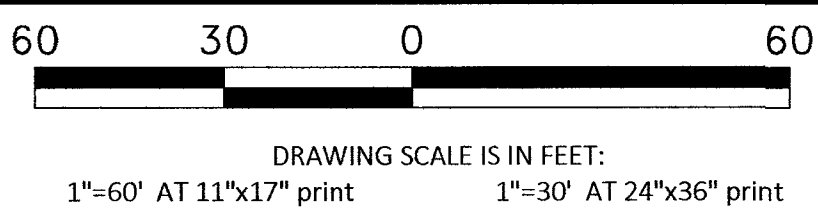

CELL SITE: LSV CASHMAN FIELD REV.
01-10-18

CITY OF LAS VEGAS, NEVADA

CLARIFICATION NO. QUANTITY

SHEET TOTAL	
2" HDPE CONDUIT:	814'
4" HDPE CONDUIT:	-
2' x 3' x 2' HANDHOLE(S):	-
2.5' x 5' x 2.5' HANDHOLE(S):	1
4' x 5' x 4' HANDHOLE(S):	-
MANHOLE(S):	-
AERIAL:	-
VZW CONDUIT:	-
3RD PARTY CONDUIT:	-
ASPHALT CUT:	-
TRENCH:	404'
BORE:	-
BORE/OPEN TRENCH:	-
TOTAL NEW UG FOOTAGE:	404'
TOTAL FOOTAGE:	404'

COMMUNICATIONS SERVICES, INC.
OUTSIDE PLANT CONSTRUCTION
TITLE: CELL SITE: LSV CASHMAN FIELD
REV. 01-10-18

DATE: 01/10/18

DRAWN BY: JJAMES

REVISIONS		
DATE	DESCRIPTION	INITIAL
12-12-18	UPDATE HH LOCATION SHT. 14 & RELOCATE R/L SHTS. 13 AND 14	EJR
01-10-18	MOVED R/L SHTS 10-13, ADJUSTED FOOTAGE SHTS 3, 13, 14	JJ
	PK 122 19	

EXCEPT AS MAY BE OTHERWISE PROVIDED BY
CONTRACT, THESE DRAWINGS AND SPECIFICATIONS
SHALL REMAIN THE PROPERTY OF MCI.
COMMUNICATIONS SERVICES, INC. BOTH BEING
ISSUED IN STRICT CONFIDENCE AND SHALL NOT BE
REPRODUCED, COPIED, OR USED FOR ANY PURPOSE
WITHOUT SPECIFIC WRITTEN PERMISSION.

SCALE

HORIZONTAL: 1"=30'

VERTICAL: NA




MP TO MP

SHEET 11 OF 15


FILE: LSV CASHMAN FIELD REV.
01-10-18

RTC NOTES:	
BACKFILL AND RIGHT OF WAY RESTORATION SHALL CONFORM TO CLARK COUNTY UNIFORM STANDARD DRAWINGS	
(1) 500.1	0 TO 5 YEARS PAVEMENT RESTORATION LONGITUDINAL CUT
(2) 500.2	0 TO 5 YEARS PAVEMENT RESTORATION TRAVERSE CUT
(3) 500.3	OVER 5 YEARS PAVEMENT RESTORATION LONGITUDINAL CUT, GREATER THAN 60' R.O.W
(4) 500.4	OVER 5 YEARS PAVEMENT RESTORATION LONGITUDINAL CUT, 60' R.O.W OR LESS
(5) 500.5	OVER 5 YEARS PAVEMENT RESTORATION TRAVERSE ALL R.O.W WIDTHS
(6) 501	TYPICAL UNDERGROUND UTILITY LOCATIONS IN RESIDENTIAL STREETS 60' OR LESS R.O.W
(7) 501.1	TYPICAL UTILITY UNDERGROUND LOCATIONS IN STREETS WITH GREATER THAN 60' R.O.W
(8) 503	METHOD B FOR RIGID AND FLEXIBLE PIPE TRENCH BACKFILL - PAVED AREAS
(9) 503.1	METHOD A FOR FLEXIBLE PIPE TRENCH BACKFILL - PAVED AREAS
(10) 503.2	METHOD A FOR RIGID PIPE TRENCH BACKFILL - PAVED AREAS
(11) 234	SIDEWALK
(12)	BACKFILL IN UNPAVED AREA AS REQUIRED BY LOCAL CODE OR AS APPROVED BY AGENCY.

210	PLACE CONDUIT
212	PLACE HIGH DENSITY POLYETHYLENE (HDPE)
240	PLACE HANDHOLE
250	PLACE MANHOLE
270	REMOVE AND RESTORE ASPHALT
280	REMOVE AND RESTORE CONCRETE
281	REMOVE AND RESTORE SIDEWALK
282	REMOVE AND RESTORE CURBING
410	PULL CABLE
411	PULL THROUGH DUCT (INNERDUCT)
520	PLACE AERIAL CABLE
630	DIRECTIONAL BORE

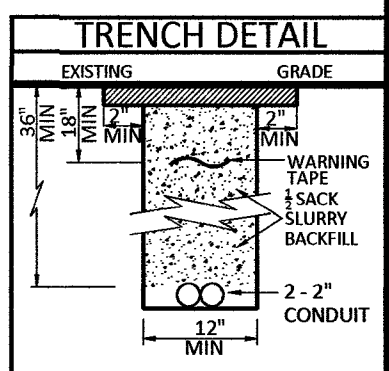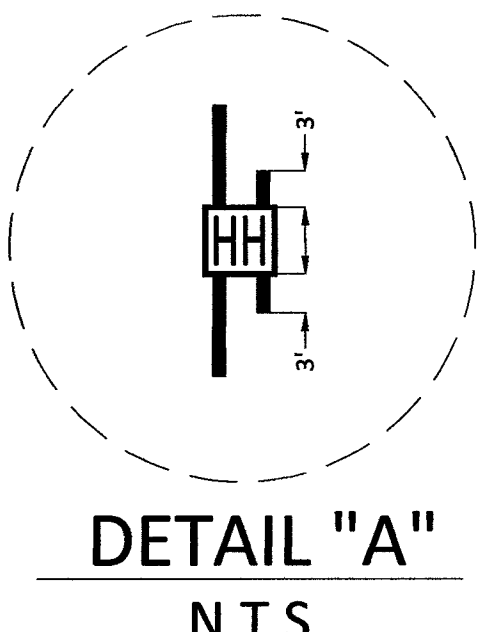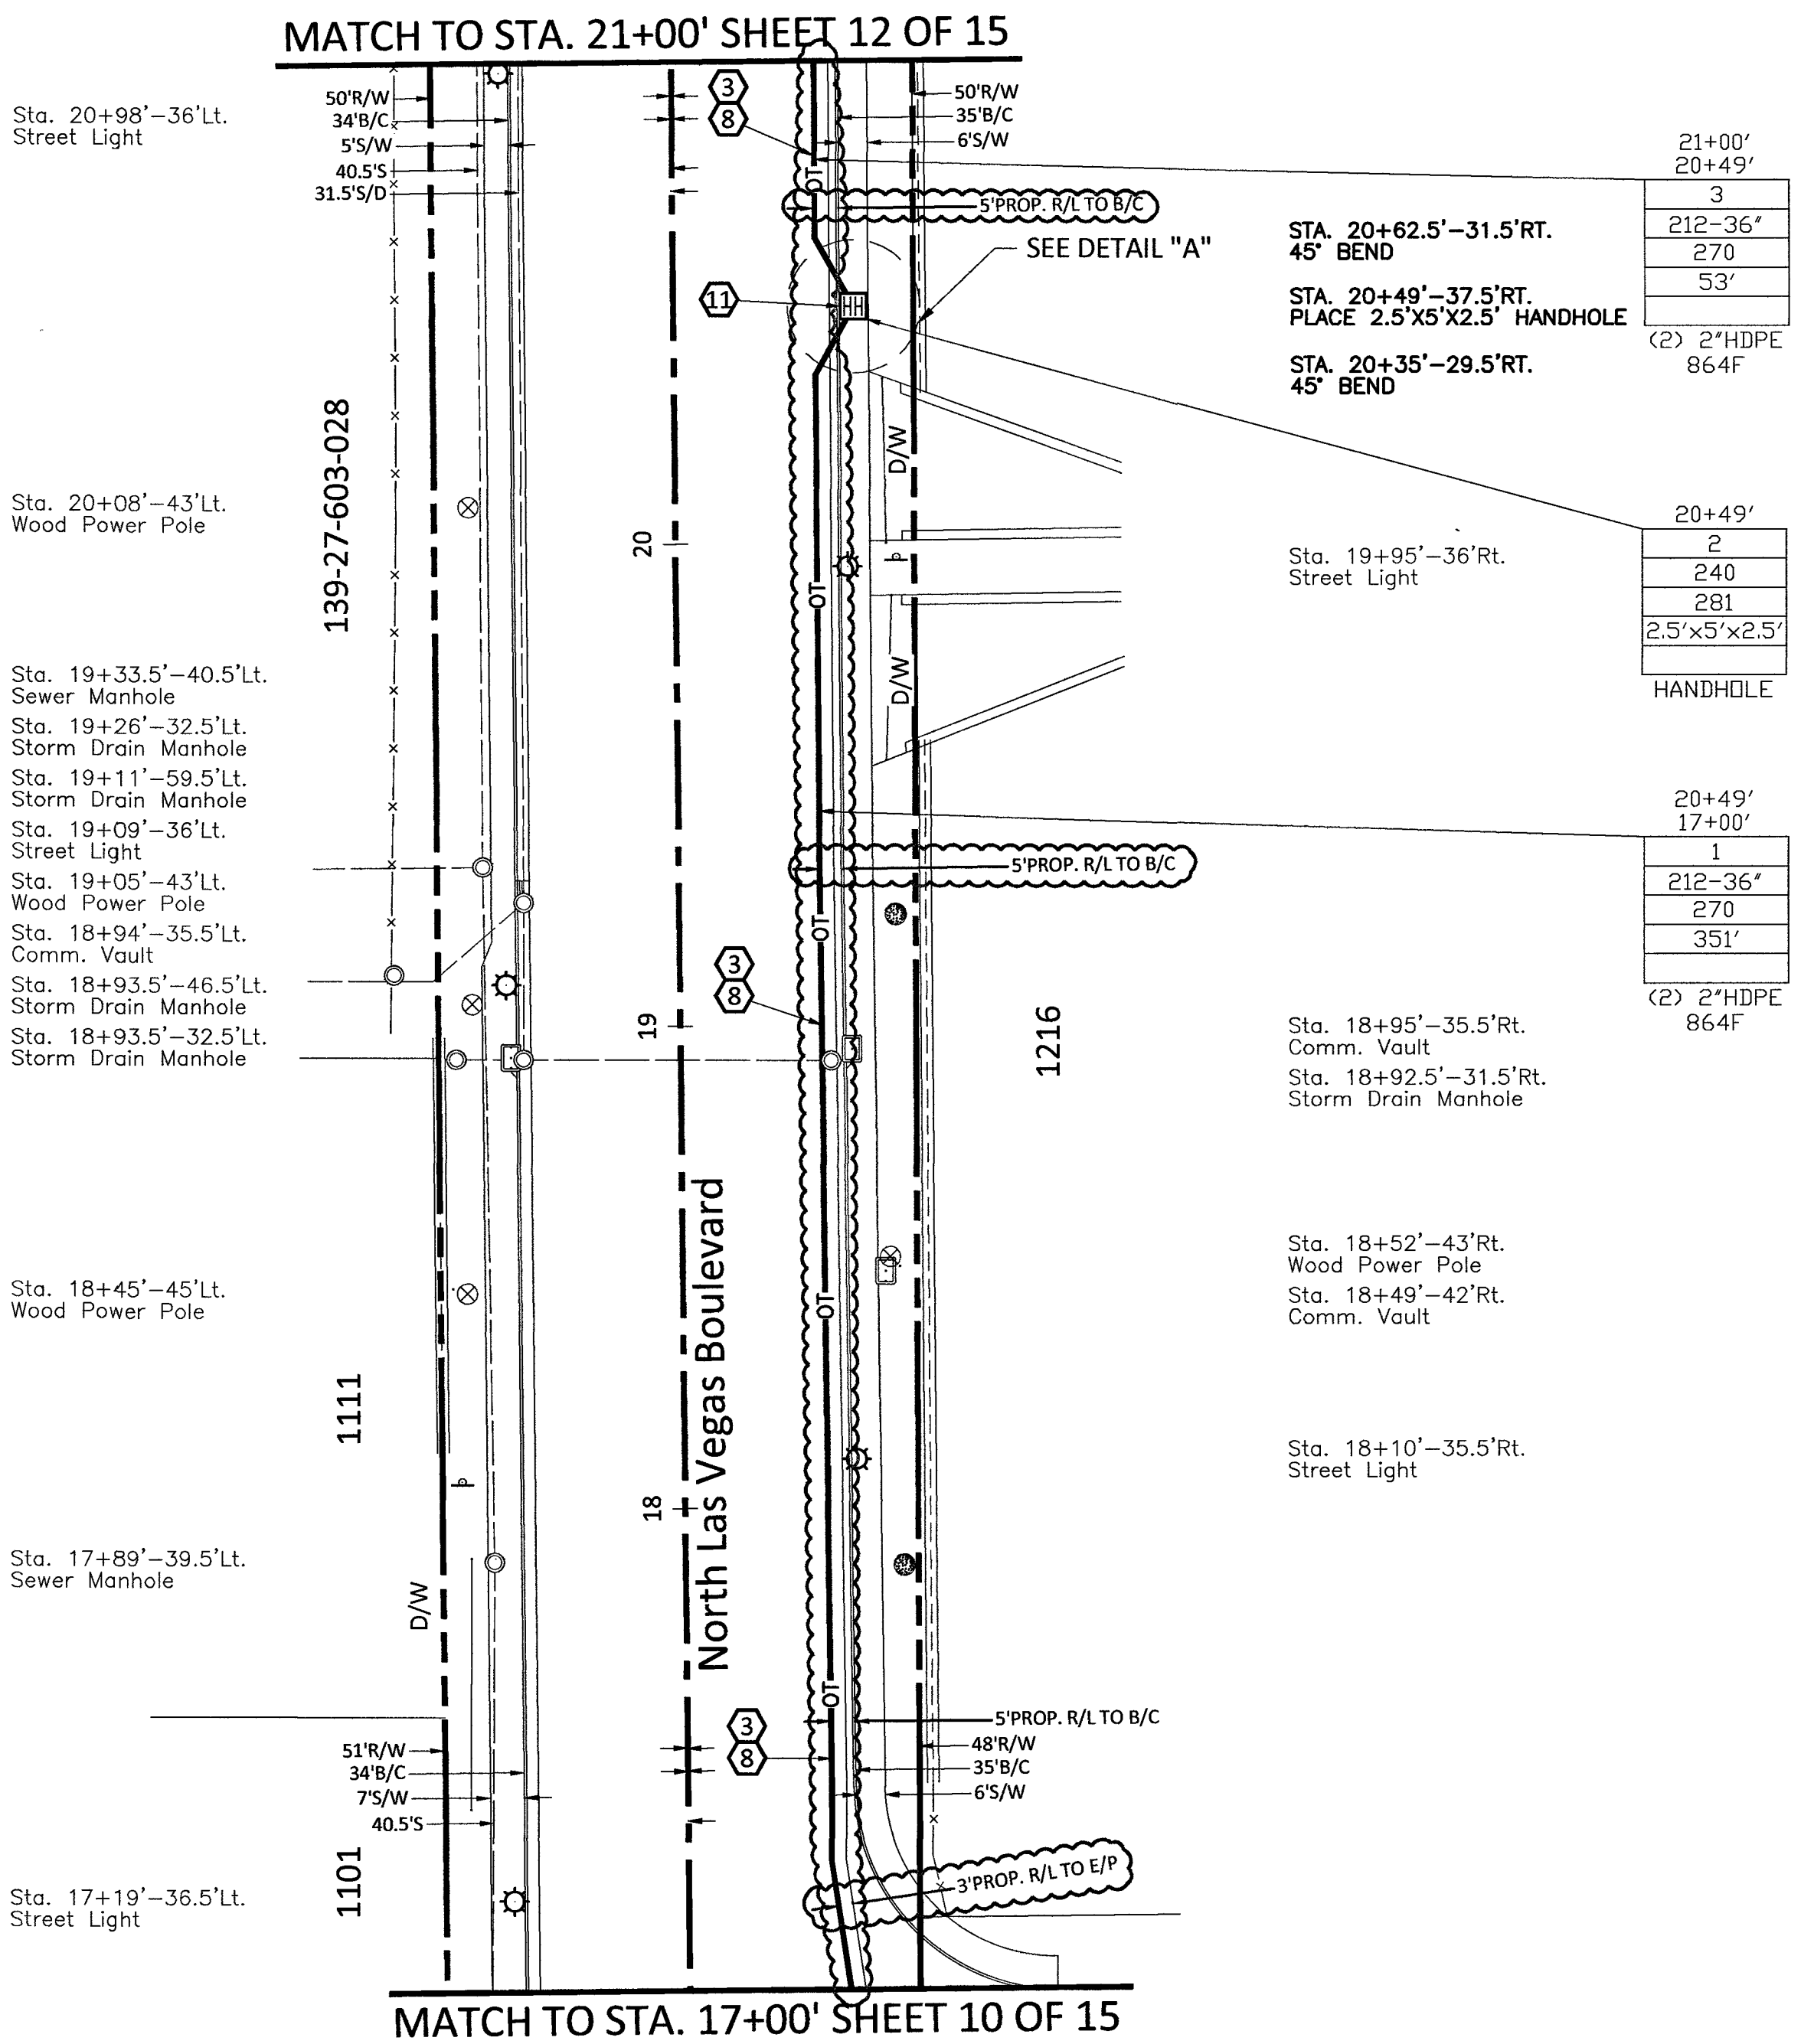


CONSTRUCTION DRAWING
CITY OF LAS VEGAS, NEVADA

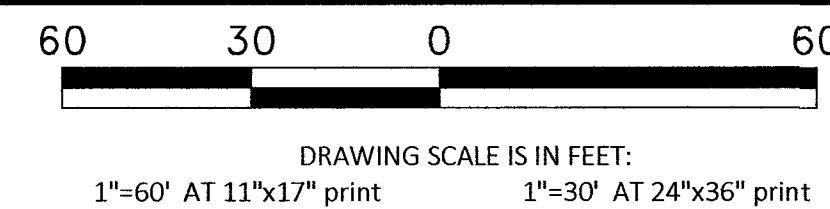

Call at least two full working days
before you begin excavation.

811 Know what's below.
Call 811 before you dig.

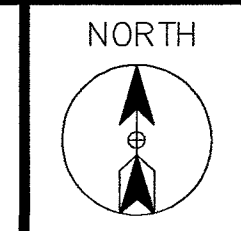

CELL SITE: LSV CASHMAN FIELD REV.
01-10-18

CITY OF LAS VEGAS, NEVADA

CLARIFICATION NO. QUANTITY

SHEET TOTAL

2" HDPE CONDUIT:	800'
4" HDPE CONDUIT:	-
2' x 3' x 2' HANDHOLE(S):	-
2.5' x 5' x 2.5' HANDHOLE(S):	-
4' x 5' x 4' HANDHOLE(S):	-
MANHOLE(S):	-
AERIAL:	-
VZW CONDUIT:	-
3RD PARTY CONDUIT:	-
ASPHALT CUT:	-
TRENCH:	400'
BORE:	-
BORE/OPEN TRENCH:	-
TOTAL NEW UG FOOTAGE:	400'
TOTAL FOOTAGE:	400'

MCI
COMMUNICATIONS SERVICES, INC.
OUTSIDE PLANT CONSTRUCTION
TITLE: CELL SITE: LSV CASHMAN FIELD
REV. 01-10-18

DATE: 01/10/18

DRAWN BY: JJAMES

REVISIONS

DATE	DESCRIPTION	INITIAL
12-12-18	UPDATE HH LOCATION SHT. 14 & RELOCATE R/L SHTS. 13 AND 14	EJR
01-10-18	MOVED R/L SHTS 10-13, ADJUSTED FOOTAGE SHTS 3, 13, 14	JJ
	PXC 1 22 19	

EXCEPT AS MAY BE OTHERWISE PROVIDED BY
CONTRACT, THESE DRAWINGS AND SPECIFICATIONS
SHALL REMAIN THE PROPERTY OF MCI
COMMUNICATIONS SERVICES, INC. BOTH BEING
ISSUED IN STRICT CONFIDENCE AND SHALL NOT BE
REPRODUCED, COPIED, OR USED FOR ANY PURPOSE,
WITHOUT SPECIFIC WRITTEN PERMISSION.

SCALE

HORIZONTAL: 1"=30'


VERTICAL: NA

MP TO MP

SHEET 12 OF 15

LSV CASHMAN FIELD REV.
FILE: 01-10-18

MATCH TO STA. 25+00' SHEET 13 OF 15

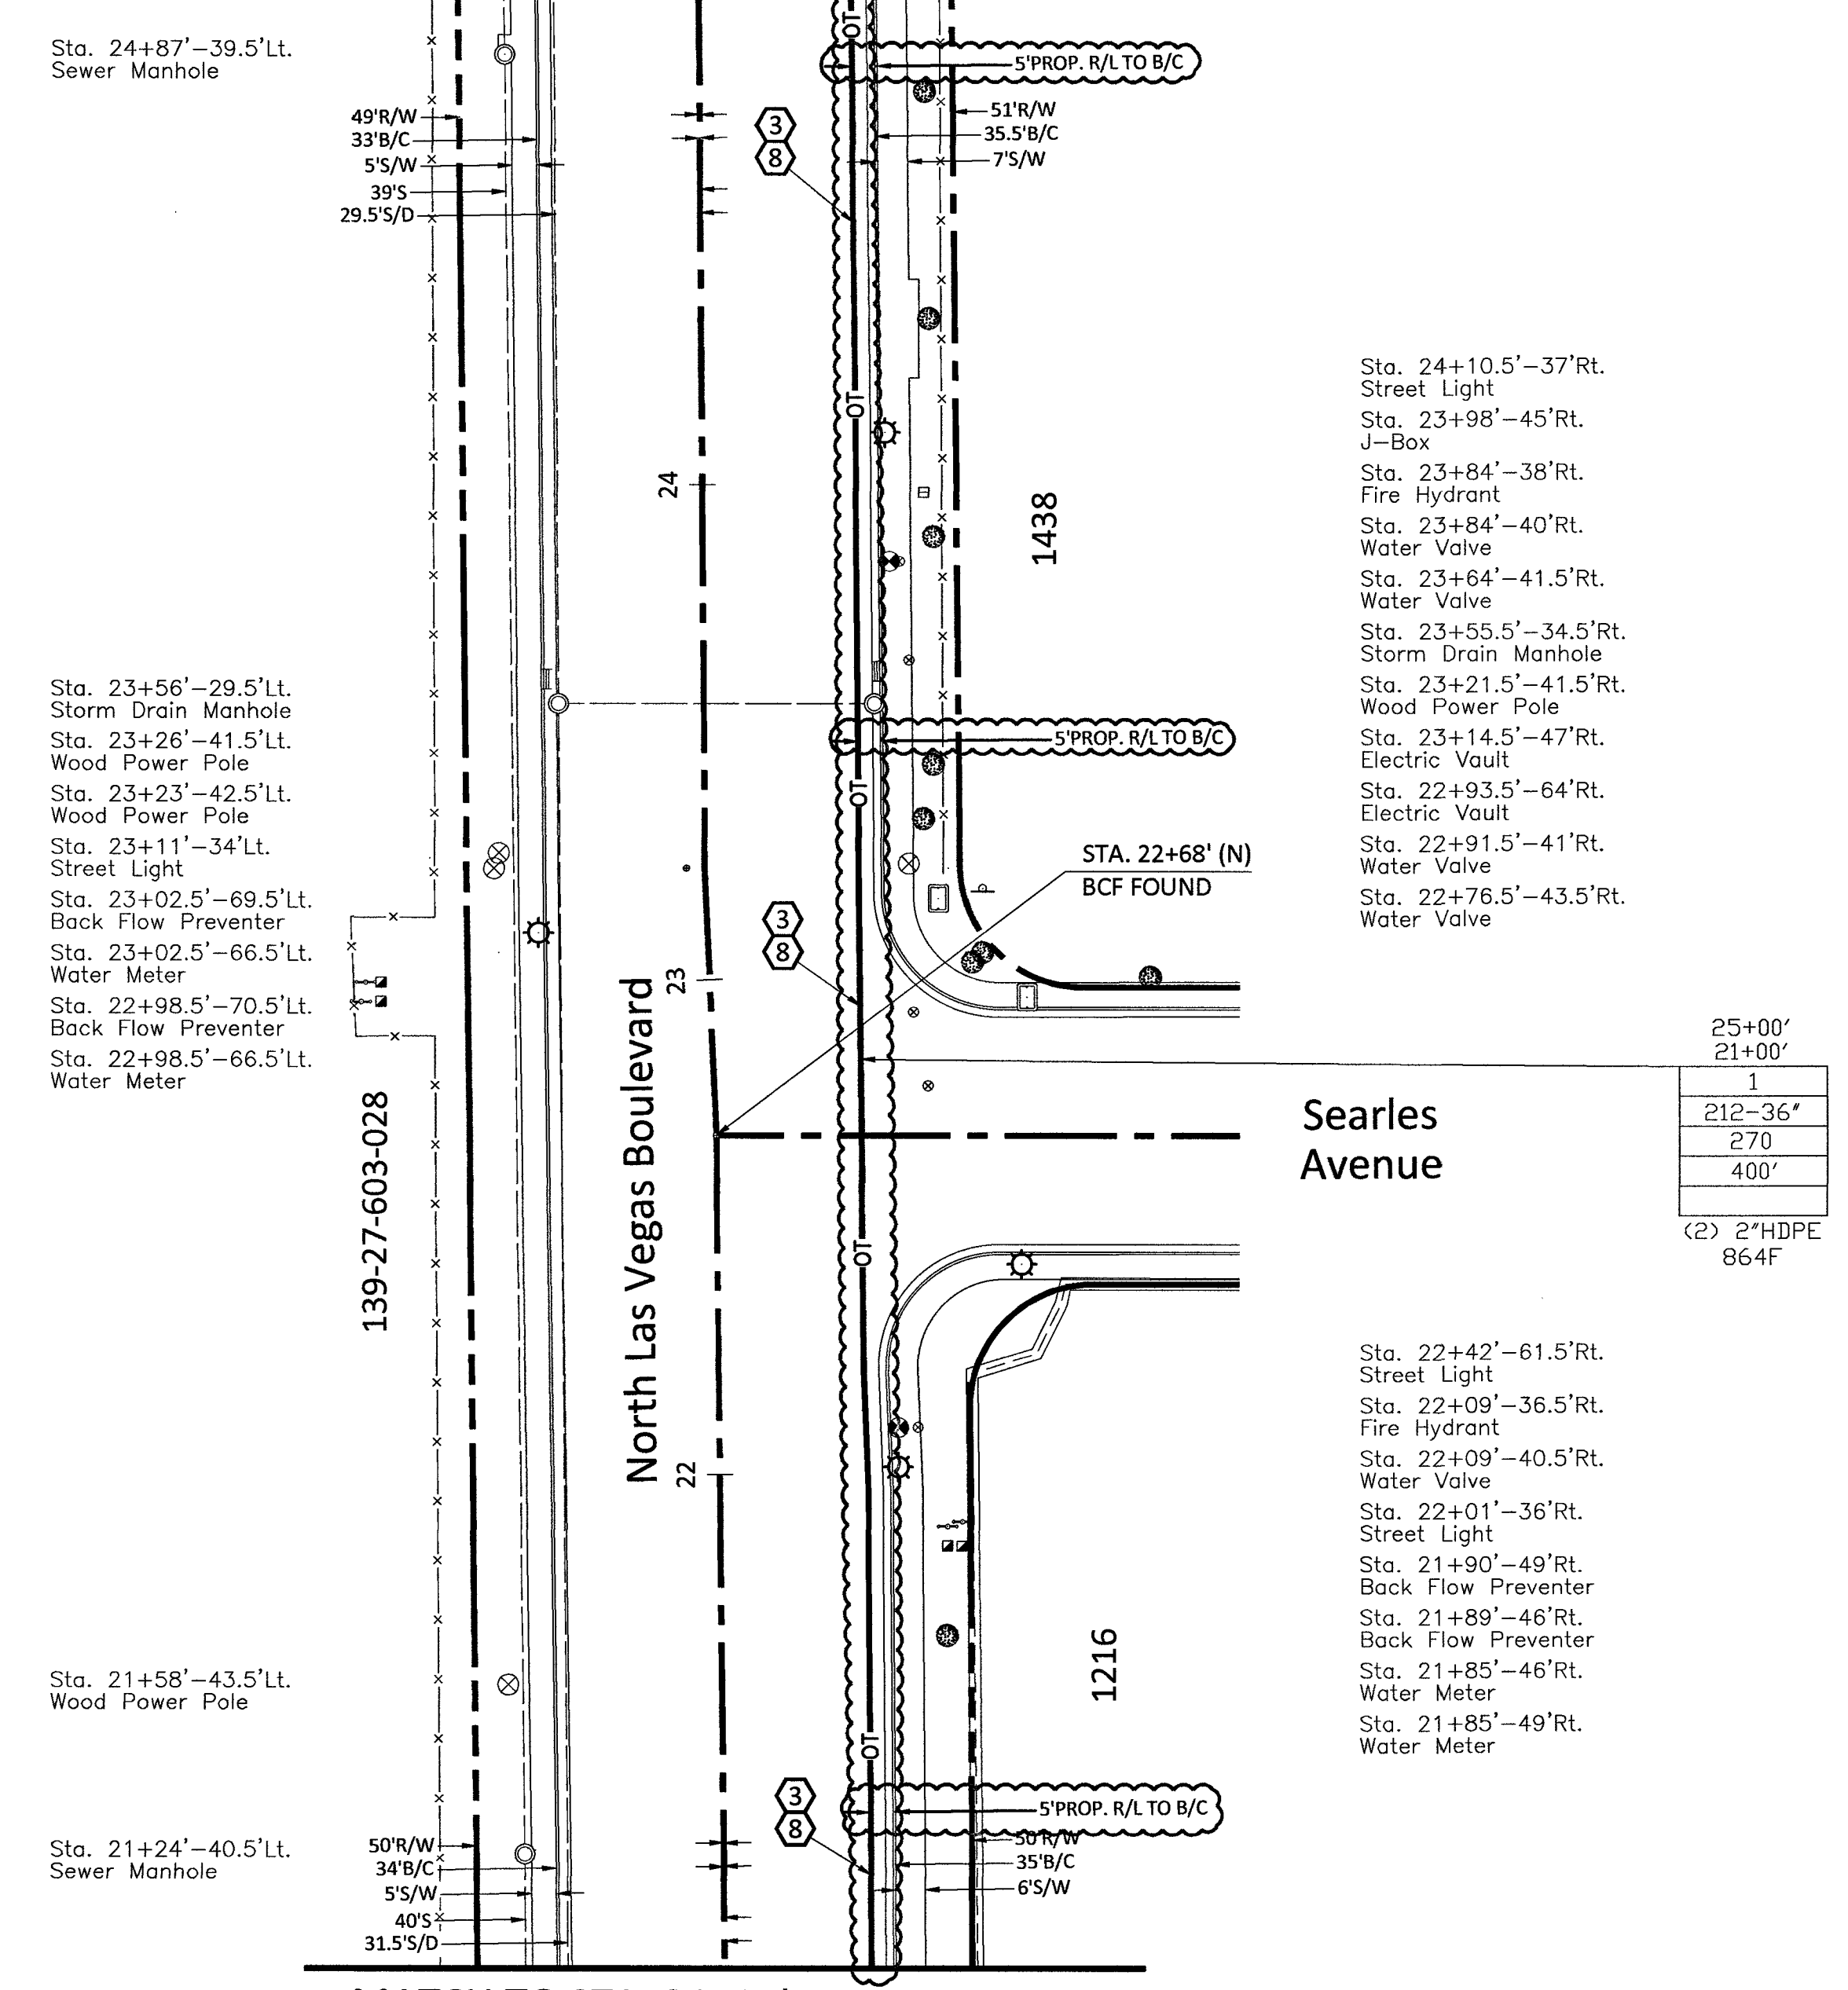


MATCH TO STA. 21+00' SHEET 11 OF 15

RTC NOTES:

BACKFILL AND RIGHT OF WAY RESTORATION SHALL CONFORM TO CLARK COUNTY
UNIFORM STANDARD DRAWINGS

1	500.1	0 TO 5 YEARS PAVEMENT RESTORATION LONGITUDINAL CUT
2	500.2	0 TO 5 YEARS PAVEMENT RESTORATION TRAVERSE CUT
3	500.3	OVER 5 YEARS PAVEMENT RESTORATION LONGITUDINAL CUT, GREATER THAN 60' R.O.W
4	500.4	OVER 5 YEARS PAVEMENT RESTORATION LONGITUDINAL CUT, 60' R.O.W OR LESS
5	500.5	OVER 5 YEARS PAVEMENT RESTORATION TRAVERSE ALL R.O.W WIDTHS
6	501	TYPICAL UNDERGROUND UTILITY LOCATIONS IN RESIDENTIAL STREETS 60' OR LESS R.O.W
7	501.1	TYPICAL UTILITY UNDERGROUND LOCATIONS IN STREETS WITH GREATER THAN 60' R.O.W
8	503	METHOD B FOR RIGID AND FLEXIBLE PIPE TRENCH BACKFILL - PAVED AREAS
9	503.1	METHOD A FOR FLEXIBLE PIPE TRENCH BACKFILL - PAVED AREAS
10	503.2	METHOD A FOR RIGID PIPE TRENCH BACKFILL - PAVED AREAS
11	234	SIDEWALK
12		BACKFILL IN UNPAVED AREA AS REQUIRED BY LOCAL CODE OR AS APPROVED BY AGENCY.



210	PLACE CONDUIT
212	PLACE HIGH DENSITY POLYETHYLENE (HDPE)
240	PLACE HANDHOLE
250	PLACE MANHOLE
270	REMOVE AND RESTORE ASPHALT
280	REMOVE AND RESTORE CONCRETE
281	REMOVE AND RESTORE SIDEWALK
282	REMOVE AND RESTORE CURBING
410	PULL CABLE
411	PULL THROUGH DUCT (INNERDUCT)
520	PLACE AERIAL CABLE
630	DIRECTIONAL BORE

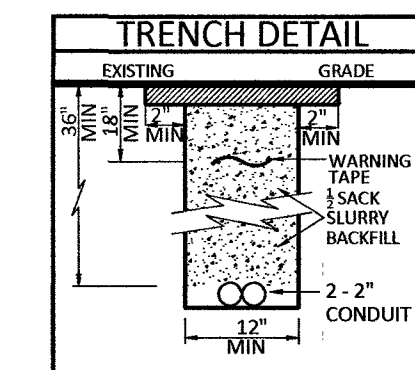

M:\VENISON\ONEFIBER\LAS VEGAS\LSV FOREMASTER\LSV CASHMAN FIELD\CONSTRUCTION DRAWINGS

M:\VERIZON ONEFIBER\LAS VEGAS\LSV FOREMASTER\LSV CASHMAN FIELD\CONSTRUCTION DRAWINGS

CONSTRUCTION DRAWING
CITY OF LAS VEGAS, NEVADA

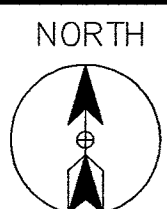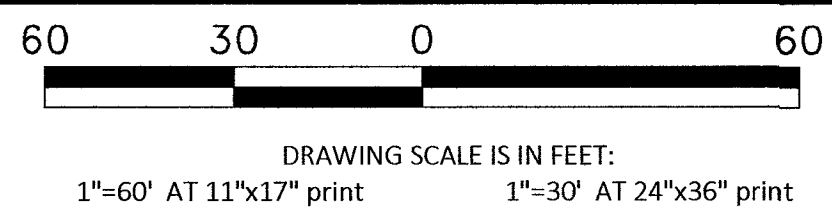

Call at least two full working days
before you begin excavation.



PROJECT: 916055, 916056, 916117

CELL SITE: LSV CASHMAN FIELD REV.
01-10-18
CITY OF LAS VEGAS, NEVADA

CLARIFICATION NO. QUANTITY

SHEET TOTAL	
2" HDPE CONDUIT:	714'
4" HDPE CONDUIT:	-
2' x 3' x 2' HANDHOLE(S):	-
2.5' x 5' x 2.5' HANDHOLE(S):	1
4' x 4' x 4' HANDHOLE(S):	-
MANHOLE(S):	-
AERIAL:	-
VZW CONDUIT:	-
3RD PARTY CONDUIT:	-
ASPHALT CUT:	-
TRENCH:	357'
BORE:	-
BORE/OPEN TRENCH:	-
TOTAL NEW UG FOOTAGE:	357'
TOTAL FOOTAGE:	357'

MCI
COMMUNICATIONS SERVICES, INC.
OUTSIDE PLANT CONSTRUCTION

TITLE: CELL SITE: LSV CASHMAN FIELD
REV. 01-10-18

DATE: 01/10/18
DRAWN BY: JJAMES

REVISIONS		
DATE	DESCRIPTION	INITIAL
12-12-18	UPDATE HH LOCATION SHT. 14 & RELOCATE R/L SHTS. 13 AND 14	EJR
01-10-18	MOVED R/L SHTS 10-13, ADJUSTED FOOTAGE SHTS 3, 13, 14	JJ

EXCEPT AS MAY BE OTHERWISE PROVIDED BY
CONTRACT, THESE DRAWINGS AND SPECIFICATIONS
SHALL REMAIN THE PROPERTY OF MCI
COMMUNICATIONS SERVICES, INC. BOTH BEING
ISSUED IN STRICT CONFIDENCE AND SHALL NOT BE
REPRODUCED, COPIED, OR USED FOR ANY PURPOSE
WITHOUT SPECIFIC WRITTEN PERMISSION.

SCALE

HORIZONTAL: 1"=30'


VERTICAL: NA

MP TO MP

SHEET 14 OF 15

FILE: LSV CASHMAN FIELD REV. 01-10-18

MATCH TO STA. 55+00' SHEET 13 OF 15

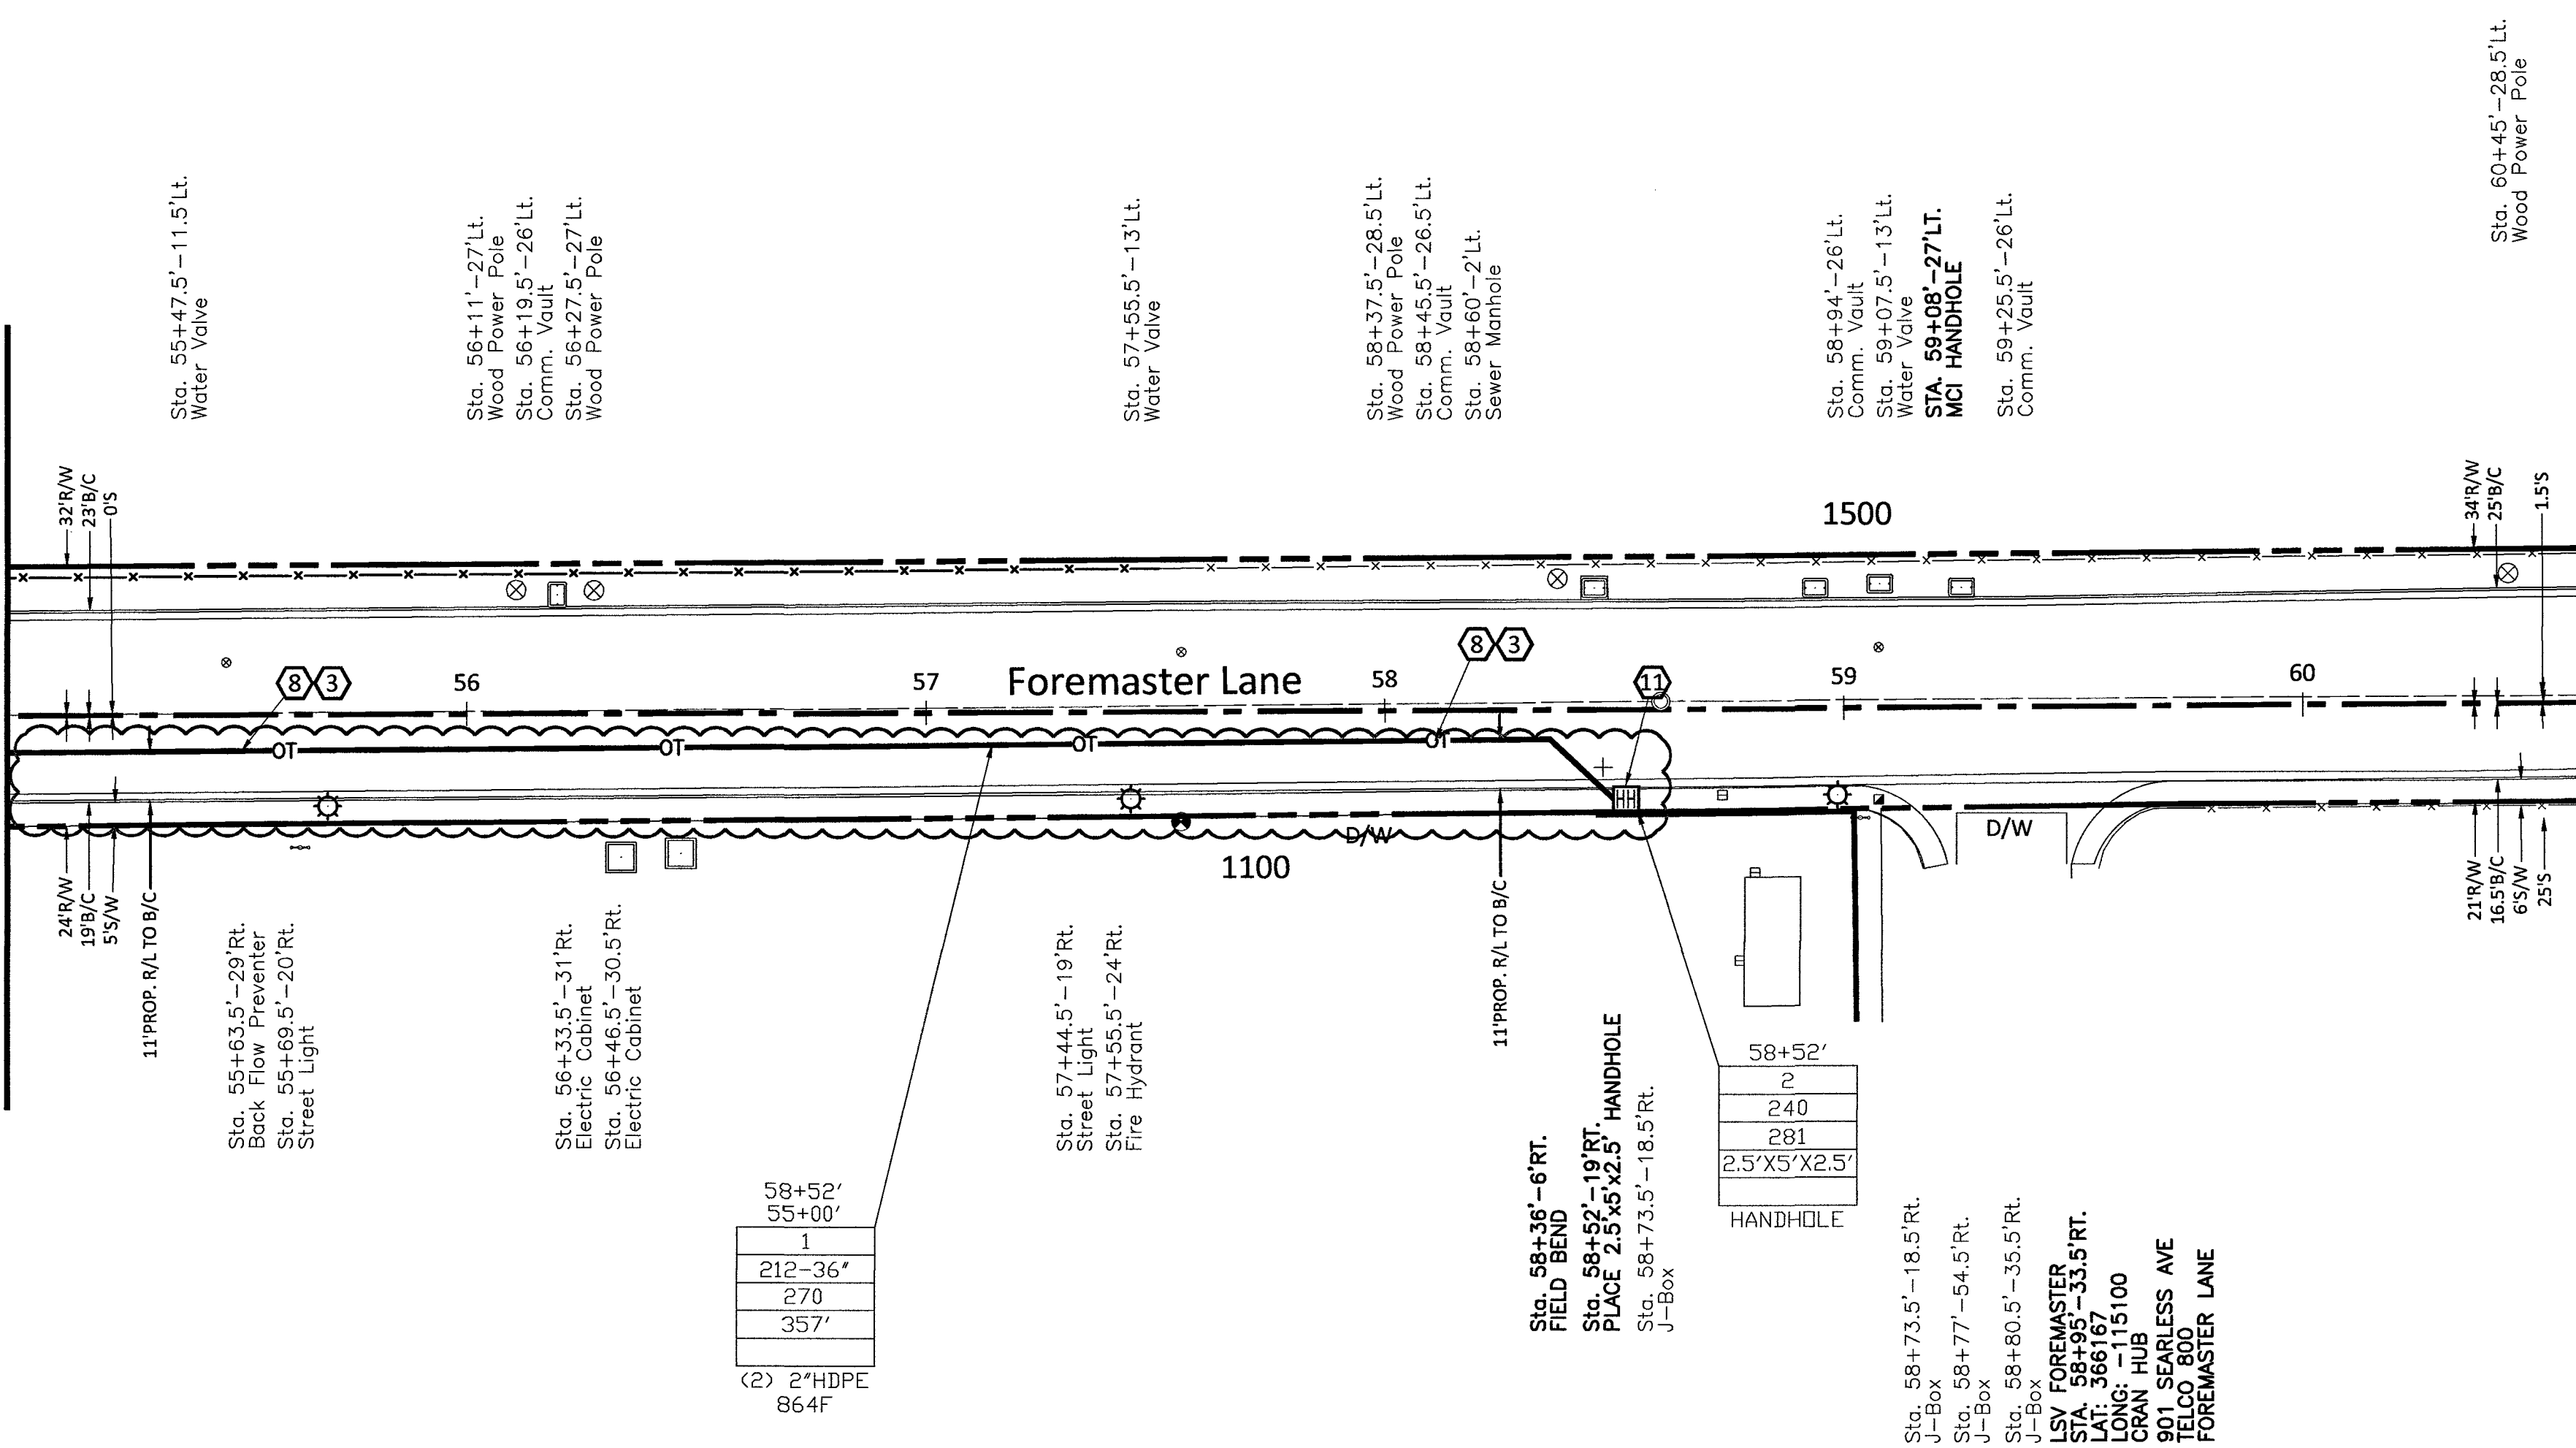

RTC NOTES:

BACKFILL AND RIGHT OF WAY RESTORATION SHALL CONFORM TO CLARK COUNTY
UNIFORM STANDARD DRAWINGS


(1)	500.1	0 TO 5 YEARS PAVEMENT RESTORATION LONGITUDINAL CUT
(2)	500.2	0 TO 5 YEARS PAVEMENT RESTORATION TRAVERSE CUT
(3)	500.3	OVER 5 YEARS PAVEMENT RESTORATION LONGITUDINAL CUT, GREATER THAN 60' R.O.W
(4)	500.4	OVER 5 YEARS PAVEMENT RESTORATION LONGITUDINAL CUT, 60' R.O.W OR LESS
(5)	500.5	OVER 5 YEARS PAVEMENT RESTORATION TRAVERSE ALL R.O.W WIDTHS
(6)	501	TYPICAL UNDERGROUND UTILITY LOCATIONS IN RESIDENTIAL STREETS 60' OR LESS R.O.W
(7)	501.1	TYPICAL UTILITY UNDERGROUND LOCATIONS IN STREETS WITH GREATER THAN 60' R.O.W
(8)	503	METHOD B FOR RIGID AND FLEXIBLE PIPE TRENCH BACKFILL - PAVED AREAS
(9)	503.1	METHOD A FOR FLEXIBLE PIPE TRENCH BACKFILL - PAVED AREAS
(10)	503.2	METHOD A FOR RIGID PIPE TRENCH BACKFILL - PAVED AREAS
(11)	234	SIDEWALK
(12)		BACKFILL IN UNPAVED AREA AS REQUIRED BY LOCAL CODE OR AS APPROVED BY AGENCY.

NOTE TO CONTRACTOR:
CONTRACTOR TO POTHOLE AND LOCATE ALL
UTILITIES PRIOR TO STARTING CONSTRUCTION.

CONTRACTOR TO PLACE LOCATE WIRE AND
MULE TAPE IN ALL CONDUIT PLACED

CONTRACTOR TO PLACE CONDUIT IN
APPROXIMATE LOCATION SHOWN ON PLAN
& PROVIDE AS-BUILTS WITH SPECIFIC TIE
LOCATION

- 210 PLACE CONDUIT
- 212 PLACE HIGH DENSITY POLYETHYLENE (HDPE)
- 240 PLACE HANDHOLE
- 250 PLACE MANHOLE
- 270 REMOVE AND RESTORE ASPHALT
- 280 REMOVE AND RESTORE CONCRETE
- 281 REMOVE AND RESTORE SIDEWALK
- 282 REMOVE AND RESTORE CURBING
- 410 PULL CABLE
- 411 PULL THROUGH DUCT (INNERDUCT)
- 520 PLACE AERIAL CABLE
- 630 DIRECTIONAL BORE

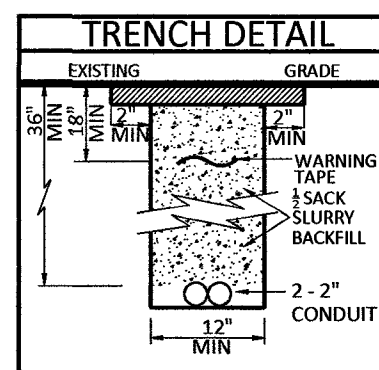


Repro

ROUTE SCHEMATIC

Call at least two full working days
before you begin excavation.

811 Know what's below.
Call 811 before you dig.

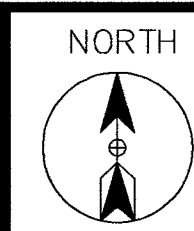

CELL SITE: LSV CASHMAN FIELD REV.
01-10-18

CITY OF LAS VEGAS, NEVADA

CLARIFICATION NO. QUANTITY

FIBER TOTALS

FIBER SIZE/LENGTH: 864F/4,561'

COMMUNICATIONS SERVICES, INC.
OUTSIDE PLANT CONSTRUCTION
TITLE: CELL SITE: LSV CASHMAN FIELD
REV. 01-10-18
PROJECT TITLE


DATE: 01/10/18

DRAWN BY: JJAMES

REVISIONS		
DATE	DESCRIPTION	INITIAL
12-12-18	UPDATE HH LOCATION SHT. 14 & RELOCATE R/L SHTS. 13 AND 14	EJR
01-10-18	MOVED R/L SHTS 10-13, ADJUSTED FOOTAGE SHTS 3, 13, 14	JJ
PK 1 22 19		

EXCEPT AS MAY BE OTHERWISE PROVIDED BY
CONTRACT, THESE DRAWINGS AND SPECIFICATIONS
SHALL REMAIN THE PROPERTY OF MCI
COMMUNICATIONS SERVICES, INC. BOTH BEING
ISSUED IN STRICT CONFIDENCE AND SHALL NOT BE
REPRODUCED, COPIED, OR USED FOR ANY PURPOSE
WITHOUT SPECIFIC WRITTEN PERMISSION.

SCALE
HORIZONTAL: 1"=30'
VERTICAL: NA
MP TO MP
SHEET 15 OF 15
FILE: LSV CASHMAN FIELD REV.
01-10-18

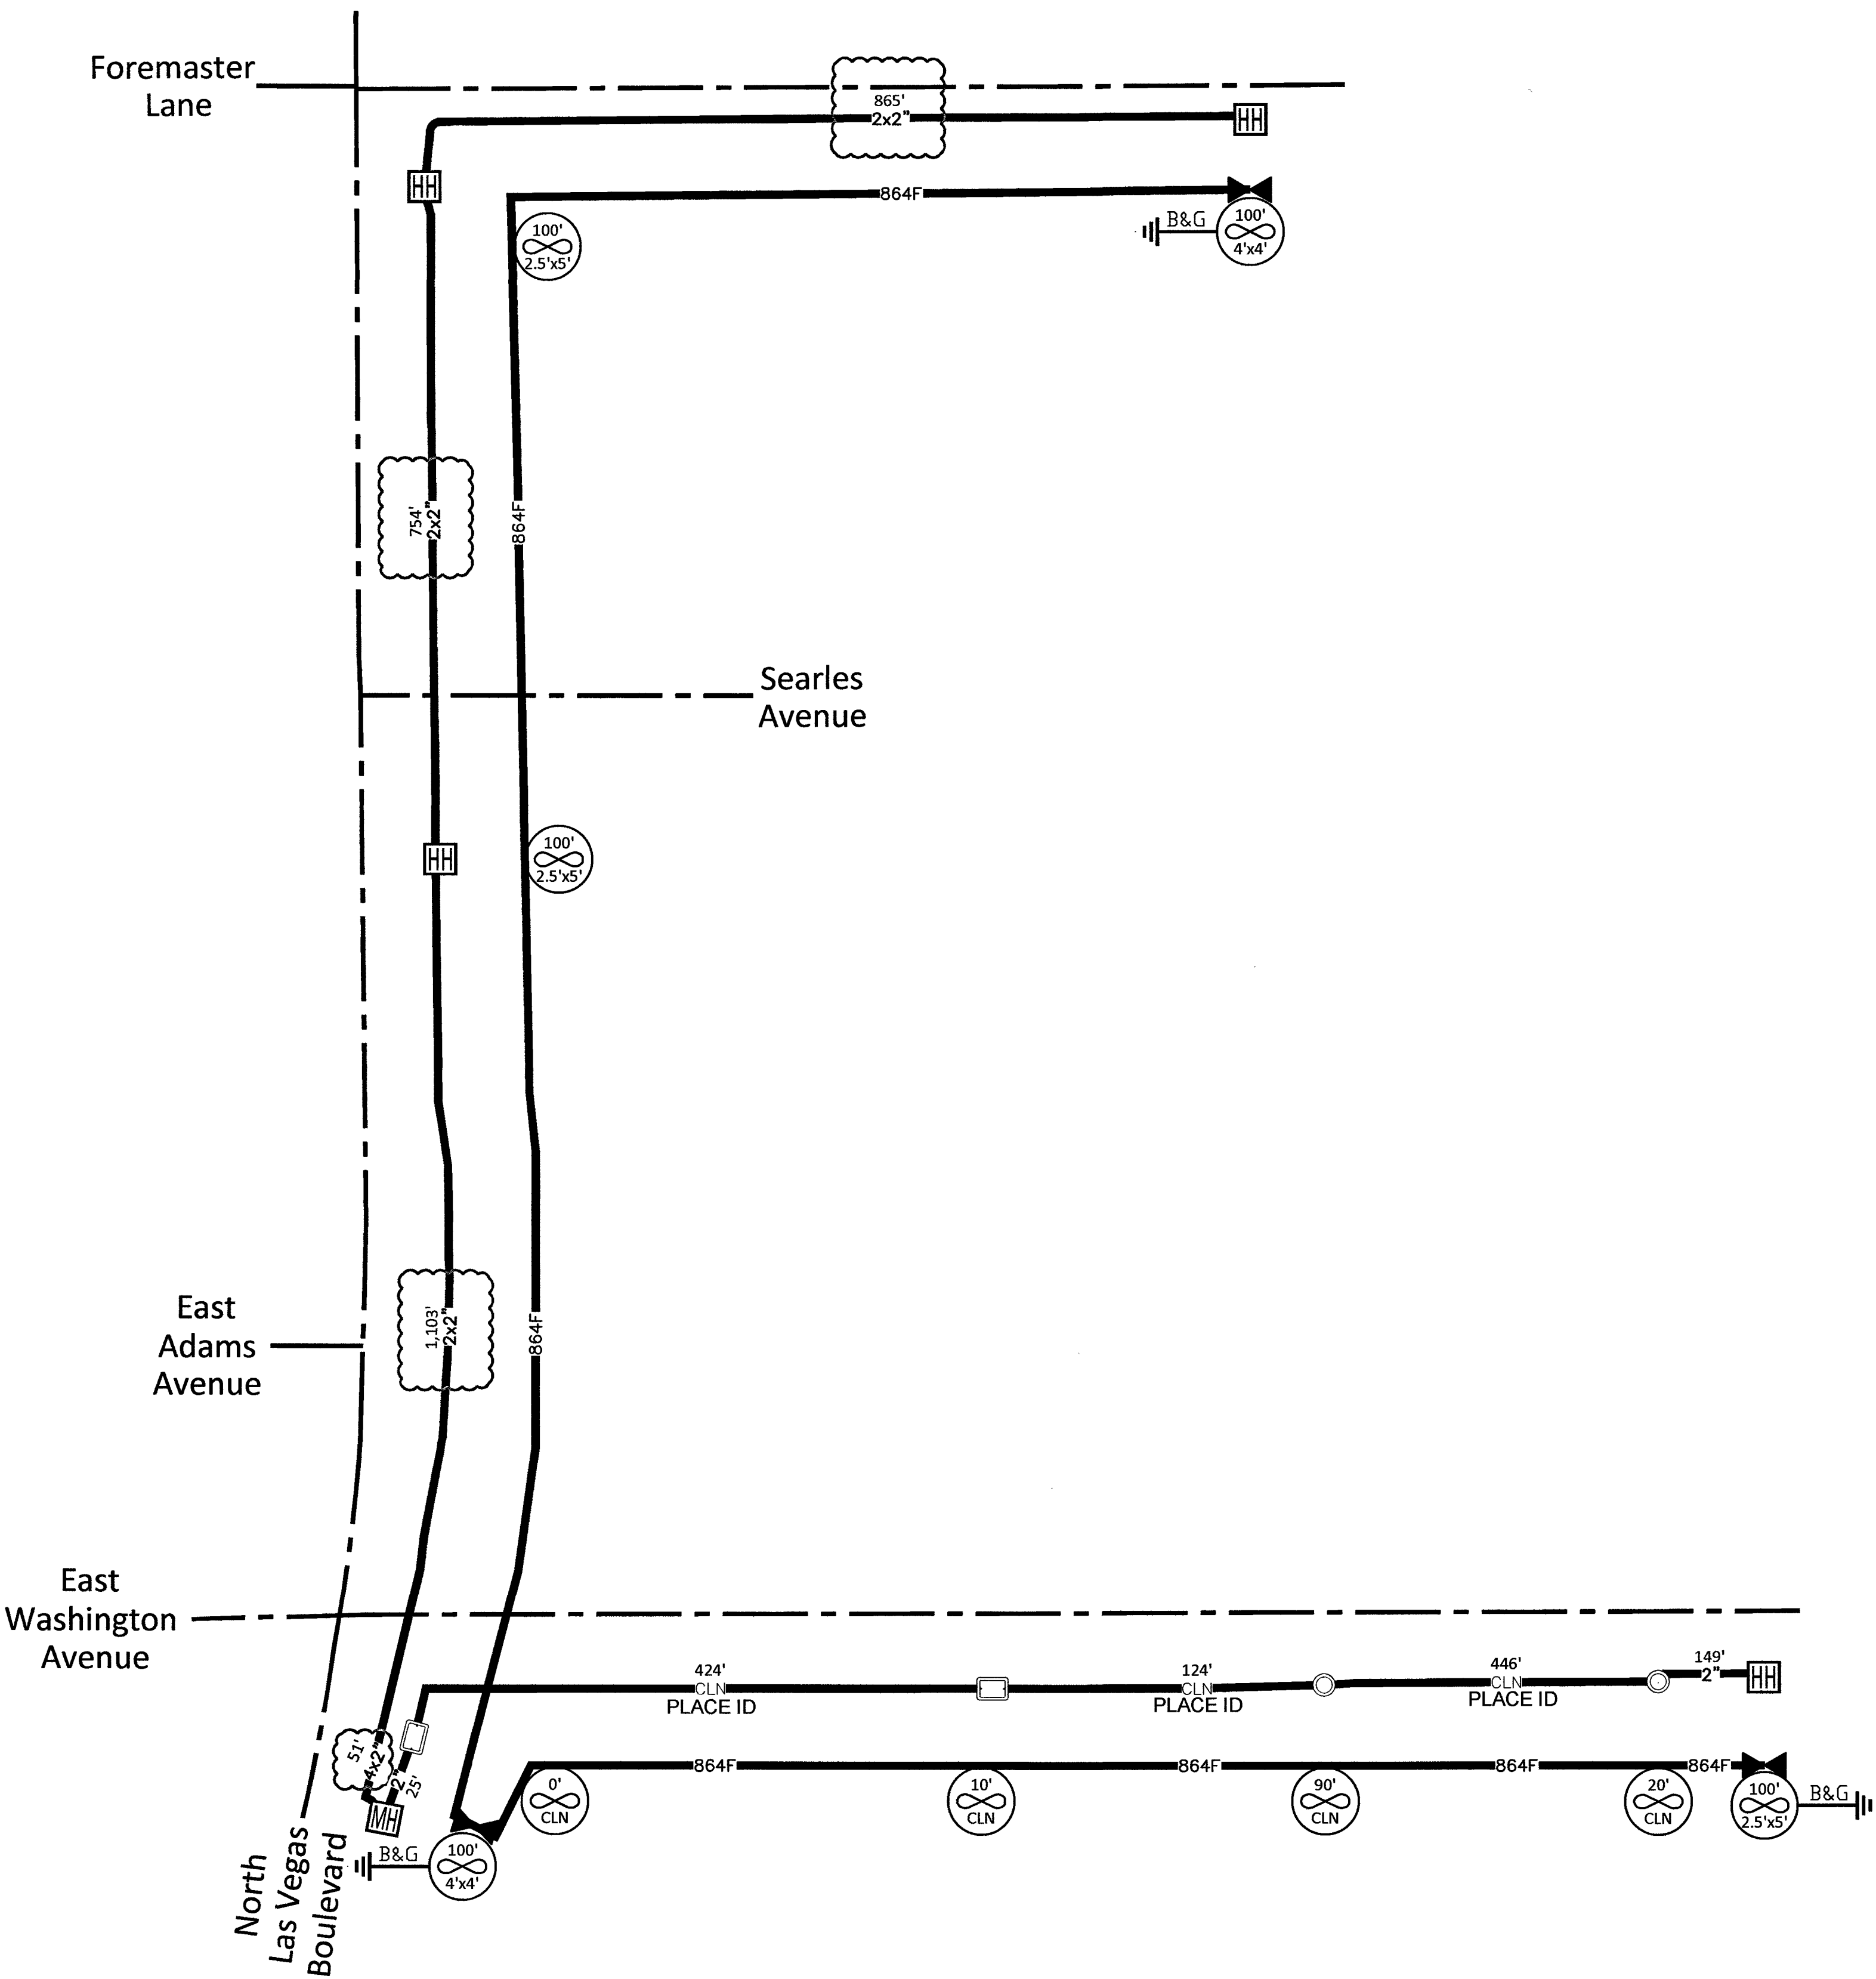


SITE-SPAN NAME: CELL SITE: LSV CASHMAN FIELD Rev. 01-10-18									
SITE-SPAN ID: 1708APXX.004									
FQID	SEGMENT	FIBER COUNT	TRENCH	BORE	DB/OT	3RD PARTY	VZ OWNED	AERIAL	TOTAL
FIB:BUR::56001067	916055	864F	2,798'	'	'	'	'	'	2,798'
FIB:BUR::56000333	916056	864F	'	'	'	994'	'	'	994'
FIB:BUR::56000333	916117	864F	149'	'	'	'	'	'	149'

REPLAT

MAVERICK ONE FIBER LAS VEGAS LAS VEGAS FOREMASTER (LSV CASHMAN FIELD) CONSTRUCTION DRAWINGS

ROUTE SCHEMATIC

Call at least two full working days
before you begin excavation.
811 Know what's below.
Call 811 before you dig.

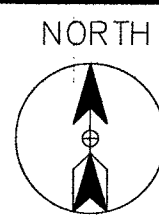

PROJECT: 916055, 916056,
916117
CELL SITE: LSV CASHMAN FIELD
CITY OF LAS VEGAS, NEVADA

CLARIFICATION NO. QUANTITY

FIBER TOTALS

FIBER SIZE/LENGTH: 864F/4,577'

MCI
COMMUNICATIONS SERVICES, INC.

OUTSIDE PLANT CONSTRUCTION

TITLE: CELL SITE: LSV CASHMAN FIELD

PROJECT TITLE

DATE: 7/18/2018

DRAWN BY: ERAMSEY

REVISIONS

DATE	INITIAL

EXCEPT AS MAY BE OTHERWISE PROVIDED BY
CONTRACT, THESE DRAWINGS AND SPECIFICATIONS
SHALL REMAIN THE PROPERTY OF MCI
COMMUNICATIONS SERVICES, INC. BOTH BEING
ISSUED IN STRICT CONFIDENCE AND SHALL NOT BE
REPRODUCED, COPIED, OR USED FOR ANY PURPOSE
WITHOUT SPECIFIC WRITTEN PERMISSION.

SCALE

HORIZONTAL: 1"=30'


VERTICAL: NA

MP TO MP

SHEET 15 OF 15

FILE: LSV CASHMAN FIELD

SITE-SPAN NAME: CELL SITE: LSV CASHMAN FIELD									
SITE-SPAN ID: 1708APXX.004									
FQID	SEGMENT	FIBER COUNT	TRENCH	BORE	DB/OT	3RD PARTY	VZ OWNED	AERIAL	TOTAL
FIB:BUR::56001067	916055	864F	2,812'	'	'	'	'	'	'
FIB:BUR::56000333	916056	864F	'	'	'	996'	'	'	'
FIB:BUR::56000333	916117	864F	149'	'	'	'	'	'	'
FQID #	#	F	'	'	'	'	'	'	'
FQID #	#	F	'	'	'	'	'	'	'
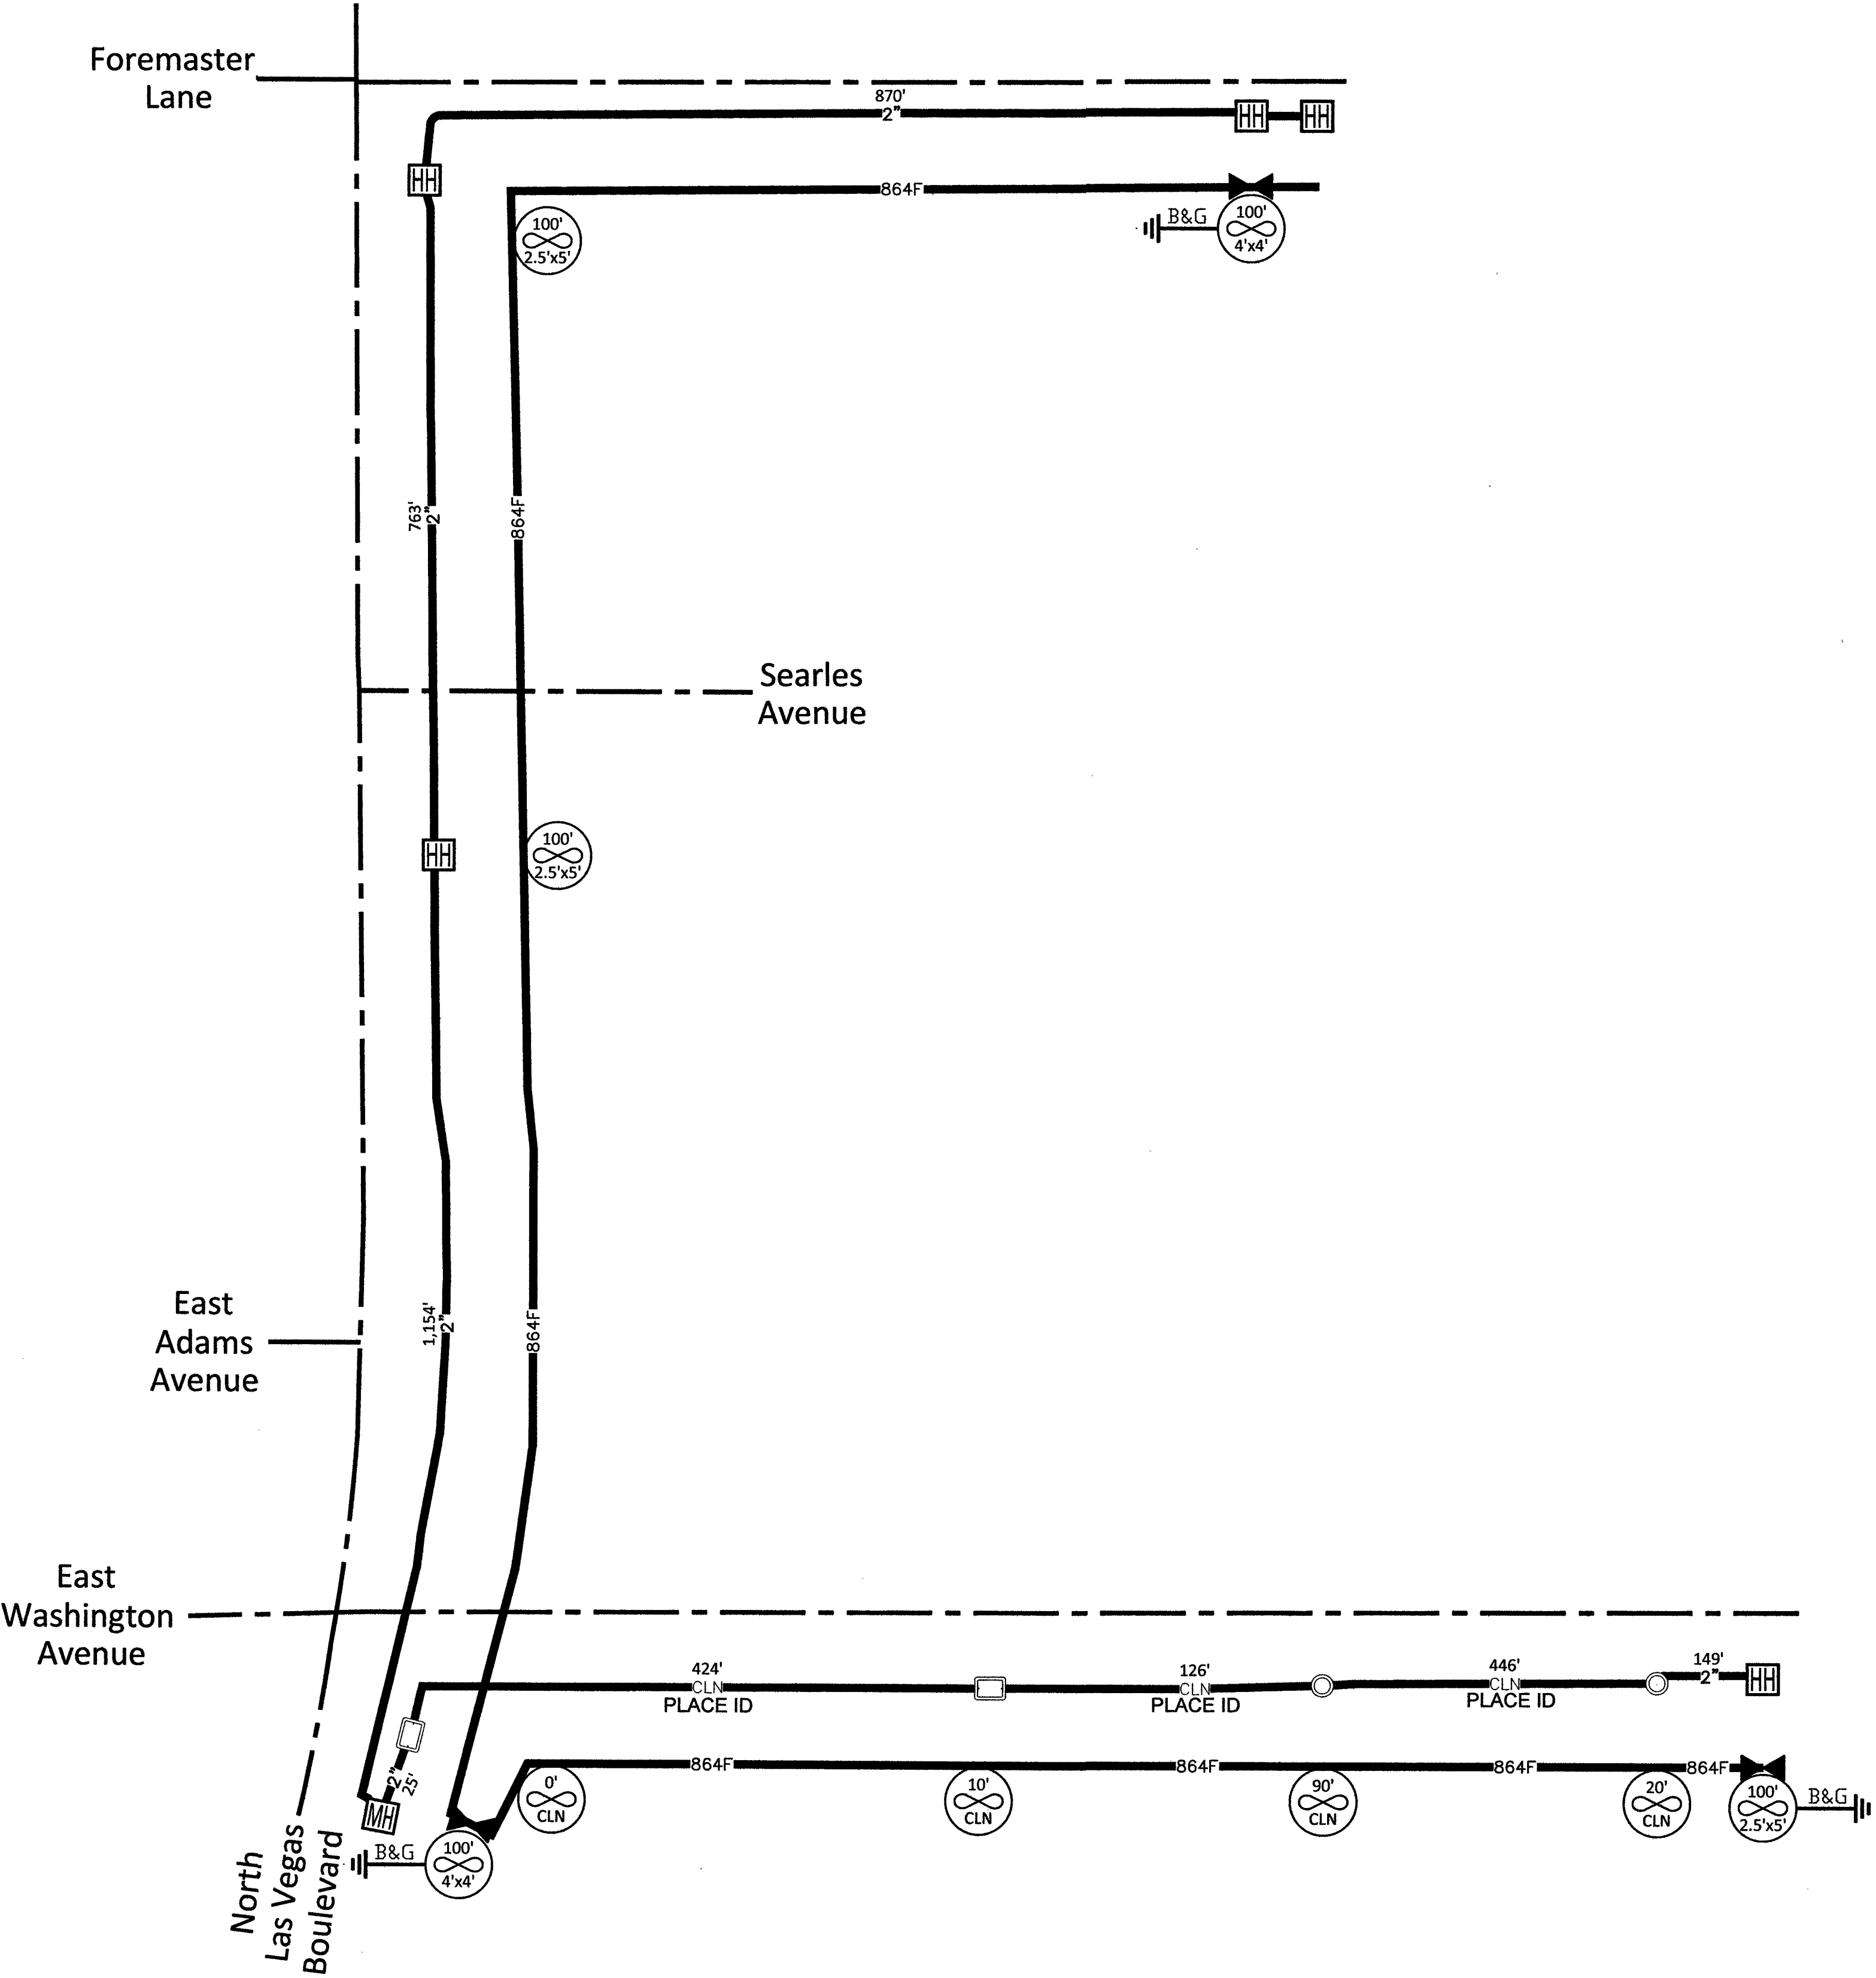

M:\VERIZON ONE\FIBER\LAS VEGAS\LSV FOREMASTER\LSV CASHMAN FIELD\CONSTRUCTION DRAWINGS