

CONSTRUCTION DRAWING

CITY OF LAS VEGAS, NEVADA

60 30 0 60

DRAWING SCALE IS IN FEET:
1"=60' AT 11"x17" print 1"=30' AT 24"x36" print

Call at least two full working days
before you begin excavation.



Know what's below.
Call 811 before you dig.



CELL SITE: LSV HUALAPAI BACK HAUL
901005, 901006, 901008 - REV
07-05-19

CITY OF LAS VEGAS, NEVADA

CLARIFICATION NO. QUANTITY

SHEET TOTAL

2" HDPE CONDUIT:	675'
2.5" HDPE CONDUIT:	-
4" HDPE CONDUIT:	-
2' x 3' x 2' HANDHOLE(S):	-
2.5' x 5' x 2.5' HANDHOLE(S):	2
4' x 5' x 4' HANDHOLE(S):	-
MANHOLE(S):	-
AERIAL:	-
VZW CONDUIT:	-
3RD PARTY CONDUIT:	182'
TRENCH:	340'
TOTAL NEW UG FOOTAGE:	340'
TOTAL FOOTAGE:	522'

MCI
COMMUNICATIONS SERVICES, INC.

OUTSIDE PLANT CONSTRUCTION

TITLE: CELL SITE: LSV HUALAPAI BACK
HAUL 901005, 901006, 901008 - REV
07-05-19

DATE: 7/5/2019

DRAWN BY: JJAMES

REVISIONS

DATE	DESCRIPTION	INITIAL
07-05-19	CHANGED UG R/L & ADDED HH (SHEET 15) UPDATED FOOTAGES (SHEET 3, 15, 16) UPDATED SCHEMATIC (SHEET 16)	JJ

EXCEPT AS MAY BE OTHERWISE PROVIDED BY
CONTRACT, THESE DRAWINGS AND SPECIFICATIONS
SHALL REMAIN THE PROPERTY OF MCI
COMMUNICATIONS SERVICES, INC. BOTH BEING
ISSUED IN STRICT CONFIDENCE AND SHALL NOT BE
REPRODUCED, COPIED, OR USED FOR ANY PURPOSE
WITHOUT SPECIFIC WRITTEN PERMISSION.

SCALE

HORIZONTAL: 1"=30'

VERTICAL: NA

MP TO MP

SHEET 15 OF 16



LSV HUALAPAI LSV BACK HAUL
FILE: 901005, 901006, 901008 - REV
07-05-19

RTC NOTES:

BACKFILL AND RIGHT OF WAY RESTORATION SHALL CONFORM TO CLARK COUNTY
UNIFORM STANDARD DRAWINGS

500.1	0 TO 5 YEARS PAVEMENT RESTORATION LONGITUDINAL CUT
500.2	0 TO 5 YEARS PAVEMENT RESTORATION TRAVERSE CUT
500.3	OVER 5 YEARS PAVEMENT RESTORATION LONGITUDINAL CUT, GREATER THAN 60' R.O.W
500.4	OVER 5 YEARS PAVEMENT RESTORATION LONGITUDINAL CUT, 60' R.O.W OR LESS
500.5	OVER 5 YEARS PAVEMENT RESTORATION TRAVERSE ALL R.O.W WIDTHS
501	TYPICAL UNDERGROUND UTILITY LOCATIONS IN RESIDENTIAL STREETS 60' OR LESS R.O.W
501.1	TYPICAL UTILITY UNDERGROUND LOCATIONS IN STREETS WITH GREATER THAN 60' R.O.W
503	METHOD B FOR RIGID AND FLEXIBLE PIPE TRENCH BACKFILL - PAVED AREAS
503.1	METHOD A FOR FLEXIBLE PIPE TRENCH BACKFILL - PAVED AREAS
503.2	METHOD A FOR RIGID PIPE TRENCH BACKFILL - PAVED AREAS
234	SIDEWALK
12	BACKFILL IN UNPAVED AREA AS REQUIRED BY LOCAL CODE OR AS APPROVED BY AGENCY.

210	PLACE CONDUIT
212	PLACE HIGH DENSITY POLYETHYLENE (HDPE)
240	PLACE HANDHOLE
250	PLACE MANHOLE
270	REMOVE AND RESTORE ASPHALT
280	REMOVE AND RESTORE CONCRETE
281	REMOVE AND RESTORE SIDEWALK
282	REMOVE AND RESTORE CURBING
410	PULL CABLE
411	PULL THROUGH DUCT (INNERDUCT)
520	PLACE AERIAL CABLE
630	DIRECTIONAL BORE

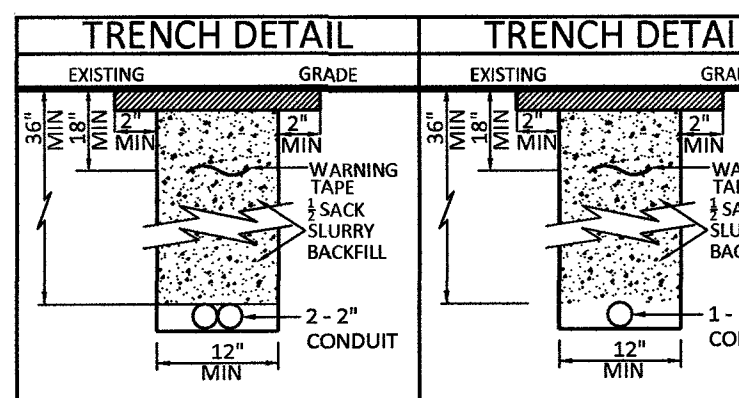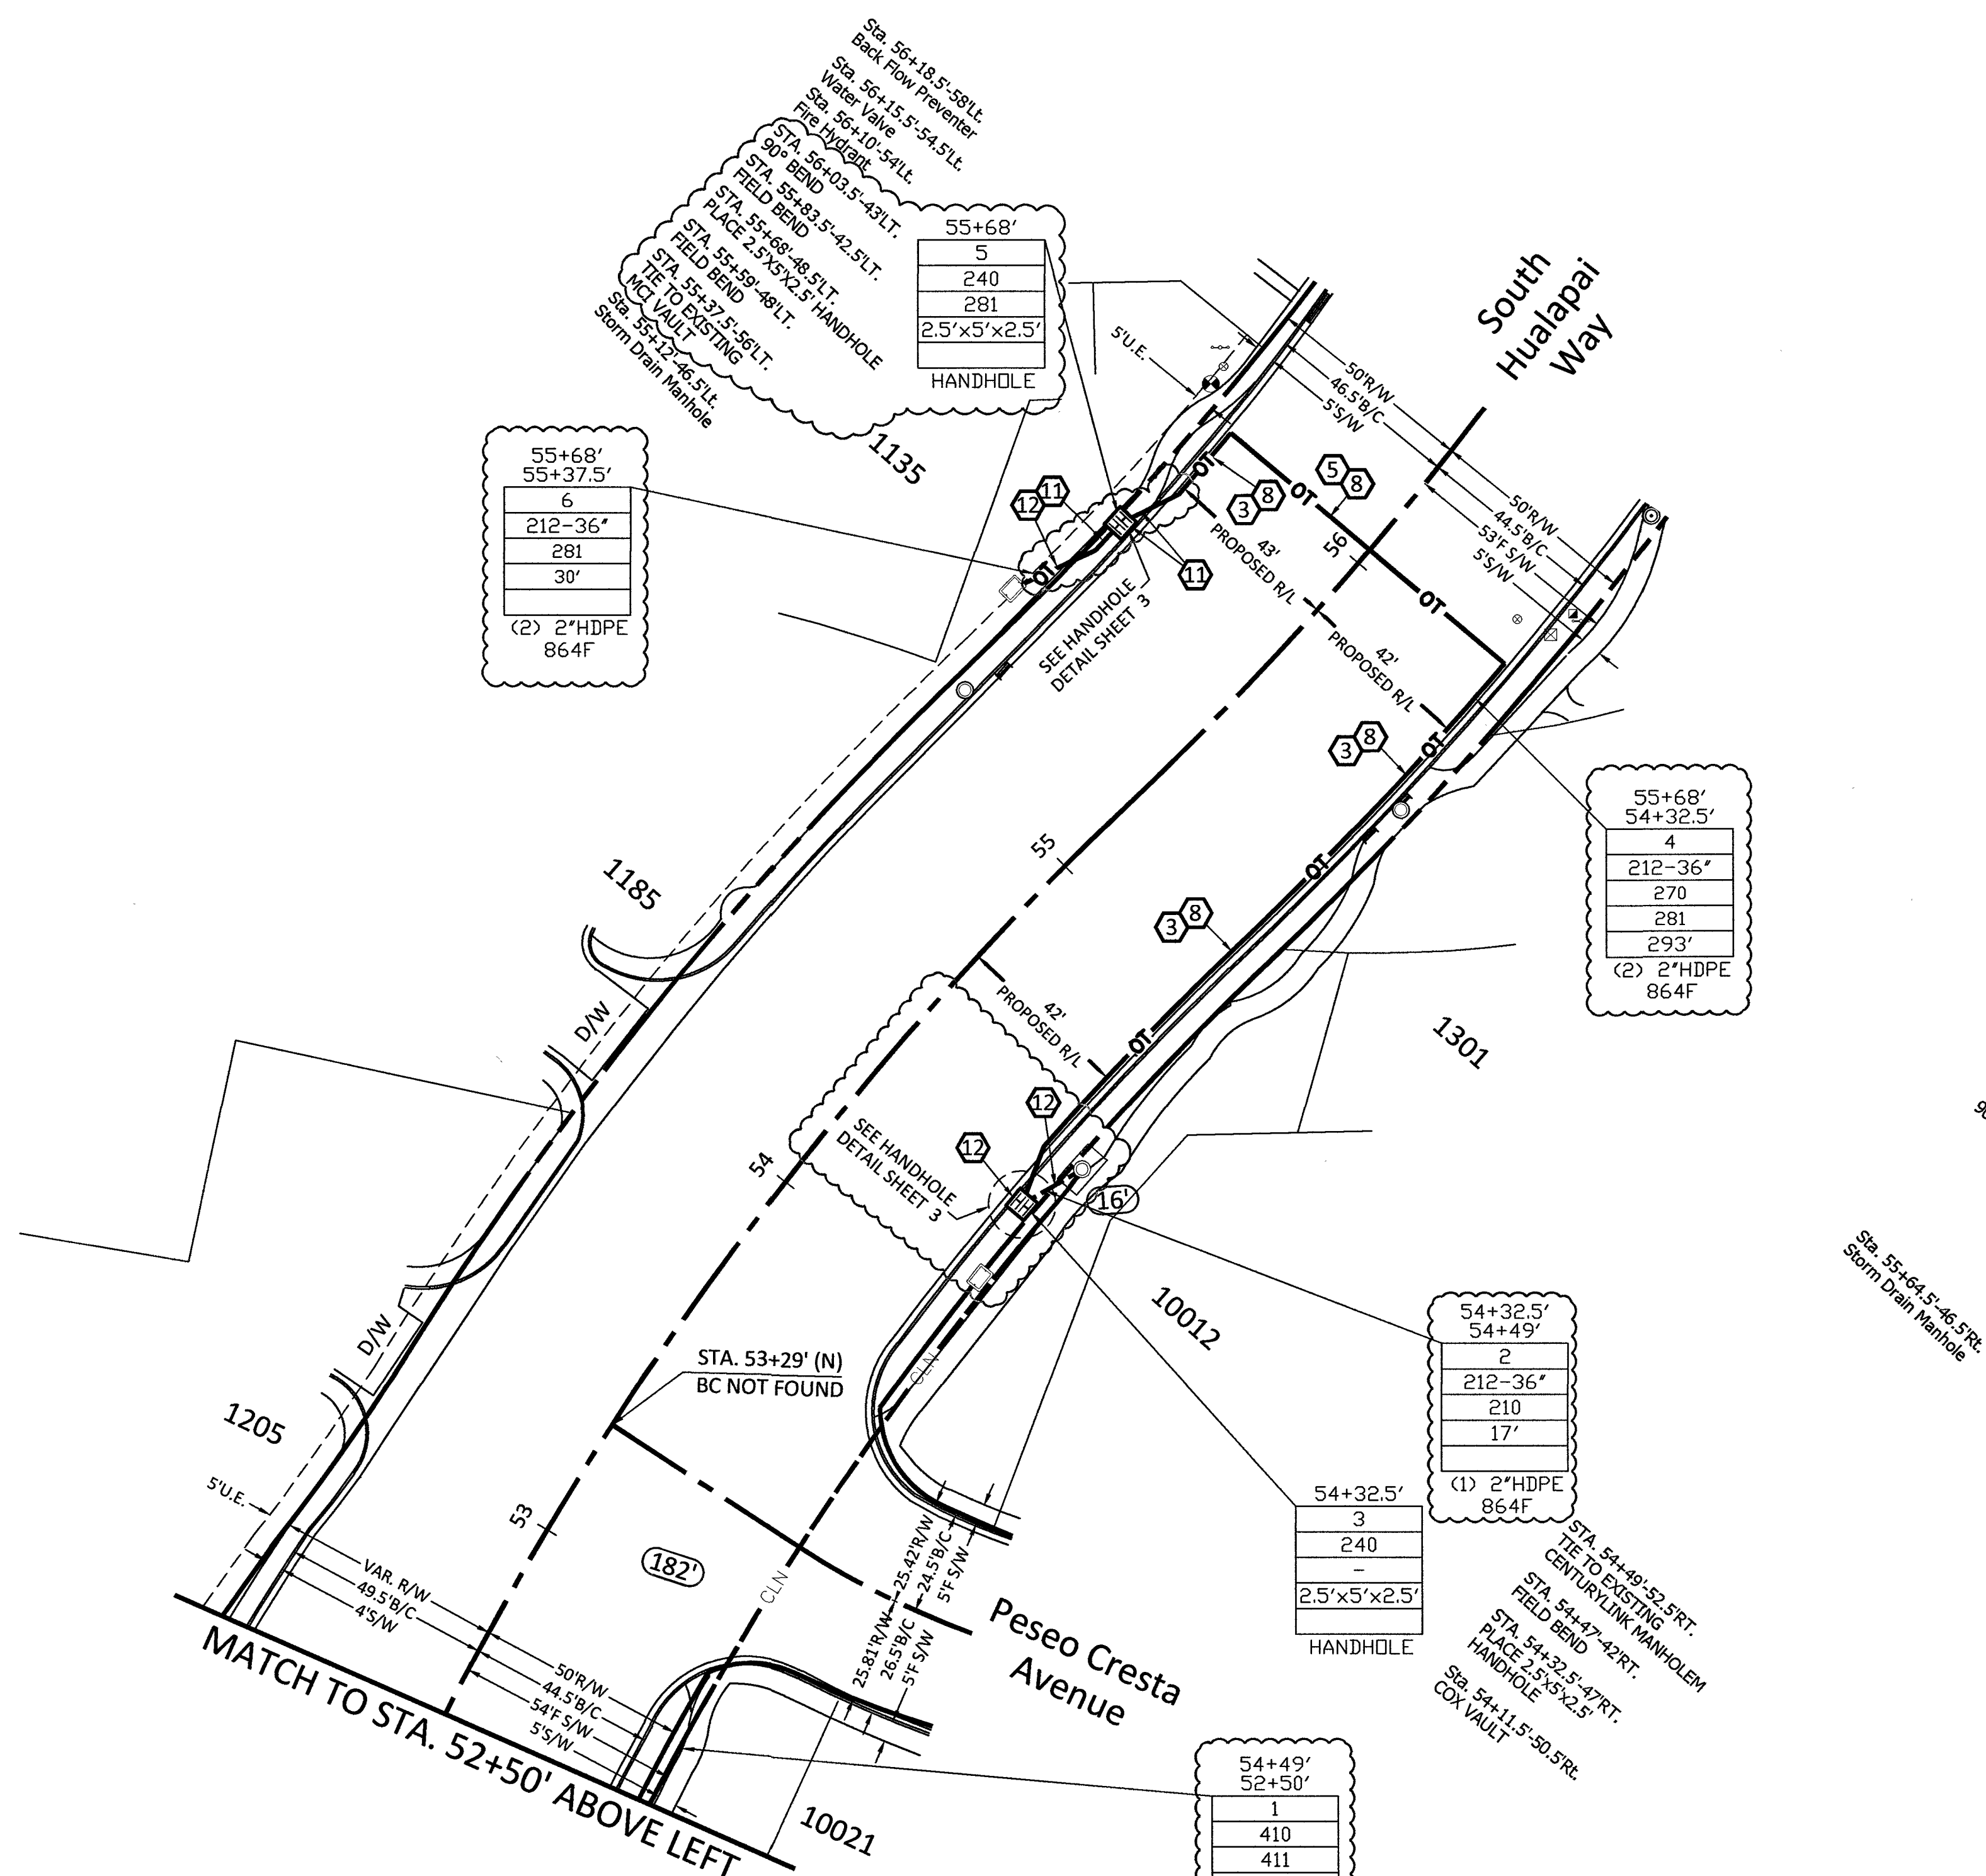

RELOT
C18-02743-2002
10/7/1579-FIB