



2440

2430

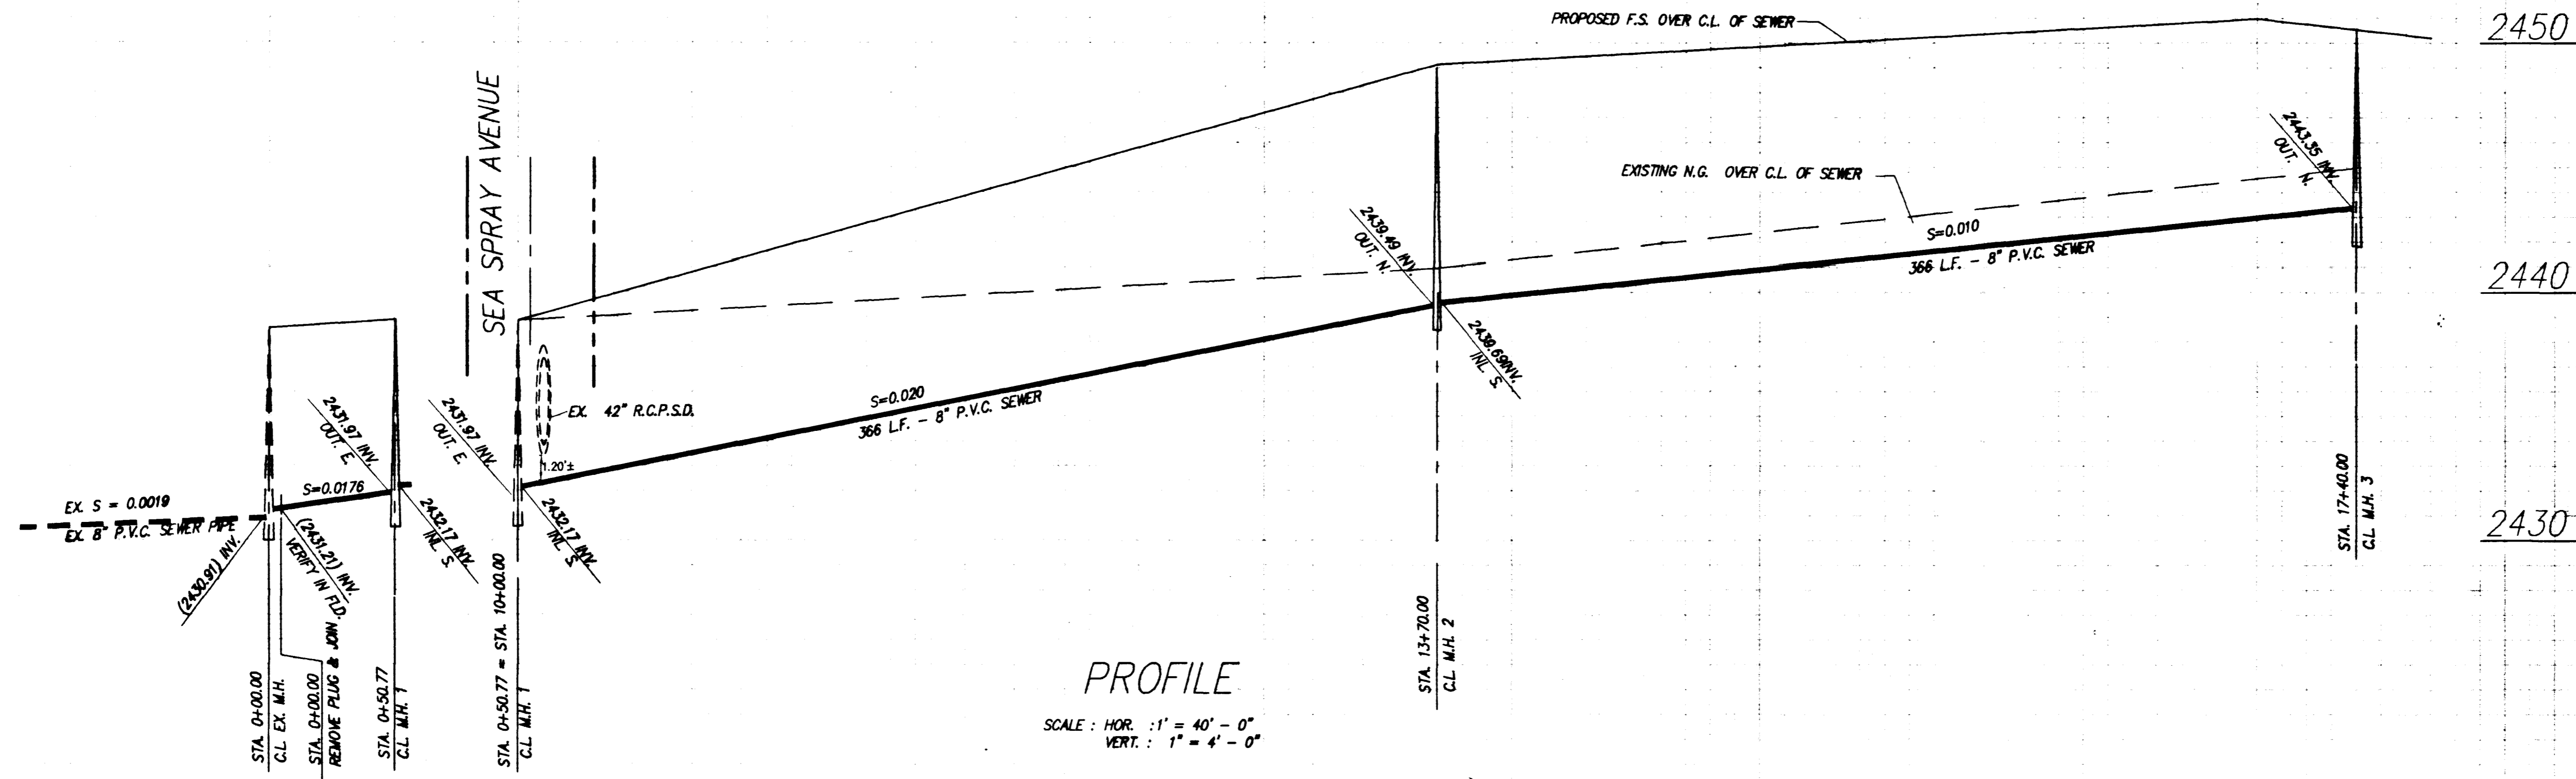


PROFILE

SCALE: HOR. : 1" = 40' - 0"
VERT. : 1" = 4' - 0"

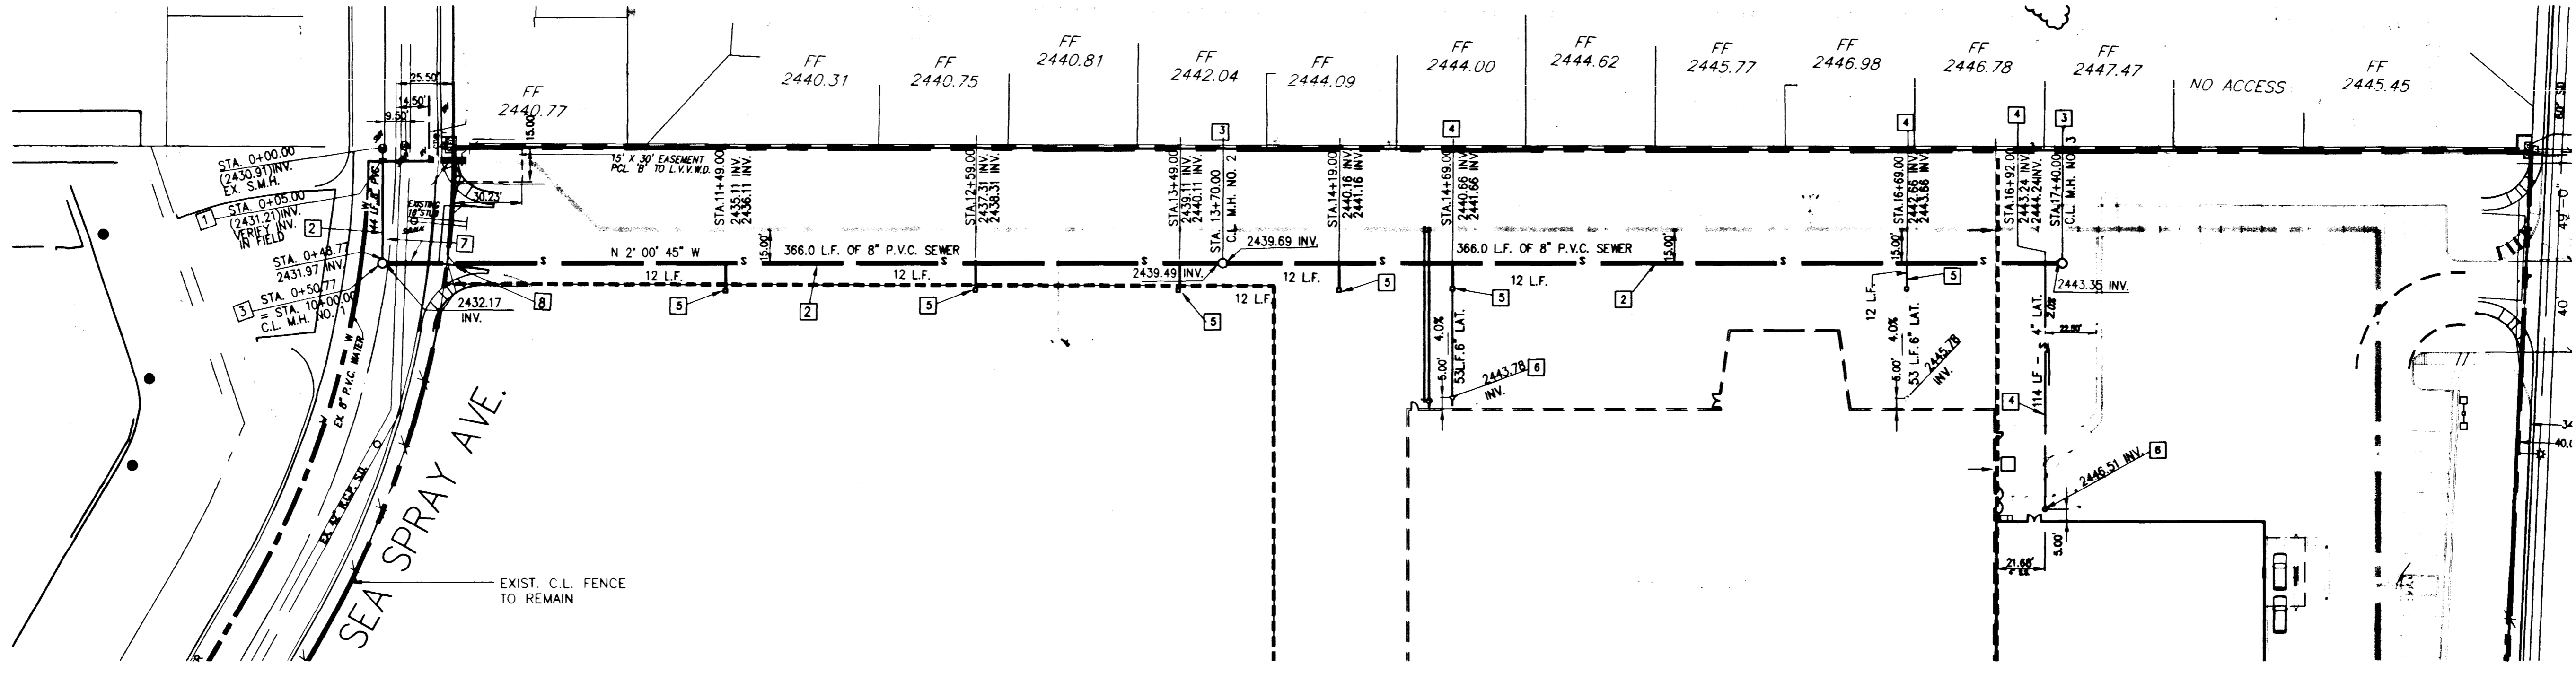

- SEWER CONSTRUCTION NOTES
1. REMOVE PLUG AND JOIN EXISTING 8" P.V.C. SEWER WITH MISSION RUBBER CO. FLEX-SEAL COUPLING PER ASTM C-425 AND ASTM C-1173 OR APP. EQ.
 2. CONSTRUCT 8" P.V.C. MAIN LINE, A.S.T.M. D-3034, S.D.R. 35 WITH ELASTOMERIC GASKET JOINTS PER ASTM F-477 WITH PIPE BEDDING PER SD-11 AND BACKFILL PER SD-16
 3. CONSTRUCT SEWER MANHOLE PER CITY OF LAS VEGAS STD. DWG. SD-1, SD-2, SD-3B, SD-6 & SD-7 WITH P.V.C. PIPE MANHOLE COUPLING PER SD-9 & STEPS PER SD-5
 4. CONSTRUCT SEWER LATERAL PER CITY STD. SD-17
 5. CONSTRUCT SEWER LATERAL PER CITY STD. SD-12, METHOD "A"
 6. CONSTRUCT SEWER CLEANOUT PER SECTION 707.0 AND 719.0 OF THE PLUMBING CODE
 7. CONSTRUCT TRENCH BACKFILL PER U.S.D. 503 WITH MIN. PATCH WIDTH OF 4'
 8. RECONSTRUCT CONCRETE CROSS GUTTER PER USD 228

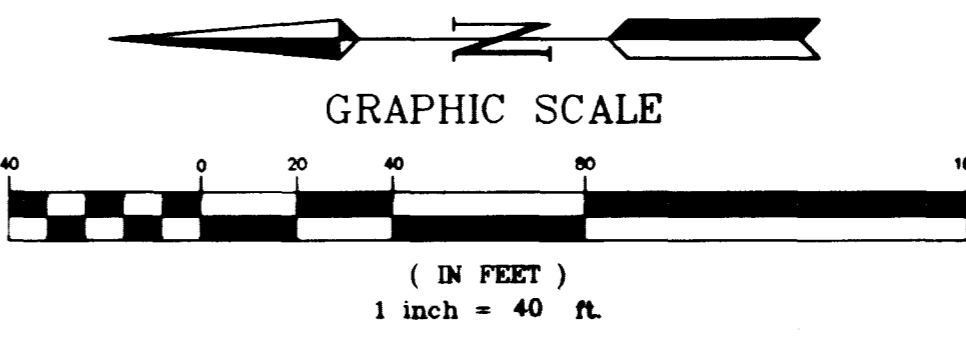



"AS-BUILT"

"As-Built" for

AMERICAN STORES PROPERTIES, INC. 299 SOUTH MAIN 17N-34 SALT LAKE CITY, UTAH 84111 TEL. NO. (801) 961-3923		REV. DATE BY _____ _____ _____
SEABOARD ENGINEERING CO. 1100 S. BEVERLY DRIVE LOS ANGELES, CALIFORNIA 90035 TEL (310) 277-1337 FAX (323) 879-4900		REVISION _____ _____ _____
SEWER PLAN PLAN & PROFILE		
LUCKY/SAY-ON SHOPPING CENTER N.E.C. OF BUFFALO DR. & VEGAS DR.		
DRAWN BY: M.D. DESIGNED BY: M.D. CHECKED BY: G.K.B. PROJECT NO.: 98-68	3/01/99 3/01/99 3/01/99 SCALE: AS NOTED	SHEET C-12 SHEET 12 OF 15 SHEETS DRAWING NO. 107-V3009

2440

2430

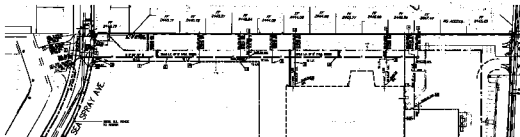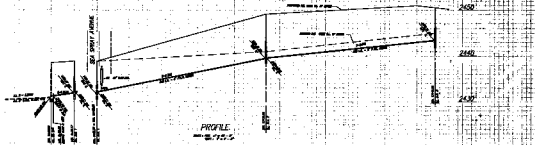

SEWER CONNECTION NOTES

1. OWNER SHALL PROVIDE ALL NECESSARY PERMITS AND RECORDS FOR THE SEWER LINE.
2. ALL SEWER LINES SHALL BE 12" DIA. UNLESS OTHERWISE SPECIFIED.
3. ALL SEWER LINES SHALL BE 4" DIA. UNLESS OTHERWISE SPECIFIED.
4. ALL SEWER LINES SHALL BE 15' DEEP UNLESS OTHERWISE SPECIFIED.
5. ALL SEWER LINES SHALL BE 15' DEEP UNLESS OTHERWISE SPECIFIED.
6. ALL SEWER LINES SHALL BE 15' DEEP UNLESS OTHERWISE SPECIFIED.
7. ALL SEWER LINES SHALL BE 15' DEEP UNLESS OTHERWISE SPECIFIED.
8. ALL SEWER LINES SHALL BE 15' DEEP UNLESS OTHERWISE SPECIFIED.



"AS-BUILT"

AMERICAN ENGINEERING CORPORATION, INC.	
SEWERAGE ENGINEERING DEPARTMENT	
SEWERAGE ENGINEERING CO.	
1000 BROADWAY, NEW YORK, N.Y.	
DATE: 10/15/55	
PROJECT: SEWERAGE SYSTEM	
SHEET: 1 OF 1	
DRAWN BY: J. W. B. / CHECKED BY: J. W. B.	
SCALE: 1" = 10'	
PROJECT NO. 1000	
SHEET NO. 1	