


KINGSWOOD ESTATES UNIT NO. 6
MONUMENT TIE MAP

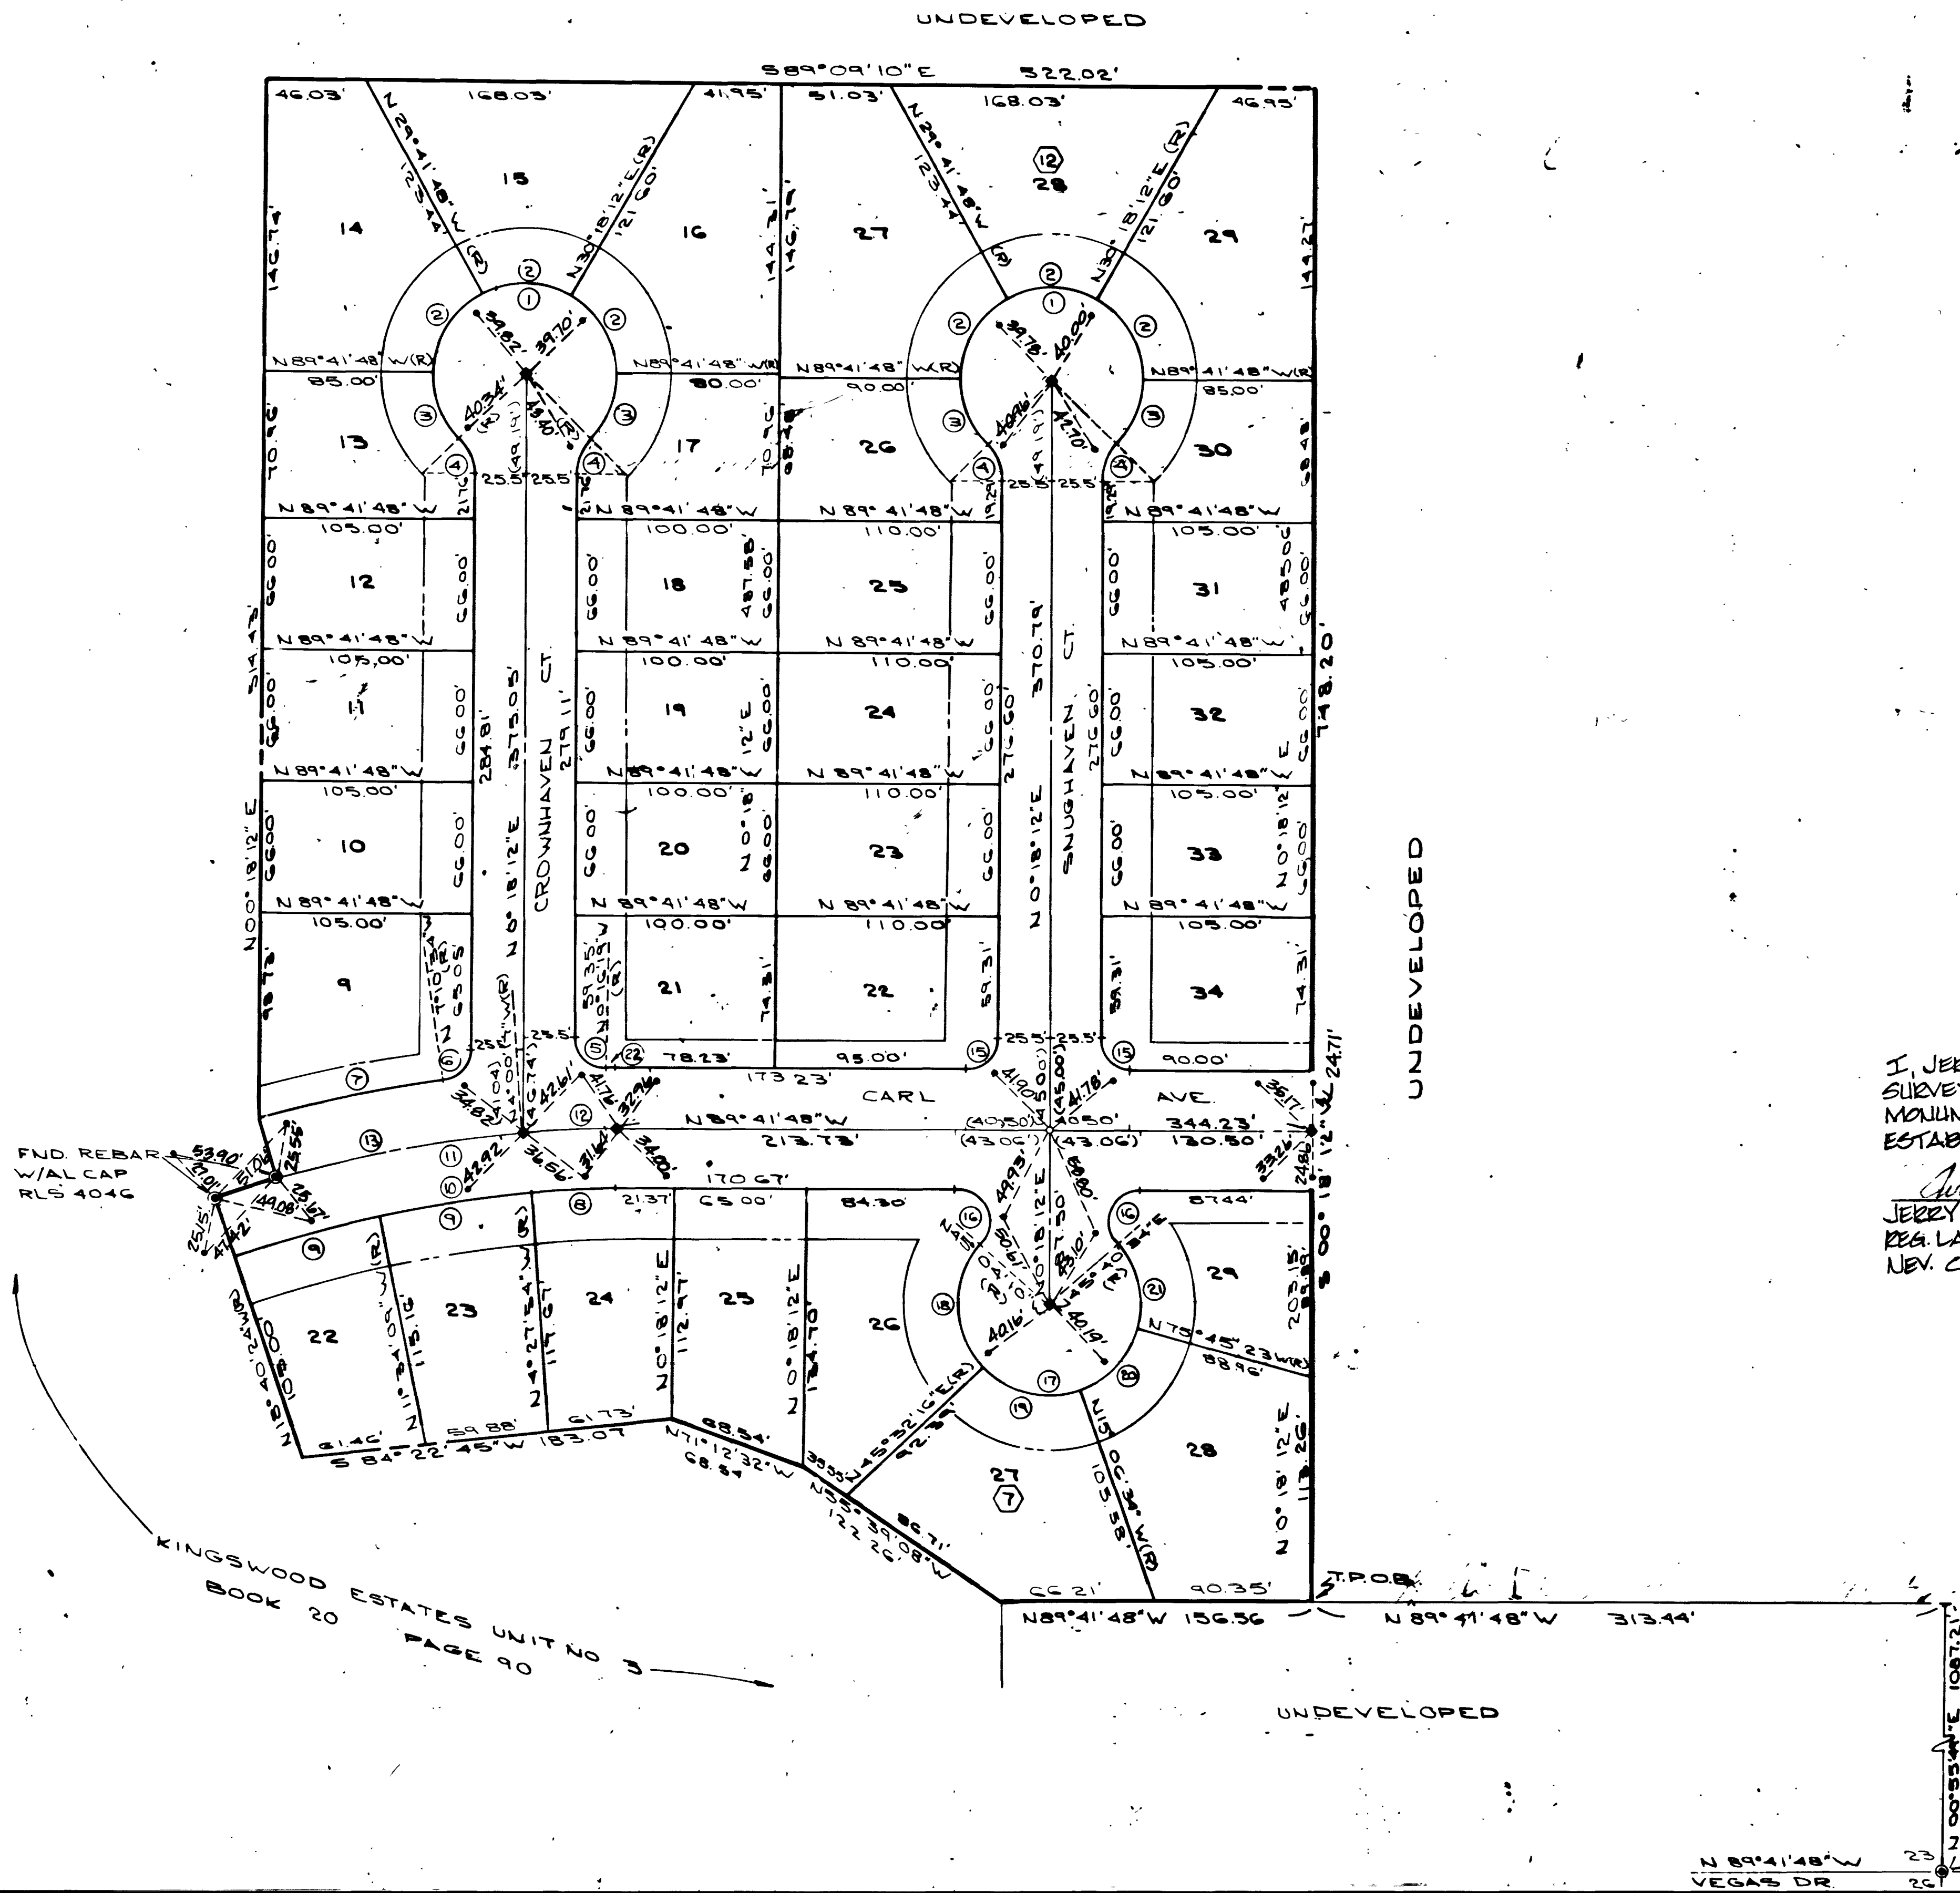



CURVE DATA

NO	Δ	R	L	T
1	268°29'54"	45.50	213.22	00
2	60°00'00"	45.50	47.65	26.27
3	44°14'57"	45.50	35.14	18.20
4	44°14'57"	25.00	19.31	10.16
5	90°34'31"	15.00	23.71	15.13
6	82°31'14"	15.00	21.60	13.16
7	8°09'51"	599.25	93.44	47.05
8	4°46'06"	599.25	49.87	24.95
9	7°06'15"	599.25	74.30	37.20
10	18°58'36"	599.25	198.48	100.16
11	18°58'36"	599.25	208.41	105.17
12	4°18'29"	599.25	47.31	23.67
13	1°20'08"	599.25	12.44	6.24
14	3°19'59"	599.25	36.61	18.31
15	90°00'00"	15.00	23.56	15.00
16	134°37'36"	15.00	35.25	35.92
17	269°15'10"	45.50	213.22	00
18	89°23'34"	45.50	70.94	45.02
19	60°38'50"	45.50	48.16	26.61
20	60°38'50"	45.50	48.16	26.61
21	58°34'03"	45.50	46.51	25.31
22	0°34'31"	599.25	6.62	3.31

- LEGEND
- 31 LOT NUMBER
 - ⑦ BLOCK NUMBER
 - ③ CURVE NUMBER
 - FOUND MONUMENT AS INDICATED
 - ◆ SET REBAR W/ALCAP R.L.S. 4046
 - SET BRASS CAP IN CONC. MON. R.L.S. 4046
 - BUILDING SET BACK LINES
 - 25' FRONT 15' SIDE
 - SET LEAD & BRASS NAIL IN TC, R.L.S. 4046

SURVEYOR'S CERTIFICATE
I, JERRY E. BARNESON, A REGISTERED LAND SURVEYOR, DO HEREBY CERTIFY THAT THE MONUMENTS HAVE BEEN SET AND THE TIES ESTABLISHED AS SHOWN HEREON.

Jerry E. Barneison 4/27/20
DATE
JERRY E. BARNESON
REG. LAND SURVEYOR
NEV. CERT. NO. 4046

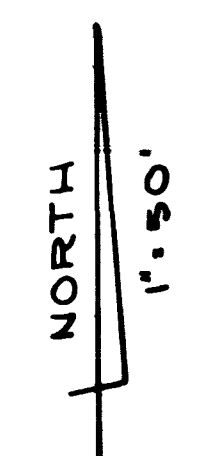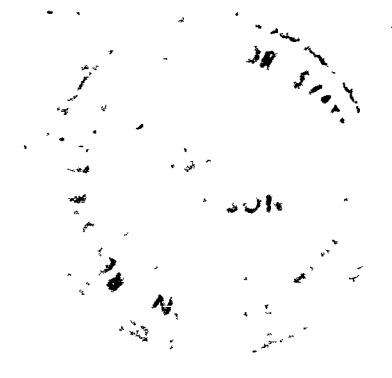

FND. REBAR
W/ALCAP
R.L.S. 4046

FND. CLV B/C
SE. SECTION COR.

SHT. 2 OF 2

KINGSWOOD ESTATES UNIT NO. 3
BOOK 20 PAGE 90

2756

4-6-21 058-1925-6

