



PURPOSE OF PROJECT:
NPC TO REMOVE POLE THAT
ARE IN CONFLICT WITH NEW
BUILDING AT CUSTOMER EXPENSE

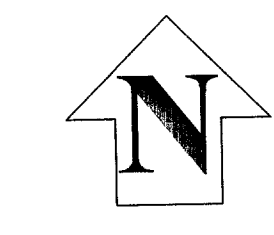

T,R,S: 2061-34
APN: 139

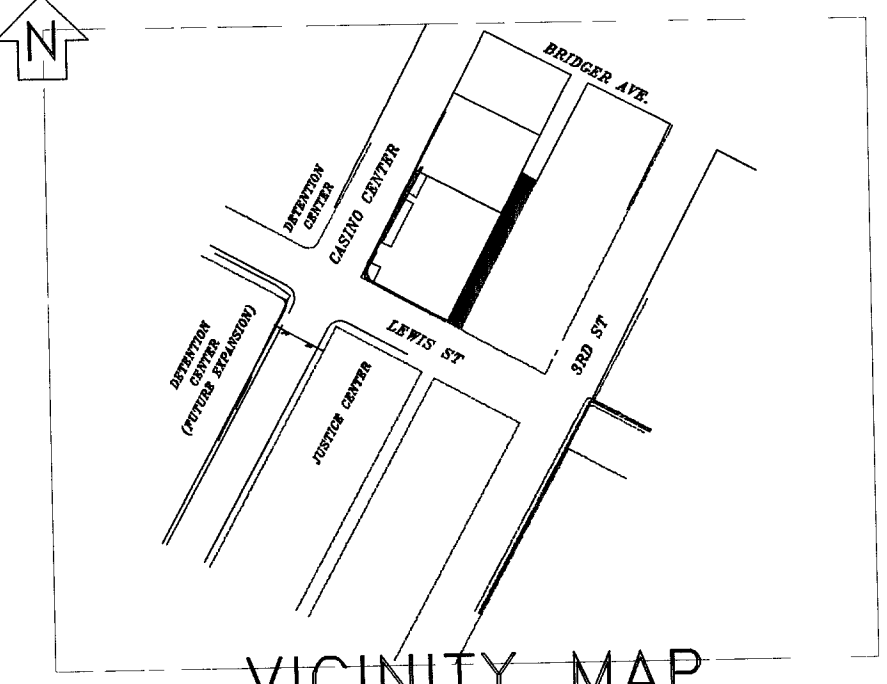

EVERY EFFORT HAS BEEN MADE TO IDENTIFY ALL NPC FACILITIES. THE CUSTOMER SHALL CONFIRM THE EXISTENCE AND LOCATION OF THESE FACILITIES.

AVOID HITTING OVERHEAD POWER LINES IT'S COSTLY.

CALL BEFORE YOU DIG OVERHEAD

AVOID CUTTING UNDERGROUND UTILITY LINES IT'S COSTLY.

Call before you Dig.

1-800-227-2600
UNDERGROUND SERVICE (USA)

REVISIONS			
NO.	DESCRIPTION	DATE	G.A.
1	POLE RELOCATION & CONDUIT REROUTING REVISED PER FIELD MEET	06/16/2005	
2	CHANGING SVC. TO METER PEDESTAL FROM C.O.S. TO NPC INSTALLED SVC AND INSTALLING HANDHOLE AT CLV METER	07/26/2005	

OVERHEAD

TYPE OF EASEMENT:

☐ AERIAL
☐ STANDARD
☐ R/W-31
☐ UNDERGROUND
☐ AS BUILT UNDERGROUND
☐ R.O.E/R/W-5-COM
☐ 3rd PARTY
☐ UNDERGROUND BY EXHIBIT
☐ (N-DOT) PERMIT
☐ (BLM) PERMIT
☐ RAILROAD-UPRR-PERMIT
☐ SO. NEVADA WATER PERMIT
☐ NOT REQUIRED
☐ Misc Info

JPA NOTES:

☐ SPRINT CONTACT: DAVE SCHERER
☐ PHONE NUMBER: 244-8071
☐ DATE OF CONTACT: 01/26/2005
☐ NPC TO SET NEW POLES
☐ NPC TO STAKE NEW POLES
☐ NPC TO PROVIDE 4 POLES
☐ 2 55 FT. CLASS 1
☐ 2 35 FT. CLASS 1
☐ FT. CLASS
☐ NPC TO DIG POLE HOLES
☐ NPC TO REMOVE EX. POLES
☐ NPC TO REMOVE (6) POLES & (4) ANCHORS AND INSTALL (4) POLES
☐ JPA#: P200500037

NPC INFORMATION:

COORDINATOR: PAT BROWN

PHONE: 657-4335

DESIGNER: DON JACKSON

DCA:

INSPECTOR: 378-3712

SCHEDULING: 657-4114, 657-4116, 657-4118

DISTRICT: LAS VEGAS

CUSTOMER INFORMATION:

APPLICANT: LEWIS CTR PARKING, LLC

ENGINEER: TANEY ENGINEERING

CONTACT: STEVE BROOK 876-7524

APPROVAL DATE: 5/23/05

GOVERNMENT INFORMATION:

AGENCY: CITY OF LAS VEGAS

APPROVAL DATE:

NEVADA POWER COMPANY

LEWIS PARKING STRUCTURE

107V4028-NPC

PROJ. ID: 172742

SCALE: 1" = 50'

SHEET #: 3 OF 3


DATE: 11/12/2003

CITY OF LAS VEGAS
PERMIT REQUIRED*

CONTACT CLV LAND DEVELOPMENT (229-6371)
CLV CONSTRUCTION SERVICES MUST BE NOTIFIED 24 HOURS PRIOR TO COMMENCING CONSTRUCTION (229-6337)

*NPC INSPECTOR MUST BE NOTIFIED BY FAX 48 HOURS PRIOR TO COMMENCING CONSTRUCTION & WILL VERIFY CITY PERMIT FOR WORK DONE IN STREETS OR SIDEWALK.

FAX PERMIT TO:
LAS VEGAS NORTH: 857-4354
LAS VEGAS SOUTH (HENDERSON): 558-4740
LAS VEGAS SOUTH (SPRING VALLEY): 252-4828

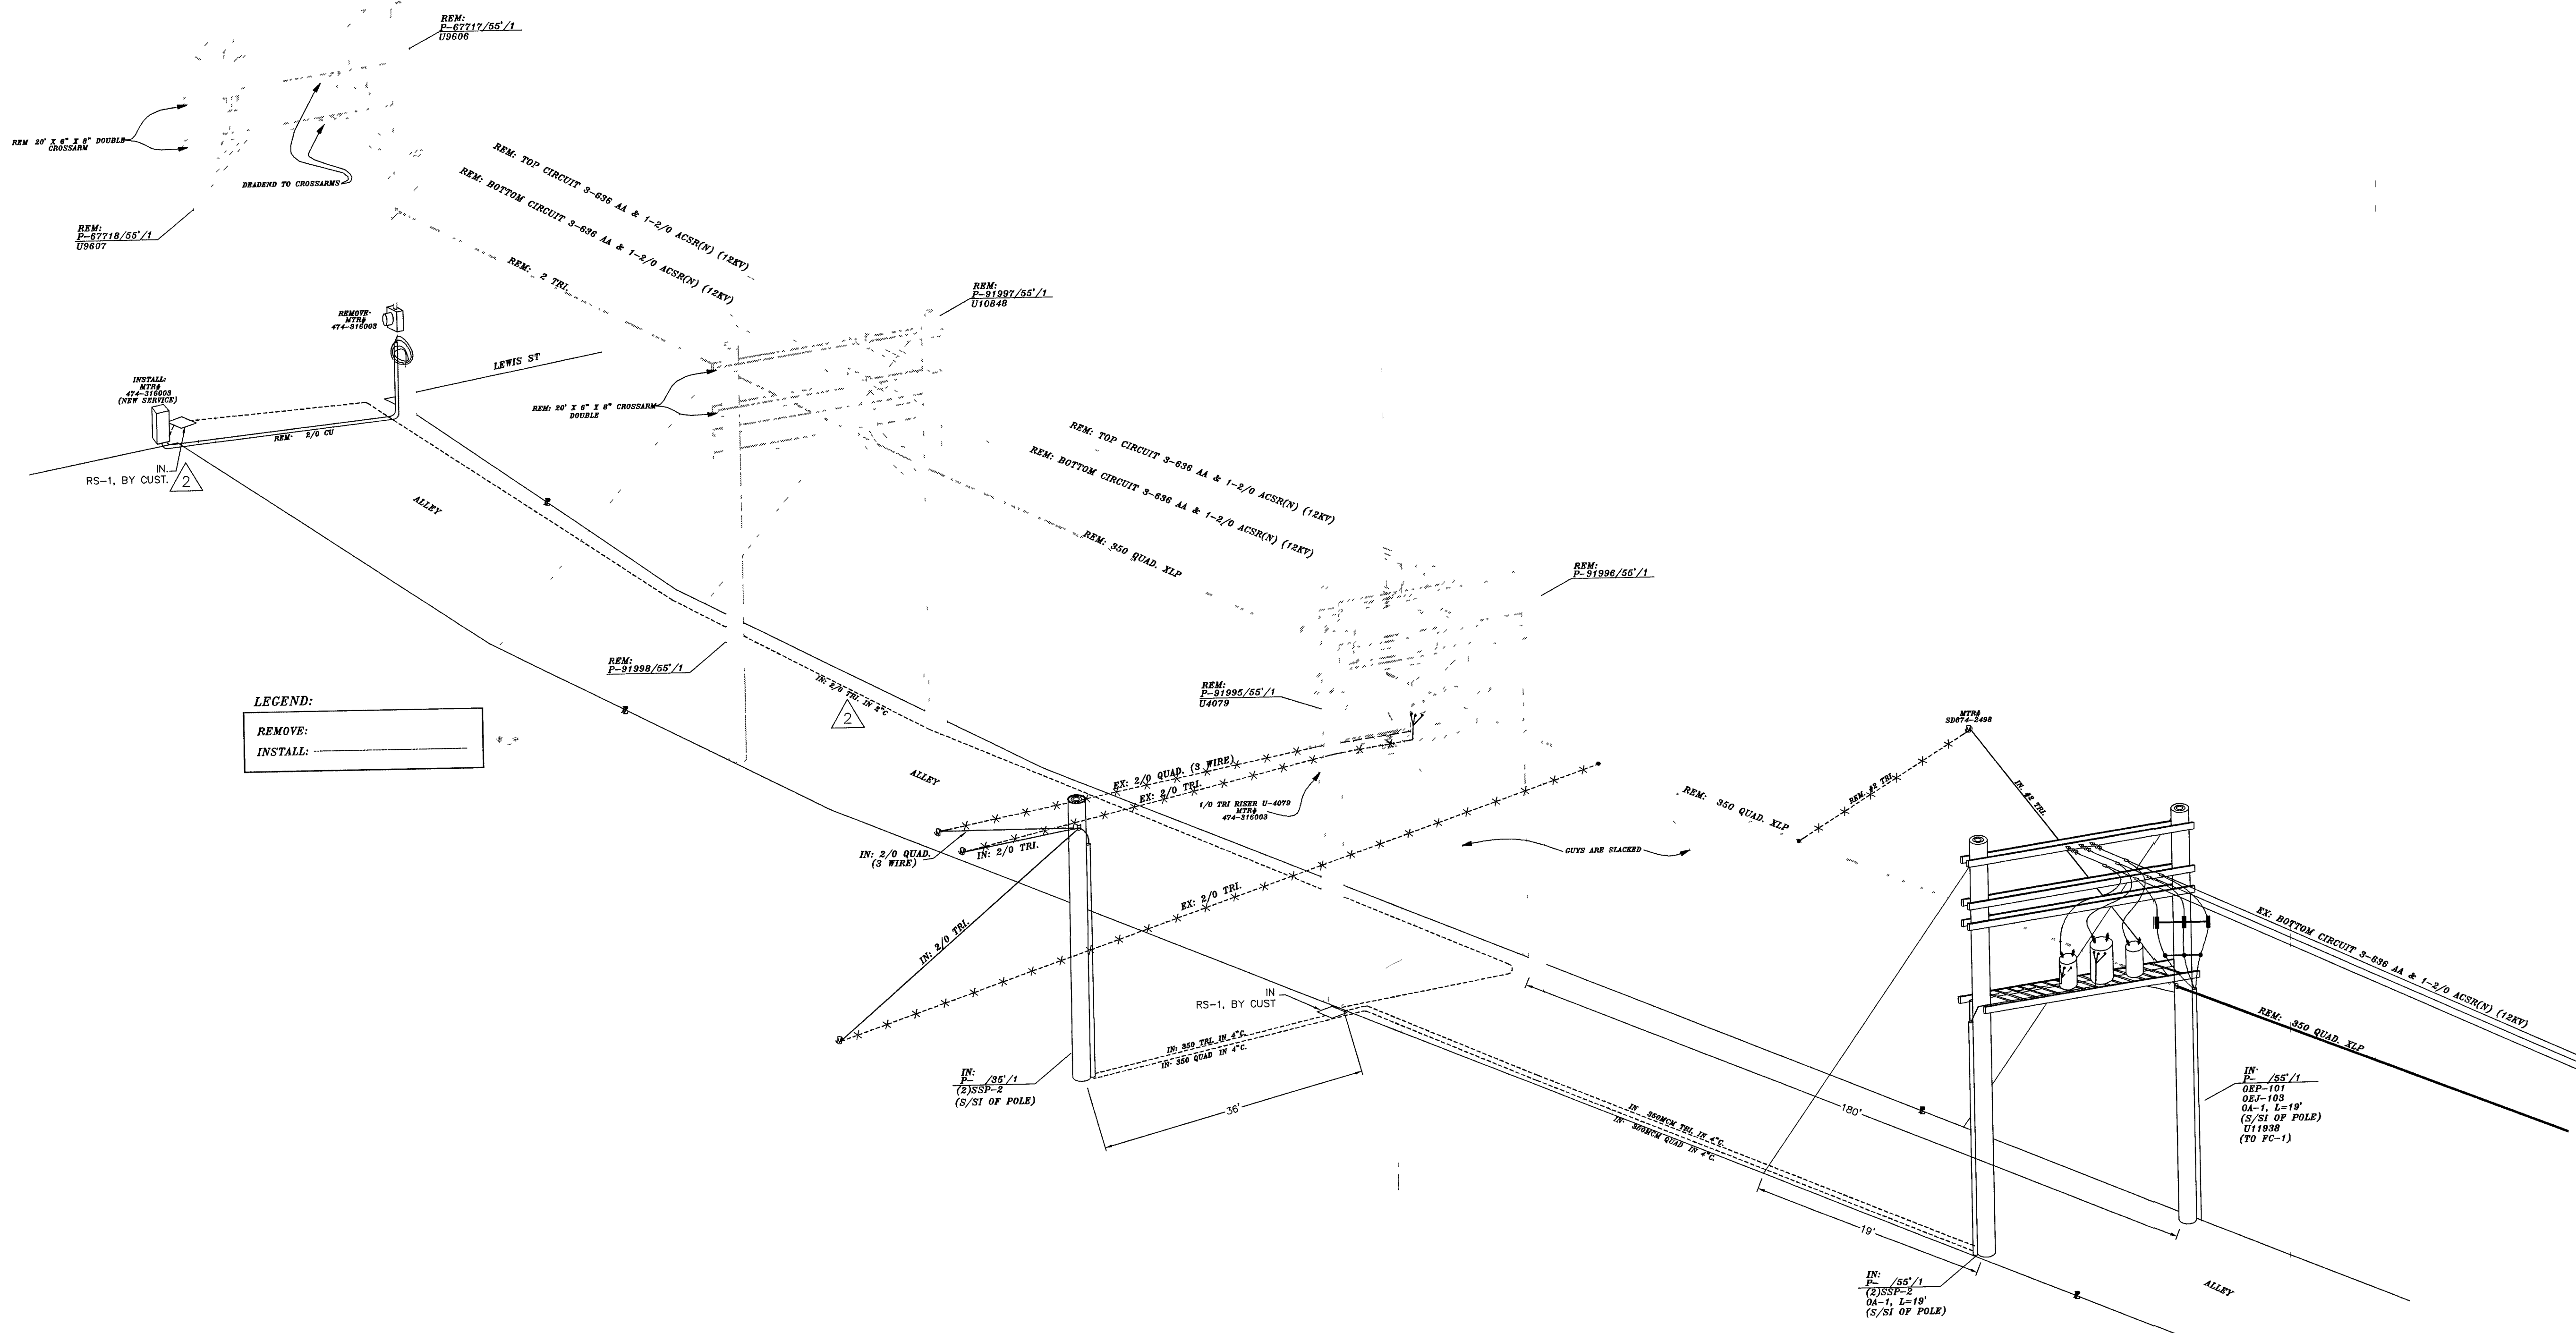

OVERALL PROJECT

-NOT TO SCALE-