


PUBLIC SEWER
 PLAN SCALE:
 HORIZONTAL 1" = 30'

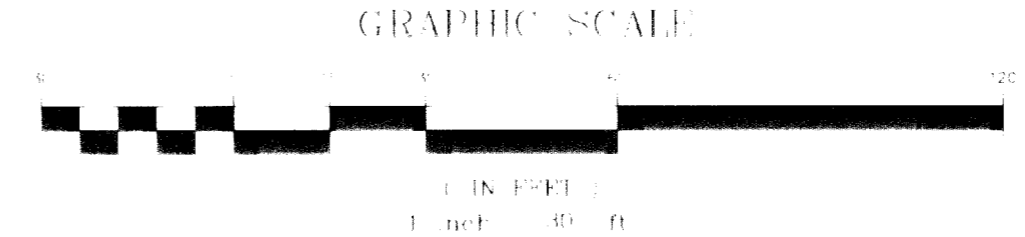


MATCHLINE STA. 31+00
 SEE SHEET PP8 FOR CONTINUATION

MATCHLINE STA. 27+50
 SEE RIGHT FOR CONTINUATION

MATCHLINE STA. 27+50
 SEE LEFT FOR CONTINUATION

MATCHLINE STA. 25+00
 SEE SHEET PP5 FOR CONTINUATION

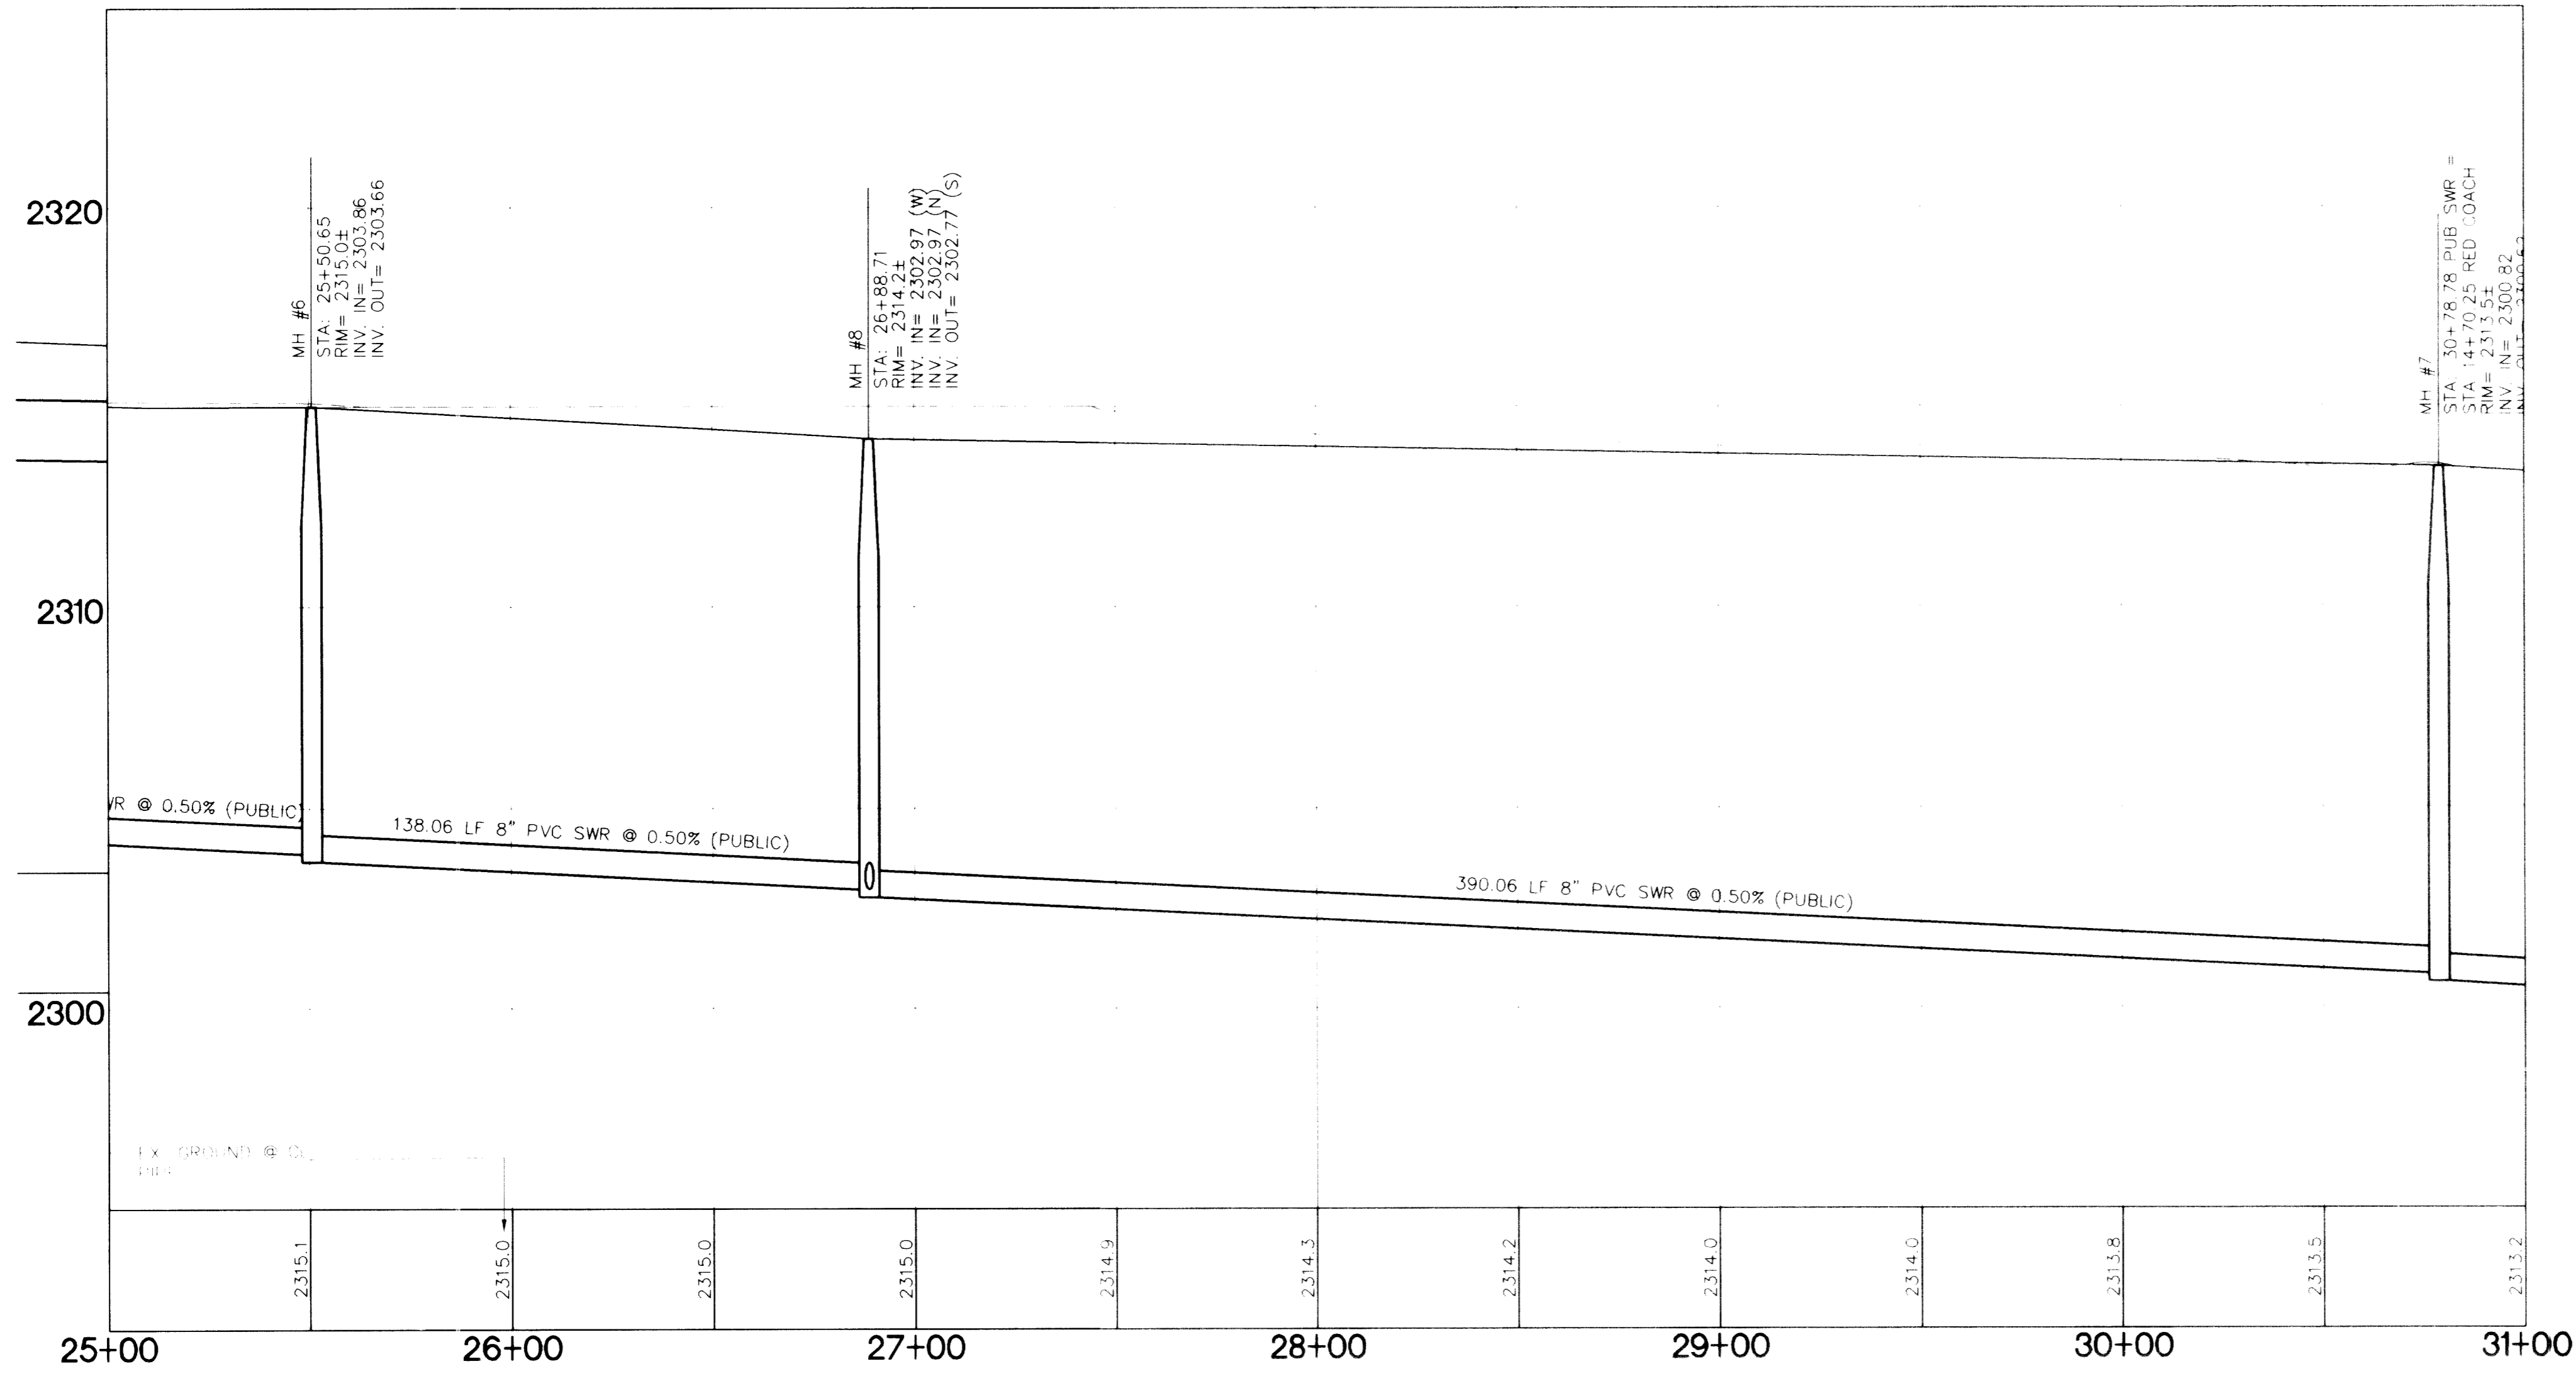

PUBLIC MANHOLE SCHEDULE

MH #	NORTHING	EASTING	RIM	INV. IN	INV. OUT
N/A					
1	2814.79	7998	4857.72	2311.81	2311.50
2	2815.51	9715	4851.71	2321.24	2310.81
3	280903	0049	48516	14014	2318.31
4	280860	0448	485560	5860	2316.51
5	280826	1847	485864	9865	2315.11
6	280927	8494	485876	0390	2315.01
7	280696	0809	486218	8150	2313.51
8	281009	8638	485987	1020	2314.21
14	280959	2847	485971	2114	2319.71

- LEGEND**
- NEW AC
 - AC TO BE REMOVED AND REPLACED
 - AC TO BE REMOVED
 - PSE PUBLIC SEWER EASEMENT

BASIS OF BEARINGS:
 THE BASIS OF BEARING FOR THIS SURVEY IS THE WESTERLY LINE OF THE NORTHWEST QUARTER (NW 1/4) OF SECTION 2, TOWNSHIP 20 SOUTH, RANGE 60 EAST, N.D.M., CITY OF LAS VEGAS, COUNTY OF CLARK, STATE OF NEVADA, WHICH BEARS NORTH 00°31'01" EAST, AS PER MAP RECORDED IN BOOK 105, PAGE 58 OF PLATS IN THE OFFICE OF THE COUNTY RECORDER OF SAID COUNTY.

BENCH MARK:
 CITY OF LAS VEGAS BENCH MARK 1LV00 3NE66
 CITY OF LAS VEGAS PIN AND PLATE IN THE TOP OF CURB, SOUTHWEST CORNER OF RAINBOW BOULEVARD AND RED COACH AVENUE NEAR THE PT OF RED COACH AVENUE
 NAVD '88 DATUM
 ELEVATION = 2319.021 U.S. SURVEY FEET
 ELEVATION = 706.839 METERS

CAUTION TO CONTRACTOR!
 EXISTING UTILITY LOCATIONS SHOWN HEREON ARE APPROXIMATE ONLY. IT SHALL BE THE CONTRACTOR'S RESPONSIBILITY TO DETERMINE THE EXACT VERTICAL AND HORIZONTAL LOCATION OF ALL EXISTING UNDERGROUND UTILITIES PRIOR TO COMMENCING CONSTRUCTION. NO REPRESENTATION IS MADE THAT ALL EXISTING UTILITIES ARE SHOWN HEREON. THE ENGINEER ASSUMES NO RESPONSIBILITY FOR UTILITIES NOT SHOWN OR UTILITIES NOT SHOWN IN THEIR PROPER LOCATION.



Call before you Dig.
 1-800-227-2600
 UNDERGROUND SERVICE (USA)

PUBLIC SEWER
 PROFILE SCALE:
 HORIZONTAL: 1" = 30'
 VERTICAL: 1" = 3'

RECORD DRAWING NOTES
 THE AS-CONSTRUCTED INFORMATION SHOWN HEREON HAS BEEN PROVIDED BY OVATION DEVELOPMENT. NO FIELD DATA HAS BEEN PROVIDED AS TO THE AS-CONSTRUCTED LOCATIONS WHERE DIMENSIONS ARE NOT SHOWN. TRC ASSUMES NO RESPONSIBILITY AS TO THE ACCURACY OF THE SUPPLIED DATA.
 SEE SHEETS U2 & U4 FOR PUBLIC SEWER LATERAL AS-BUILT LOCATIONS

OVATION DEVELOPMENT
 6021 S. FORT APACHE ROAD #100
 LAS VEGAS, NEVADA 89148
 CONTACT: JAN COVER (702) 990-2390

CTRC
 1005 WINTER RANCH DRIVE, HENDERSON, NEVADA 89014 (702) 748-6444

PUBLIC SEWER PLAN AND PROFILE STA 25+00 TO 31+00

LONE MOUNTAIN APARTMENTS RECORD DRAWINGS

PROFESSIONAL ENGINEER-STATE OF NEVADA
 PETER J. LAAS
 Exp: 12/31/07
 CIVIL
 REG. NO. 14419

REVISIONS

DATE

REVISION

SCALE
 1" = 30' HOR
 1" = 3' VERT

SHEET
 PP6
 12 OF 14 SHEETS
 DRAWING NO.