


MATCHLINE SEE SHT C9
615+00 "LVW" = 12+83.38 "TRL4"

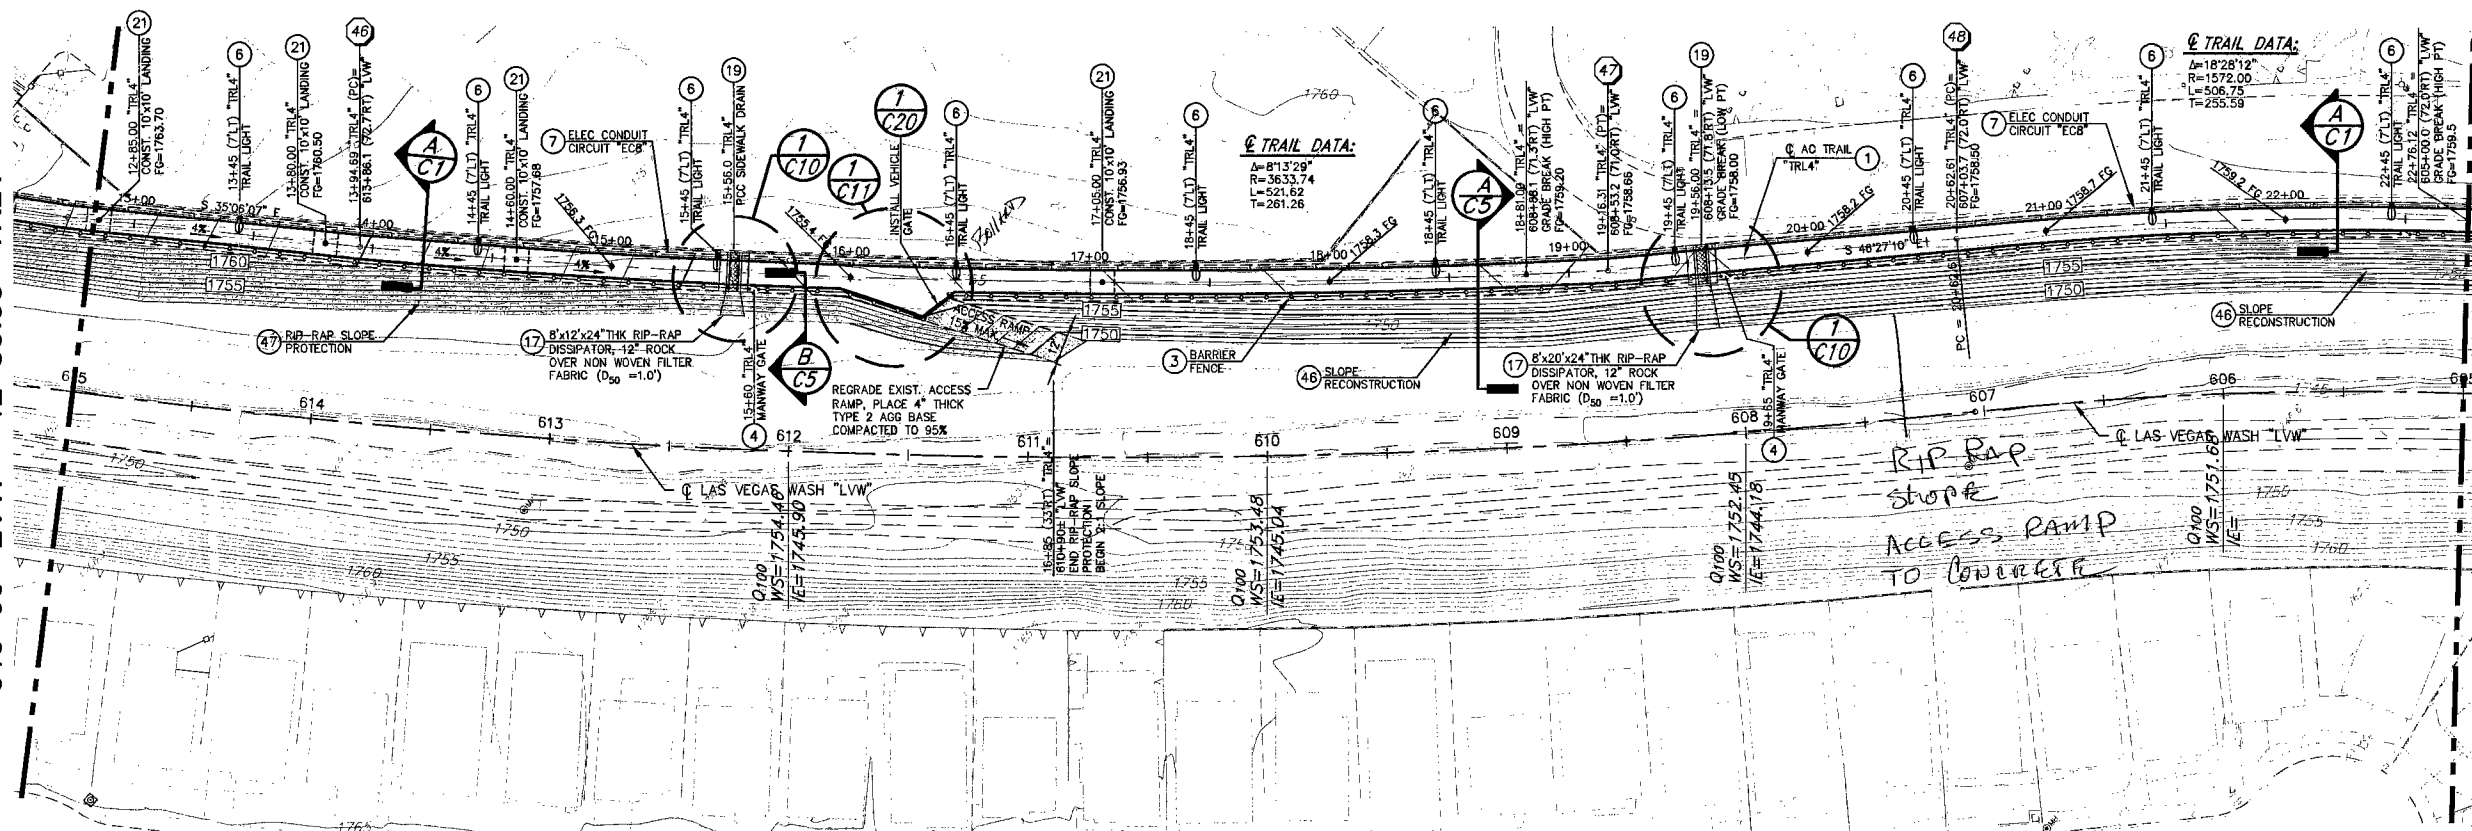

605+00 "LVW" = 22+76.12 "TRL4"
MATCHLINE SEE SHT C11

BAYBERRY DR.

COORDINATE POINT DATA		
PT #	NORTHING	EASTING
46	26764918.9365	808302.5226
47	26764520.3879	808638.3538
48	26764419.5927	808744.3948



LV WASH - TRAIL PLAN

SCALE: 1"=40'
REFERENCE SHEETS C27 TO C30 FOR CHANNEL CROSS SECTIONS AND SLOPE RECONSTRUCTION.

BAYBERRY DR.


CONSTRUCTION NOTES:

- CONSTRUCT 6" THICK PORTLAND CEMENT CONCRETE (PCC) PAVEMENT TRAIL PER DETAIL 2, SHT C1.
- PLACE LANDSCAPE ROCK 4" THICK, WITH WEED BARRIER, TO LIMITS SHOWN.
- INSTALL CABLE BARRIER FENCE PER DETAIL 1, SHT C19.
- INSTALL MANWAY ACCESS GATE PER DETAIL 1, SHT C19.
- INSTALL VEHICLE ACCESS GATE PER DETAIL 1, SHT C20.
- INSTALL 150 WATT TRAIL LIGHTING STANDARD AND POLE PER DETAIL 1, SHT E5.
- INSTALL PVC LIGHTING CONDUIT PER DETAIL 3, SHT E5. INSTALL ELECTRICAL WIRE PER WIRE SCHEDULES ON SHEETS E6 & E7.
- PLACE AND COMPACT TYPE II AGGREGATE BASE TO LIMITS SHOWN ON PLANS, 95% RELATIVE COMPACTION.
- PLACE RIP-RAP SLOPE PROTECTION TO LIMITS SHOWN ON PLAN.
- REMOVE EXISTING CONCRETE SPILLWAY, INSTALL CONCRETE SIDEWALK DRAIN PER STD DWG 236, AND DETAIL 1, SHT C10. MATCH EXISTING FLOWLINE.
- CONSTRUCT LANDING PER DETAIL 2, SHT C10.
- SLOPE EXCAVATION AND TRAIL FILL/EMBANKMENT, PER SECTION "A", SHT C5.
- SLOPE EXCAVATION, TRAIL FILL/EMBANKMENT, AND PLACE RIP-RAP SLOPE PROTECTION PER SECTION "B", SHT C5.

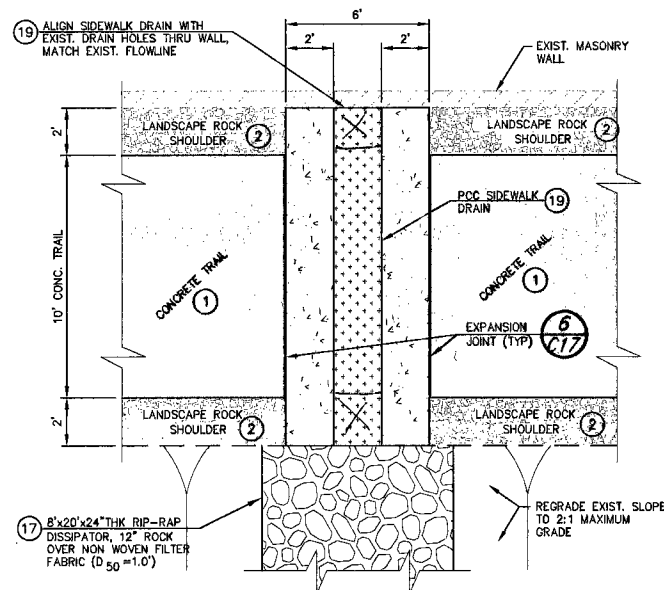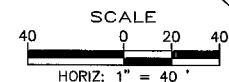


SIDEWALK DRAIN PLAN

SCALE: 1"=4'

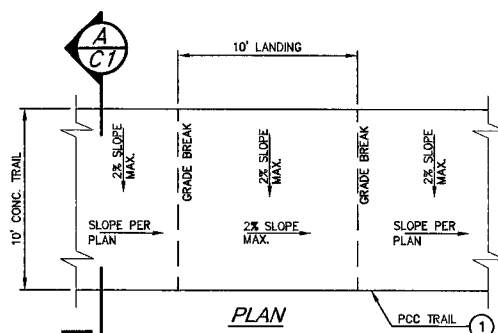


PLAN

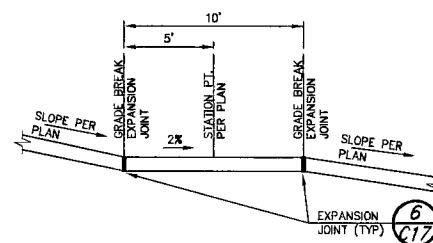


SECTION

LANDING

2
C10

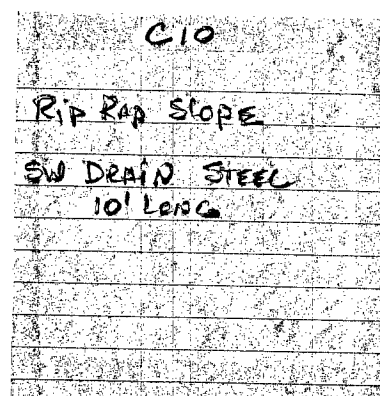

RIP RAP SLOPE
SW DRAIN STEEL
10' LONG

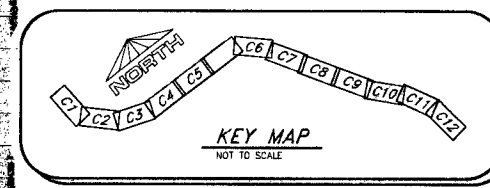

KEY MAP

NOT TO SCALE

Call before you Dig
Avoid cutting underground utility lines. It's costly.

Call
811
OR
1-800-227-2600
CLARK COUNTY TRAFFIC OPERATIONS
1-702-455-7544

John K. Kraling
RECORD
3/5/2010
AS BUILT

"TRL4" STA. 12+83.38 TO 22+76.12

LAS VEGAS WASH TRAIL - PHASE 1

OWENS AVE. TO STEWART AVE.

SHEET NO.


C10

SHT. 15 OF 43
DWG No. 107V4396

HANSEN #12956

CITY OF LAS VEGAS - DEPARTMENT OF PUBLIC WORKS - ENGINEERING DIVISION

SCALE: 1" = 40'		REVISIONS			
		NO.	DESCRIPTION	DATE	BY
DESIGN: DGR/DRA		Δ			
DRAWN: DGR		Δ			
CHECKED: DRA		Δ			
APPROVED:		Δ			
DATE: 9-18-08		PROJECT NO: _____			
		PLF NAME: TPAIL — SUTS-12 DWG			

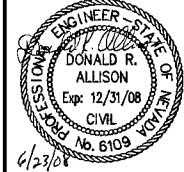

SCALE: 1" = 40'	DESIGN: DGR/DRA
DRAWN: DGR	CHECKED: DRA
APPROVED:	DATE: 6-16-08
PROJECT NO:	FILE NAME: TRAIL-SHTS-12.DWG

22213
Bureau Veritas
North America, Inc.
4840 W. University Ave, Suite A-1
Las Vegas, Nevada 89103
Tel: (702) 252-7866