



TRAIL POLICY SIGN FRAME (1) C21
NTS

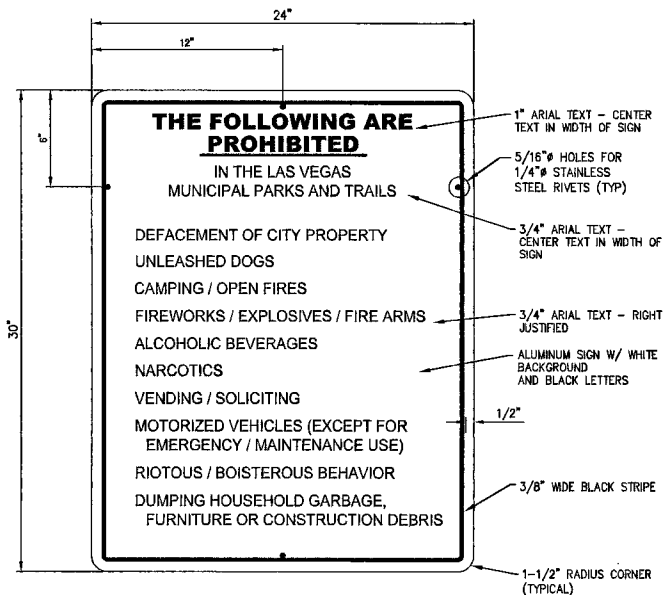


TRAIL POLICY SIGN (2) C21
NTS

*Shows Modified per City
Suite of 3 signs
installed @ entry points*


① Policy
② Floods
③ Dog Walker

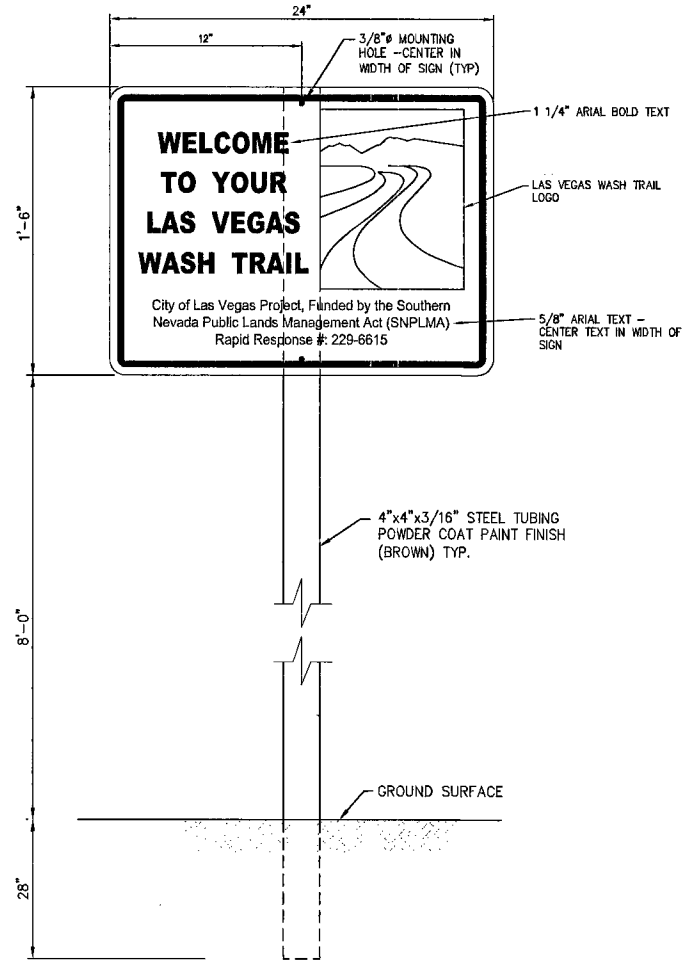

TRAIL HEAD SIGN & POST (3) C21
NTS

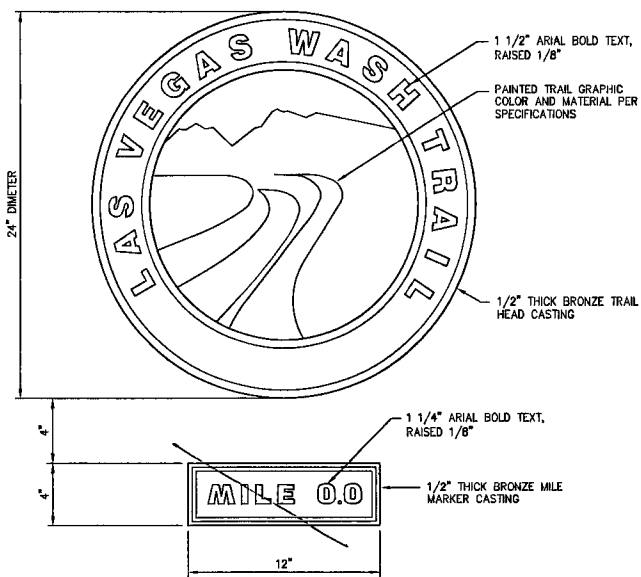


TRAILHEAD LOGO MEDALLION (4) C21
NTS

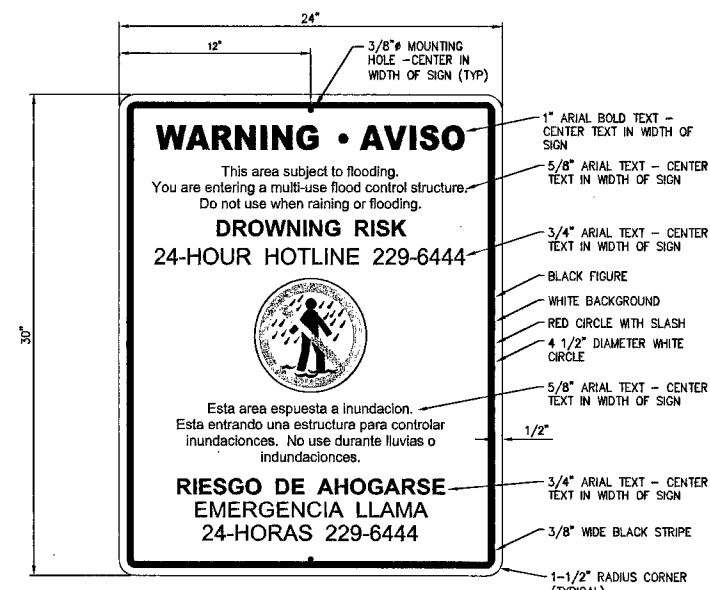


FLOOD WARNING SIGN (5) C21
NTS

*C-21
ADDED SIGNS
Changed Flood Sign
Stencil Black on White
Trail Logos*

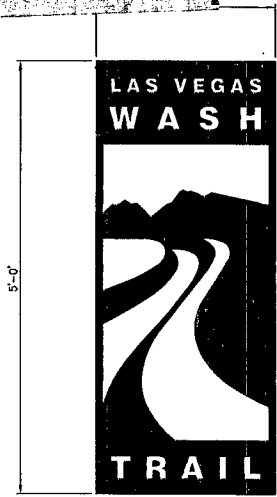

PAVEMENT LEGEND STENCIL (6) C21
NTS

NOTE:
NORMAL APPLICATION SHALL BE:
BLACK THERMO PAINT ON EXISTING WHITE CONCRETE SURFACE.

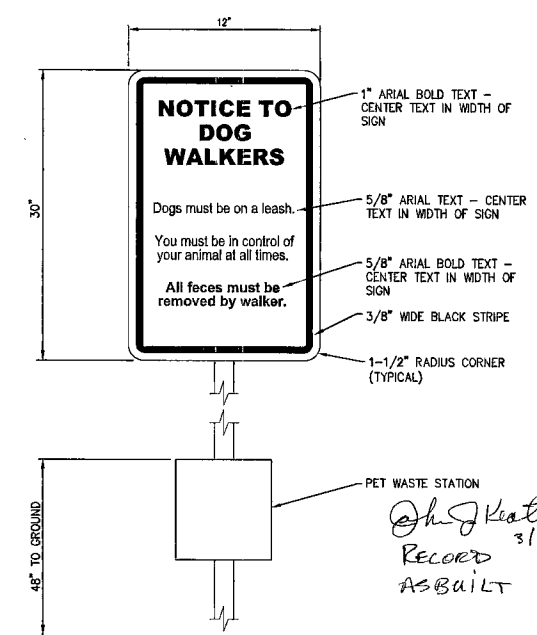


DOG WALKERS SIGN (7) C21
NTS

*PET WASTE STATION
Revised 3/15/2010
AS BUILT*

NO.	REVISIONS	DESCRIPTION	DATE	BY

SCALE: AS NOTED
DESIGN: DGR/DRA
DRAWN: DGR
CHECKED: DRA
APPROVED: DRA
DATE: 6-10-08

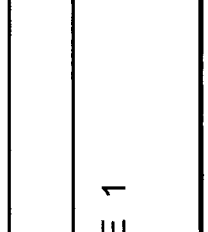

TRAIL SIGNS & DETAILS
LAS VEGAS WASH TRAIL - PHASE 1
OWENS AVE. to STEWART AVE.

SHEET NO.
C21

SHT. 26 OF 43
DWG No. 107V4396
HANSEN #12956

122224
Bureau Veritas
North America, Inc.
4840 W. University Ave, Suite A-1
Las Vegas, Nevada 89103
Tel: (702) 252-7866

*1/4 MILE MARKERS
IN STAMPE-TO-OS
TRAIL
@ These 2 1/2*