

(BOOK 120, PAGE 12)
LOCATED WITHIN THE NORTH HALF
(N 1/2) OF GOVERNMENT LOT 2, OF SECTION 2,
TOWNSHIP 20 SOUTH, RANGE 60 EAST, M.D.M., CITY OF
LAS VEGAS, CLARK COUNTY, NEVADA

I, VERNON C. LITTLE, A PROFESSIONAL LAND SURVEYOR LICENSED IN THE STATE OF NEVADA, DO HEREBY CERTIFY THAT THE MONUMENTS HAVE BEEN SET AND THE TIE DISTANCES ESTABLISHED AS SHOWN HEREON. THIS SURVEY WAS COMPLETED ON JUNE 9, 2006.


40 0 20 40

1* = 40'

SEE FINAL MAP FOR BEARING AND DISTANCES.
(BOOK 120, PAGE 12)

2	LOT NUMBER
	BLOCK NUMBER
_____	RIGHT OF WAY
_____	LOT LINES
_____	SUBDIVISION BOUNDARY LINE
_____	STREET CENTERLINE
_____	BACK OF CURB LINE
- - - - -	EX. BACK OF CURB LINE
●	TYPE III MONUMENT - 5/8" REBAR AND AL. CAP STAMPED "VTN PLS 13930"
■	TYPE IV-A REFERENCE MONUMENTS STAMPED "VTN PLS 13930" IN TOP OF CURB
○	FOUND TYPE IV-A REFERENCE MONUMENTS STAMPED "PLS 6878" IN TOP OF CURB
◎	FOUND MONUMENT AS DESCRIBED

058-4835

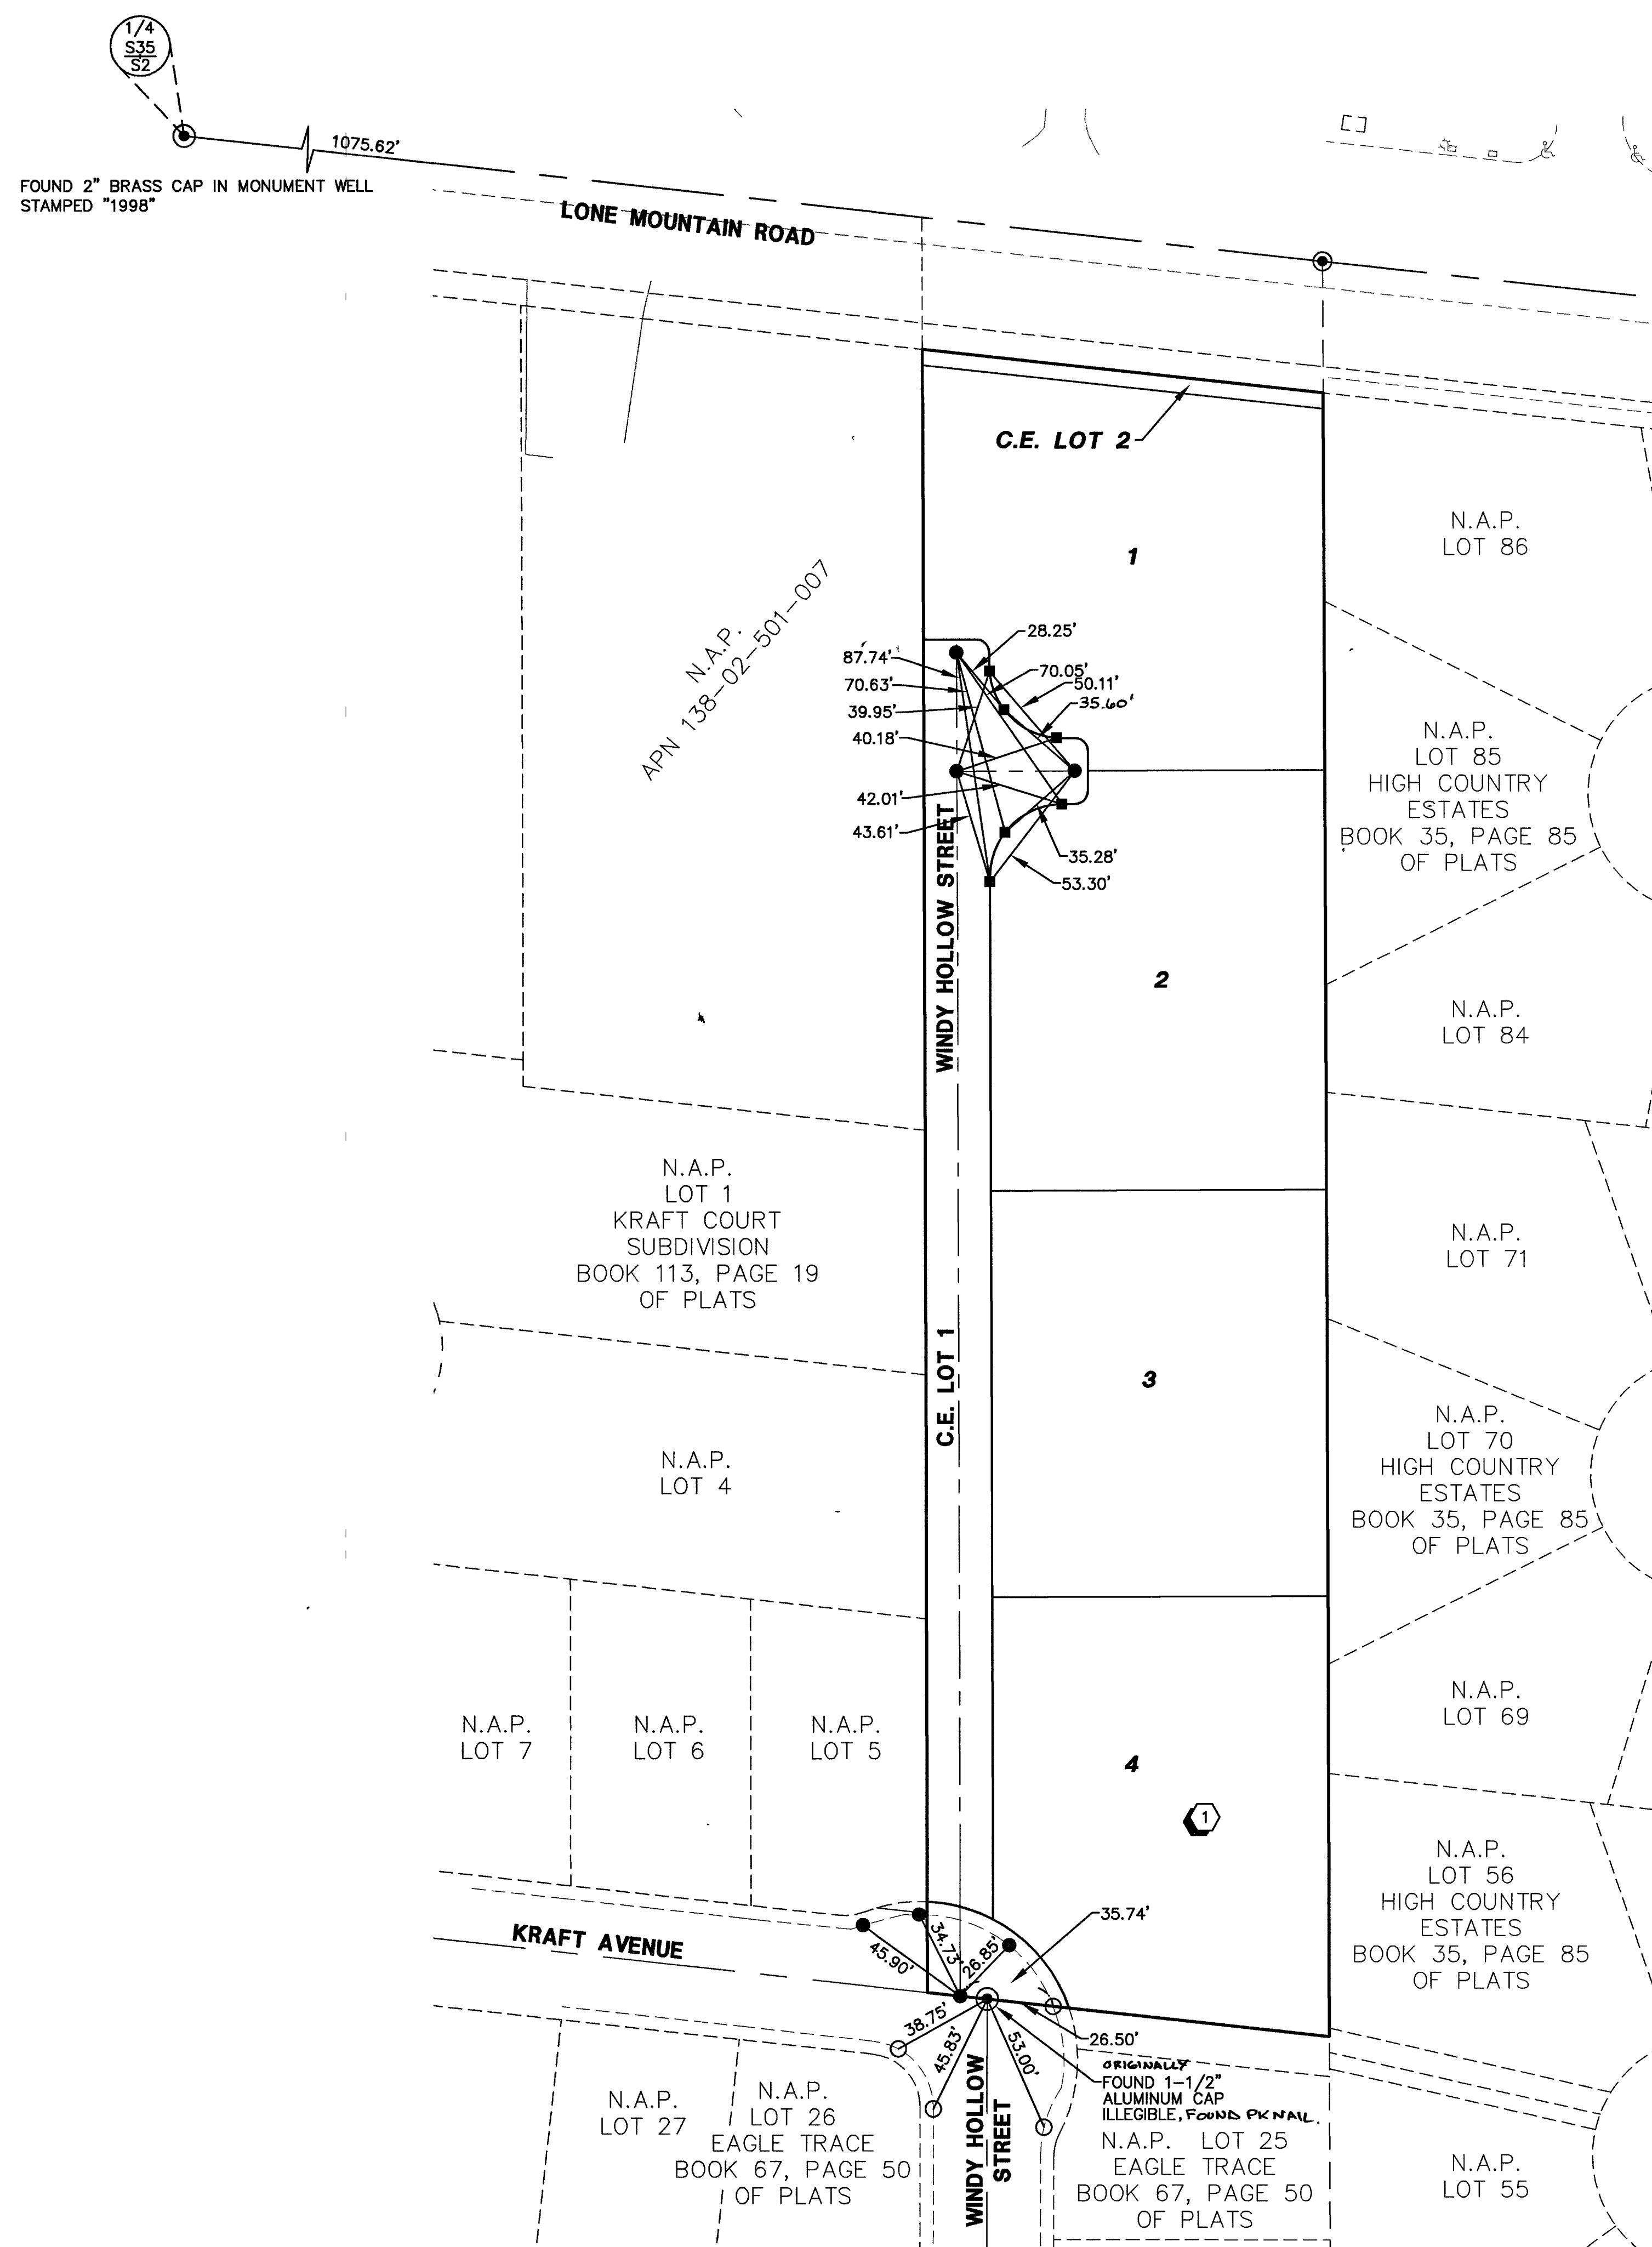

99036