


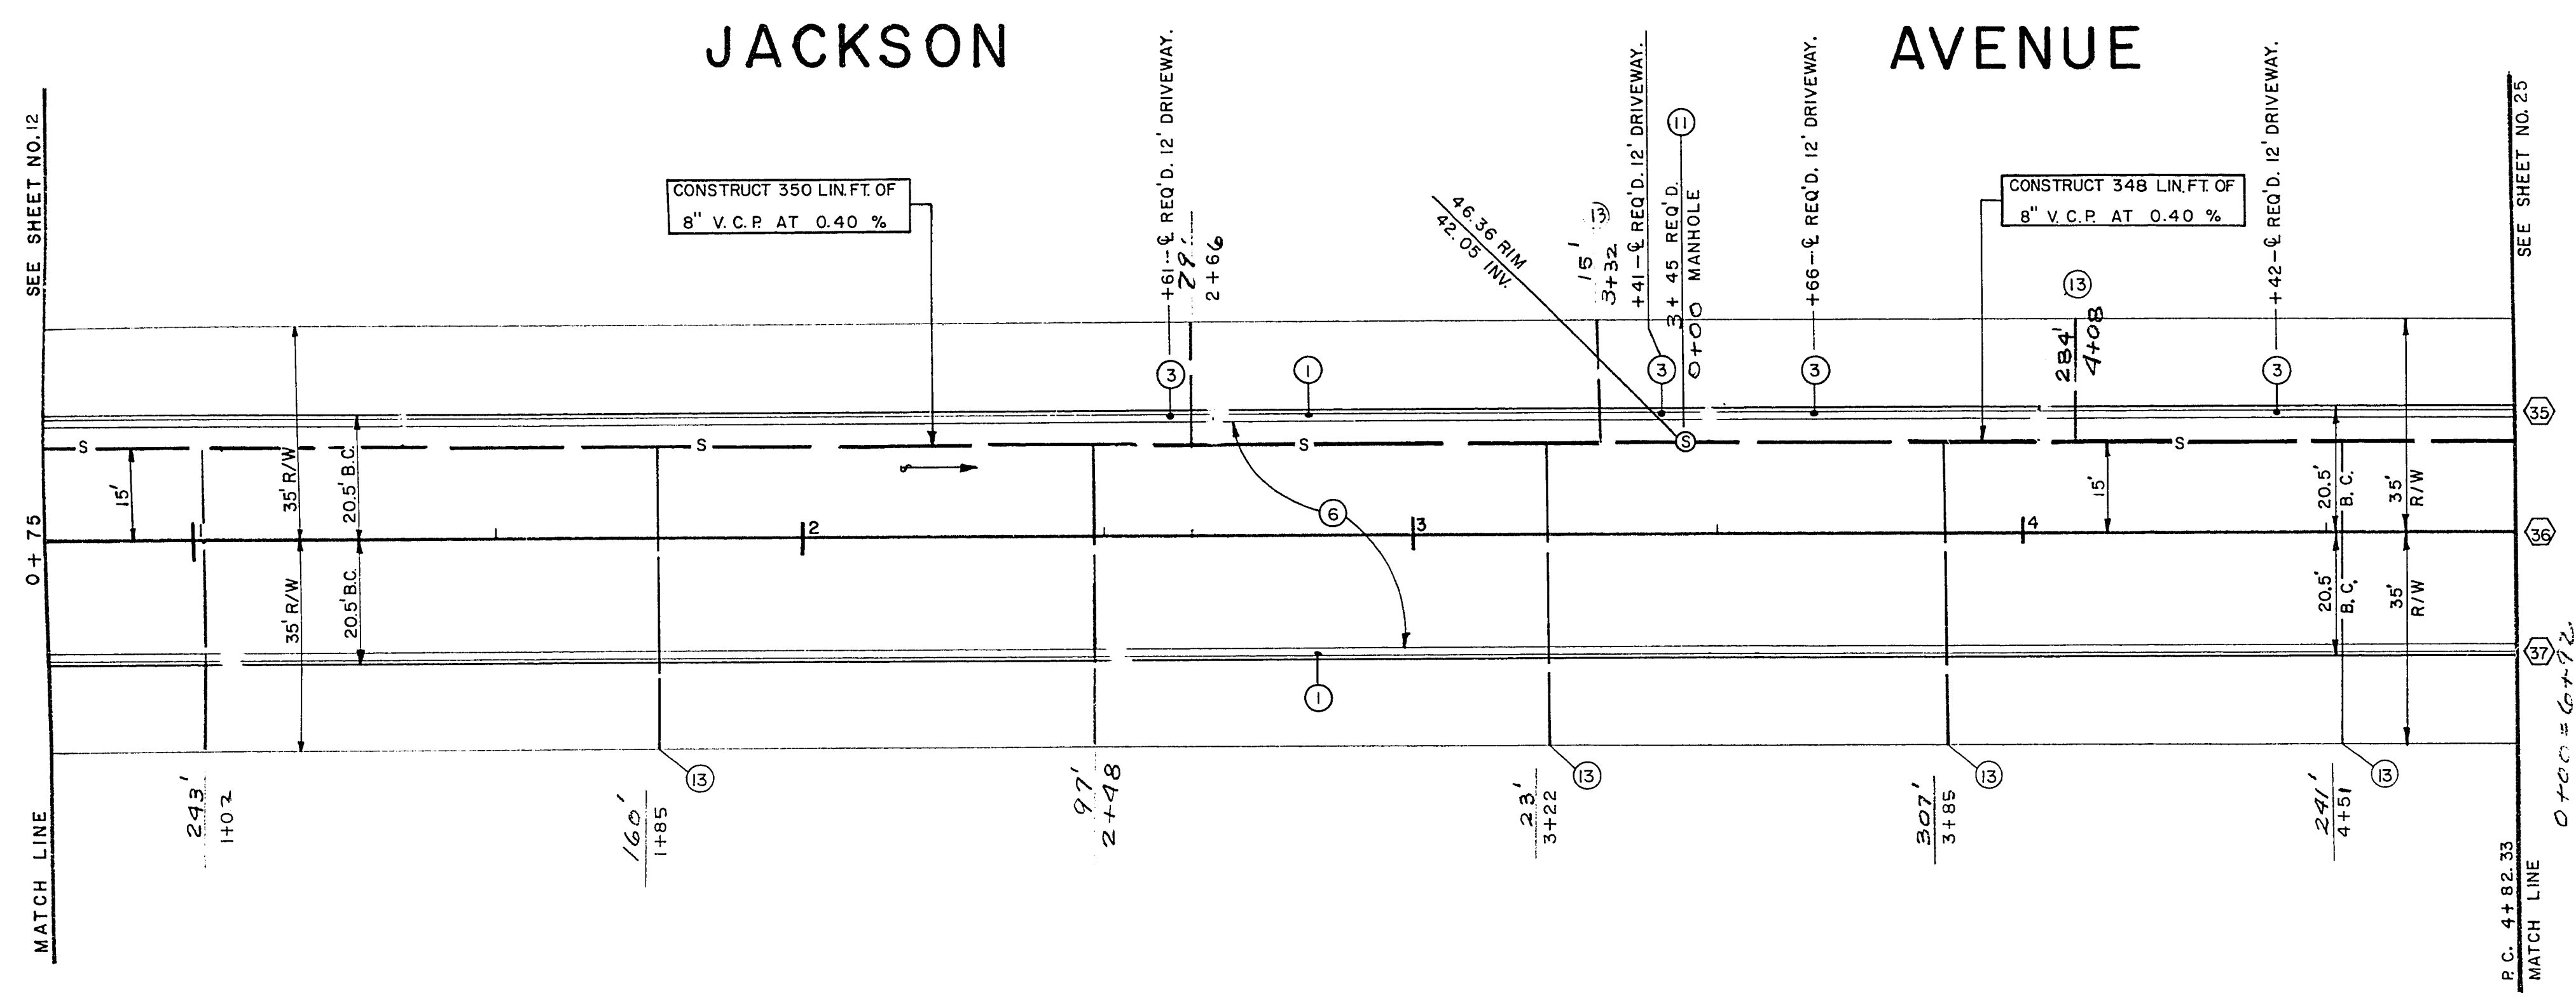

APPROXIMATE QUANTITIES — THIS SHEET			
ITEM	DESCRIPTION	QTY	UNIT
201.1	ROADWAY EXCAVATION	1069	CU. YD.
340.1	CONSTRUCT CONCRETE CURB & GUTTER	815	LN. FT.
302.1	TYPE I GRAVEL BASE	435	CU. YD.
302.2	TYPE II GRAVEL BASE	186	CU. YD.
334.4	2 INCH ASPHALTIC CONCRETE PAVEMENT	1675	SQ. YD.
333.1	BITUMINOUS FOG SEAL	1675	SQ. YD.
512.1	CONSTRUCT MANHOLE	11	EACH
123.208	INSTALL 8" VITRIFIED CLAY PIPE	407	LN. FT.
123.204	INSTALL 4" VITRIFIED CLAY PIPE (NEW)	13	LN. FT.


SCALE: 1"= 20'

CURVE NO.	Δ	R	T	L
35	4°21'09"	968.68	36.81	73.59
36	4°21'09"	989.18	37.59	75.14
37	4°21'09"	1,009.68	38.37	76.70

BENCH MARK: GUARD STAKE ON POWER POLE AT NORTH EAST CORNER OF IVY STREET AND MADISON AVENUE. ELEVATION 2042.48

DATE	10/13/68
DESIGNED BY	KSA 9-5-68
CHECKED BY	W.A. 9-27-68
APPROVED BY	W.A. 9-30-68
DATE	11/1/70

CONTRACT
DRAWING
FEB 3 1969

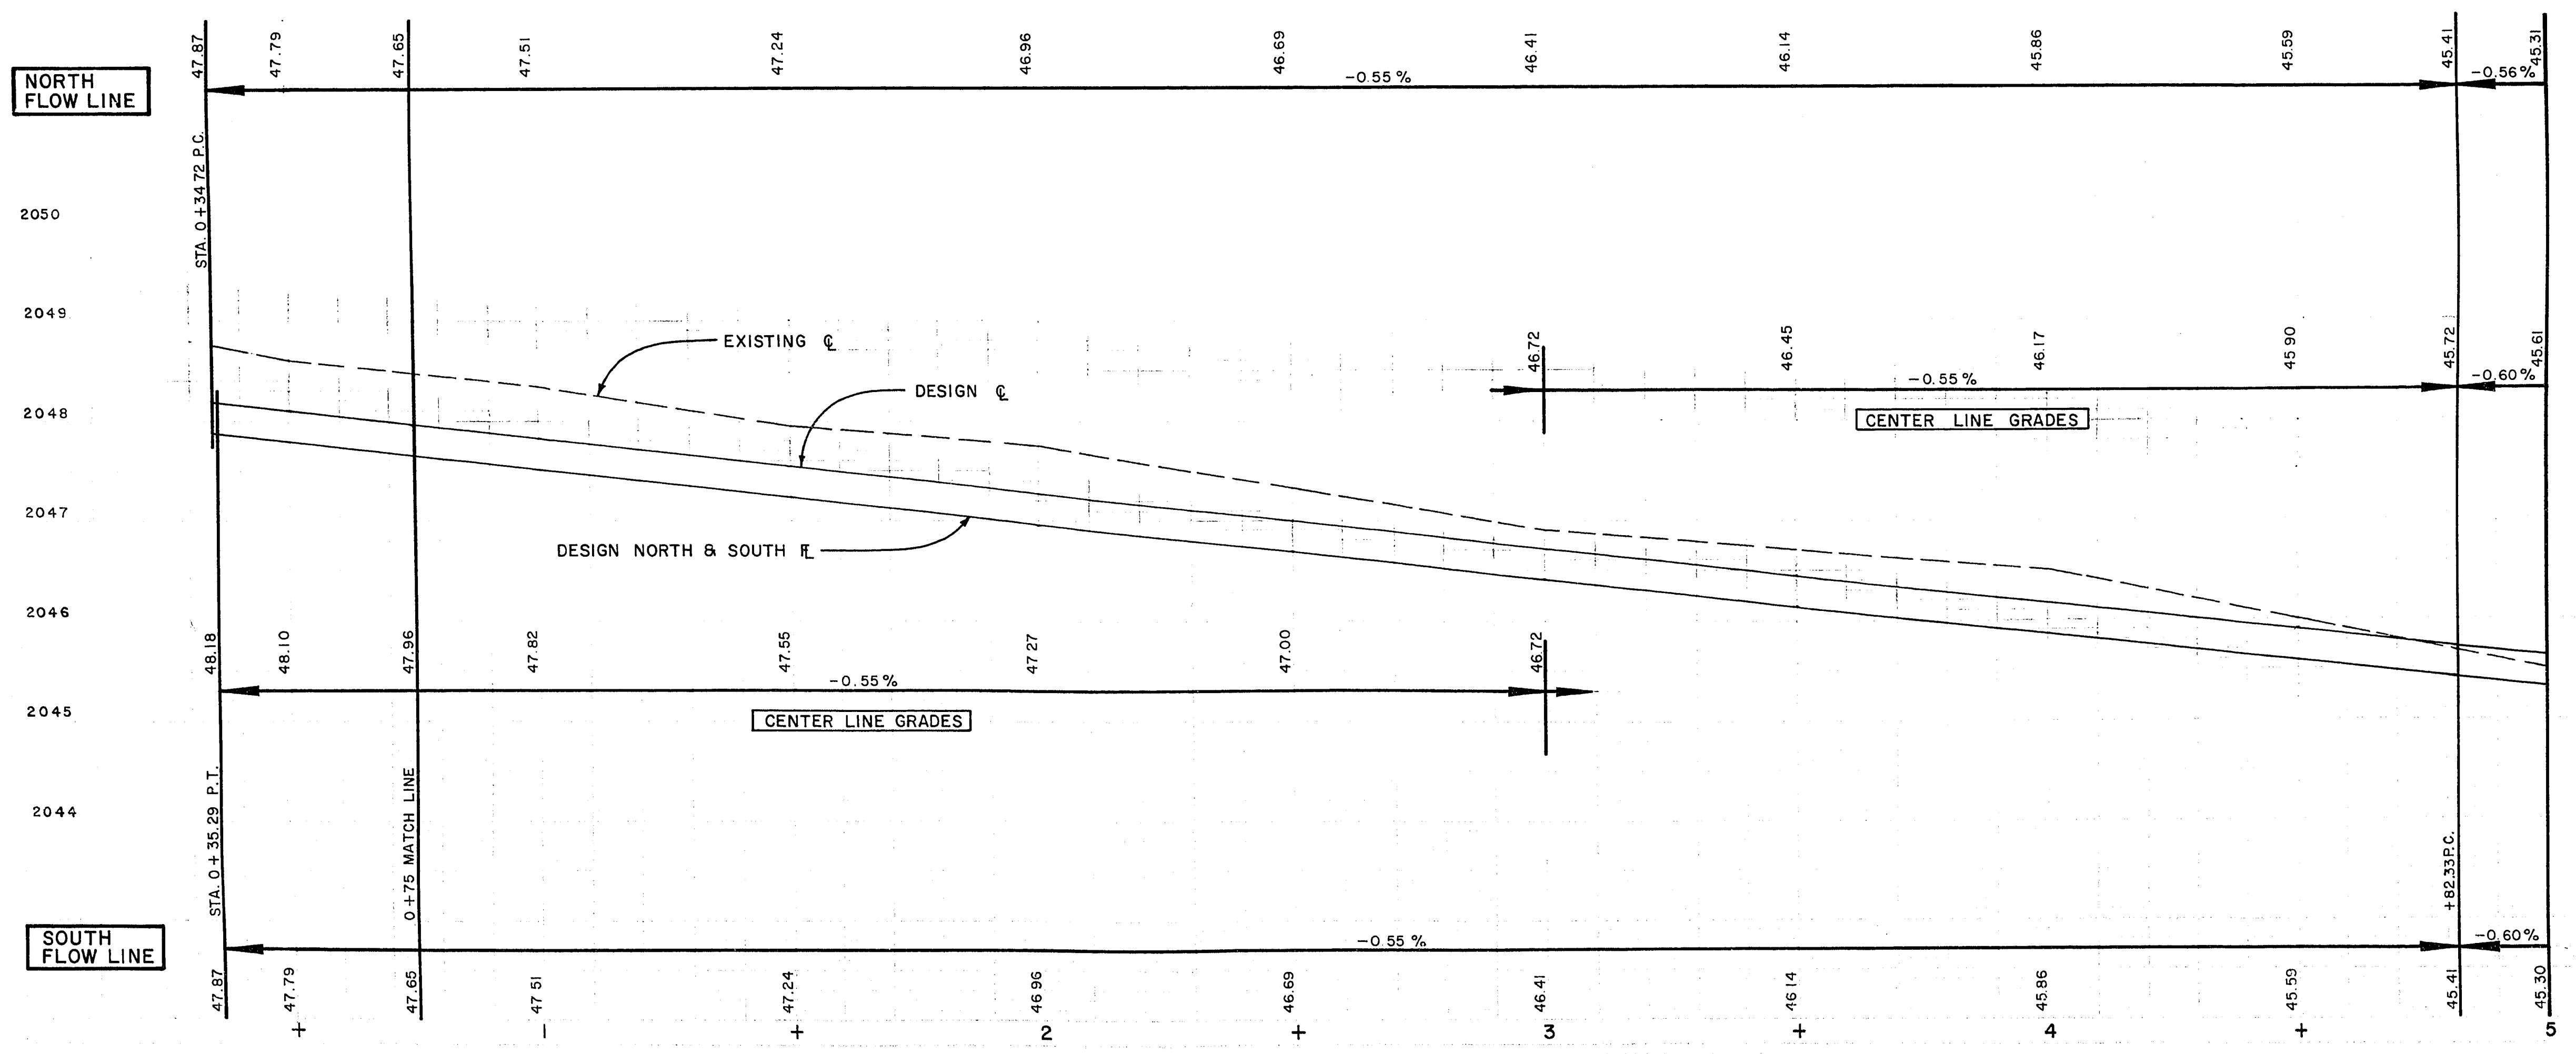

AS BUILT SEWER

CITY OF LAS VEGAS NEVADA ENGINEERING DEPT.			
JACKSON AVENUE "N" STREET TO "J" STREET STATION 0+75 TO STATION 4+82.33			
S.A.D. 486 UNIT I - II - III	DATE	SC. (H)	1" = 20'
DES. K. ANDERSON	4-25-68	SC. (V)	1" = 1'
DR. PATTERSON	6-26-67	F.B.K. NO.	86-6X
CKD.		P.J.O. NO.	
APPROVED BY CITY ENGR.		DRAWING NO.	486

13443 107-1778