


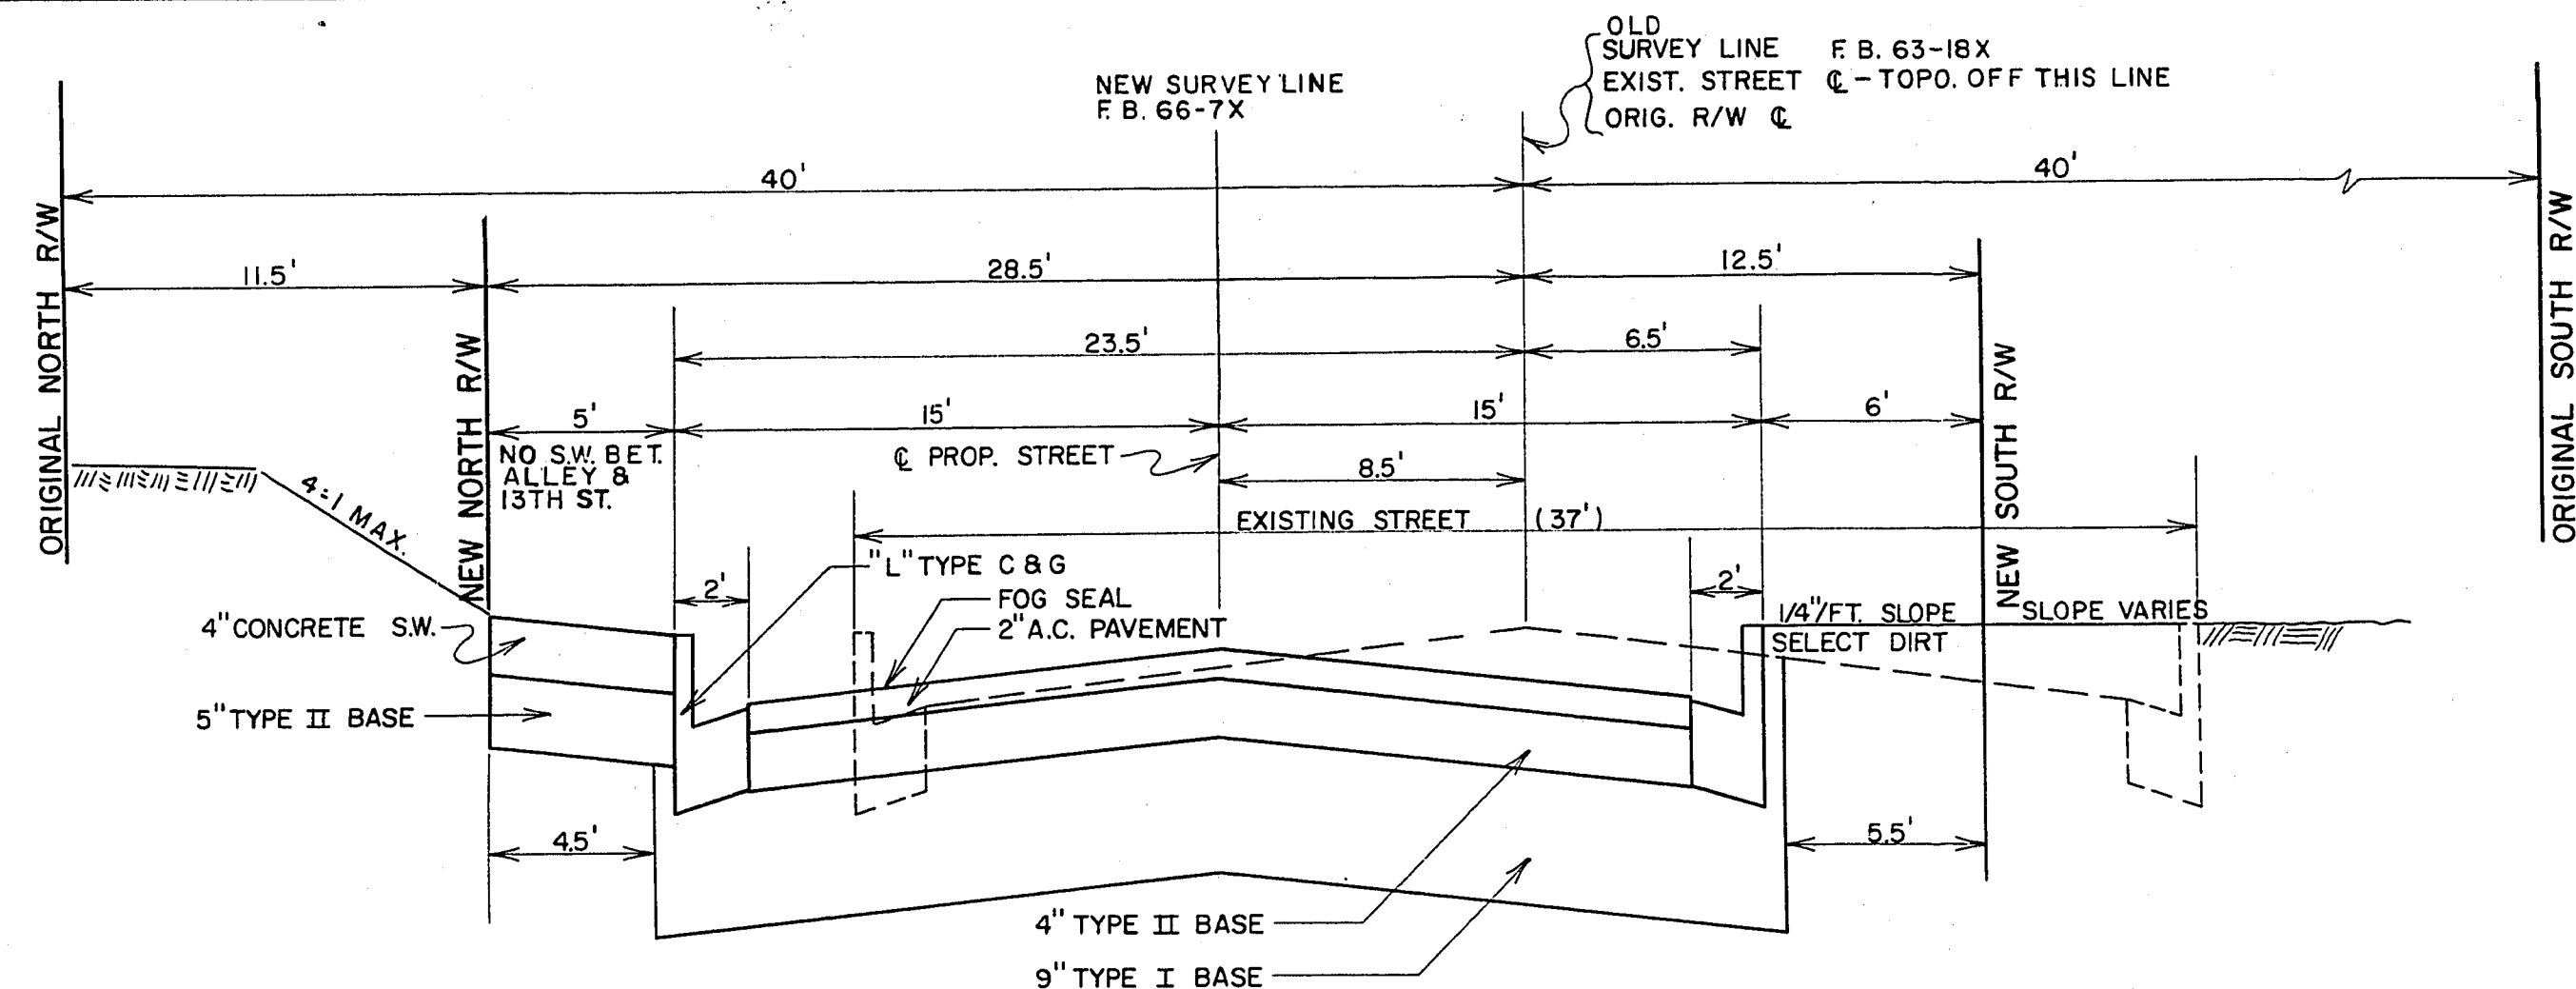

TYPICAL SECTION - LEWIS STREET
0.40' CROWN

CONSTRUCTION NOTES

REMOVAL ITEMS AND NUMBERS

- 1 REMOVE CONCRETE SIDEWALK TO LIMITS SHOWN ON PLANS.
- 2 REMOVE CONCRETE CURB & GUTTER TO LIMITS SHOWN ON PLANS.
- 3 REMOVE ASPHALT PAVEMENT TO LIMITS SHOWN ON PLANS.
- 4 REMOVE CONCRETE ALLEY GUTTER.
- 5 REMOVE CONCRETE DRIVEWAY.
- 6 RELOCATE FIRE HYDRANT.

CONSTRUCTION ITEMS AND NUMBERS

- 8 SAWCUT CONCRETE SIDEWALK TO LIMITS SHOWN ON PLANS.
- 9 SAWCUT ASPHALT PAVEMENT TO LIMITS SHOWN ON PLANS.
- 10 CONSTRUCT CONCRETE VALLEY GUTTER PER UNIFORM STANDARD DRAWING NO. 340.43.
- 11 CONSTRUCT "L" TYPE CURB AND GUTTER PER UNIFORM STANDARD DRAWING NO. 340.1.
- 12 CONSTRUCT CONCRETE SIDEWALK PER UNIFORM STANDARD DRAWING NO. 340.3.
- 13 CONSTRUCT CONCRETE ALLEY GUTTER PER UNIFORM STANDARD DRAWING NO. 340.6.
- 14 CONSTRUCT CONCRETE DRIVEWAY PER UNIFORM STANDARD DRAWING NO. 40.0 & 340.42.
- 15 CONSTRUCT 2" ASPHALT PAVEMENT OVER 4" TYPE II BASE OVER 9" TYPE I BASE AND FOG SEAL SURFACE.
- 16 CONSTRUCT 1-1/2" ASPHALT PAVEMENT OVER 4" TYPE II BASE AND FOG SEAL SURFACE FOR DRIVEWAY AND PARKING LOT TRANSITIONS AND ALSO TRANSITION AT ALLEY.
- 17 MODIFY EXISTING DROP INLET SO THAT GRATE WILL MATCH NEW VALLEY GUTTER FLOW LINE. (SEE DETAIL ON THIS SHEET)

GENERAL NOTES

- 1 ALL UTILITY COMPANIES SHALL BE NOTIFIED BY THE CONTRACTORS AT LEAST 48 HOURS PRIOR TO BEGINNING CONSTRUCTION.
- 2 THE LAS VEGAS VALLEY WATER DISTRICT SHALL BE RESPONSIBLE FOR THE REMOVAL OR RELOCATION OF ALL WATER METERS THAT INTERFERE WITH REQUIRED IMPROVEMENTS AS SHOWN ON THE PLANS AND IN ACCORDANCE WITH C.L.V. STD. DWG. 56.05 AND ADJUST WATER MANHOLES AND VALVE COVERS TO FINISHED GRADE.
- 3 THE CENTRAL TELEPHONE CO. SHALL BE RESPONSIBLE FOR THE VERTICAL ADJUSTMENT OF ALL CENTRAL TELEPHONE CO. MANHOLES TO THE REQUIRED FINISHED GRADE.

LEGEND

Legend symbols and descriptions:

- SURVEY LINE, SECTION LINE
- RIGHT OF WAY
- PROPOSED "L" TYPE CURB & GUTTER
- EXISTING "L" TYPE CURB & GUTTER
- FINISHED GRADE
- EXISTING GRADE
- EXISTING CONCRETE SIDEWALK, VALLEY & ALLEY GUTTER
- EXISTING SANITARY SEWER
- EXISTING WATER LINE
- EXISTING GAS LINE
- EXISTING STORM SEWER
- EDGE EXISTING PAVEMENT
- SAWCUT LINE, ASPHALT OR CONCRETE
- CURVE DATA AT BACK OF CURB AND CENTER LINE
- CONSTRUCTION NOTES
- EXISTING ASPHALT PAVEMENT
- EXISTING WATER VALVE
- EXISTING FIRE ALARM BOX
- EXISTING STREET LIGHT
- DESIGN ELEVATION
- EXISTING ELEVATION
- EXISTING FIRE HYDRANT
- EXISTING POWER POLE
- EXISTING STREET SIGNS
- EXISTING MANHOLES

SUMMARY OF APPROXIMATE QUANTITIES				
CONST. NOTE NO.	ITEM NO.	DESCRIPTION	UNIT	QUANTITY
	201.100	EXCAVATION	C.Y.	697
1	200.110	REMOVE CONCRETE SIDEWALK	S.F.	788
2	200.110	REMOVE CONC. CURB AND GUTTER	L.F.	367
3	201.100	REMOVE ASPHALT PAVEMENT	S.Y.	1374
4	200.110	REMOVE CONC. ALLEY GUTTER	S.F.	120
5	200.110	REMOVE CONCRETE DRIVEWAY	S.F.	165
6	560.080	RELOCATE FIRE HYDRANT	EA.	1
8	200.110	SAWCUT CONCRETE SIDEWALK	L.F.	15
9	201.100	SAWCUT ASPHALT PAVEMENT	L.F.	97
10	340.319	CONSTRUCT CONC. VALLEY GUTTER	S.F.	436
11	340.014	CONSTRUCT "L" TYPE CURB & GUTTER	L.F.	580
12	340.114	CONSTRUCT CONCRETE SIDEWALK	S.F.	735
13	340.326	CONSTRUCT CONCRETE ALLEY GUTTER	S.F.	189
14	340.222	CONSTRUCT CONCRETE COMM. DRIVEWAY	S.F.	165
15	334.004	CONSTRUCT 2" ASPHALT PAVEMENT	S.Y.	976
16	334.003	CONSTRUCT 1-1/2" ASPHALT PAVEMENT	S.Y.	65
17	500.201	MODIFY DROP INLET	EA.	1
18	302.100	TYPE I GRAVEL	C.Y.	300
19	302.200	TYPE II GRAVEL	C.Y.	134

AS BUILT

CONTRACT DRAWING APR 3 1970

CITY OF LAS VEGAS NEVADA
DEPARTMENT OF PUBLIC WORKS
SERVICES DIVISION

LEWIS AVENUE 12TH STREET TO 13TH STREET

W.O. NO. 3041 F.B.K. NO. 63-18X DATE SC. (H) 1" = 20' SC. (V) 1" = 2' DRAWING NO. 107V-809

DES. W. JAUBERT DR. H. FRAZIER NOV. 1969 FILE NO.

APPROVED BY DIRECTOR OF PUBLIC WORKS MAR 26 1970 SHEET 2 OF 3

I CERTIFY THAT THIS PLAN WAS PREPARED UNDER MY SUPERVISION. JAY M. FRAZIER R.P.E. 1624 DATE 3-17-70